


**TREE SUMMARY**

TREE NUMBER	COMMON NAME	BOTANICAL NAME	SIZE	REMARK
①	LIVE OAK	QUERCUS VIRGINIANA	3"	REMOVED
②	REDTONG DOGWOOD	CORNUS ALBA	3"	REMOVED
③	LIVE OAK	QUERCUS VIRGINIANA	3"	PROPOSED TREE
④	LIVE OAK	QUERCUS VIRGINIANA	3"	PROPOSED TREE
⑤	LIVE OAK	QUERCUS VIRGINIANA	3"	REMOVED
⑥	LIVE OAK	QUERCUS VIRGINIANA	3"	PROPOSED TREE

NOTE:  
CONTRACTOR SHALL BE RESPONSIBLE FOR REINSTALL IRRIGATION SYSTEM.

**SITE LEGEND**


- EXIST. TREE
- EXIST. TREE TO BE RELOCATED
- PROP. TREE (WITH 1 YEAR WARRANTY)

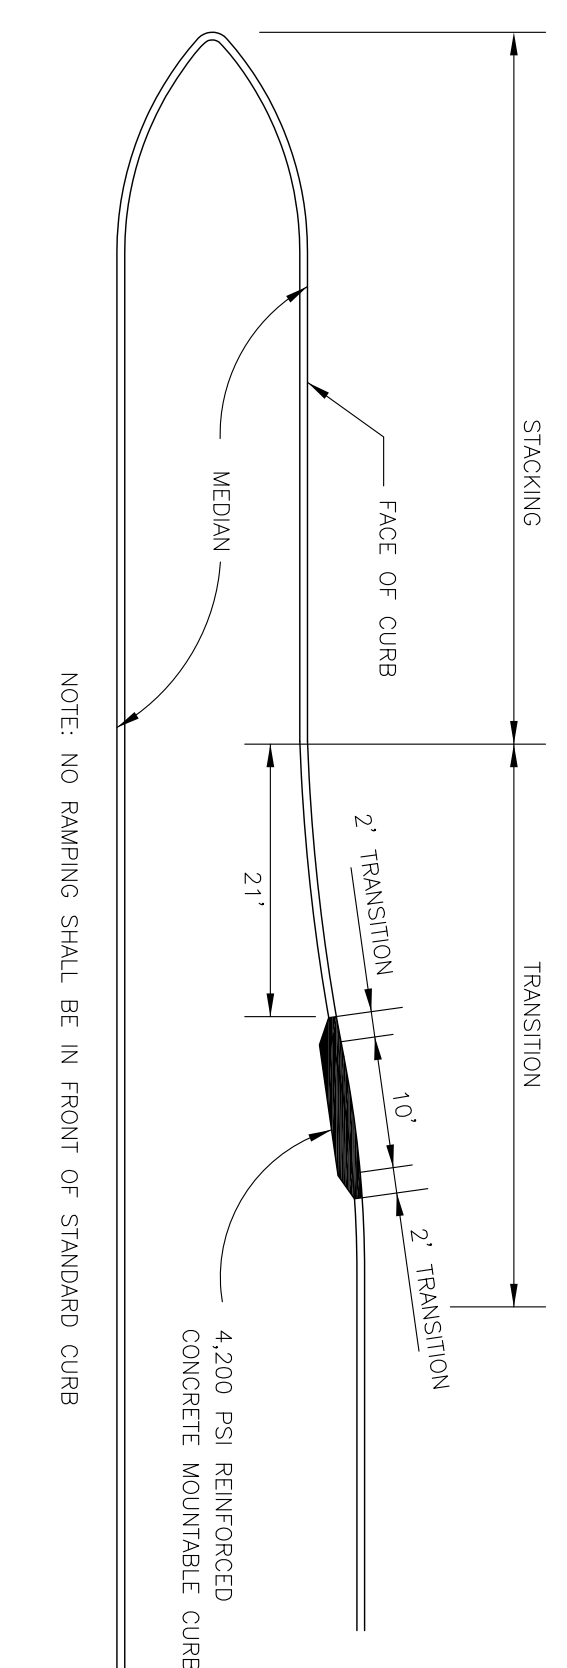

NOTE: NO RAMPING SHALL BE IN FRONT OF STANDARD CURB


**PLAN VIEW**

**LANDSCAPE MAINTENANCE RAMP**

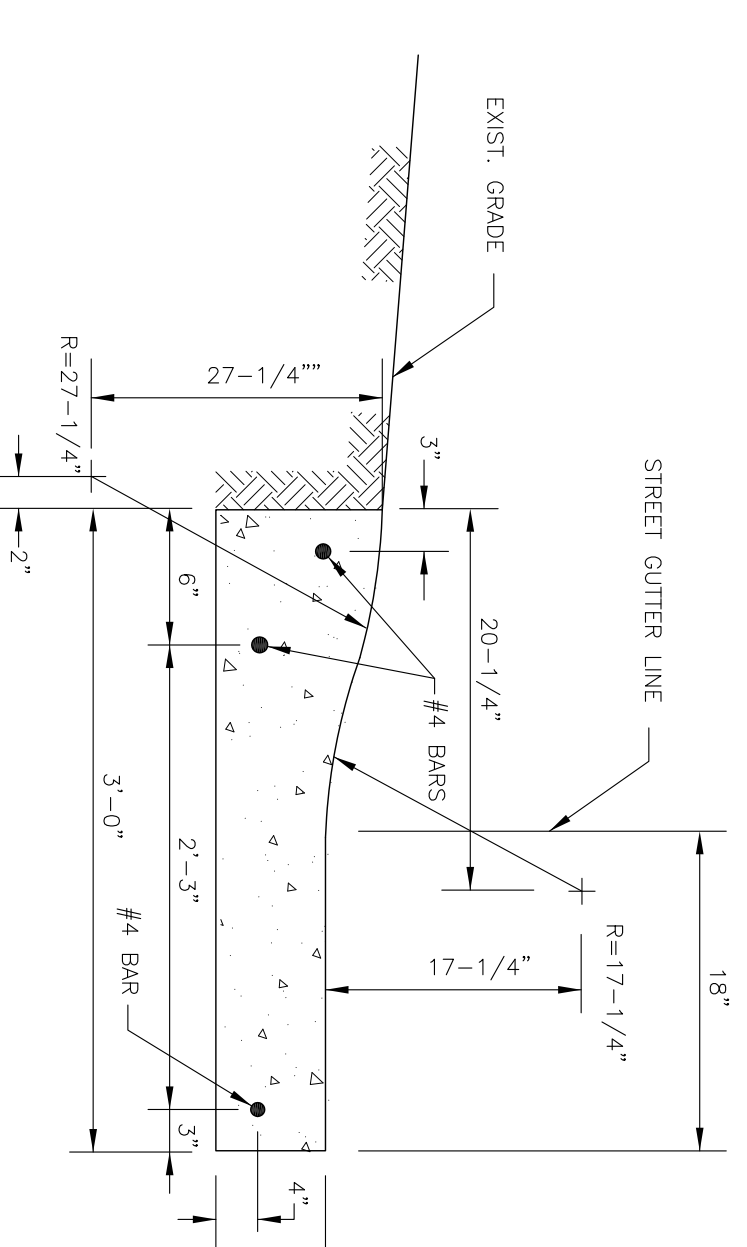

**MOUNTABLE CURB SECTION**


N.T.S.

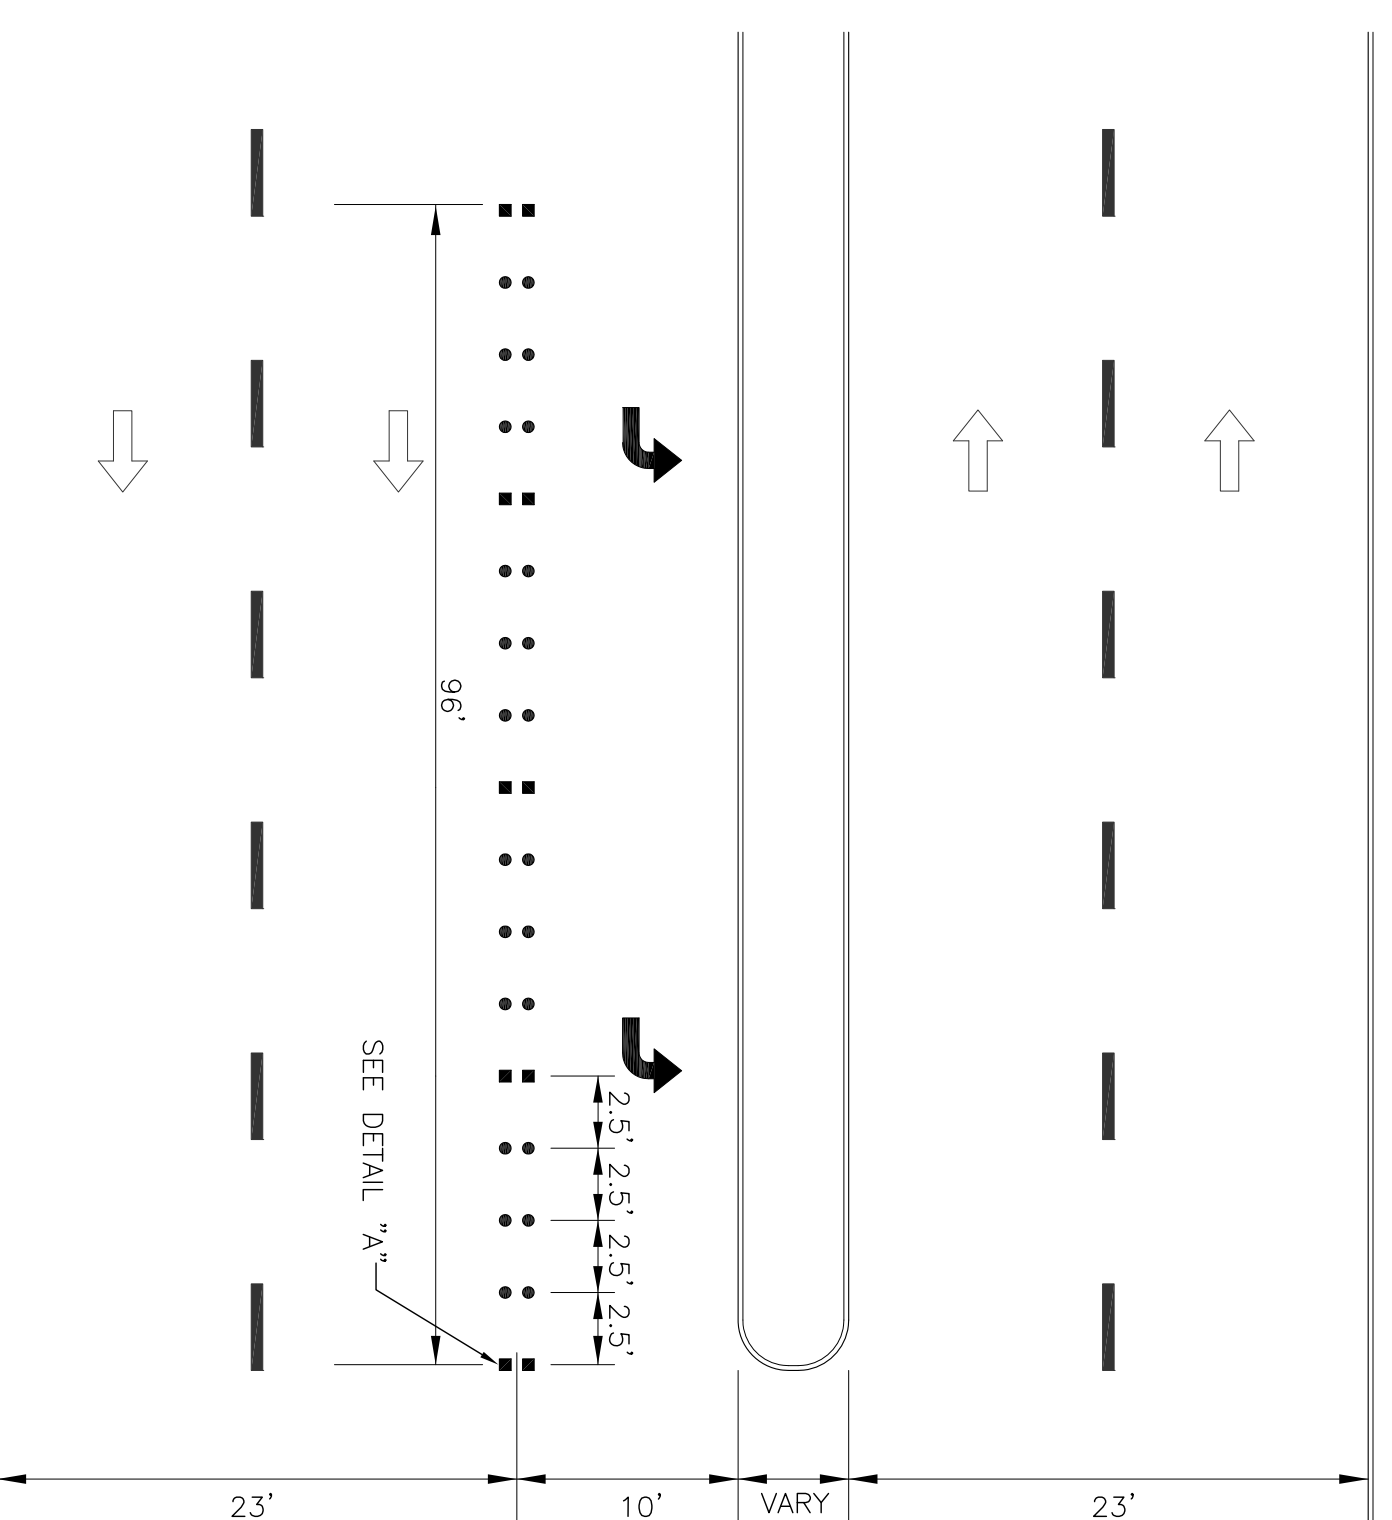

**RALPH HALL PKWY**

**TYP PAVEMENT MARKING DETAIL**

N.T.S.

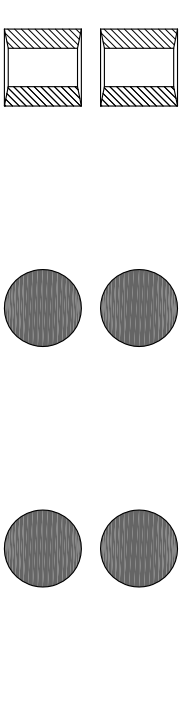

**BUTTONS SPACING**

**DETAIL "A"**

N.T.S.

**AS BUILT**  
THIS IS TO CERTIFY THAT CHANGES AND CORRECTIONS HAVE BEEN MADE TO THE ORIGINAL DESIGN AND RECORD OF THIS PROJECT.  
7.5.11



NOTE: RESPONSIBILITY FOR ADEQUACY OF DESIGN REMAINS WITH THE DESIGN ENGINEER. THE CITY OF ROCKWALL, IN REVIEWING AND RELEASING PLANS FOR CONSTRUCTION, ASSUMES NO RESPONSIBILITY FOR ADEQUACY OR ACCURACY OF DESIGN.

**LEFT TURN LANE PLAN AND DETAILS**

**ROCKWALL MARKET CENTER SOUTH**

**GU DEVELOPMENT, LP.**

**PSA ENGINEERING**

1500 E INDUSTRIAL BOULEVARD, MCKINNEY, TEXAS 75068, (972) 562-5555  
17819 DAVENPORT ROAD, SUITE 218 DALLAS, TX 75228, PH (972) 248-9851, FAX (972) 248-9881  
T.B.P.E. REGISTRATION # F-6974, T.B.P.L.S. FROM REGISTERED NO. 1004533

DESIGN	DRAWN	DATE	SCALE	CHECK	FILE	NO.
PSA	PSA	06/22/11	AS SHOWN	PSS	21009.RMS	<b>C-5</b>