


I.H. 30

BENCH MARK:
EXISTING CUT SQUARE ON TOP OF CURB AT NW CORNER OF VILLAGE DRIVE BRIDGE OVER RAIL ROAD ELEVATION = 506.23'

26.20 TC = PROPOSED TOP OF CURB ELEVATION
[25.63] = PROPOSED FINISHED CONCRETE ELEVATION

107 PARKING SPACES INCLUDES 5 HANDICAP SPACES
NOTE: 1. All Water to be C-900 Class 200.

AS BUILT

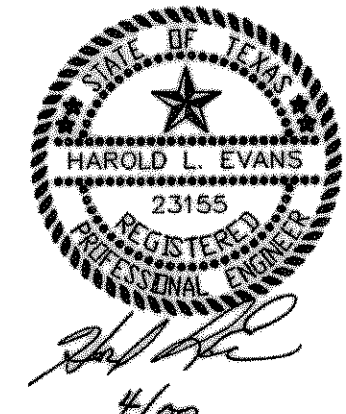

REVISION DESCRIPTION	DATE	SCALE	DESIGN	DRAWN
1. Revisions	9-09-99	1" = 20'	H.L.E.	L.W.G.
2. Revisions	10-04-99	1" = 20'	H.L.E.	L.W.G.
3. Revisions	11-04-99	1" = 20'	H.L.E.	L.W.G.
4. Revisions	11-09-99	1" = 20'	H.L.E.	L.W.G.
5. Revisions	11-12-99	1" = 20'	H.L.E.	L.W.G.
6. Revisions	12-06-99	1" = 20'	H.L.E.	L.W.G.

HAROLD L. EVANS
CONSULTING ENGINEER
P.O. BOX 28355
2331 GUS THOMASSON ROAD, SUITE 102
DALLAS, TEXAS 75228, (214) 328-8133

GRADING, WATER & SAN. SEWER PLAN
THE RANCH HOUSE ADDITION
CITY OF ROCKWALL

SHEET NO.	3
JOB NO.	9943