
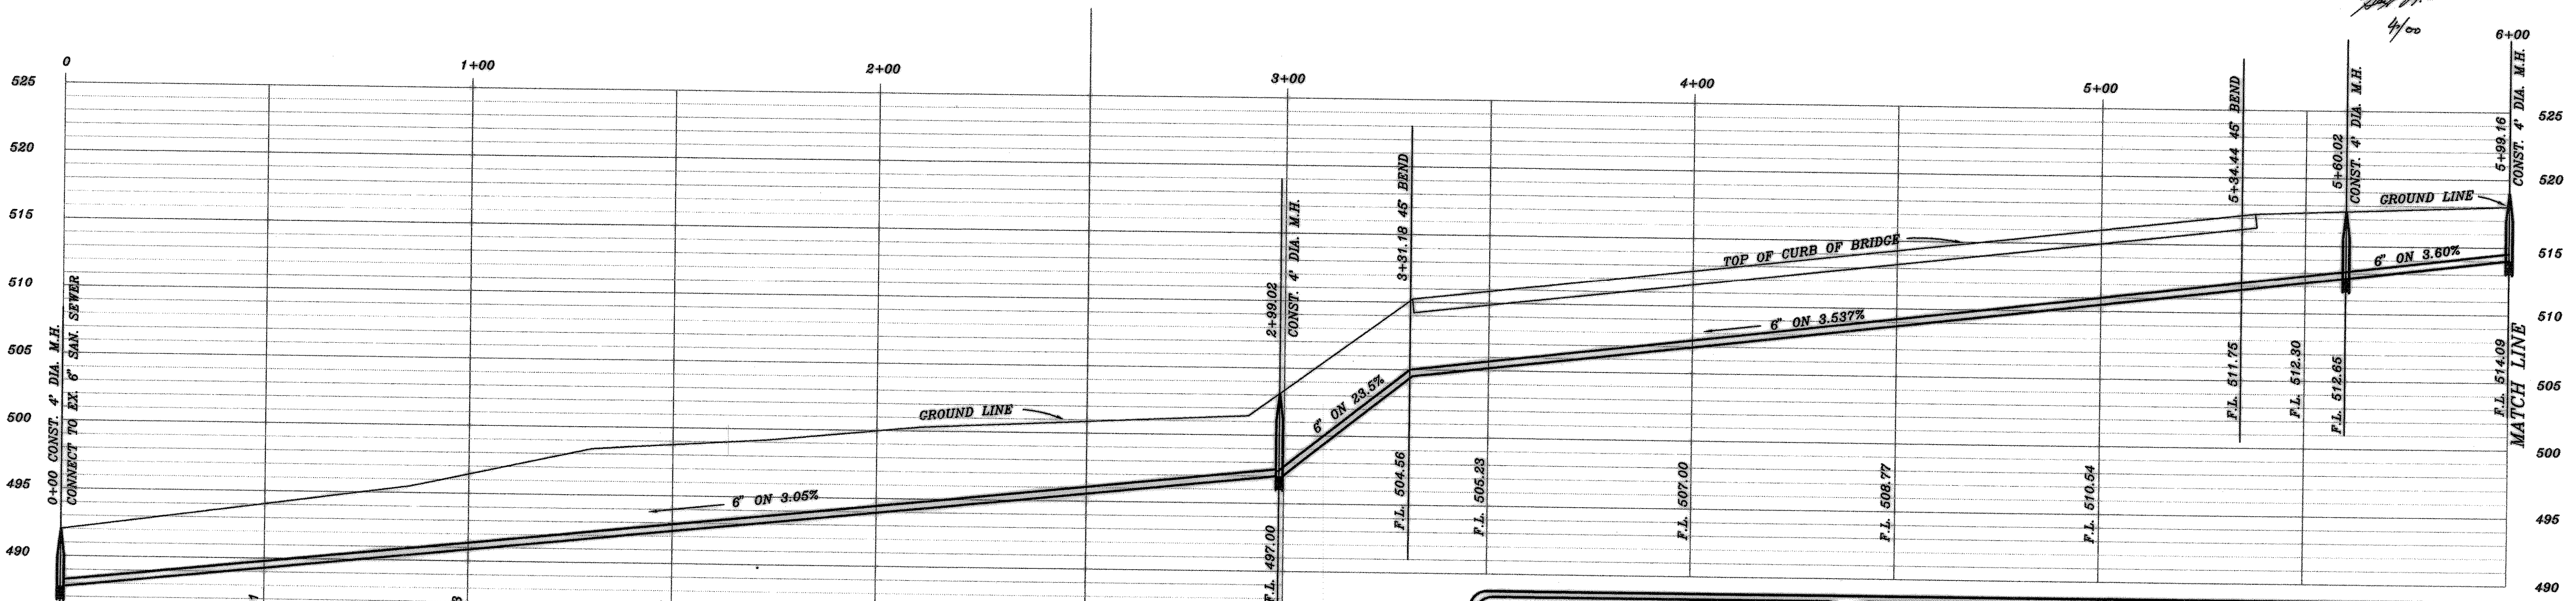


$\Delta = 30'49'37''$   
 $R = 200.00'$   
 $T = 55.14'$   
 $L = 107.61'$

**AS BUILT**

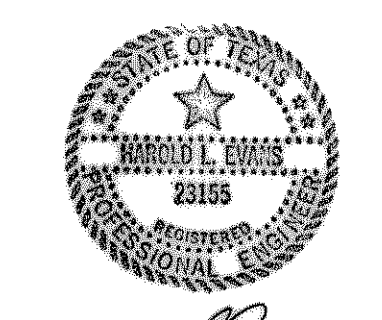

	<b>HAROLD L. EVANS</b> CONSULTING ENGINEER P.O. BOX 28355 2831 GUS THOMASSON ROAD, SUITE 102 DALLAS, TEXAS 75228, (214) 328-8133	<b>OFFSITE WATER &amp; SEWER PLAN</b>	SHEET NO. 4
	<b>THE RANCH HOUSE ADDITION</b> <b>CITY OF ROCKWALL</b>		JOB NO.