


DRAINAGE TABLE - DEVELOPED

DRAINAGE AREA NO.	ACRES	T.C.	C	I 100 YR.	Q 100 YR.	SUM Q 100 YR.
1	0.36	10	0.80	9.80	2.82	
2	0.17	"	"	"	1.33	
3	0.45	"	"	"	3.53	
4	0.23	"	"	"	1.80	
5	0.29	"	"	"	2.27	
6	0.06	"	"	"	0.47	

I.H. 30

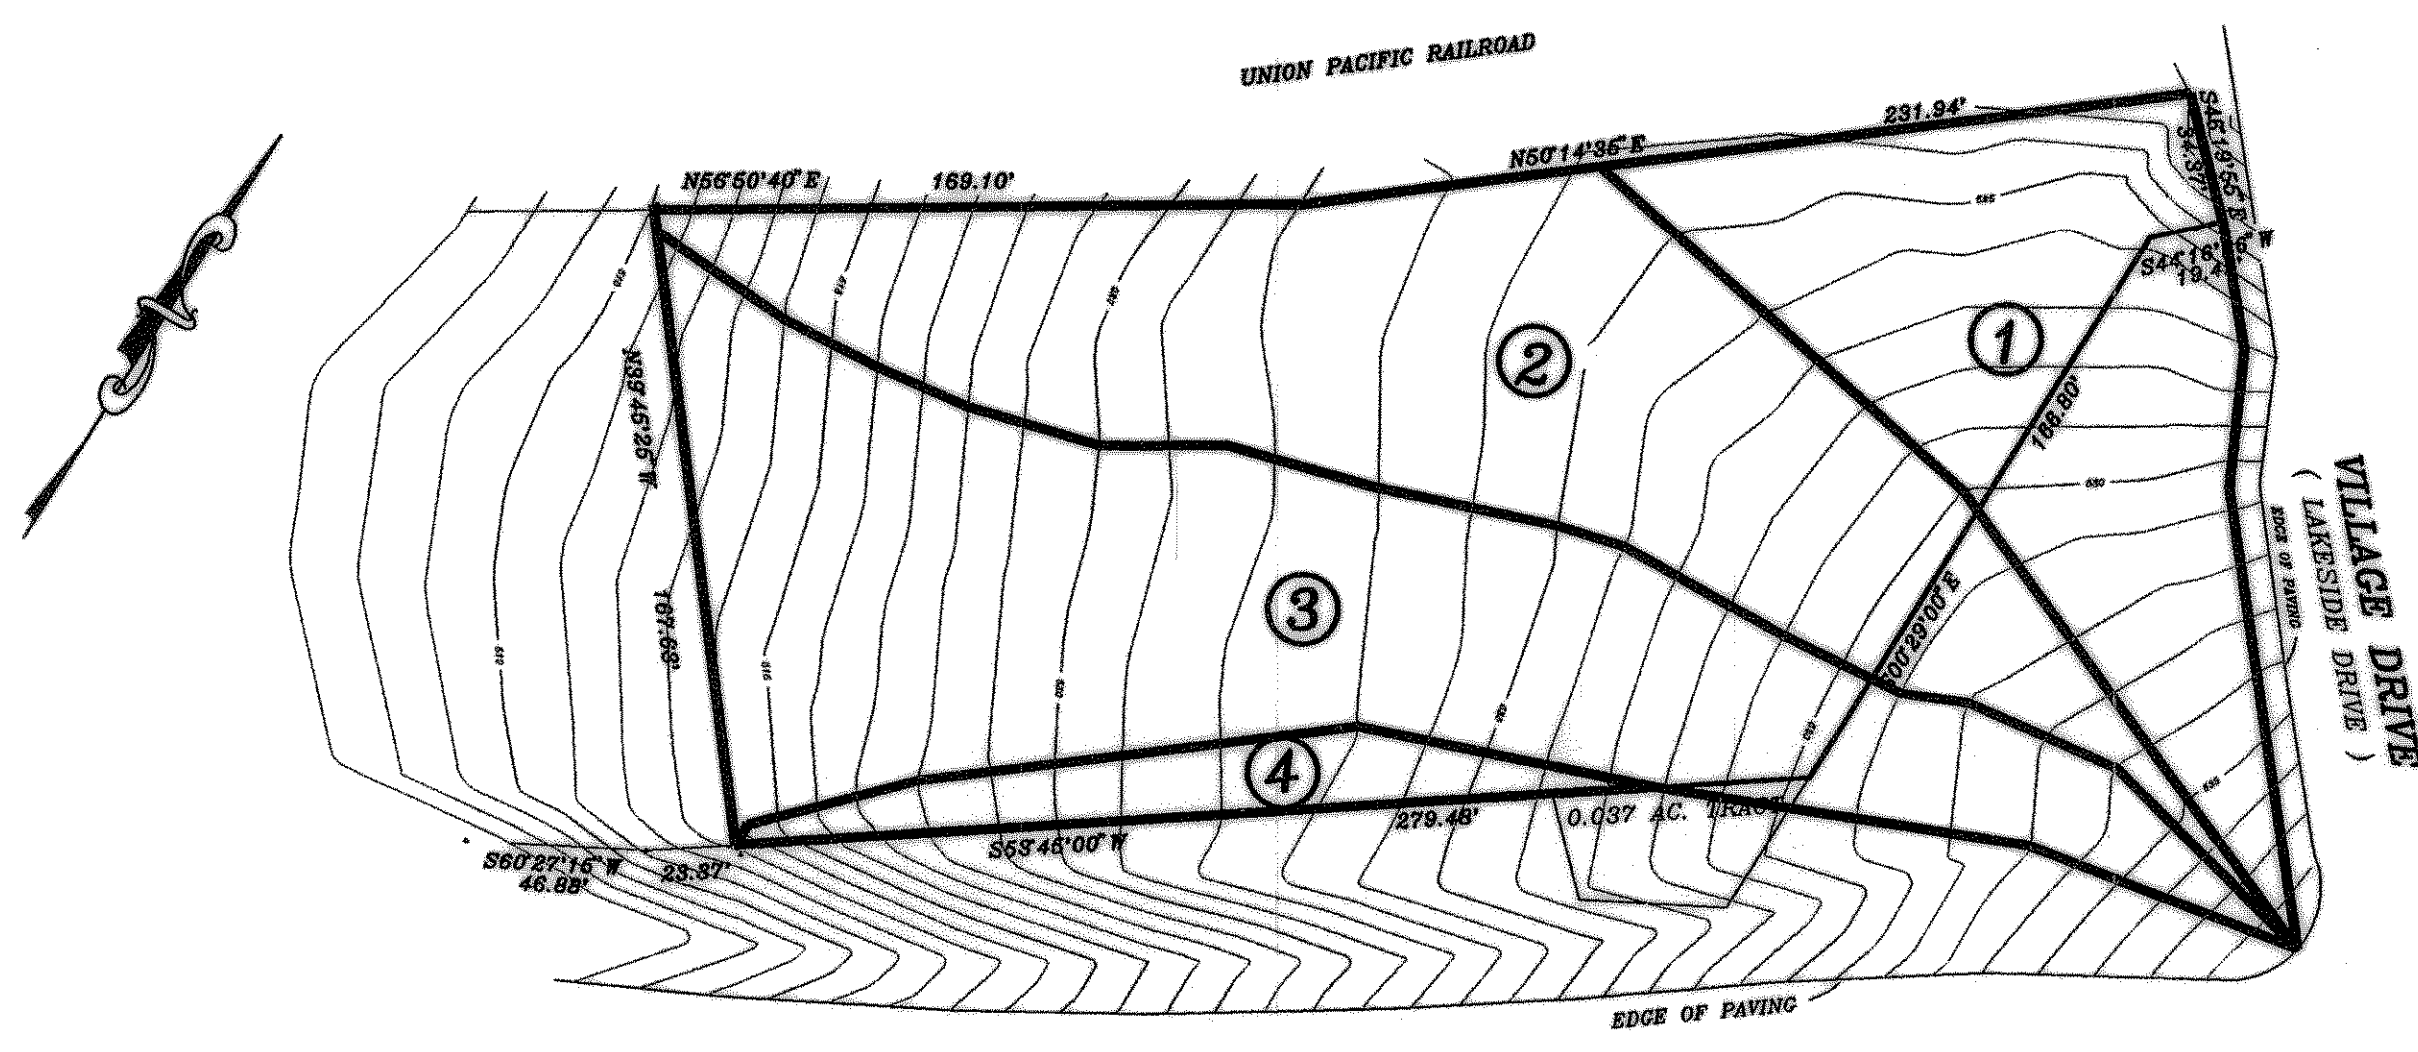


I.H. 30

DRAINAGE TABLE - PRE DEVELOPMENT

DRAINAGE AREA NO.	ACRES	T.C.	C	I 100 YR.	Q 100 YR.	SUM Q 100 YR.
1	0.36	10	0.80	9.80	2.82	
2	0.54	"	"	"	4.23	
3	0.62	"	"	"	4.86	
4	0.07	"	"	"	0.55	

AS BUILT

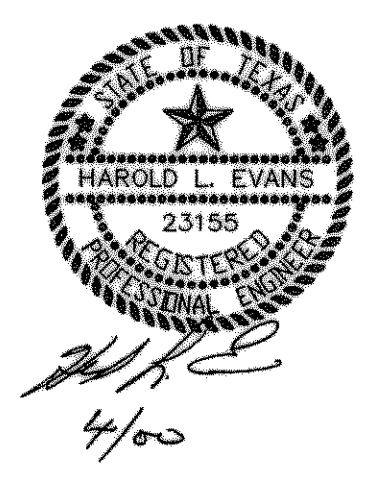

REVISION DESCRIPTION 99422A1	DATE OCTOBER, 1989	SCALE 1" = 20' 1" = 6'	DESIGN H.L.E.	DRAWN L.W.G.	DRAINAGE AREA MAP THE RANCH HOUSE ADDITION CITY OF ROCKWALL	SHEET NO. 5	JOB NO. 9943
HAROLD L. EVANS CONSULTING ENGINEER P.O. BOX 28355 2331 GUS THOMASSON ROAD, SUITE 102 DALLAS, TEXAS 75228, (214) 328-8133							