


GRAPHIC SCALE



(IN FEET)
1 inch = 20 ft.

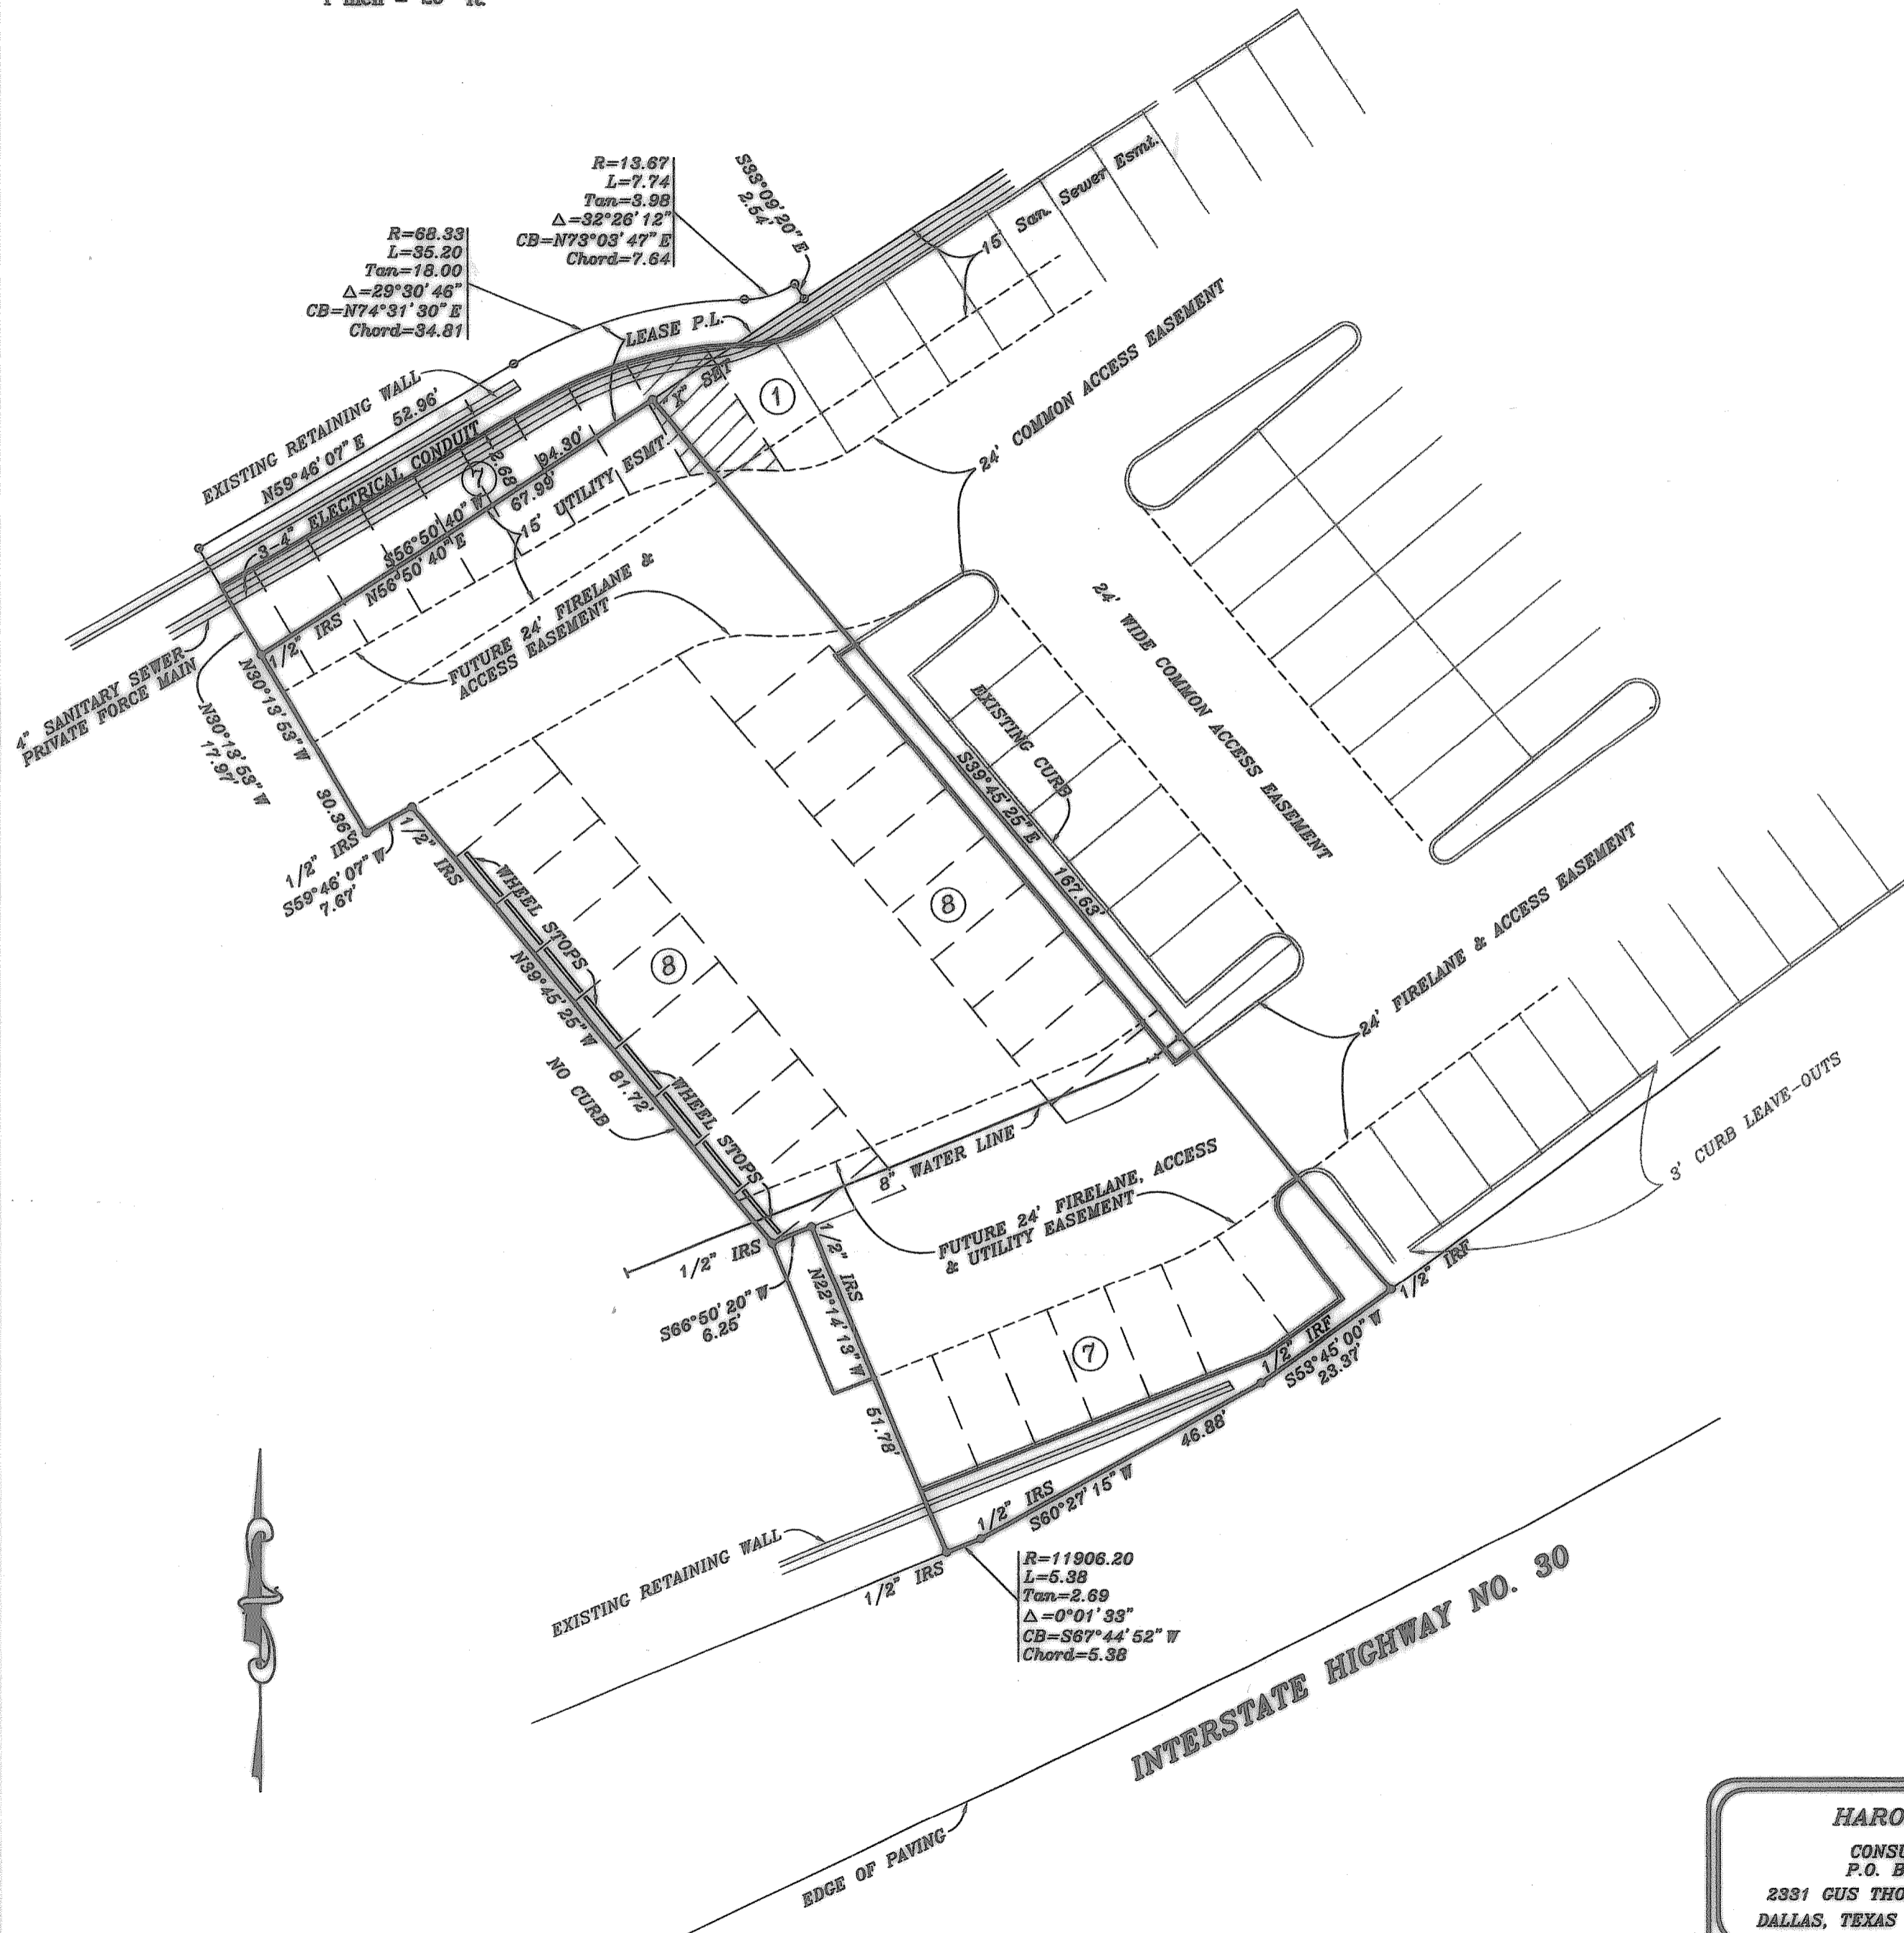

[Signature]
4/8/05

Snuffer's Parking Lot Expansion

AS-BUILT SURVEY

M.J. BARKSDALE SURVEY, ABSTRACT NO. 11

CITY OF ROCKWALL, ROCKWALL COUNTY, TEXAS

HAROLD L. EVANS
CONSULTING ENGINEER
P.O. BOX 570355-75370
2331 GUS THOMASSON ROAD, SUITE 102
DALLAS, TEXAS 75228, (214) 328-8133

SCALE	DATE	JOB No.
1" = 20'	4/8/05	05004