


FM 3097 - (HORIZON RD)

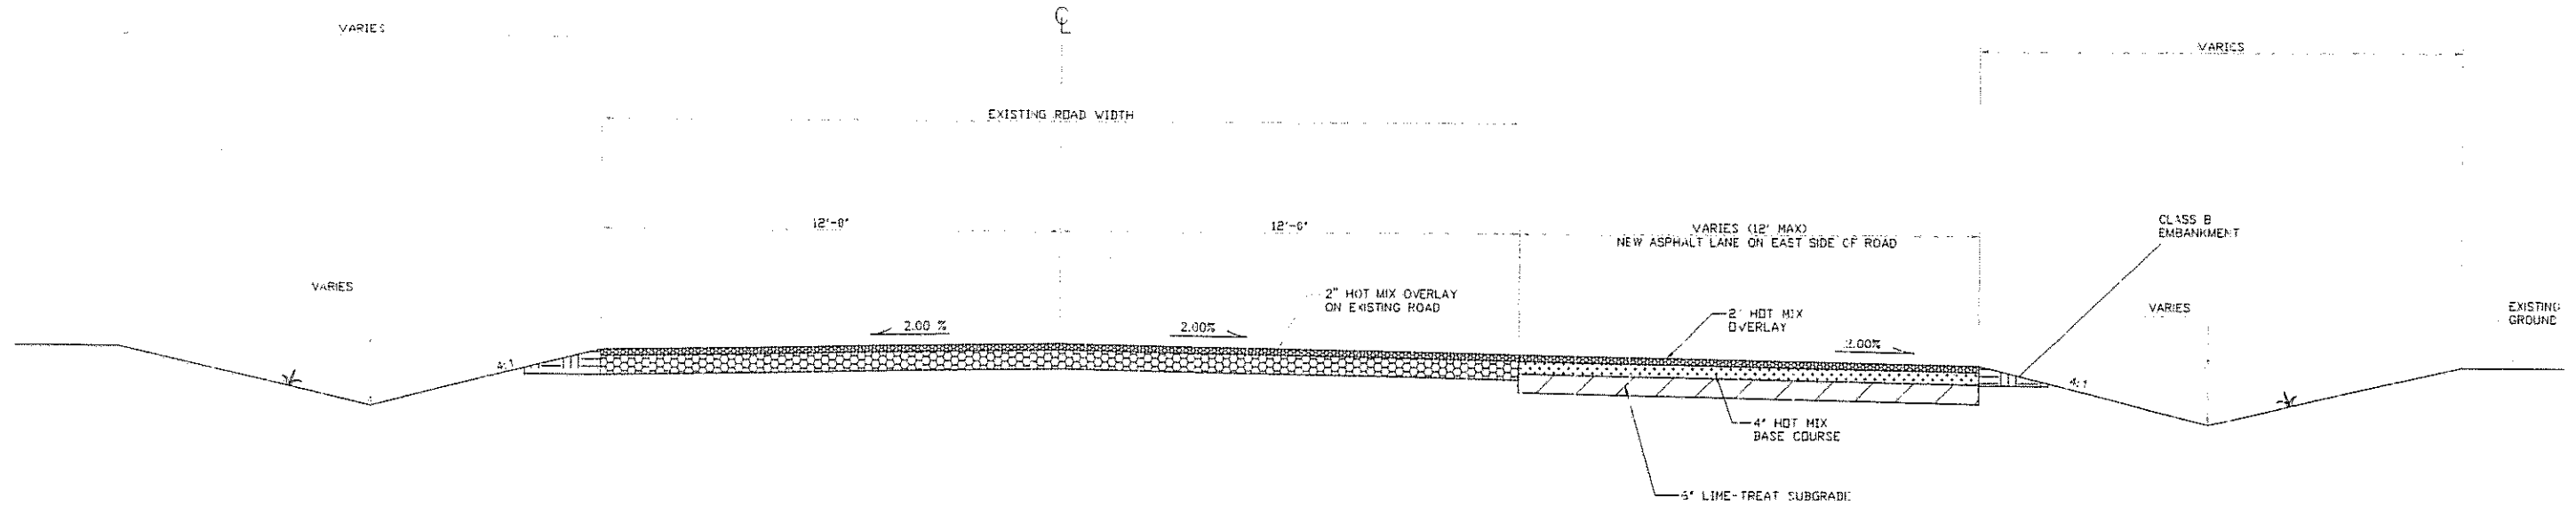

ROAD SECTION

APPROVED FOR
CONSTRUCTION

NOV 11 2004

City of Rockwall Engineering Dept.
City Engineer: _____

NO.	DATE	BY	DESCRIPTION
1	9-18-04	JB	REVISED NOTES



John D. Wright
Nov. 5, 2004

Wright Engineering
9609 La Rochelle
Greenville, TX 75402

DRAWN BY: JERRY KISS-CK
DATE: RANCH TRAIL ROAD & F.M. 3097 (HORIZON RD.)
ROCKWALL, TEXAS

DRAWING NO.:

RTR-1.5

ROAD SECTION - FM 3097 (HORIZON RD.)