


# CONSTRUCTION PLANS FOR PUBLIC WATER & SANITARY SEWER IMPROVEMENTS

## RAYBURN COUNTRY ADDITION AN ADDITION TO THE CITY OF ROCKWALL, ROCKWALL COUNTY, TEXAS

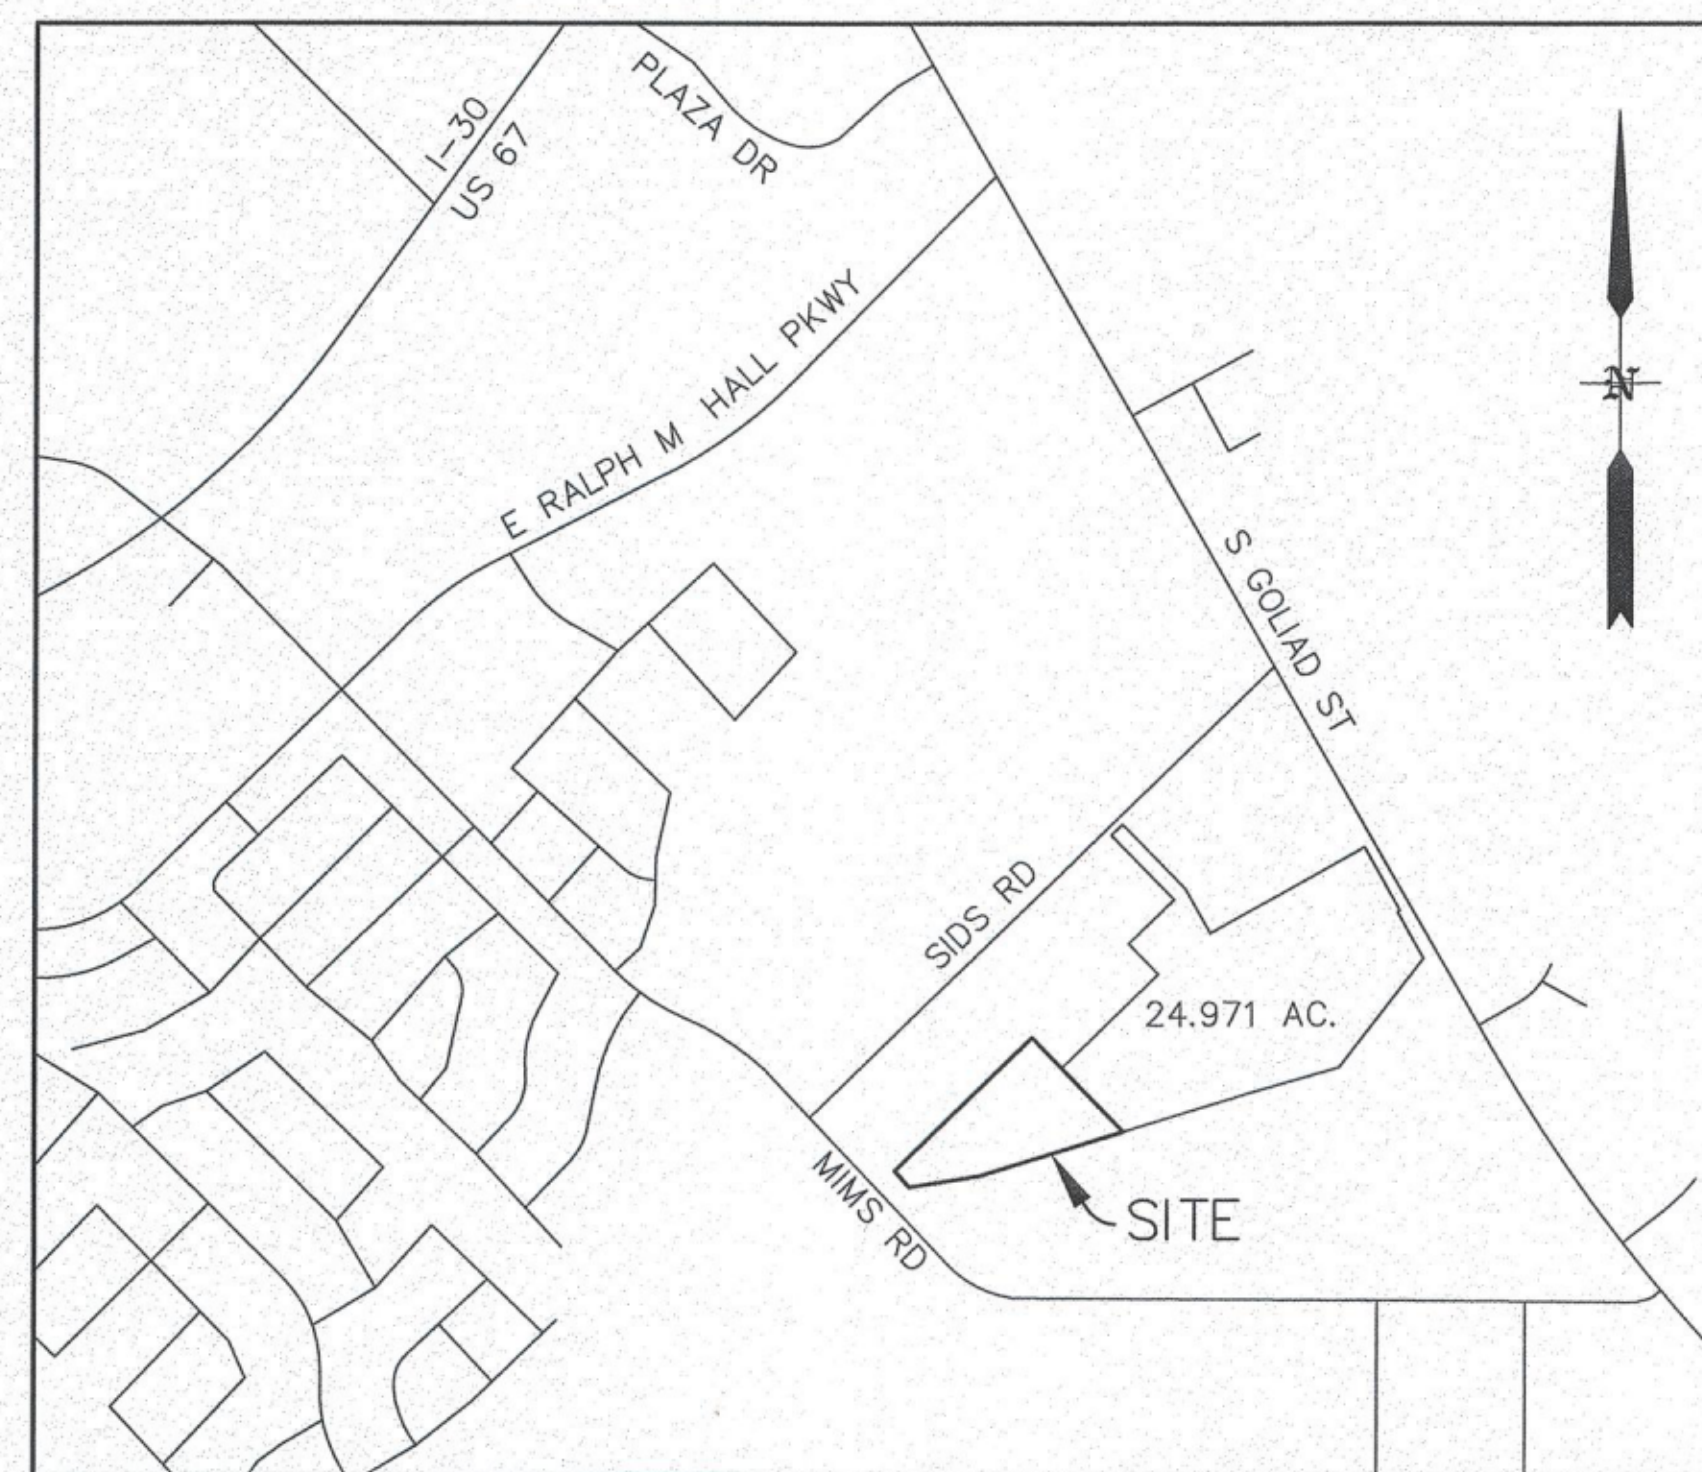

VICINITY MAP  
N.T.S.

### SHEET INDEX

1. COVER SHEET
2. GENERAL NOTES & TYPICAL SECTION
3. OFFSITE WATER LINE W-1 STA. (0+00 - 9+50)
4. OFFSITE WATER LINE W-1 STA. (9+50 -END)
5. SANITARY SEWER LINE "A" PLAN & PROFILE
6. EROSION CONTROL PLAN & DETAILS
7. WATER DETAILS
8. SANITARY SEWER DETAILS

### RECORD DRAWINGS

To the best of our knowledge Engineering Concepts & Design, L.P., hereby states that this plan is As-Built. This information provided is based on surveying at the site and information provided by the contractor.

*Todd Winters* 7-14-14  
TODD WINTERS DATE

RELEASED FOR CONSTRUCTION  
ALL RESPONSIBILITY FOR ADEQUACY OF DESIGN  
REMAINS WITH THE DESIGN ENGINEER. THE CITY  
OF ROCKWALL, IN REVIEWING AND RELEASING  
PLANS FOR CONSTRUCTION, ASSUMES NO  
RESPONSIBILITY FOR ADEQUACY OR ACCURACY  
OF DESIGN.

*Todd Winters* 4-10-14  
CITY DATE

### CAUTION! EXISTING UTILITIES

CONTRACTOR SHOULD CALL 1-800-DIG-TESS PRIOR TO BEGINNING ANY CONSTRUCTION ACTIVITIES FOR EXISTING UTILITY LOCATIONS. EXISTING UTILITIES AND UNDERGROUND FACILITIES INDICATED ON THESE PLANS HAVE BEEN LOCATED FROM REFERENCE INFORMATION. IT IS THE RESPONSIBILITY OF THE CONTRACTOR TO VERIFY BOTH HORIZONTALLY AND VERTICALLY THE LOCATION OF ALL EXISTING UTILITIES AND UNDERGROUND FACILITIES PRIOR TO CONSTRUCTION AND TO TAKE NECESSARY PRECAUTIONS IN ORDER TO PROTECT ALL FACILITIES ENCOUNTERED. THE CONTRACTOR SHALL PRESERVE AND PROTECT ALL EXISTING UTILITIES FROM DAMAGE DURING CONSTRUCTION.

### OWNER

Rayburn Country Electric  
980 Sids Road  
Rockwall, TX 75087  
Telephone: 469.402.2100



ENGINEERING / PROJECT MANAGEMENT /  
CONSTRUCTION SERVICES - FIRM REG. #F-001145  
201 WINDCO CIR, STE 200, WYLIE, TX 75098  
972-941-8400 FAX: 972-941-8401 WWW.ECDLP.COM

### REVISIONS:

DATE: APRIL 2014  
PROJECT NO: 3551  
DWG FILE NAME: COVER (OFFSITE UTILITY).DWG

THIS DOCUMENT IS RELEASED FOR  
THE PURPOSE OF CONSTRUCTION.  
THE SEAL APPEARING ON THIS  
DOCUMENT WAS AUTHORIZED BY  
TODD D. WINTERS, P.E. 87085

