


BENCHMARK:
"X" CUT IN CURB 23'± SOUTH OF EAST DRIVE APPROACH
OF EXISTING RAYBURN COUNTRY ELECTRIC BUILDING.

ENGINEERINGCONCEPTS
& DESIGN, L.P.

ENGINEERING / PROJECT MANAGEMENT /
CONSTRUCTION SERVICES - FIRM REG. #F-001145
201 WINDCO CIR, STE 200, WYLIE, TX 75098
972-941-8400 FAX: 972-941-8401 WWW.ECDLP.COM

REVISIONS:	
DRAWN: TONY	DATE: APRIL 13, 2018
CHECKED: TW	DATE: APRIL 13, 2018
PROJECT NO: 3560	
DWG FILE NAME:	

THIS DOCUMENT IS RELEASED FOR THE
PURPOSE OF CONSTRUCTION.

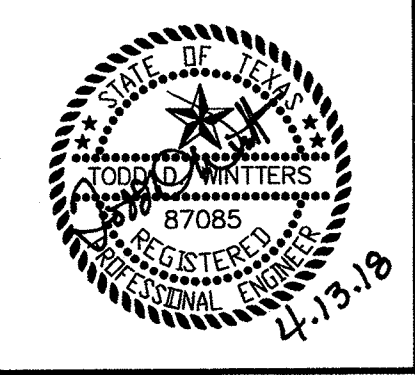

RECORD DRAWINGS

To the best of our knowledge Engineering Concepts & Design, L.P., hereby states that this plan is As-Built. This information provided is based on surveying at the site and information provided by the contractor.

Todd Winters 6-13-19
TODD WINTERS DATE

EXISTING CONCRETE TO REMAIN

REMOVE CONCRETE

DEMOLITION PLAN
RAYBURN ELECTRIC COOP. PHASE 2
LOT 5, BLK 1 RAYBURN COUNTRY ADDITION
CITY OF ROCKWALL, ROCKWALL COUNTY, TEXAS

"Case No. SP2017-041"