
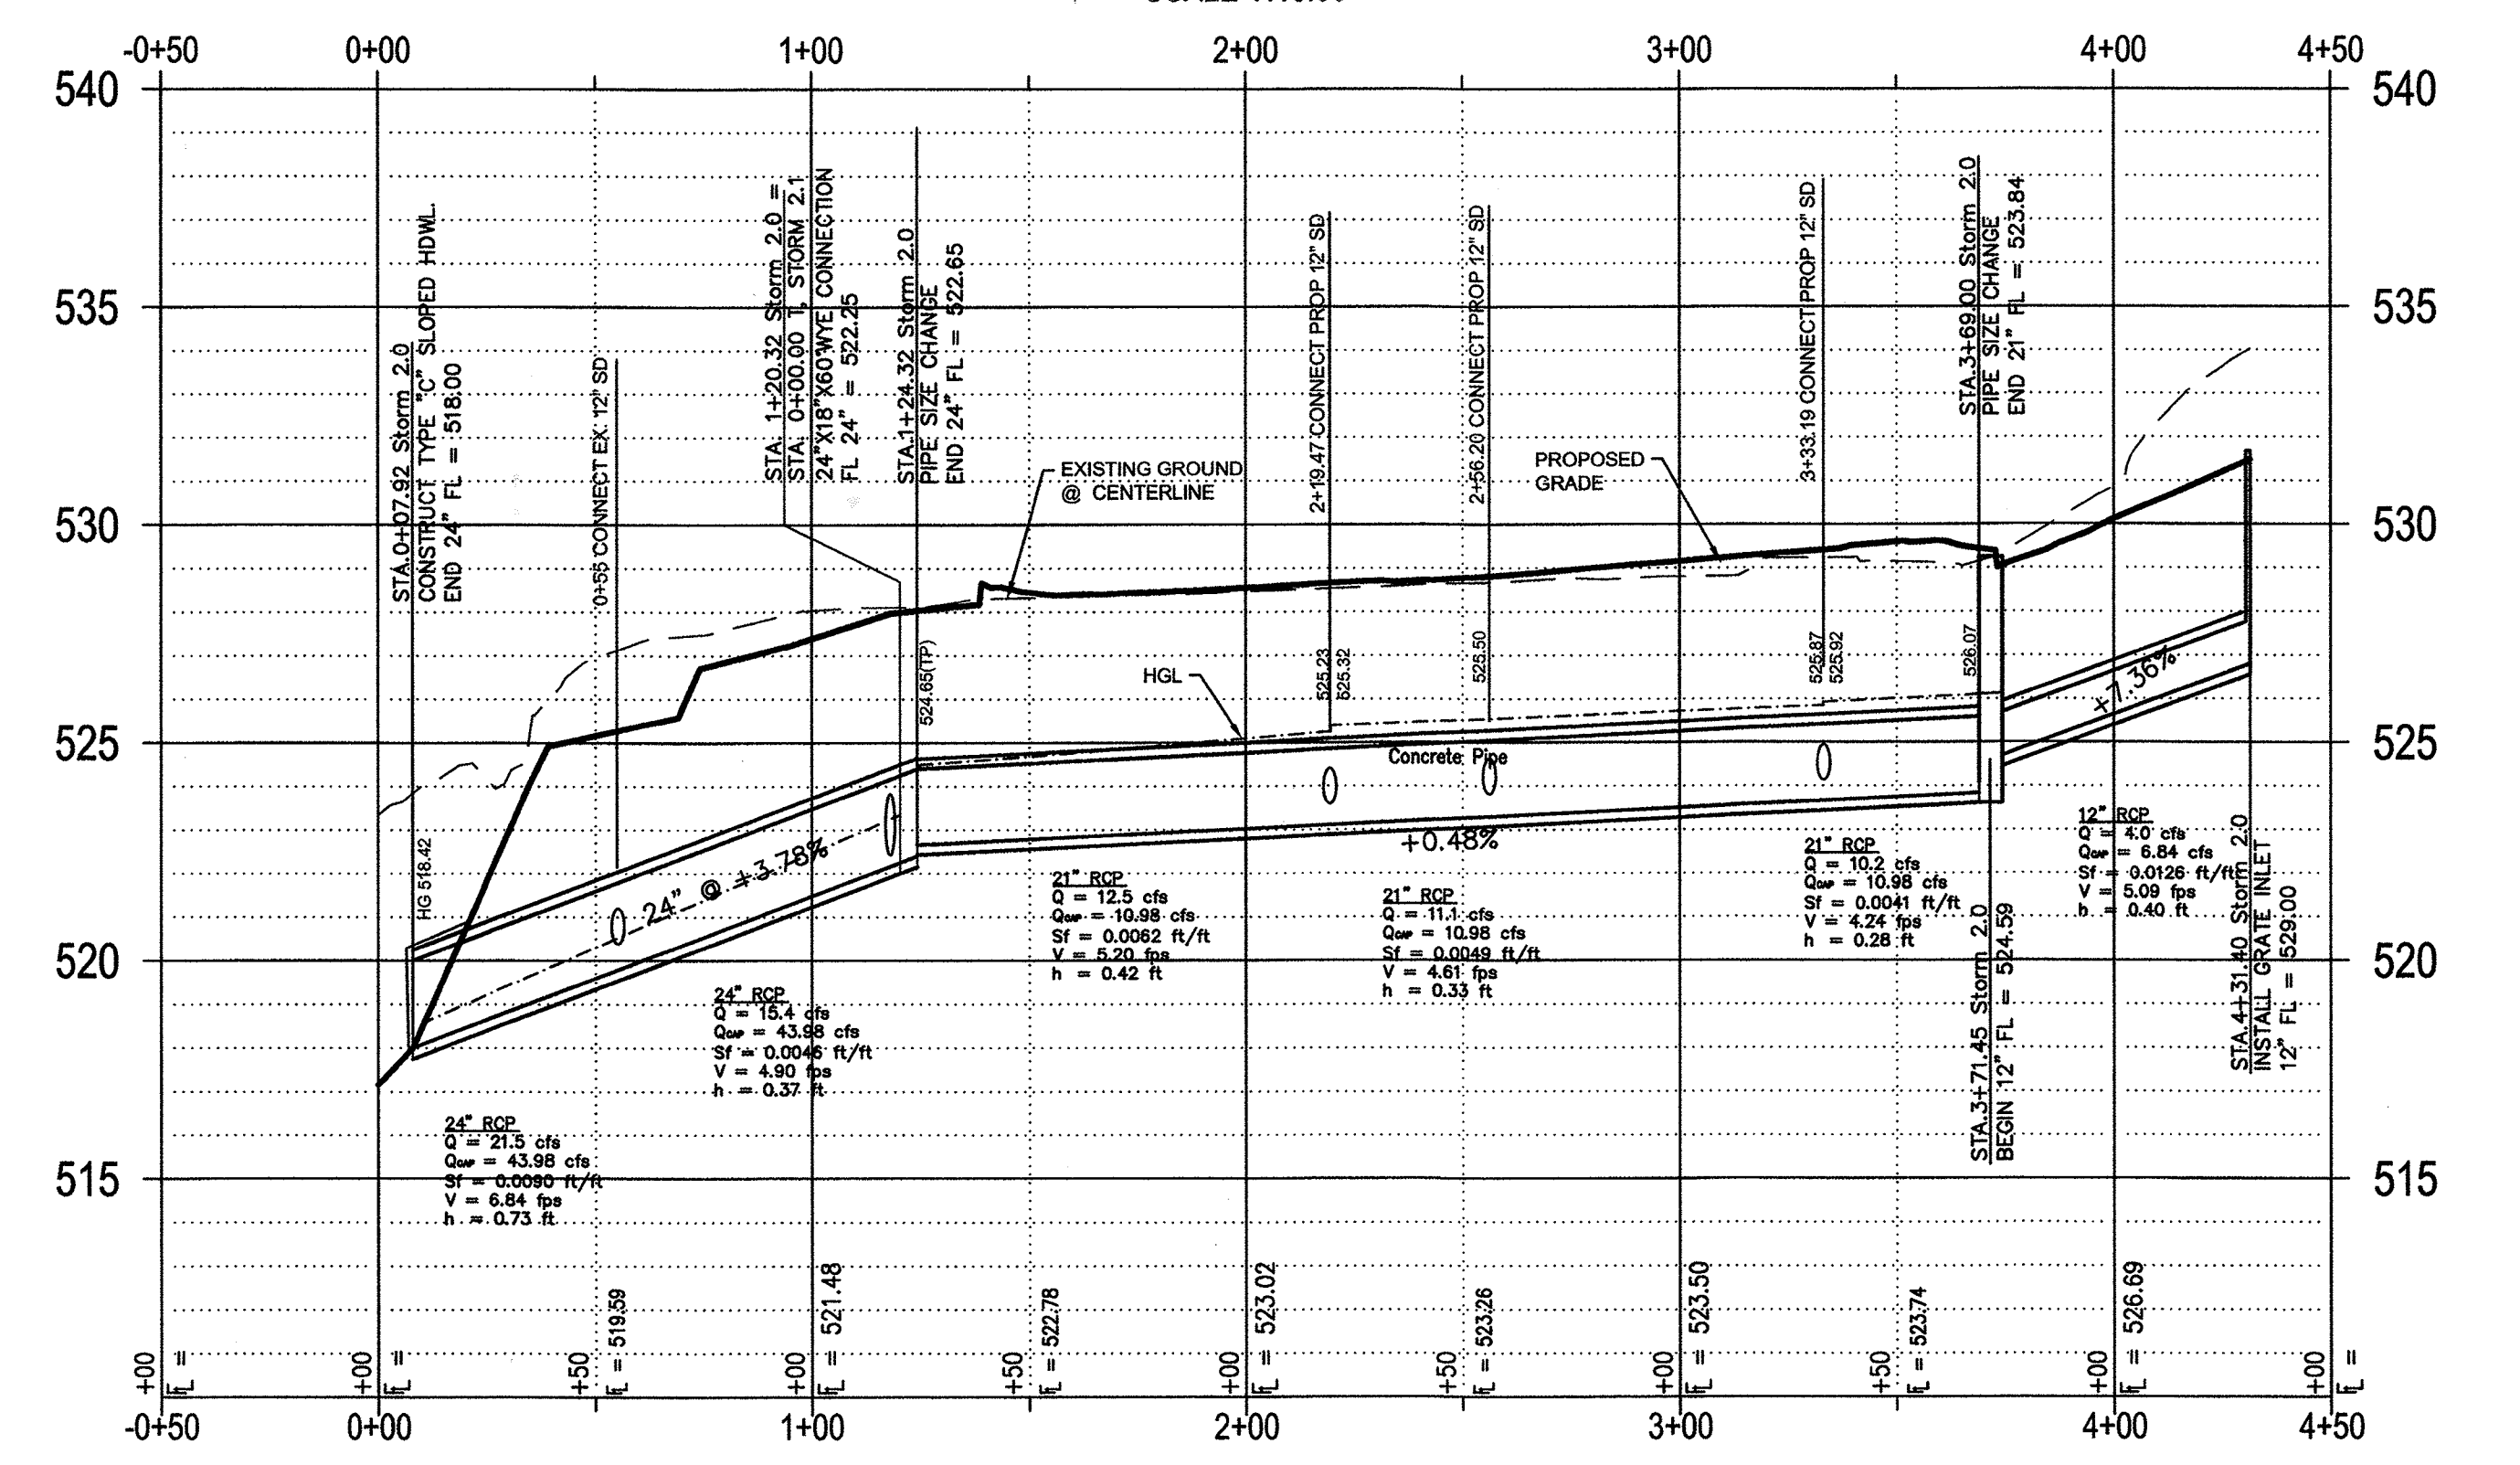
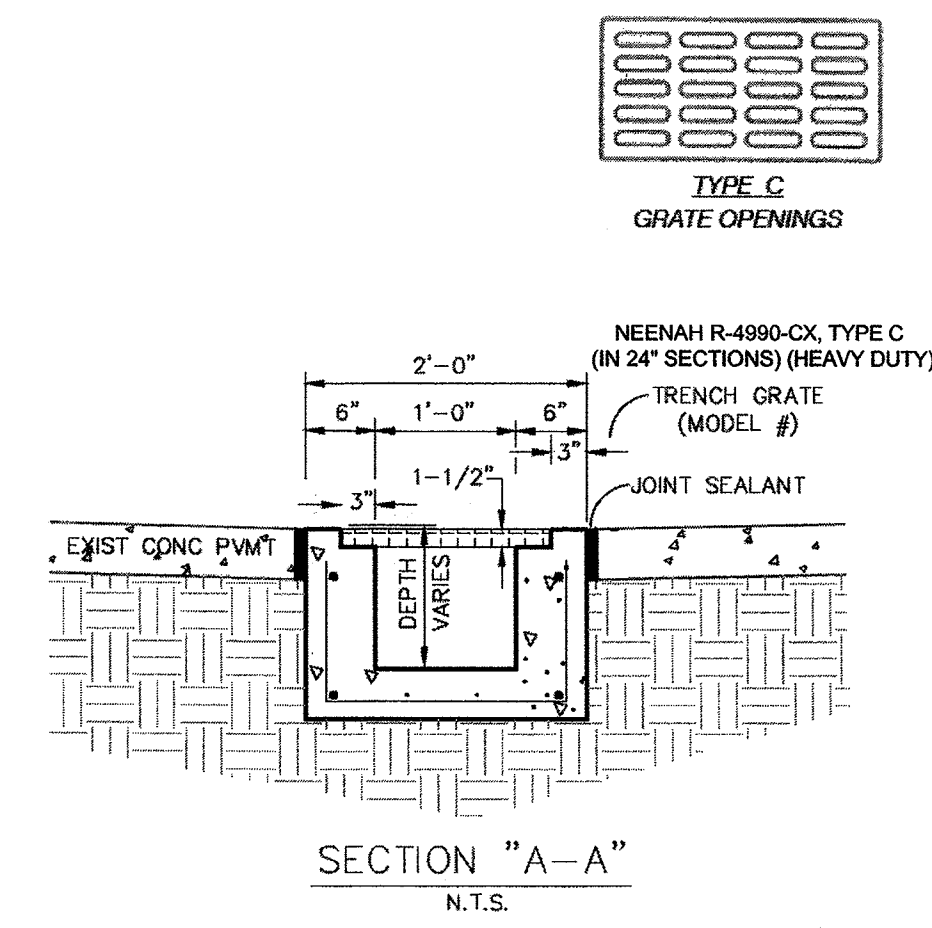


RECORD DRAWINGS
 To the best of our knowledge Engineering Concepts & Design, L.P., hereby states that this plan is As-Built. This information provided is based on surveying at the site and information provided by the contractor.
 Todd Winters 6-13-19
 TODD WINTERS DATE

PRIVATE
 STORM 1.0
 SCALE H: 4
 SCALE V: 10.00

PRIVATE
 STORM 2.0
 SCALE H: 4
 SCALE V: 10.00

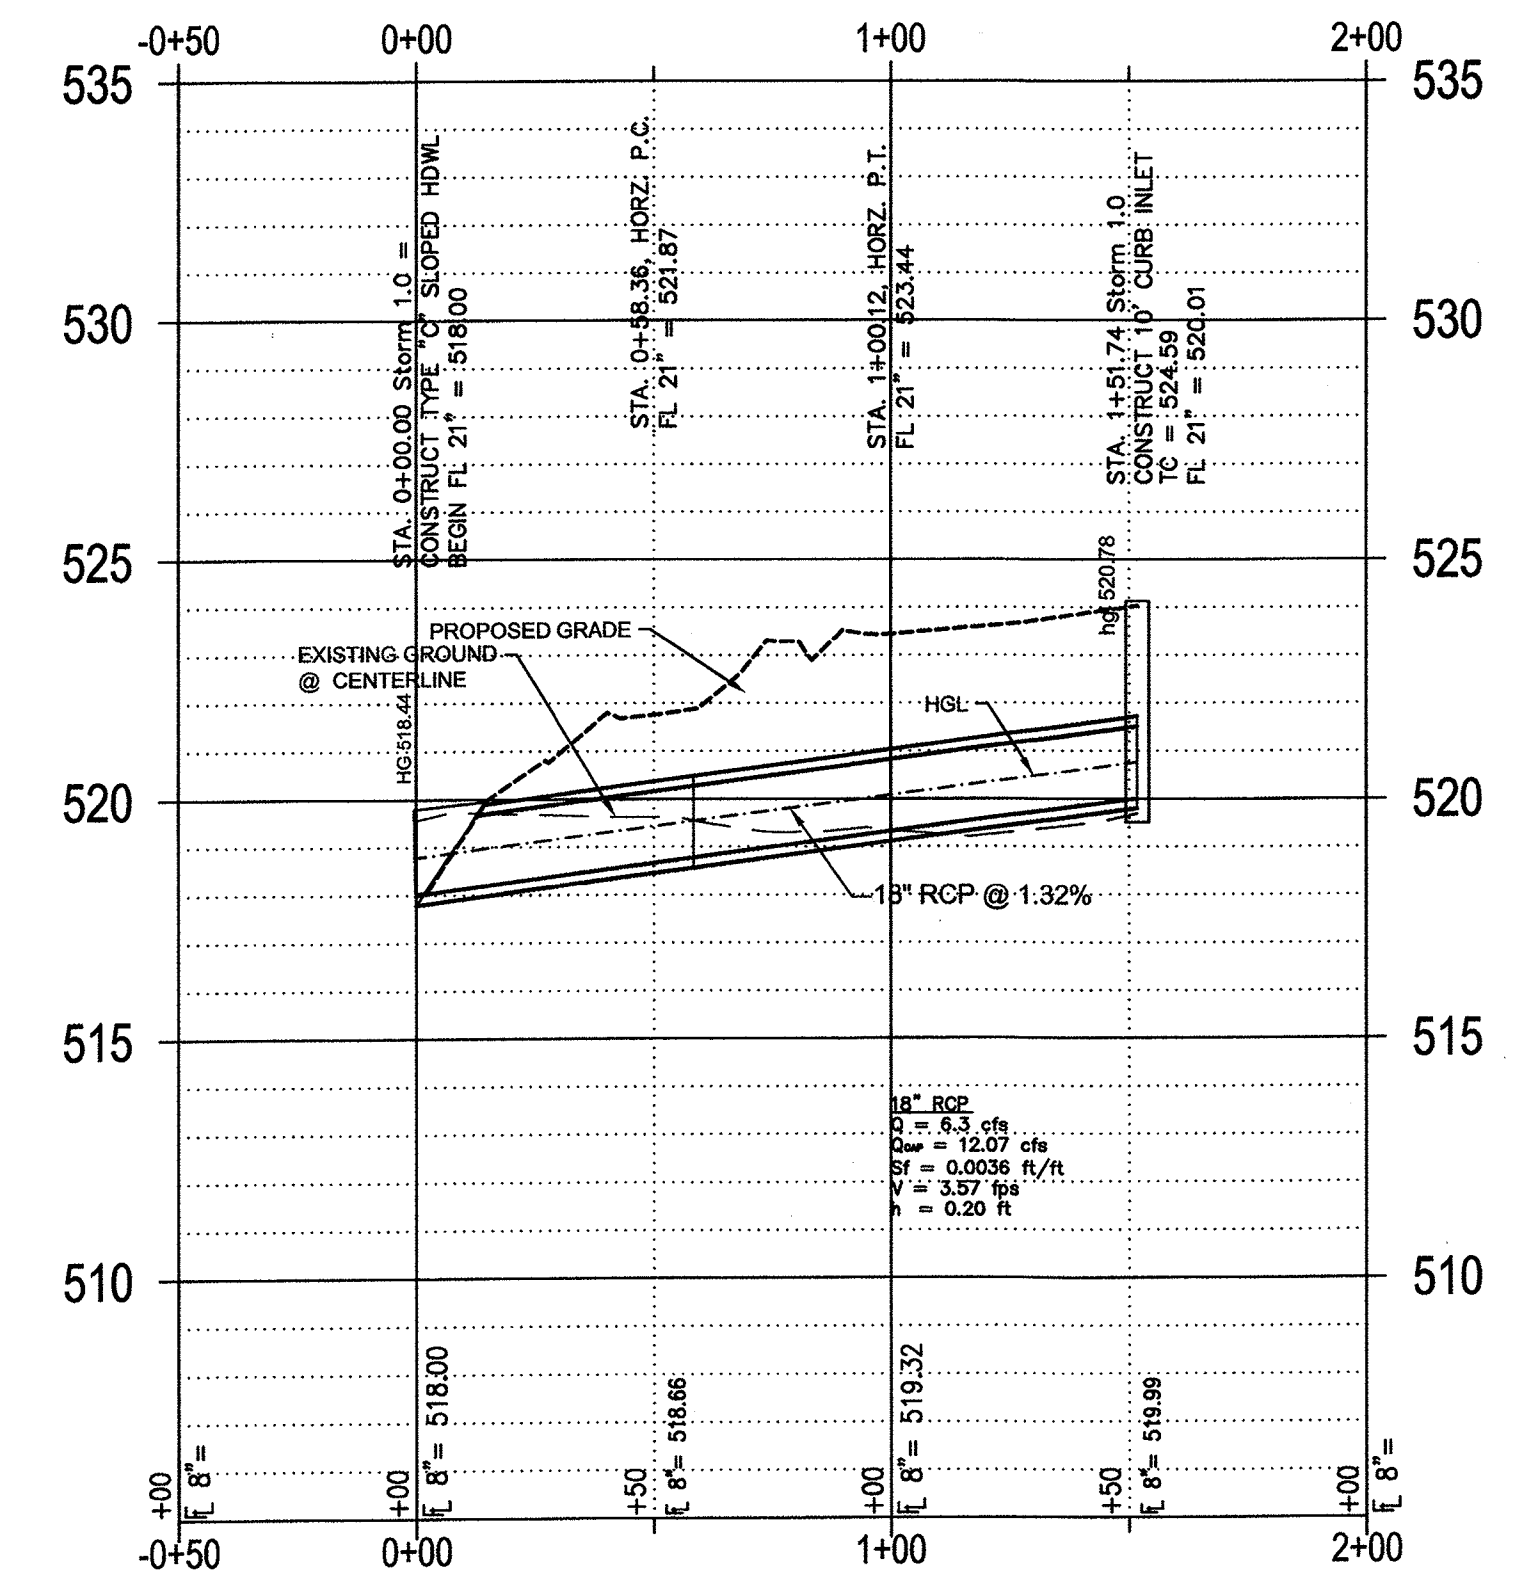

"Case No. SP2017-041"

BENCHMARK:
 "X" CUT IN CURB 23± SOUTH OF EAST DRIVE APPROACH OF EXISTING RAYBURN COUNTRY ELECTRIC BUILDING.

ENGINEERINGCONCEPTS
 & DESIGN, L.P.
 ENGINEERING / PROJECT MANAGEMENT /
 CONSTRUCTION SERVICES - FIRM REG. #F-001145
 201 WINDCO CIR, STE 200, WYLIE, TX 75098
 972-941-8400 FAX: 972-941-8401 WWW.ECDLP.COM

REVISIONS: AUGUST 29, 2018
 REVISED RETAINING WALL, RELOCATED STREET LIGHT, ADDED 12" RCP, ADDED TRENCH DRAIN

DRAWN: TONY	DATE: JUNE 7, 2018
CHECKED: TW	DATE: MAY 23, 2018
PROJECT NO.: 3560	
DWG FILE NAME:	

THIS DOCUMENT IS RELEASED FOR THE PURPOSE OF CONSTRUCTION.



STORM SEWER PLAN & PROFILE
 RAYBURN ELECTRIC COOP. PHASE 2
 LOT 5, BLK 1 RAYBURN COUNTRY ADDITION
 CITY OF ROCKWALL, ROCKWALL COUNTY, TEXAS

SHEET
 09
 OF
 20