




PRIVATE
STORM 2.1
SCALE H: 4
SCALE V:10.00

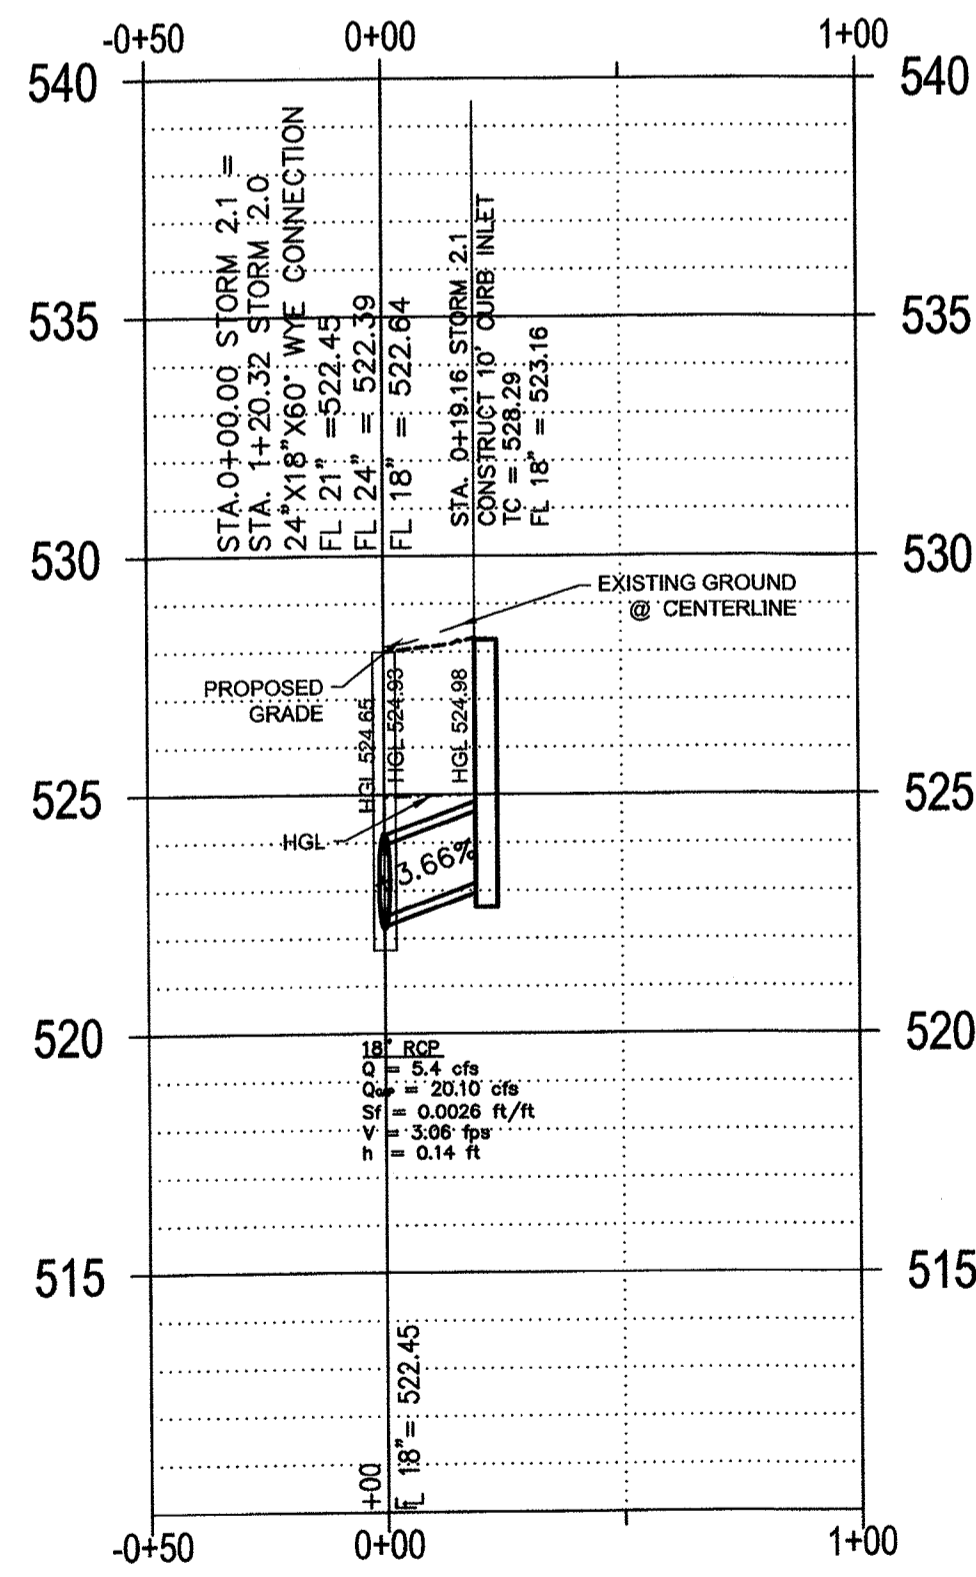


PRIVATE
STORM 4.0
SCALE H: 4
SCALE V:10.00

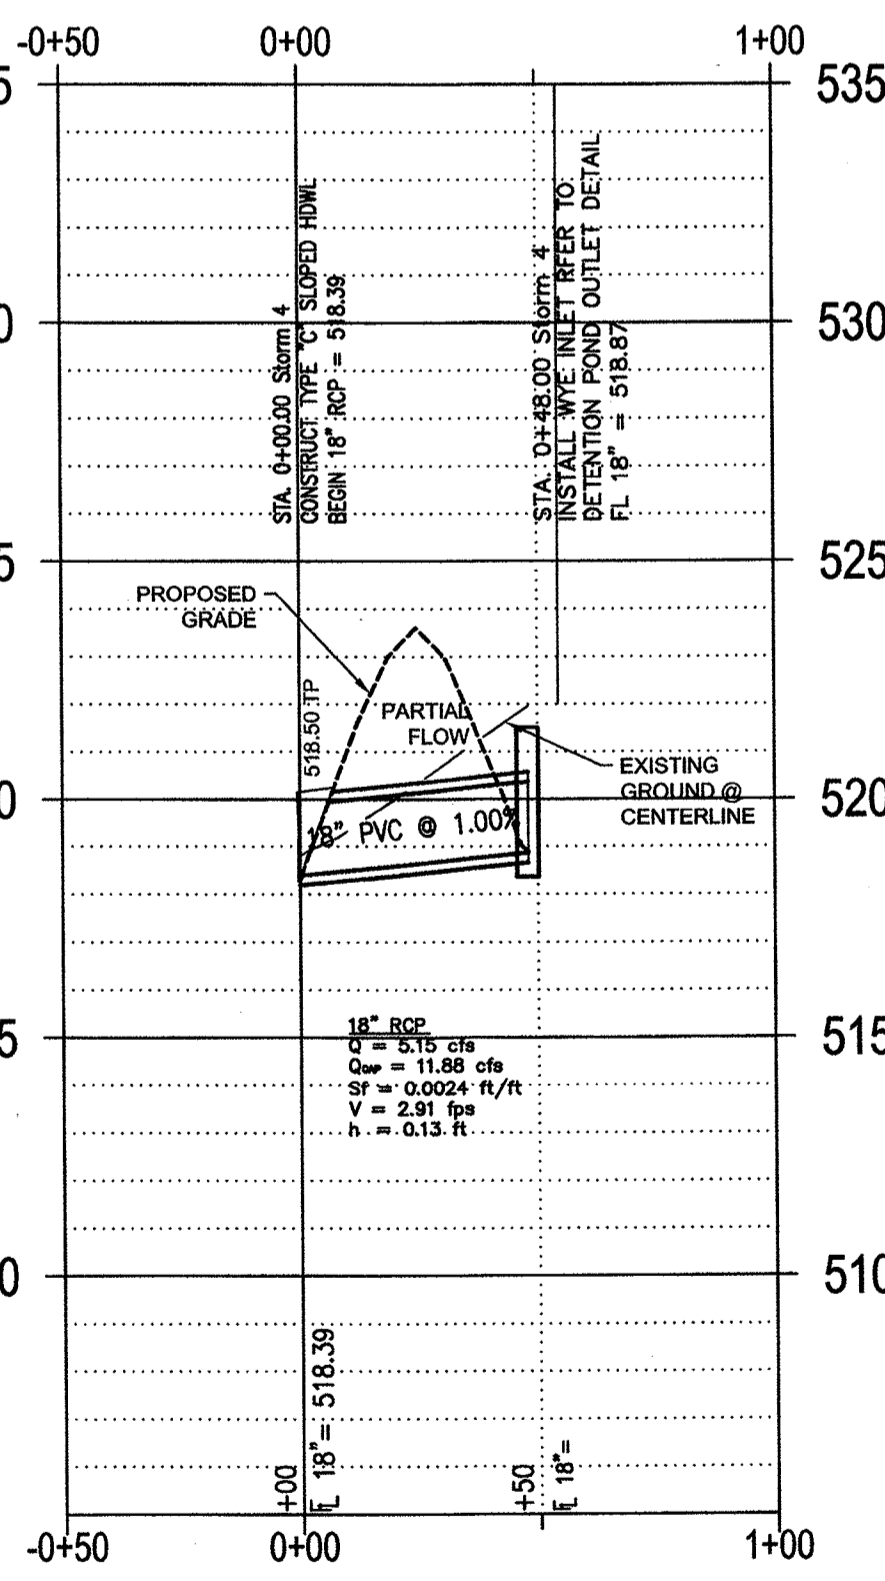

PRIVATE
STORM 1.2
SCALE H: 4
SCALE V:10.00

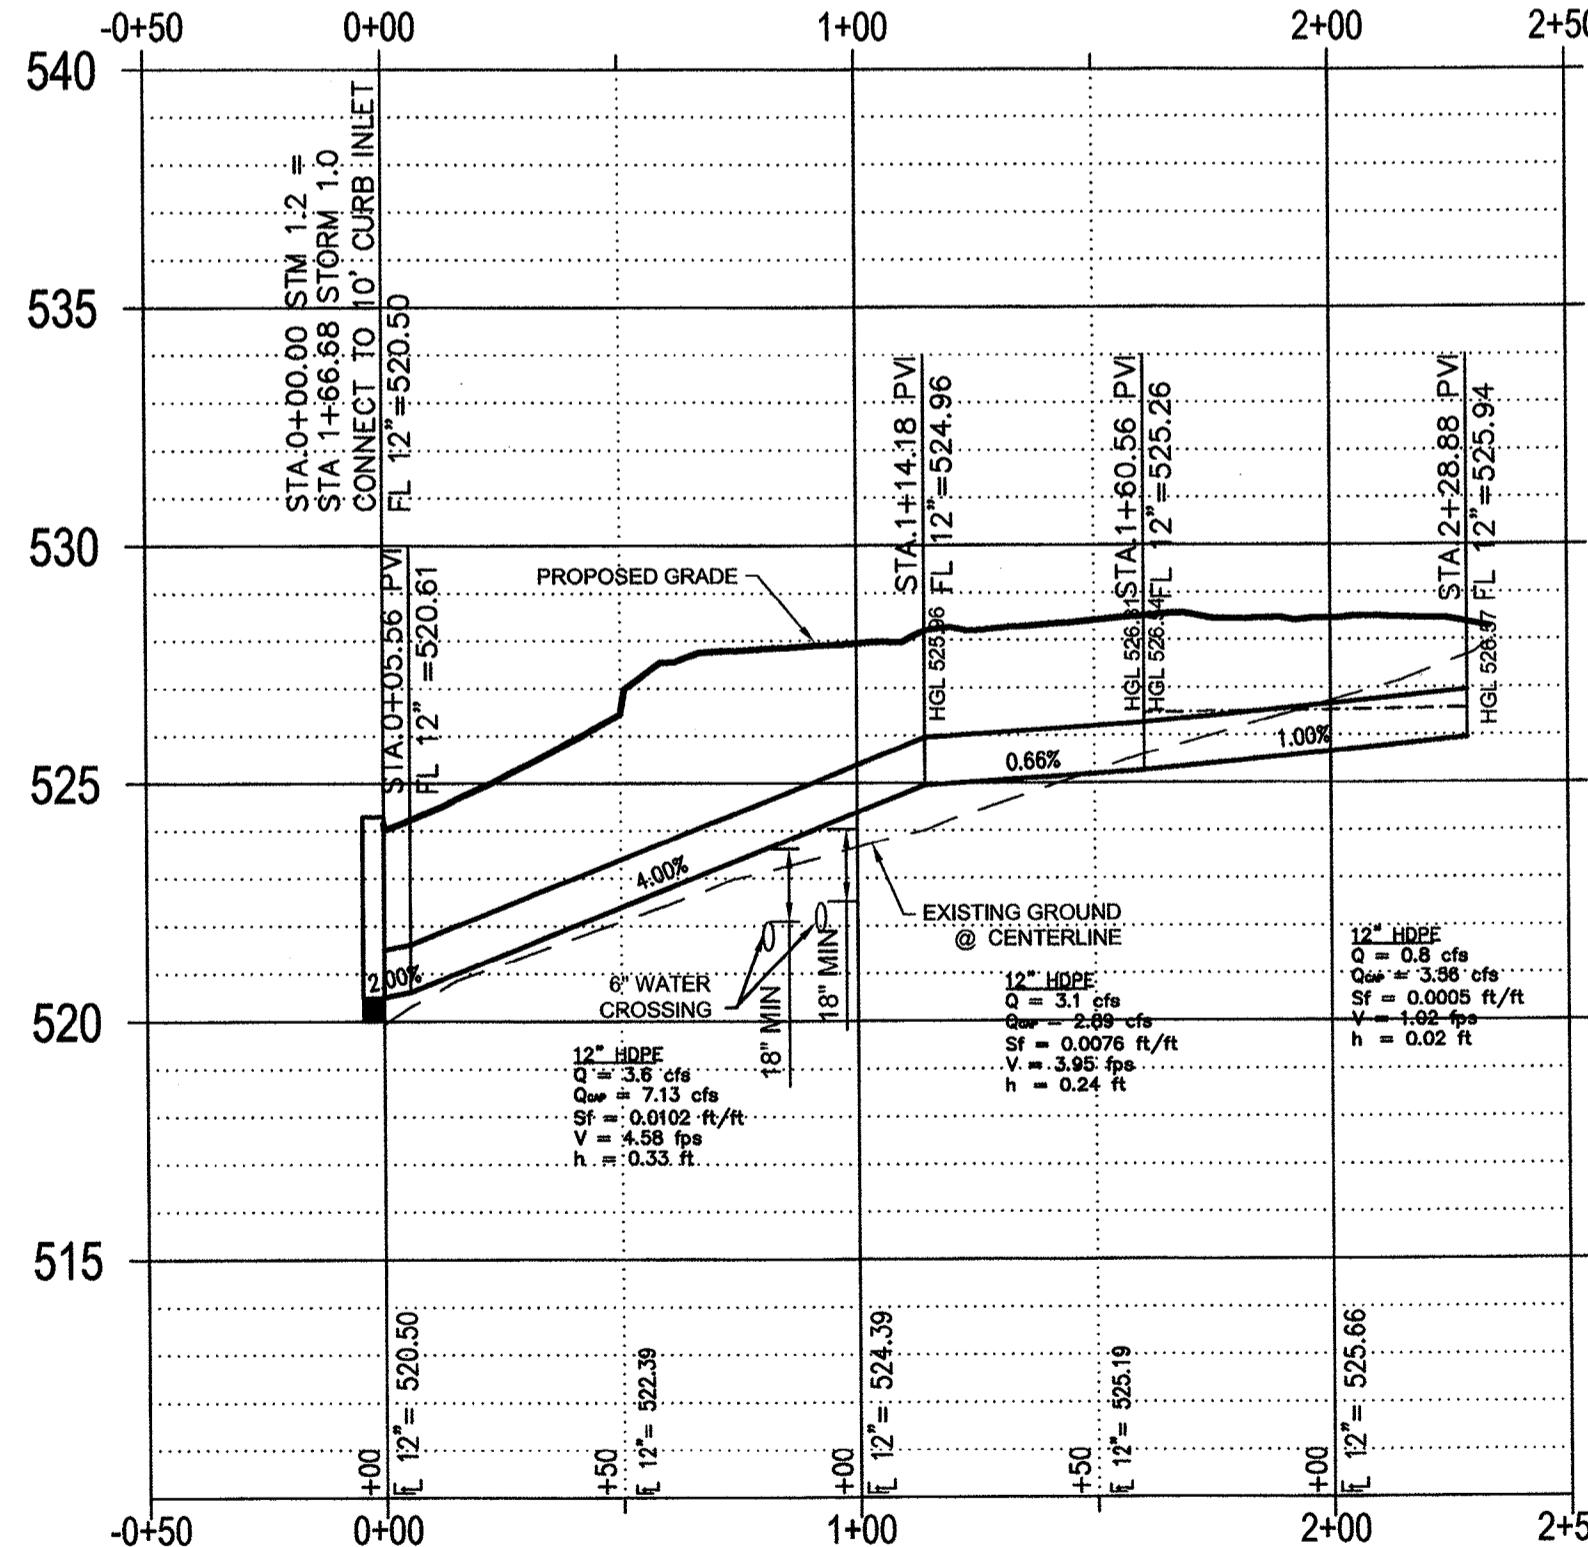

PRIVATE
STORM 3.0
SCALE H: 4
SCALE V:10.00

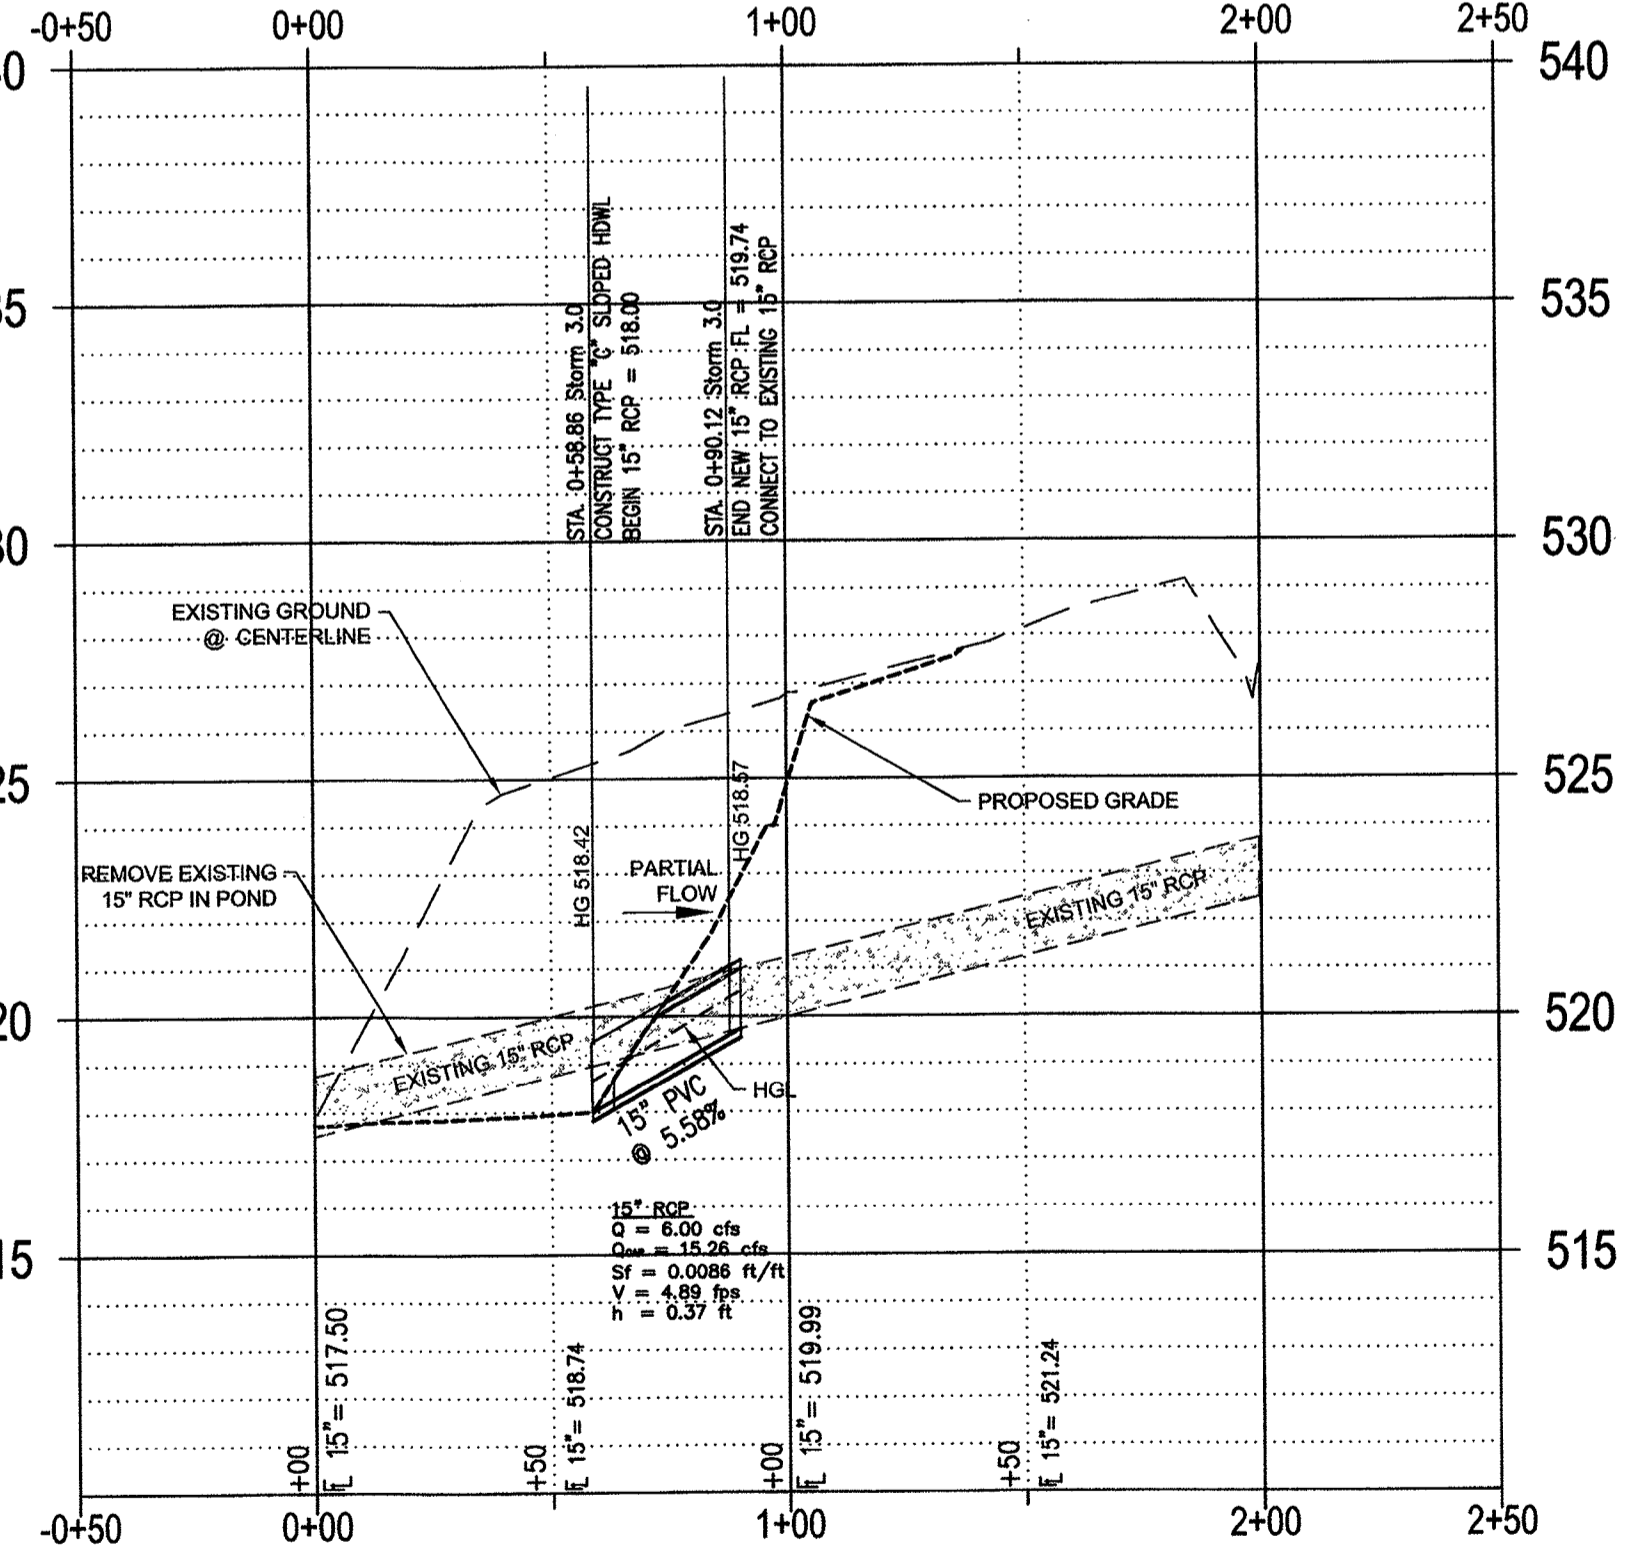

RECORD DRAWINGS
To the best of our knowledge Engineering Concepts & Design, L.P., hereby states that this plan is As-Built. This information provided is based on surveying at the site and information provided by the contractor.
TODD WINTERS 6-13-19 DATE

BENCHMARK:
"X" CUT IN CURB 23± SOUTH OF EAST DRIVE APPROACH OF EXISTING RAYBURN COUNTRY ELECTRIC BUILDING.

ENGINEERINGCONCEPTS
& DESIGN, L.P.
ENGINEERING / PROJECT MANAGEMENT / CONSTRUCTION SERVICES - FIRM REG. #F-001145
201 WINDCO CIR, STE 200, WYLIE, TX 75098
972-941-8400 FAX: 972-941-8401 WWW.ECDLP.COM

REVISIONS:	
DRAWN: TONY	DATE: JUNE 7, 2018
CHECKED: TW	DATE: MAY 23, 2018
PROJECT NO.: 3560	
DWG FILE NAME:	

THIS DOCUMENT IS RELEASED FOR THE PURPOSE OF CONSTRUCTION.



STORM SEWER PLAN & PROFILE
RAYBURN ELECTRIC COOP. PHASE 2
LOT 5, BLK 1 RAYBURN COUNTRY ADDITION
CITY OF ROCKWALL, ROCKWALL COUNTY, TEXAS

"Case No. SP2017-041"

SHEET
10
OF
20