


# CONSTRUCTION PLANS

# REHAB MANAGEMENT & OFFICE COMPLEX

## CITY OF ROCKWALL, TEXAS

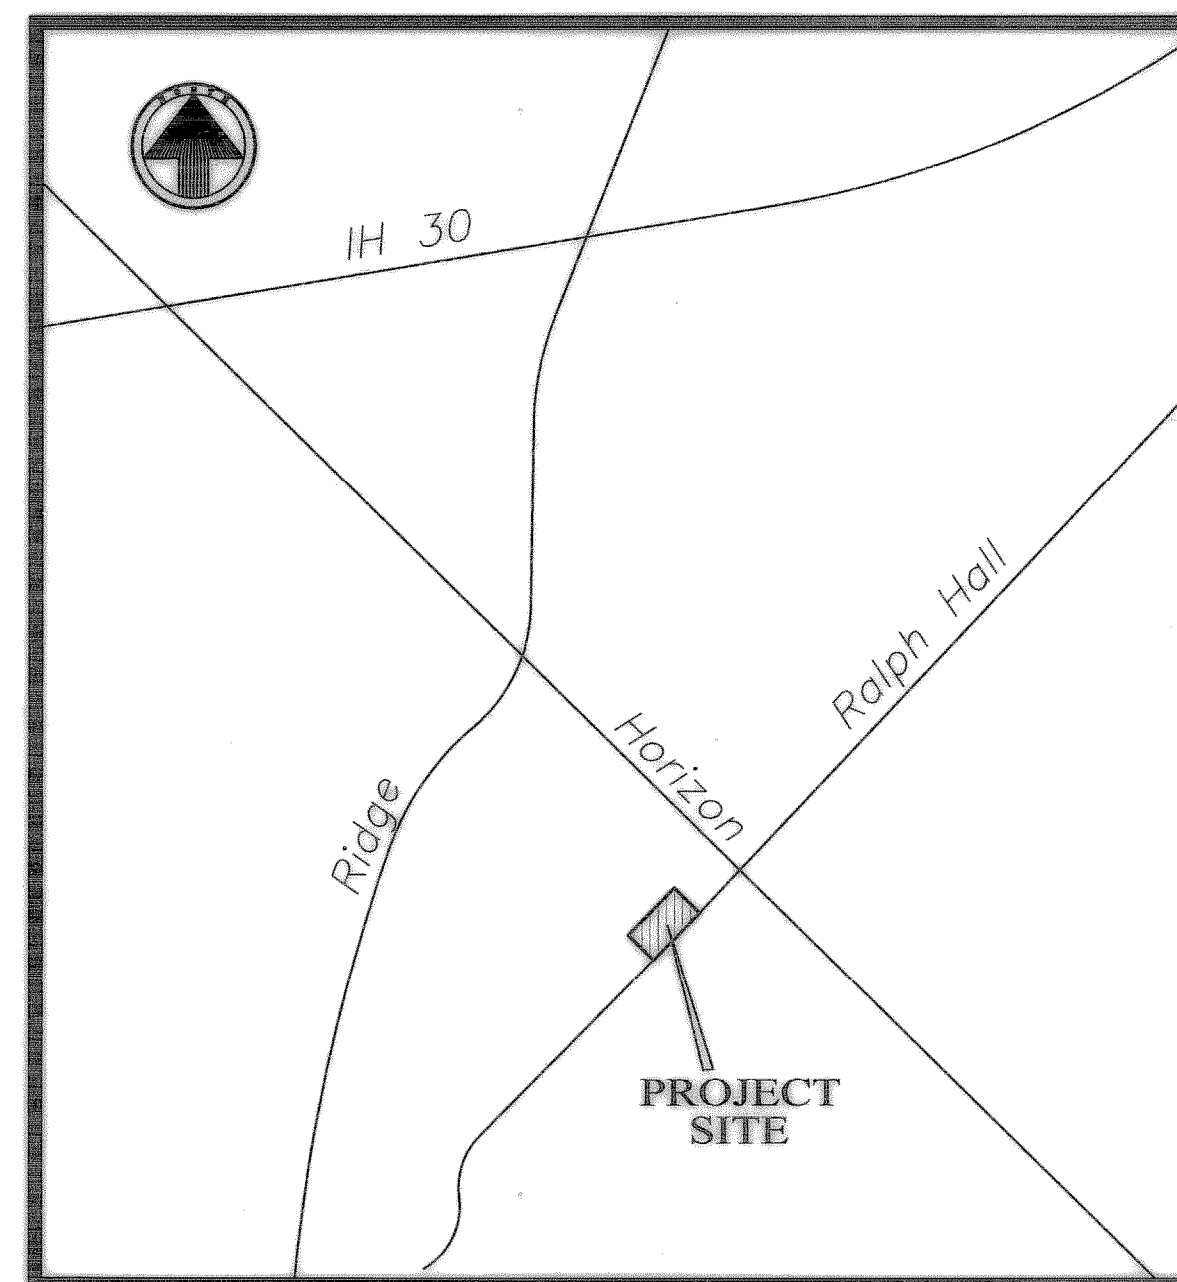


LOCATION MAP

### INDEX of SHEETS

Sheet No.	Title
1	Cover Sheet
2	Re-Plat
3	Paving/Dimensional Control Plan
4	Grading Plan
5	Water & Sanitary Sewer Plan
6	Drainage Area Map/Drainage Plan & Profiles
7	Erosion Control Plan
8	Landscape Plan

*CONSTRUCTION RECORD DRAWINGS*  
10/07/2005

THE SEAL APPEARING ON THIS  
DOCUMENT WAS AUTHORIZED BY  
CHRISTOPHER R. CUNY, P.E. 65642

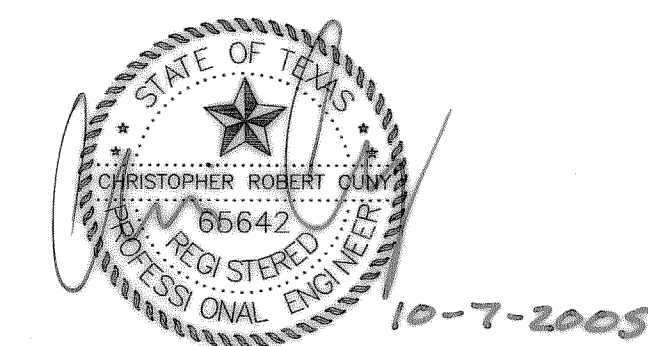

Owner ~ Developer:  
**GORDON VAN AMBURGH**  
435 Columbia Drive  
Rockwall, Texas 75032  
972-771-0999

Engineer ~ Surveyor:  
**F.C. CUNY CORPORATION**

#2 Horizon Court • Heath, Texas 75032 • (469) 402-7700

## December, 2004