





**RALPH HALL PARKWAY**  
Exist. Concrete Pavement With 6" Curb

THE SEAL APPEARING ON THIS DOCUMENT WAS AUTHORIZED BY CHRISTOPHER R. CUNY, P.E. 65642

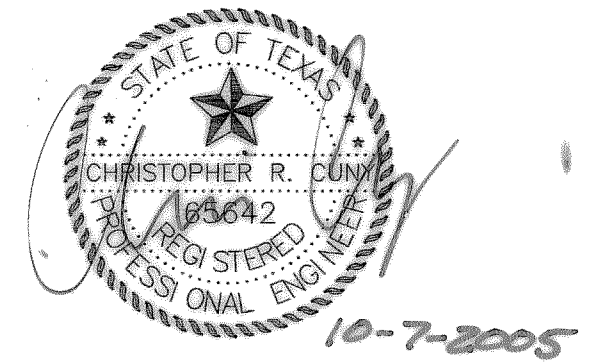

**LEGEND:**

-  6" - 3600 PSI CONCRETE PAVEMENT  
6 1/2 SACK MIN. FOR HAND POUR  
6 SACK MIN. FOR MACHINE POUR
-  5" - 3000 PSI CONCRETE PAVEMENT

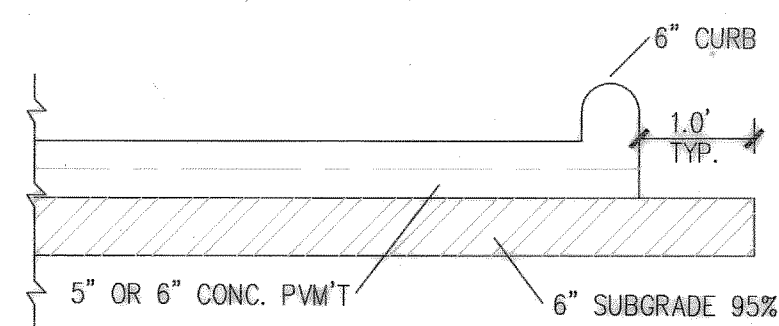

TYPICAL PAVING SECTION  
N.T.S.

**NOTES:**

1. WHERE THE PLASTICITY INDEX OF THE NATURAL SOIL IS EQUAL TO OR EXCEEDS 15, LIME STABILIZED SUBGRADE SHALL BE REQUIRED, A MINIMUM OF 6% BY WEIGHT OF LIME TO A DEPTH OF 6" SHALL BE REQUIRED, IF P.I. IS LESS THAN 15 SUBGRADE SHALL BE 6" THICK AND COMPACTED TO A DENSITY NOT LESS THAN 95% AT 0%-4% OF OPTIMUM MOISTURE CONTENT.
2. ALL CONSTRUCTION TO BE IN CONFORMANCE WITH THE CITY OF ROCKWALL SPECIFICATION AND STANDARDS
3. ALL RADII ARE 2' UNLESS OTHERWISE NOTED
4. ALL DIMENSIONS ARE TO FACE OF CURB AND FACE OF BUILDING UNLESS OTHERWISE NOTED
5. ALL FIRE LANES MUST BE 6" 3600 PSI CONCRETE.

**CONSTRUCTION RECORD DRAWINGS**  
10/07/2005

PAVING/DIMENSIONAL CONTROL PLAN					
Rehab Management and Office Complex					
Gordan Van Amburgh					
City of Rockwall, Rockwall County, Texas					
F.C. CUNY CORPORATION					
#2 Horizon Court • Heath, Texas 75032 • 469-402-7700					
Drawn By:	Checked By:	Date:	Scale:	Project No.:	Sheet No.:
MW	JW	December 04	1" = 20'	04-003	3 of 8