

EXISTING TREE NOTES


- Existing trees to remain shall be protected during construction from tree structure damage and compaction of soil under and around drip line (canopy) of tree.
- If any root structure is damaged during excavation/construction, notify the Architect immediately. It is recommended that a licensed Arborist be secured for the treatment of any possible tree wounds.
- No disturbance of the soil greater than 4" shall be located closer to the tree trunk than 1/2 the distance of the drip line to the tree trunk. A minimum of 75% of the drip line and root zone shall be preserved at natural grade.
- Any fine grading done within the critical root zones of the protected trees must be done with light machinery such as a bobcat or light tractor. No earth moving equipment with tracks is allowed within the critical root zone of the trees.
- Material Storage: No materials intended for use in construction or waste materials accumulated due to excavation or demolition shall be placed within the limits of the drip line of any tree.
- Equipment Cleaning/Liquid Disposal: No equipment may be cleaned, toxic solutions, or other liquid chemicals shall be deposited within the limits of the drip line of a tree. This would include but not be limited to paint, oil, solvents, asphalt, concrete, mortar, primers, etc.
- Tree Attachments: No signs, wires or other attachments, other than those of a protective nature shall be attached to any tree.
- Vehicular Traffic: No vehicular and construction equipment traffic or parking is allowed within the limits of the drip line of trees.
- Boring of Utilities: May be permitted under protected trees in certain circumstances. The minimum length of the bore shall be the width of the tree's canopy and shall be a minimum depth of forty-eight (48) inches.
- Trenching: Any irrigation trenching which must be done within the critical root zone of a tree shall be dug by hand and enter the area in a radial manner.
- Tree Flagging: All trees to be removed from the site shall be flagged by the Contractor with bright red vinyl tape (3" width) wrapped around the main trunk at a height of four (4) feet above grade. Flagging shall be approved by Landscape Architect prior to any tree removal. Contractor shall contact Landscape Architect with 72 hour notice to schedule on-site meeting.
- Protective Fencing: All trees to remain, as noted on drawings, shall have protective fencing located at the tree's drip line. The protective fencing may be comprised of snow fencing, orange vinyl construction fencing, chain link fence or other similar fencing with a four (4) foot approximate height. The protective fencing will be located as indicated on the Tree Protection Detail(s).
- Bark Protection: In situations where a tree remains in the immediate area of intended construction, the tree shall be protected by enclosing the entire circumference of the tree's trunk with lumber encircled with wire or other means that does not damage the tree. Refer to Tree Protection Detail(s).
- Construction Pruning: In a case where a low hanging limb is broken during the course of construction, the Contractor shall notify the Landscape Architect immediately. In no instance shall the Contractor prune any portion of the damaged tree without the prior approval by the Landscape Architect.

EXISTING TREE LEGEND

- TREES TO REMAIN
- TREES TO BE REMOVED

TREE SURVEY FIELD DATA

NO.	DIA. INCHES	SPECIES (COMMON NAME)	REMARKS	NO.	DIA. INCHES	SPECIES (COMMON NAME)	REMARKS	NO.	DIA. INCHES	SPECIES (COMMON NAME)	REMARKS
101	9	CEDAR ELM	TO BE REMOVED	151	10	*CEDAR	TO BE REMOVED	201	10	*CEDAR	TO BE REMOVED
102	12	CEDAR ELM	TO BE REMOVED	152	14	HACKBERRY	TO BE REMOVED	202	36	CEDAR	TO BE REMOVED
103	15	CEDAR ELM	TO BE REMOVED	153	5	*CEDAR	TO BE REMOVED	203	6	*CEDAR	TO BE REMOVED
104	8	*HACKBERRY	TO BE REMOVED	154	10	*CEDAR	TO BE REMOVED	204	15	ASH	TO BE REMOVED
105	10	*HACKBERRY	TO BE REMOVED	155	7	*HACKBERRY	TO BE REMOVED	205	24	CEDAR	TO BE REMOVED
106	36	HACKBERRY	TO BE REMOVED	156	29	CEDAR ELM	TO BE REMOVED	206	8	*CEDAR	TO BE REMOVED
107	6	CEDAR ELM	TO BE REMOVED	157	12	HACKBERRY	TO BE REMOVED	207	6	*CEDAR	TO BE REMOVED
108	9	*HACKBERRY	TO BE REMOVED	158	5	CEDAR	TO BE REMOVED	208	12	ASH	TO REMAIN
109	5	*HACKBERRY	TO BE REMOVED	159	12	CEDAR	TO BE REMOVED	209	12	CEDAR	TO REMAIN
110	5	CEDAR ELM	TO BE REMOVED	160	8	*CEDAR	TO BE REMOVED	210	9	*CEDAR	TO BE REMOVED
111	11	ASH	TO BE REMOVED	161	10	*CEDAR	TO BE REMOVED	211	20	*COTTONWOOD	TO BE REMOVED
112	13	ASH	TO BE REMOVED	162	8	*CEDAR	TO BE REMOVED	212	12	*COTTONWOOD	TO BE REMOVED
113	8	*HACKBERRY	TO BE REMOVED	163	8	*CEDAR	TO BE REMOVED	213	12	CEDAR	TO BE REMOVED
114	8	*HACKBERRY	TO BE REMOVED	164	11	CEDAR	TO BE REMOVED	214	16	CEDAR	TO BE REMOVED
115	9	CEDAR ELM	TO BE REMOVED	165	12	CEDAR	TO BE REMOVED	215	15	CEDAR	TO BE REMOVED
116	8	CEDAR ELM	TO BE REMOVED	166	13	CEDAR	TO BE REMOVED	216	8	CEDAR ELM	TO BE REMOVED
117	8	*HACKBERRY	TO BE REMOVED	167	20	HACKBERRY	TO BE REMOVED	217	10	*HACKBERRY	TO BE REMOVED
118	4	*HACKBERRY	TO BE REMOVED	168	11	CEDAR	TO BE REMOVED	218	6	CEDAR ELM	TO BE REMOVED
119	9	CEDAR ELM	TO BE REMOVED	169	7	CEDAR ELM	TO BE REMOVED	219	10	CEDAR ELM	TO BE REMOVED
120	6	*HACKBERRY	TO BE REMOVED	170	14	CEDAR	TO BE REMOVED	220	4	CEDAR ELM	TO BE REMOVED
121	6	*HACKBERRY	TO BE REMOVED	171	12	CEDAR	TO BE REMOVED	221	15	CEDAR ELM	TO BE REMOVED
122	10	*HACKBERRY	TO BE REMOVED	172	20	CEDAR	TO BE REMOVED	222	12	HACKBERRY	TO BE REMOVED
123	11	CEDAR ELM	TO BE REMOVED	173	4	*CEDAR	TO BE REMOVED	223	5	CEDAR ELM	TO BE REMOVED
124	4	*HACKBERRY	TO BE REMOVED	174	6	*HACKBERRY	TO BE REMOVED	224	12	CEDAR ELM	TO BE REMOVED
125	10	*HACKBERRY	TO BE REMOVED	175	6	*CEDAR	TO BE REMOVED	225	12	ASH	TO BE REMOVED
126	5	*CEDAR	TO BE REMOVED	176	10	CEDAR ELM	TO BE REMOVED	226	7	CEDAR ELM	TO BE REMOVED
127	5	*CEDAR	TO BE REMOVED	177	7	*CEDAR	TO BE REMOVED	227	7	CEDAR ELM	TO BE REMOVED
128	5	*CEDAR	TO BE REMOVED	178	15	CEDAR	TO BE REMOVED	228	12	CEDAR ELM	TO BE REMOVED
129	7	CEDAR ELM	TO BE REMOVED	179	8	CEDAR ELM	TO BE REMOVED	229	24	*COTTONWOOD	TO BE REMOVED
130	9	*HACKBERRY	TO BE REMOVED	180	8	CEDAR ELM	TO BE REMOVED				
131	6	*HACKBERRY	TO BE REMOVED	181	12	CEDAR ELM	TO BE REMOVED				
132	10	*HACKBERRY	TO BE REMOVED	182	6	CEDAR ELM	TO BE REMOVED				
133	8	CEDAR ELM	TO BE REMOVED	183	11	CEDAR	TO BE REMOVED				
134	10	*HACKBERRY	TO BE REMOVED	184	12	CEDAR	TO BE REMOVED				
135	6	*CEDAR	TO BE REMOVED	185	36	CEDAR ELM	TO BE REMOVED				
136	10	*HACKBERRY	TO BE REMOVED	186	4	*CEDAR	TO BE REMOVED				
137	7	*HACKBERRY	TO BE REMOVED	187	11	CEDAR ELM	TO BE REMOVED				
138	6	*HACKBERRY	TO BE REMOVED	188	8	*CEDAR	TO BE REMOVED				
139	13	CEDAR ELM	TO BE REMOVED	189	12	CEDAR	TO BE REMOVED				
140	5	CEDAR ELM	TO BE REMOVED	190	7	CEDAR ELM	TO BE REMOVED				
141	6	CEDAR ELM	TO BE REMOVED	191	10	ASH	TO BE REMOVED				
142	5	CEDAR ELM	TO BE REMOVED	192	14	HACKBERRY	TO BE REMOVED				
143	11	CEDAR ELM	TO BE REMOVED	193	9	ASH	TO BE REMOVED				
144	10	*HACKBERRY	TO BE REMOVED	194	7	ASH	TO BE REMOVED				
145	10	*HACKBERRY	TO BE REMOVED	195	15	CEDAR ELM	TO BE REMOVED				
146	12	CEDAR	TO BE REMOVED	196	9	*CEDAR	TO BE REMOVED				
147	6	*HACKBERRY	TO BE REMOVED	197	8	CEDAR ELM	TO BE REMOVED				
148	5	*CEDAR	TO BE REMOVED	198	8	CEDAR ELM	TO BE REMOVED				
149	4	*CEDAR	TO BE REMOVED	199	8	CEDAR ELM	TO BE REMOVED				
150	5	*CEDAR	TO BE REMOVED	200	4	CEDAR ELM	TO BE REMOVED				

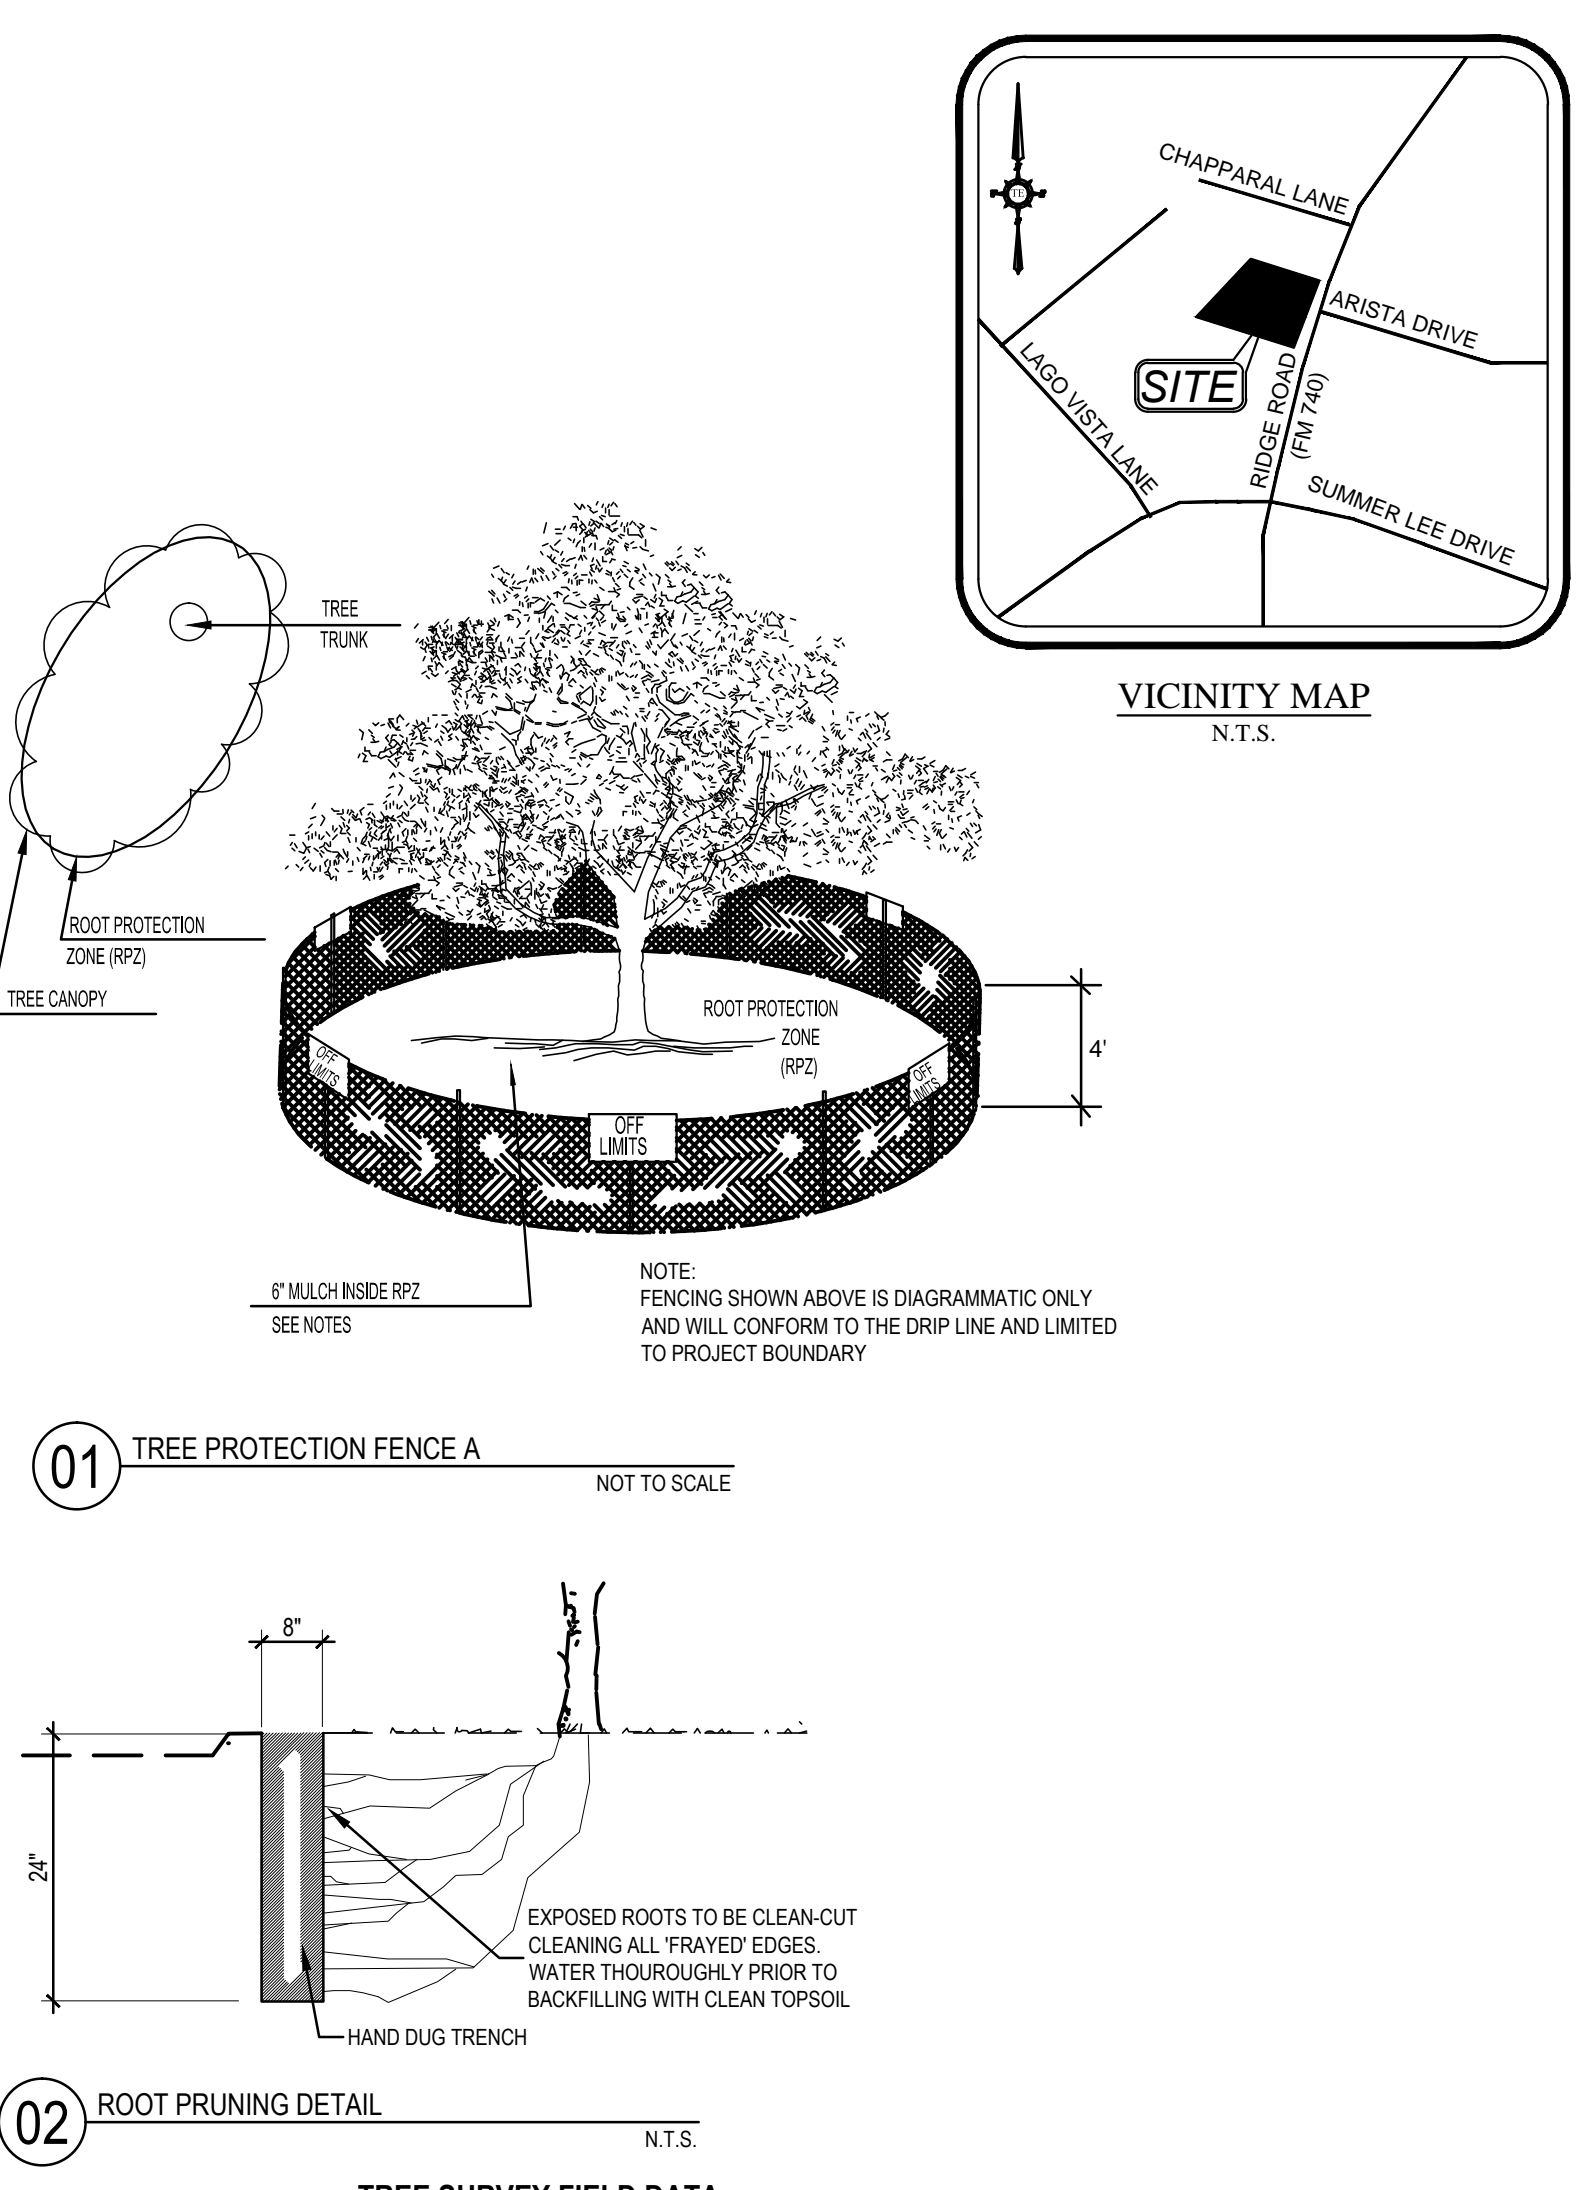

01 EXISTING TREE PLAN
SCALE: 1" = 20'-0"

TOTAL CALIPER INCHES REMOVED: 1334"
TOTAL MITIGATION: 715.5"

TREES TO BE PLANTED FOR MITIGATION: 20"
MITIGATION BALANCE DUE: 695.5"

smr
landscape architects, inc.
1708 N. Griffin Street
Dallas, Texas 75202
Tel: 214.871.0063
Fax: 214.871.0545
Email: smr@smr-la.com

TO THE BEST OF OUR KNOWLEDGE SMR LANDSCAPE ARCHITECTS INC. STATES THAT THIS PLAN IS AS-BUILT. THIS INFORMATION PROVIDED IS BASED ON SURVEYING AT THE SITE AND INFORMATION PROVIDED BY THE CONTRACTOR

CASE # SP2014-003

TRIANGLE ENGINEERING, L.L.C.
TX TYPE FIRM # 11525
1509 ASTORIA DRIVE, ALLEN, TX 75013
PHONE: 214-609-9271

BY: KJP
DATE: _____
NO: _____
DESCRIPTION: _____

STATE OF TEXAS
LANDSCAPE ARCHITECT
06.25.2015

MEDICAL OFFICE
3018 RIDGE ROAD
ROCKWALL, TEXAS

EXISTING TREE PLAN
PROJECT No: 13-035
DATE: 02/10/2014
DRAWN BY: CT
CHECKED BY: CT

SHEET # L.1 REVISION #

RECORD DRAWINGS