


CONSTRUCTION PLANS TO SERVE

RIDGE ROAD RETAIL CENTER

2930 SOUTH RIDGE ROAD
LOT 26R, LAKERIDGE ESTATES
ROCKWALL, TEXAS

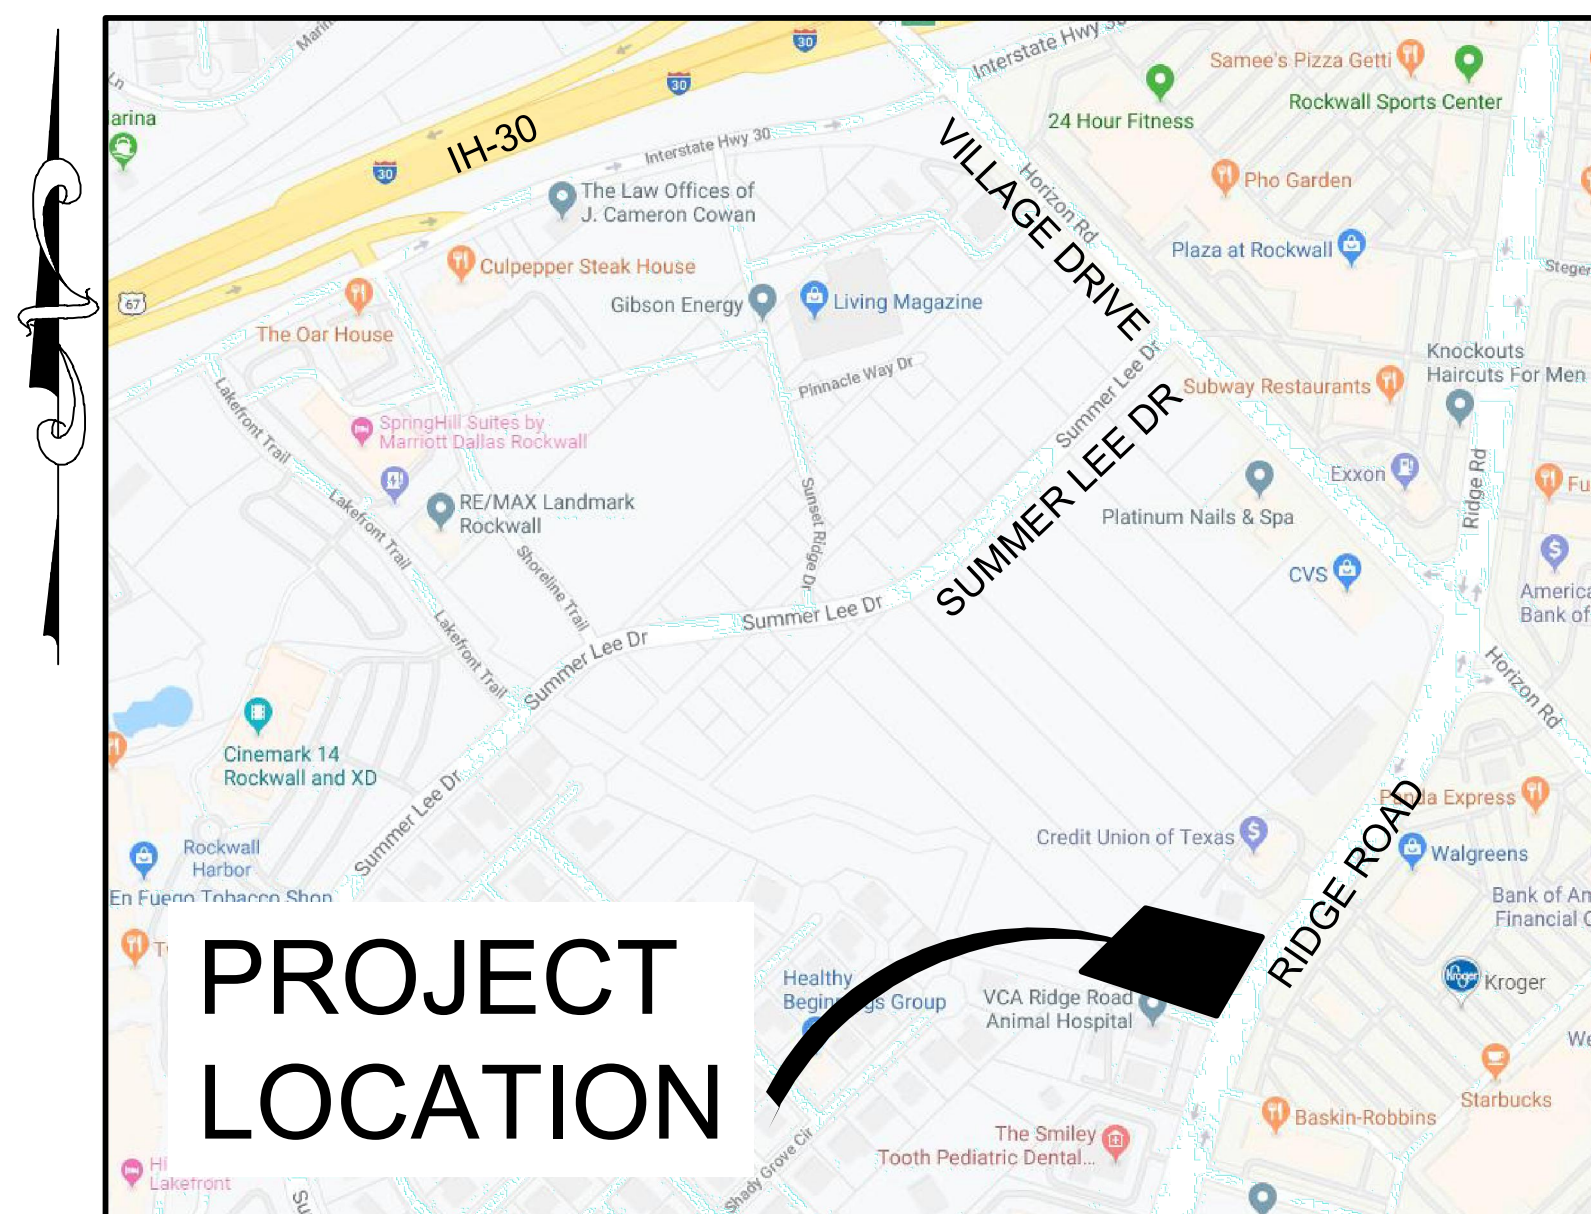

**PROJECT
LOCATION**

LOCATION MAP

N.T.S.

SHEET INDEX

| SHEET NO. | DESCRIPTION |
|-----------|---|
| C0.00 | COVER SHEET |
| | REPLAT |
| C0.01 | GENERAL NOTES |
| C1.00 | DEMOLITION PLAN |
| C2.00 | APPROVED SITE PLAN |
| C2.01 | PAVING / DIMENSION PLAN |
| C2.02 | GLEN HILL WAY PAVING PLAN AND PROFILE |
| C2.03 | GLEN HILL WAY STREET LIGHT PLAN |
| C3.00 | GRADING PLAN |
| C3.00a | GRADING PLAN |
| C4.00 | EXISTING DRAINAGE AREA MAP |
| C4.01 | PROPOSED DRAINAGE AREA MAP |
| C5.00 | WATER PLAN / UTILITY PLAN |
| C6.00 | EROSION CONTROL PLAN |
| C6.01 | EROSION CONTROL DETAILS |
| C7.00 | CONSTRUCTION DETAILS |
| C7.01 | SITE SPECIFIC DETAILS |
| C8.00 | CITY DETAILS |
| C8.01 | * CITY DETAILS |
| C9.00 | TxDOT DETAILS - BARRICADE AND CONSTRUCTION TYPE III |
| L-0 | TRESCAPE PLAN |
| L-1 | LANDSCAPE PLAN |
| L-2 | LANDSCAPE DETAILS |
| L-3 | SIGN DETAILS |
| L-4 | SIGN DETAILS |

* THE STANDARD TxDOT AND COFW SHEETS, SPECIFICALLY IDENTIFIED IN THIS INDEX OF SHEETS, HAVE BEEN SELECTED BY ME OR UNDER MY RESPONSIBLE SUPERVISION AS BEING APPLICABLE TO THIS PROJECT.



OWNER / DEVELOPER:
RETAIL PARTNERS, LLC
550 BAILEY AVENUE, SUITE 550
FORT WORTH, TEXAS
PHONE: (817) - 870-9147
EMAIL: JRM@RETAILPARTNERSLLC.COM
CONTACT: EDDIE MARTIN

PREPARED BY:



CARRILLO ENGINEERING, LLC
TEXAS BOARD OF PROFESSIONAL ENGINEERS
REGISTRATION NO. F-15893
301 COMMERCE STREET, SUITE 1410
FORT WORTH, TEXAS 76102
PHONE NO.: 817-697-4996
CONTACT: ANNA C. BLACKWELL, P.E.

RECORD DRAWING

TO THE BEST OF OUR KNOWLEDGE CARRILLO ENGINEERING, HEREBY STATES THAT THIS PLAN IS AS-BUILT. THE INFORMATION PROVIDED IS BASED ON SURVEYING AT THE SITE AND INFORMATION PROVIDED BY THE CONTRACTOR.

DATE: SEPTEMBER 15, 2022

FEBRUARY 2020