

GENERAL NOTES

- 1. ALL CONSTRUCTION TO BE IN ACCORDANCE WITH THE CITY OF ROCKWALL'S STANDARDS AND SPECIFICATIONS...

STORM SEWER NOTES

- 1. ALL PRIVATE STORM DRAINAGE PIPE SHALL BE HDPE AND SHOULD BE INSTALLED PER MANUFACTURE'S SPECIFICATIONS...

STORM SEWER DISCHARGE AUTHORIZATION

- 1. IF THE TOTAL DISTURBED AREA EXCEEDS ONE (1) ACRE A NOTICE OF INTENT (N.O.I.) SHALL BE SUBMITTED BY THE CONTRACTOR...

WATER NOTES

- 1. ALL WATER MAINS SHALL BE PVC AWWA-C900, DR14, (PC 305) FOR ≤12" AND DR18 (PC235) FOR ≤ 14"...

SANITARY SEWER NOTES

- 1. ALL SANITARY SEWER PIPE SHALL BE SDR 35 PVC (ASTM D-3034), UNLESS THE LINE IS DEEPER THAN 10 FEET...

TRAFFIC CONTROL NOTES

- 1. CONTRACTOR SHALL PROVIDE TRAFFIC CONTROL PLANS TO THE OWNER AND CITY INSPECTOR, AT LEAST 3 WEEKS PRIOR TO CONSTRUCTION...

EROSION CONTROL NOTES

- 1. THE CONTRACTOR SHALL COMPLY WITH ALL FEDERAL, STATE, AND LOCAL EROSION, CONSERVATION, AND SILTATION ORDINANCES...

- LENGTH: AS SHOWN ON PLAN MIN 50'
- WIDTH, 20' MIN.: NOT LESS THAN FULL WIDTH OF ALL POINTS OF INGRESS AND EGRESS...

GRADING NOTES


- 1. ALL AREAS DISTURBED DURING CONSTRUCTION, INCLUDING AREAS OUTSIDE THE CONSTRUCTION BOUNDARY SHALL BE SEEDED AND HYDROMULCHED OR SODDED TO RE-ESTABLISH VEGETATION...

PAVING

- 1. ALL CONSTRUCTION SHALL BE IN GENERAL ACCORDANCE WITH THESE PLANS, CITY OF ROCKWALL STANDARD SPECIFICATIONS, THE FINAL GEOTECHNICAL REPORT AND COMMONLY ACCEPTED CONSTRUCTION STANDARDS...

- SHALL BE PERFORMED BY AN APPROVED AGENCY FOR TESTING MATERIALS. THE NOMINATION OF THE TESTING LABORATORY AND THE PAVEMENT OF SUCH TESTING SERVICES SHALL BE MADE BY THE CONTRACTOR...

GEOTECHNICAL REPORT REPORT NO. G192681 BY: ALPHA TESTING, INC. DATED: JANUARY 2, 2020

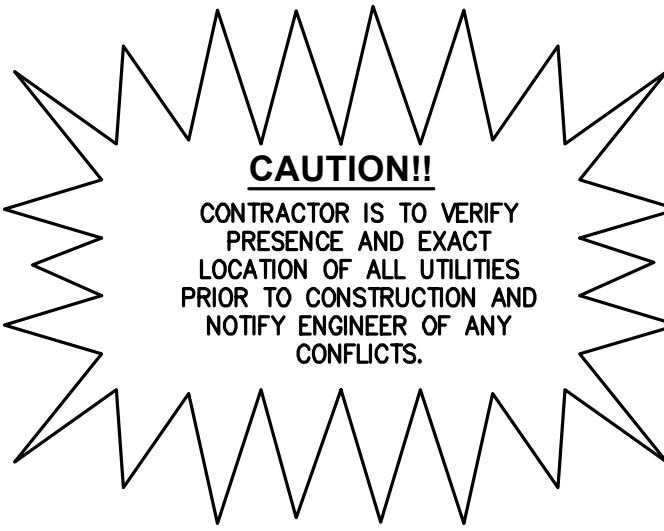

RECORD DRAWING TO THE BEST OF OUR KNOWLEDGE ENGINEERING, HEREBY STATES THAT THIS PLAN IS AS-BUILT. THE INFORMATION PROVIDED IS BASED ON SURVEYING AT THE SITE AND INFORMATION PROVIDED BY THE CONTRACTOR. DATE: SEPTEMBER 15, 2022

Carrillo Engineering, LLC 301 Commerce Street, Ste 1410 - Fort Worth, Texas 76102 Phone: 817-697-4996 - Firm Registration #F-15893

Issue Date: NOVEMBER 22, 2019 JANUARY 17, 2020 FEBRUARY 20, 2020

Scale: Drawn By: Checked By: Sheet C0.01 PROJECT BENCHMARK: CITY OF ROCKWALL CONTROL MONUMENTATION MONUMENT NUMBER RESET #1. POSTED ELEV=567.704 (NAVE88)