

**LEGEND**


- FLOW DIRECTION
- PROPOSED CONTOURS
- EXISTING CONTOURS
- SILT FENCE
- INLET PROTECTION
- INLET PROTECTION
- CONSTRUCTION ENTRANCE
- ROCK CHECK DAM
- TREE TO REMAIN W/ TREE PROTECTION

DRAINAGE IMPROVEMENTS SUFFICIENT TO MITIGATE THE IMPACT OF CONSTRUCTION SHALL BE INSTALLED PRIOR TO ADDING IMPERVIOUS COVER.

**EROSION CONTROL GENERAL NOTE:**  
 EROSION CONTROL MEASURES MAY ONLY BE PLACED IN FRONT OF INLETS, IN CHANNELS, DRAINAGEWAYS OR BORROW DITCHES AT RISK OF CONTRACTOR. THE CONTRACTOR SHALL REMAIN LIABLE FOR ANY DAMAGE CAUSED BY THE MEASURES, INCLUDING FLOODING DAMAGE, WHICH MAY OCCUR DUE TO BLOCKED DRAINAGE. AT THE CONCLUSION OF ANY PROJECT, ALL CHANNELS, DRAINAGEWAYS AND BORROW DITCHES IN THE WORK ZONE SHALL BE DREGDED OF ANY SEDIMENT GENERATED BY THE PROJECT OR DEPOSITED AS A RESULT OF EROSION CONTROL MEASURES.

DISTURBED AREA = 1.162 ACRES

NOTE: ALL RESPONSIBILITY FOR ADEQUACY OF DESIGN REMAINS WITH THE DESIGN ENGINEER. THE CITY OF ROCKWALL IN REVIEWING AND RELEASING PLANS FOR CONSTRUCTION, ASSUMES NO RESPONSIBILITY FOR ADEQUACY OR ACCURACY OF DESIGN.

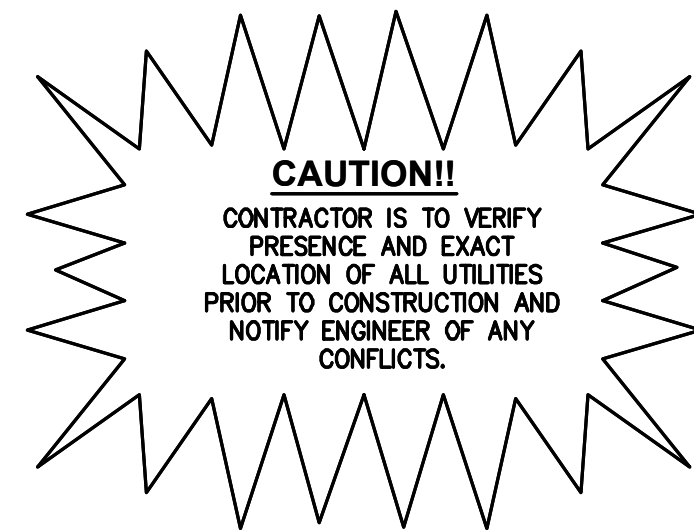

**STOP!**  
**CALL BEFORE YOU DIG**  
**DIG TESS**  
**1-800-DIG-TESS**  
 (at least 72 hours prior to digging)

**RECORD DRAWING**  
 TO THE BEST OF OUR KNOWLEDGE CARRILLO ENGINEERING, HEREBY STATES THAT THIS PLAN IS AS-BUILT. THE INFORMATION PROVIDED IS BASED ON SURVEYING AT THE SITE AND INFORMATION PROVIDED BY THE CONTRACTOR.  
 DATE: SEPTEMBER 15, 2022

**PROJECT BENCHMARK:**  
 CITY OF ROCKWALL CONTROL MONUMENTATION MONUMENT NUMBER RESET #1.  
 POSTED ELEV=567.704 (NAVE88)

**Carrillo Engineering, LLC**  
 301 Commerce Street, Ste 1410 - Fort Worth, Texas 76102  
 Phone 817-697-4996 - Firm Registration #F-15893



**RIDGE ROAD RETAIL CENTER**  
**2930 SOUTH RIDGE ROAD**  
**LAKERIDGE ESTATES, LOT 26**  
**ROCKWALL, TEXAS**  
**EROSION CONTROL PLAN**

**Issue Dates:**  
 NOVEMBER 22, 2019  
 JANUARY 17, 2020  
 FEBRUARY 20, 2020

Date	Revisions

Scale:  
 Drawn By:  
 Checked By:  
 Sheet  
**C6.00**

Drawing: S:\18-138-001 - Rockwall Retail\CAD\18-138-001 EROSION.dwg, Saved By: Jesse, Save Time: 8/15/2022 8:28:52 PM  
 Plotted By: Jesse Print Date: 10/09/2022 11:35 AM