




REINFORCED CONCRETE SIDEWALKS	CITY OF ROCKWALL	DATE	DRAWING NO.
JOINTS AND SPACING		AUG '19	R-2170

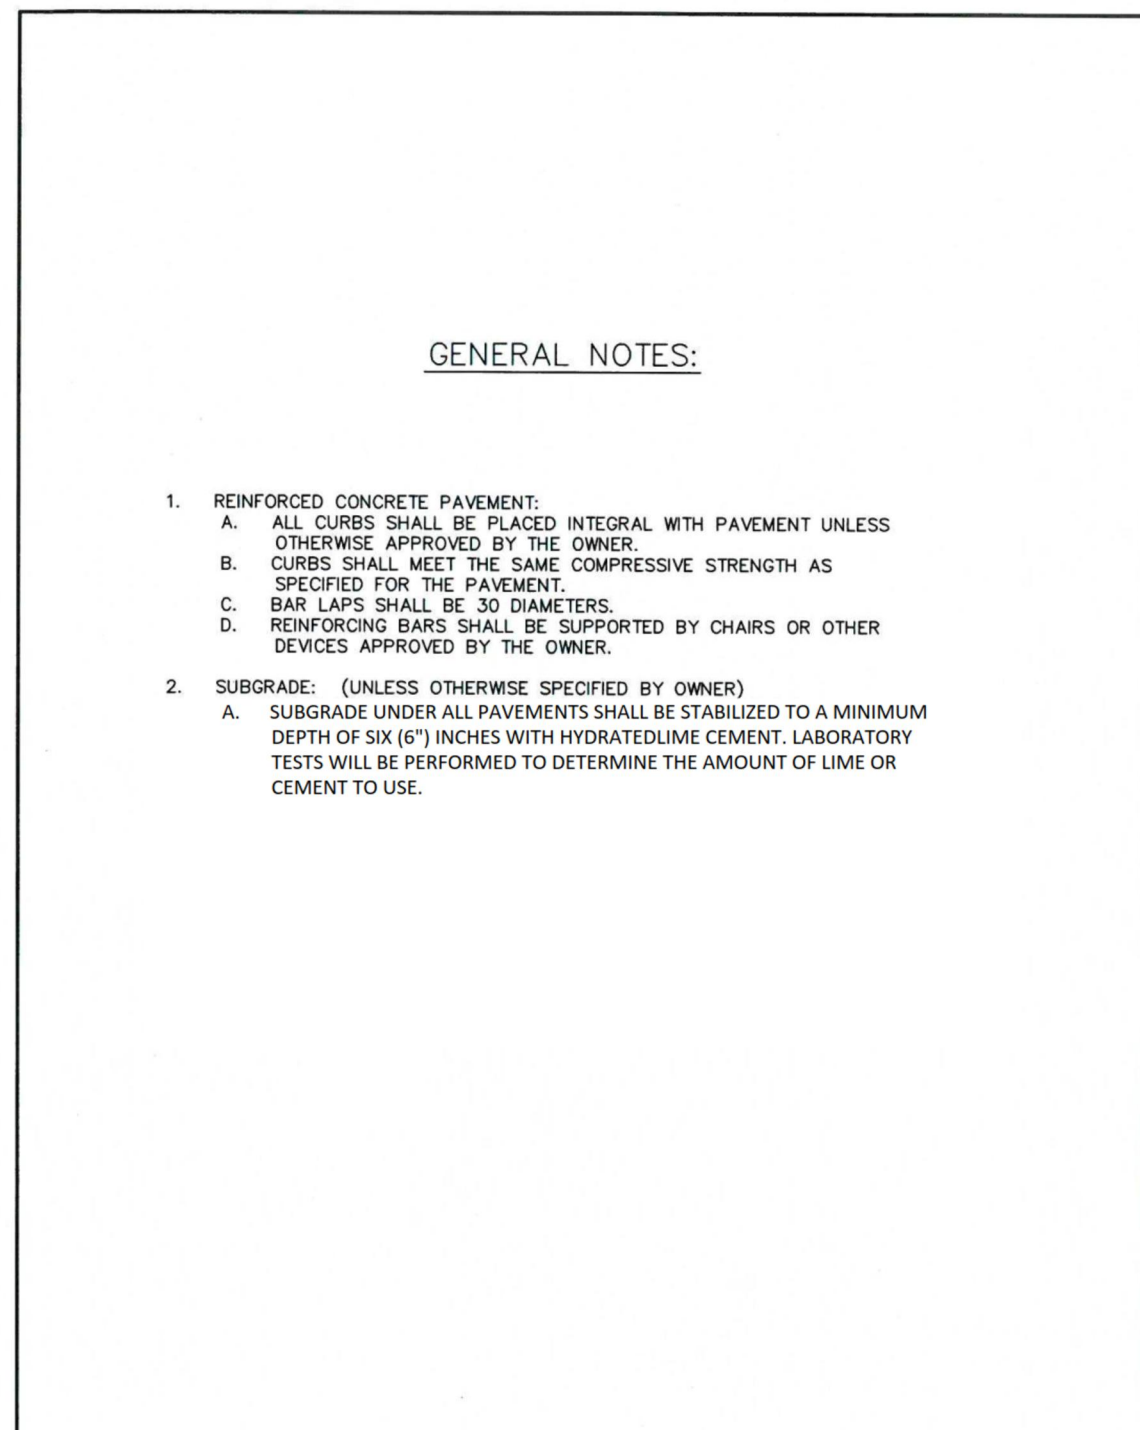


PAVEMENT SYSTEMS	CITY OF ROCKWALL	STANDARD SPECIFICATION REFERENCE
GENERAL NOTES		302.303
		DATE: Mar. 2018
		STANDARD DRAWING NO. R-2190

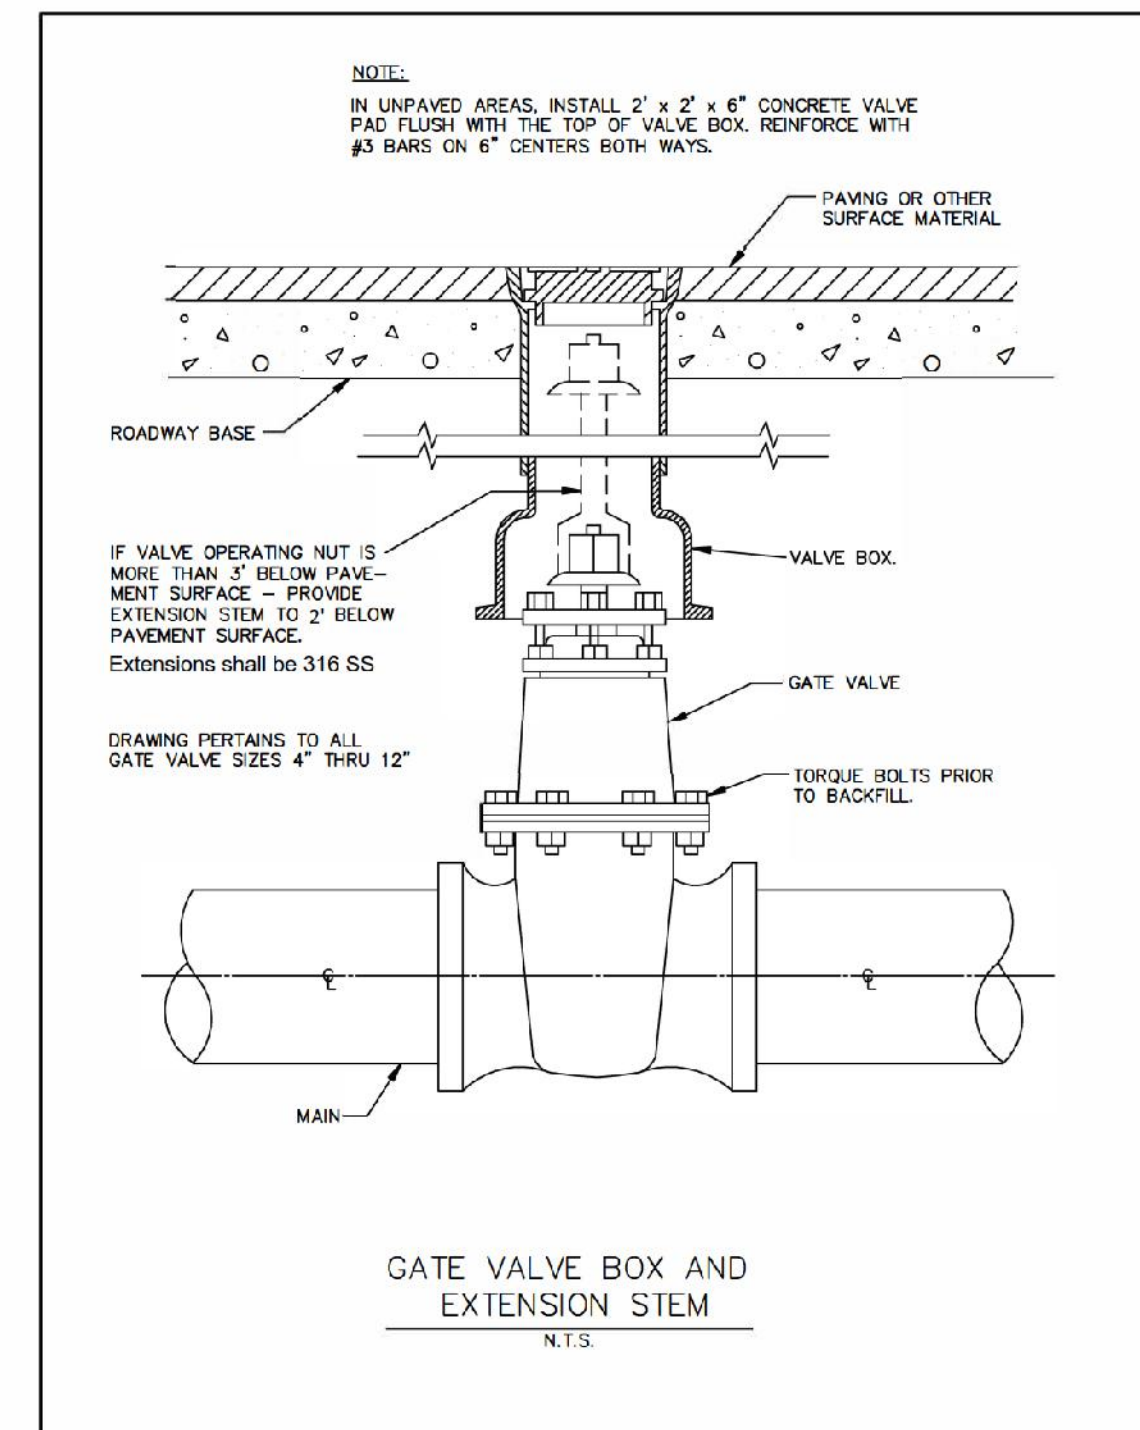


GATE VALVE 4" TO 12"	CITY OF ROCKWALL	STANDARD SPECIFICATION REFERENCE
BOX & EXTENSION STEM		502.6.6*
		DATE: AUG. 19
		STANDARD DRAWING NO. R-4050

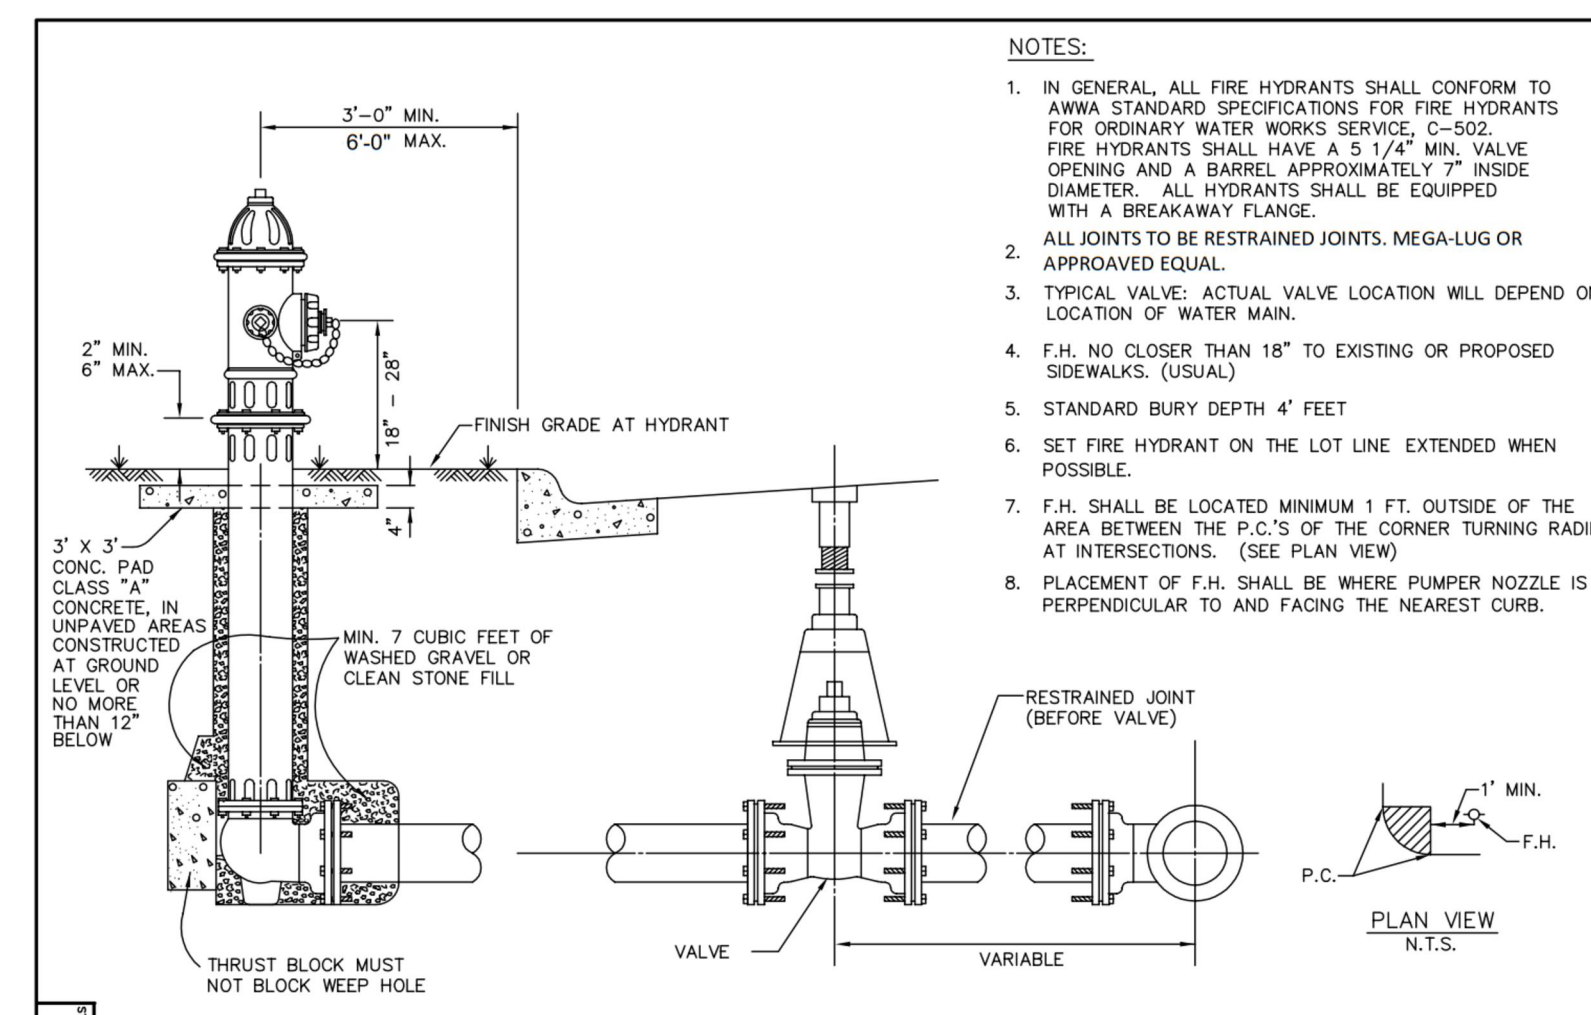

FIRE HYDRANT	CITY OF ROCKWALL	STANDARD SPECIFICATION REFERENCE
INSTALLATION		502.3
		DATE: Aug. 2019
		STANDARD DRAWING NO. R-4120

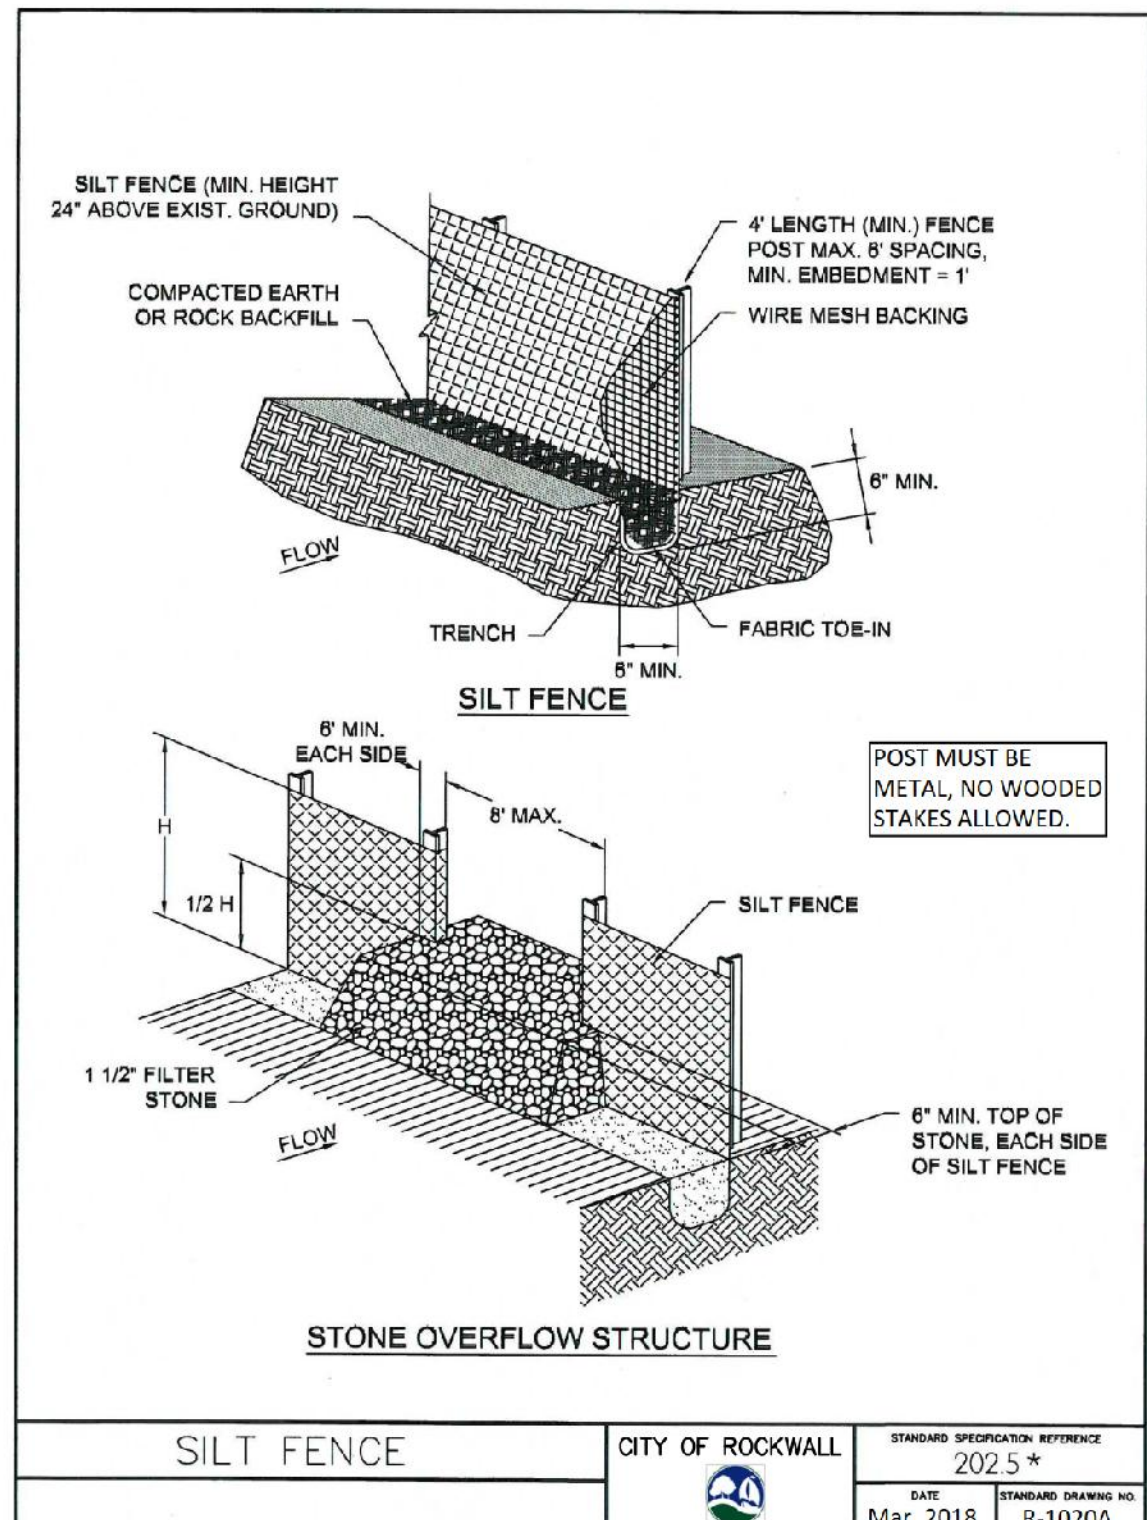

SILT FENCE	CITY OF ROCKWALL	STANDARD SPECIFICATION REFERENCE
		202.5*
		DATE: Mar. 2018
		STANDARD DRAWING NO. R-1020A

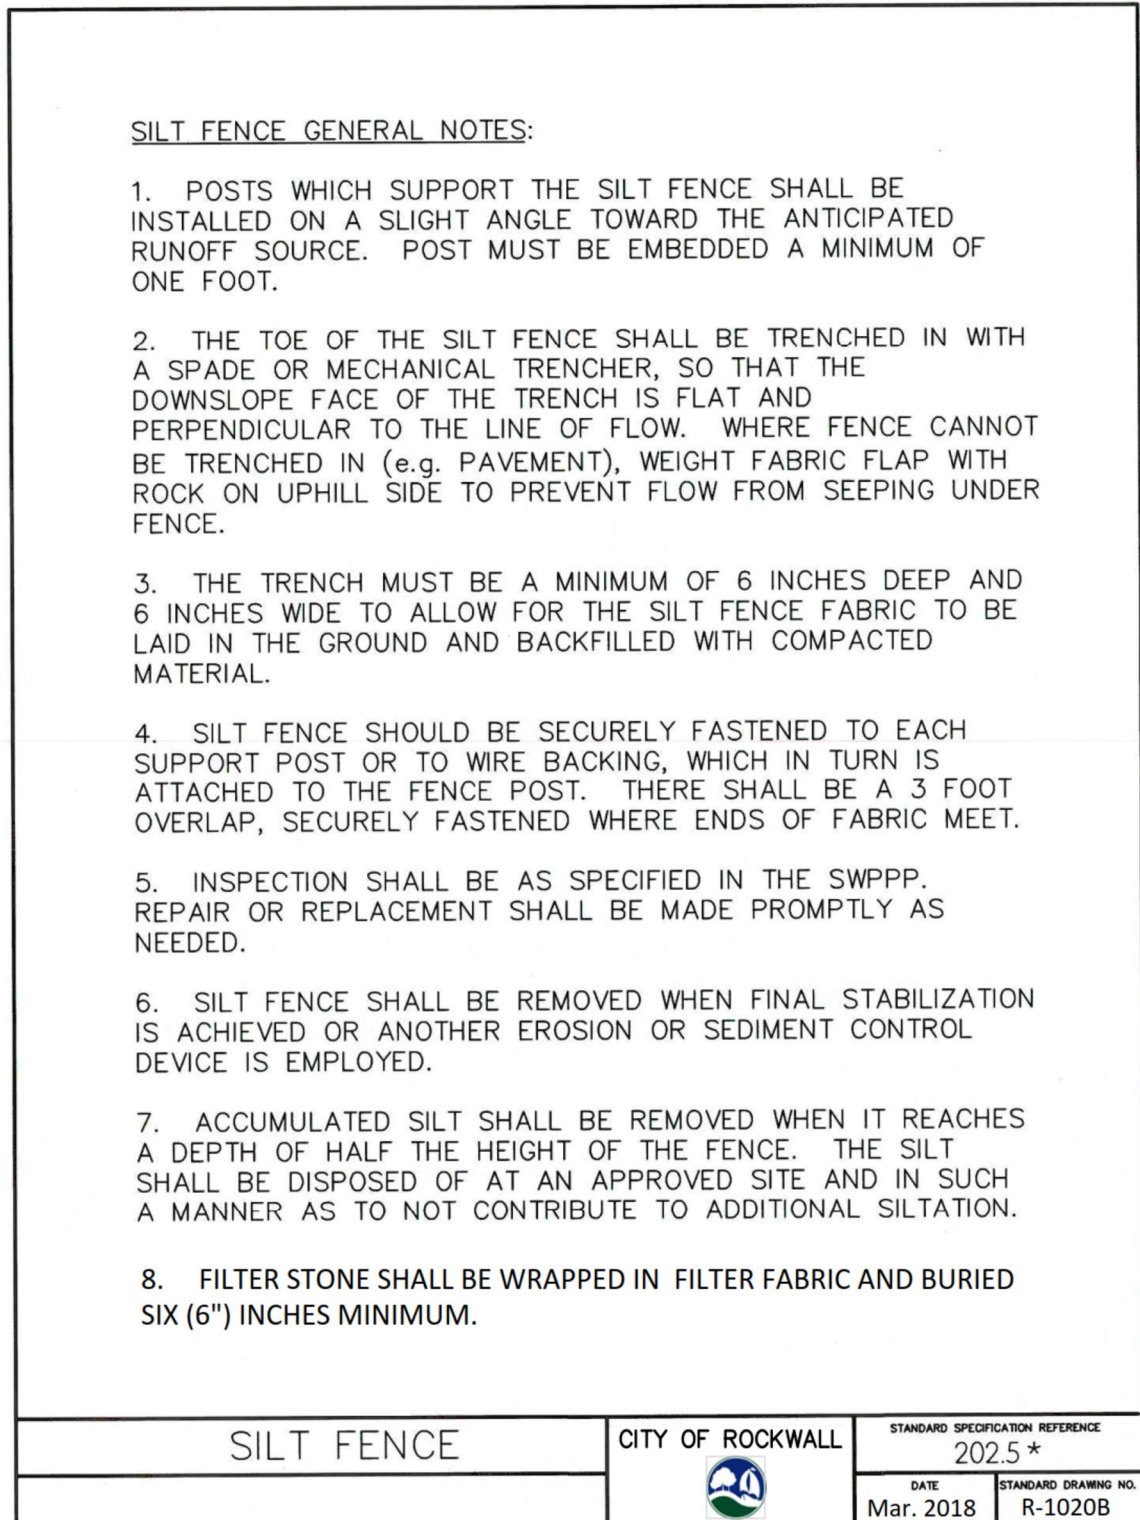

SILT FENCE	CITY OF ROCKWALL	STANDARD SPECIFICATION REFERENCE
		202.5*
		DATE: Mar. 2018
		STANDARD DRAWING NO. R-1020B

Date	Revisions

RECORD DRAWING
 TO THE BEST OF OUR KNOWLEDGE CARRILLO ENGINEERING, HEREBY STATES THAT THIS PLAN IS AS-BUILT. THE INFORMATION PROVIDED IS BASED ON SURVEYING AT THE SITE AND INFORMATION PROVIDED BY THE CONTRACTOR.
 DATE: SEPTEMBER 15, 2022

Drawing: X:\19-139-001 - Roadway Retail\CAD\19-139-001 DETAILS.dwg Saved By: Jesse Stone Time: 8/17/2022 5:33:32 PM
 Plotted By: Jesse Print Date: 8/17/2022 5:35 PM