



RIDGE ROAD
TOWN
CENTRE
ROCKWALL, TEXAS

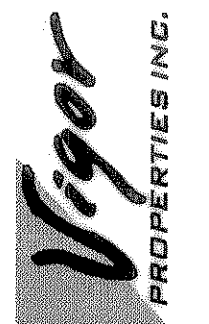


Ridge Road Town Centre
Partners, L.P.
by its General Partners:
RIDGE ROAD
PARTNERS L.L.C.

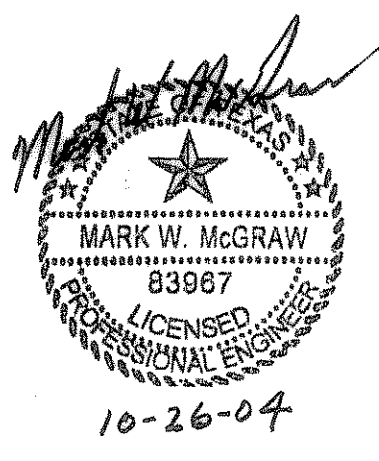


Half Associates, Inc.
ENGINEERS • ARCHITECTS • SCIENTISTS • PLANNERS • SURVEYORS
8616 NORTHWEST PLAZA DRIVE
DALLAS, TEXAS 75225
FAX (214) 759-0095

| | | |
|---------------|---------------|-------------------|
| Project No: | AVG # 20817 | |
| Issue: | | |
| Revisions: | | |
| No. | Date | Description |
| 1 | 11/04/02 | FIRST SUBMITTAL |
| 2 | 4/09/03 | SECOND SUBMITTAL |
| 3 | 5/09/03 | THIRD SUBMITTAL |
| 4 | 6/09/03 | FOURTH SUBMITTAL |
| 5 | 7/09/04 | FIFTH SUBMITTAL |
| 7 | 10/26/04 | SEVENTH SUBMITTAL |
| Drawn by: | | |
| Checked by: | | |
| Sheet Title: | SLEEVING PLAN | |
| Sheet Number: | C4.2 | |

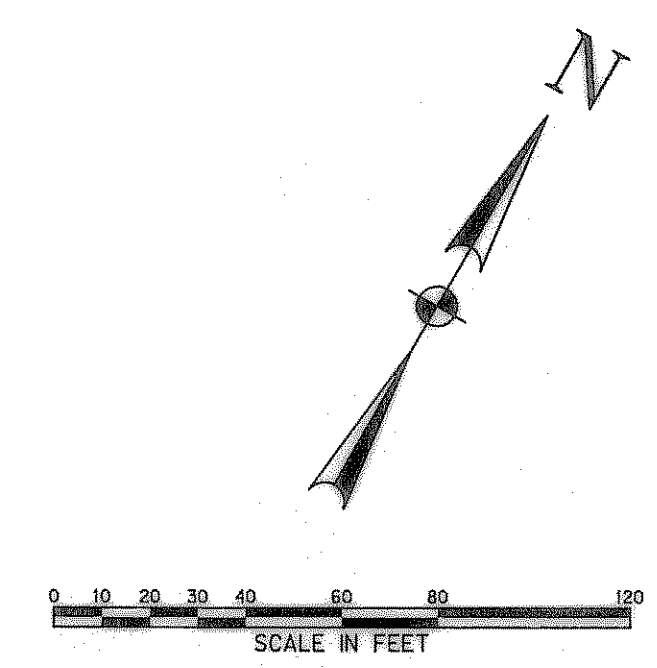

IRRIGATION SLEEVING PLAN NOTES
CONTRACTOR SHALL VERIFY CONDUIT SIZES AND LOCATIONS SHOWN ON THIS SHEET WITH THE LANDSCAPE IRRIGATION PLANS, AND MEP DRAWINGS FOR ELECTRICAL AND TELEPHONE.

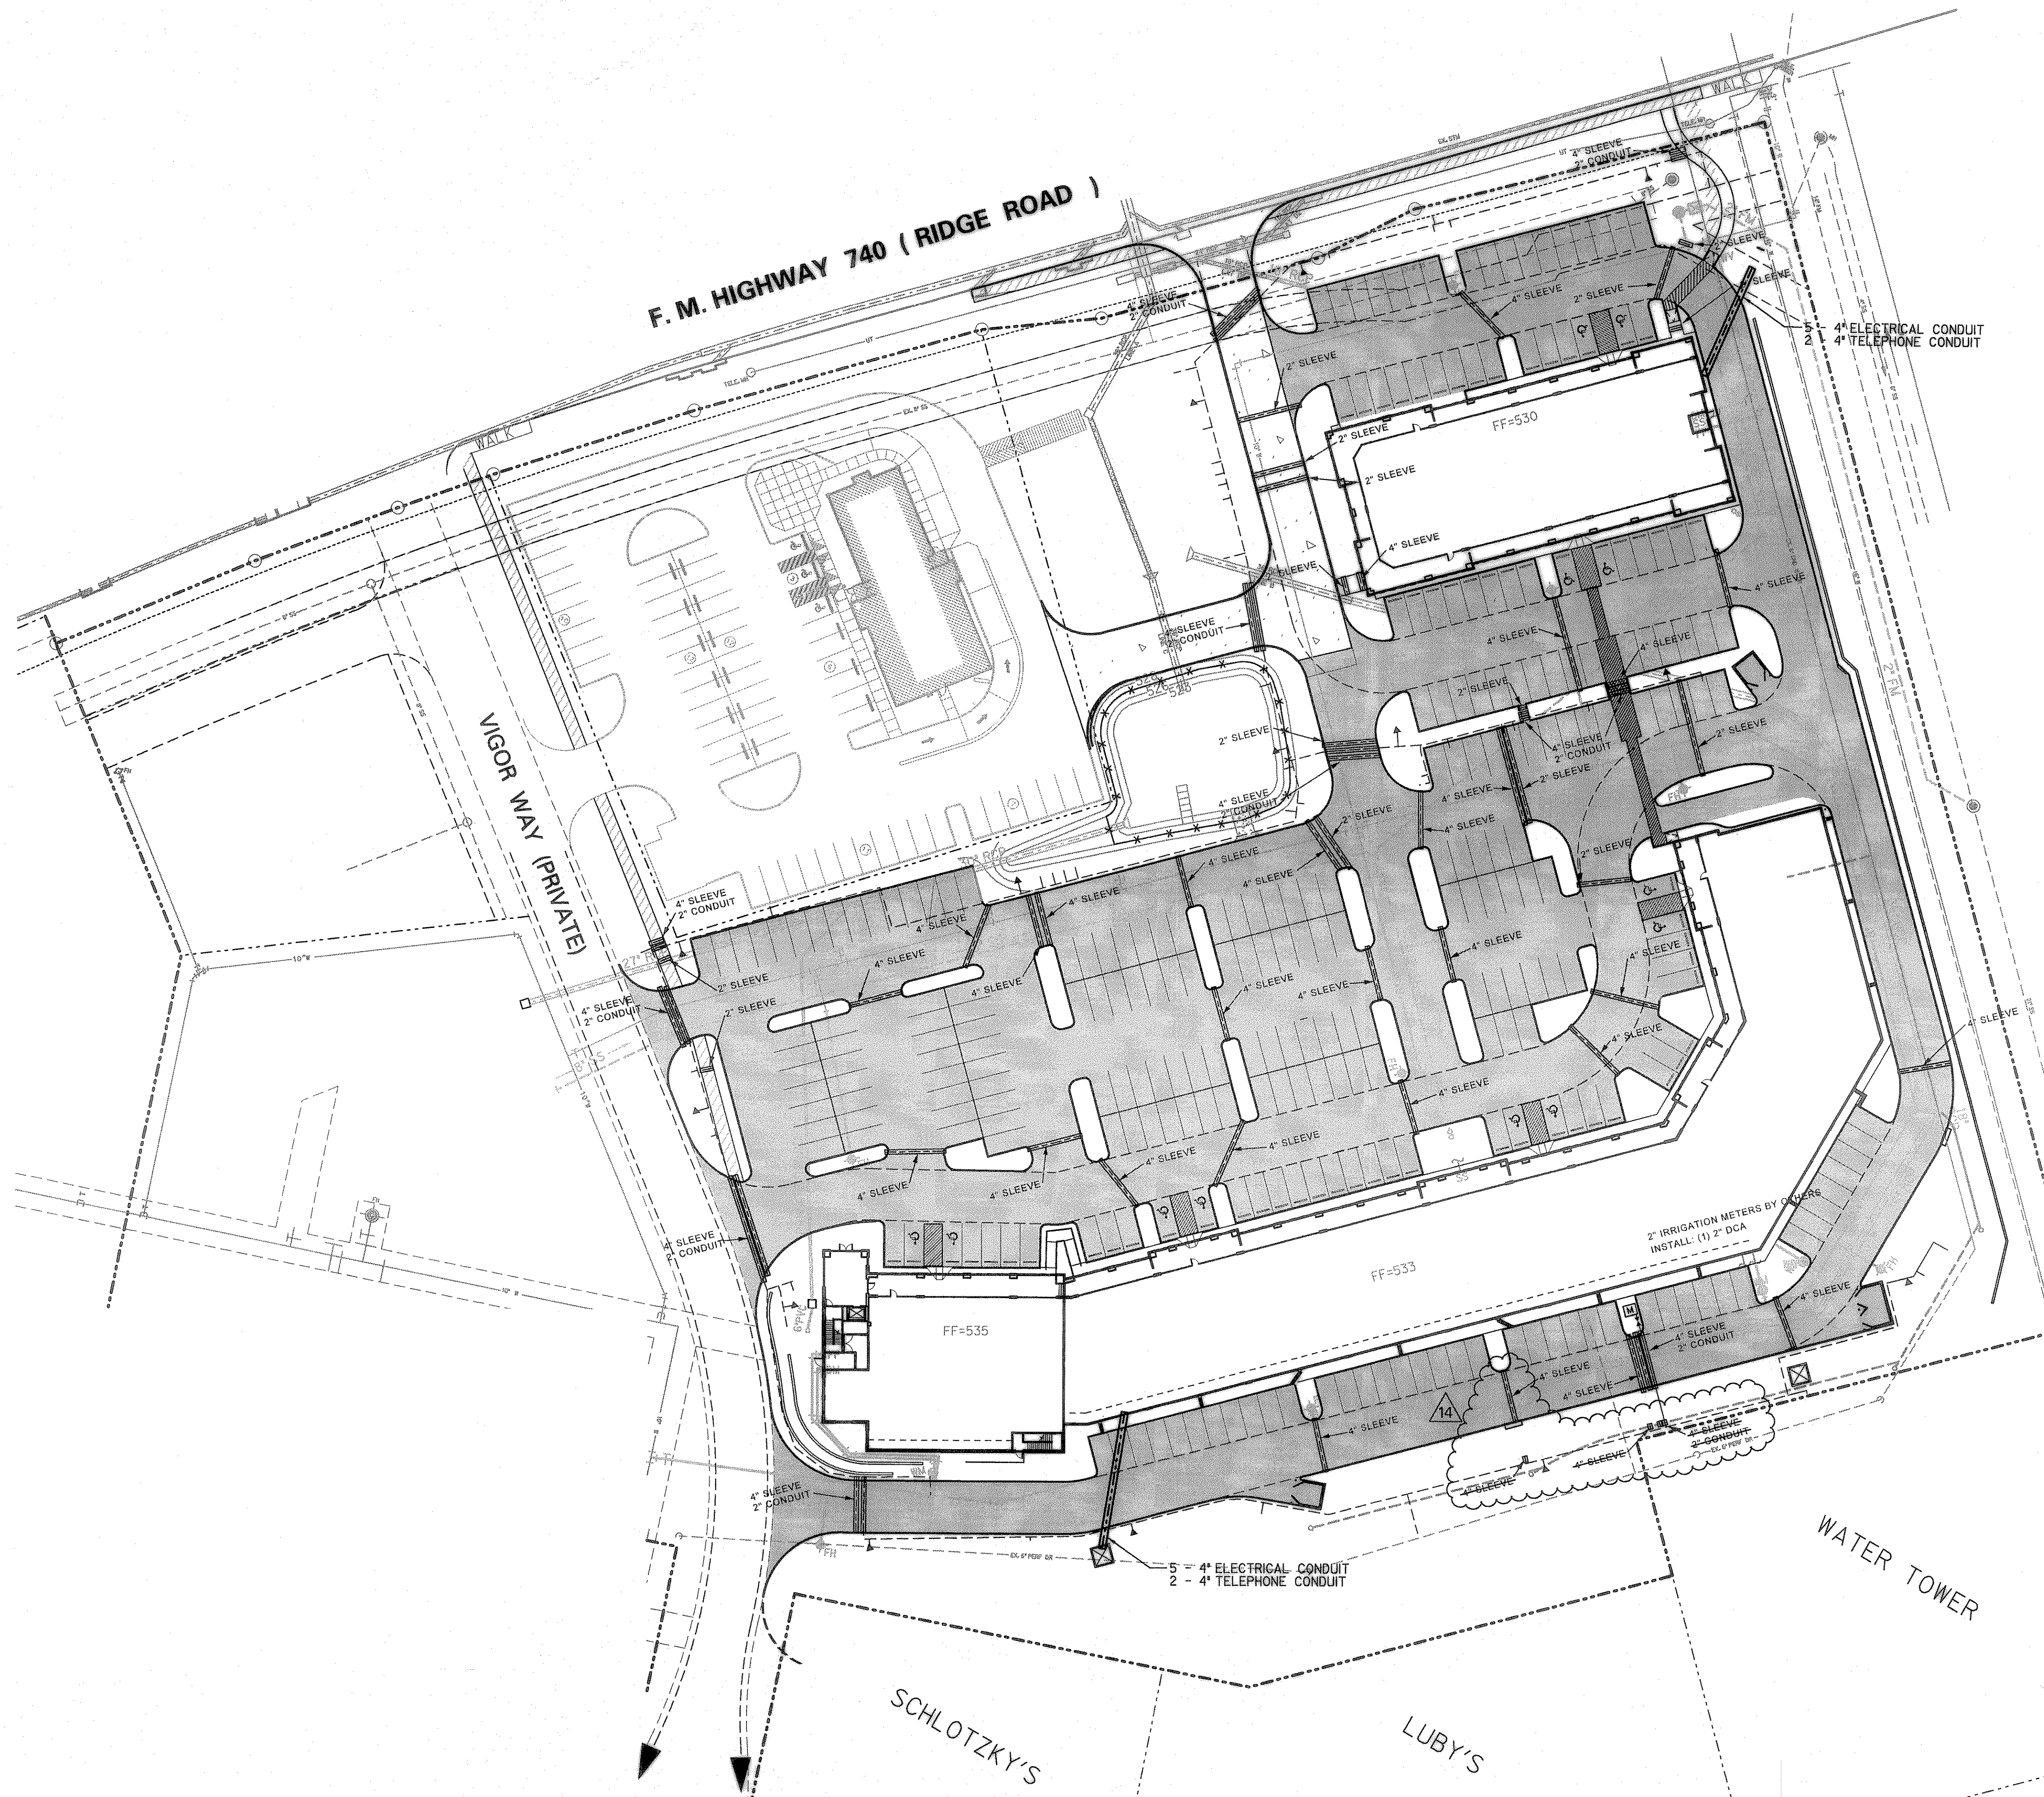

RECORD DRAWINGS BASED ON
FIELD SURVEY (12/05) AND
CONTRACTOR INFORMATION ONLY.
Mark W. McGrath 2-8-06

02-08-06 RECORD DRAWINGS
122705 ELIMINATED 26 PARKING SPACES