


- GENERAL NOTES**
1. MAXIMUM SLOPE ON BARRIER FREE RAMPS SHALL NOT EXCEED 1" PER FOOT AT ANY LOCATION.
 2. DESIGNS SHOWN ARE FOR 6" CURBS. FOR CURBS GREATER THAN 6" DIMENSIONS SHALL BE INCREASED PROPORTIONATELY.
 3. STREETS ON STEEP GRADE WILL REQUIRE LONGER CURB TRANSITIONS. IT IS THE DESIGN ENGINEER'S RESPONSIBILITY TO INSURE THAT THIS DETAIL WILL WORK.
 4. LOCATIONS OF BARRIER FREE RAMPS MAY BE SHIFTED TO CLEAR OBSTRUCTIONS, WITH APPROVAL FROM THE CITY.
 5. CONCRETE TO HAVE A MINIMUM 3000 P.S.I. COMPRESSIVE STRENGTH AT 28 DAYS.
 6. REINFORCEMENT TO BE #3 BARS AT 24" O.C.E.W.
 7. GROOVES MUST BE CLEAN AND STRAIGHT FOR CLEAR DETECTION BY TOUCH WITH A CANE AND PARALLEL TO CROSSWALKS.
 8. FOR PURPOSES OF WARNING, THE FULL WIDTH AND DEPTH OF CURB RAMPS SHALL HAVE A LIGHT REFLECTIVE VALUE AND TEXTURE THAT SIGNIFICANTLY CONTRASTS WITH THAT OF ADJOINING PEDESTRIAN ROUTES. CITY SHALL APPROVE MATERIALS AND COLOR SHALL BE CHROMIX ADMIXTURES QUARRY RED, C-32 (CHROMIX IS MANUFACTURED BY THE L.M. SCOFIELD CO. (800)800-9900 OR APPROVED EQUAL.

GENERAL NOTES
FOR BARRIER FREE RAMPS

CITY OF ROCKWALL
"THE NEW HORIZON"


SCALE: NONE
DATE: AUG. '03
DRAWING NAME: HANDICAP_3

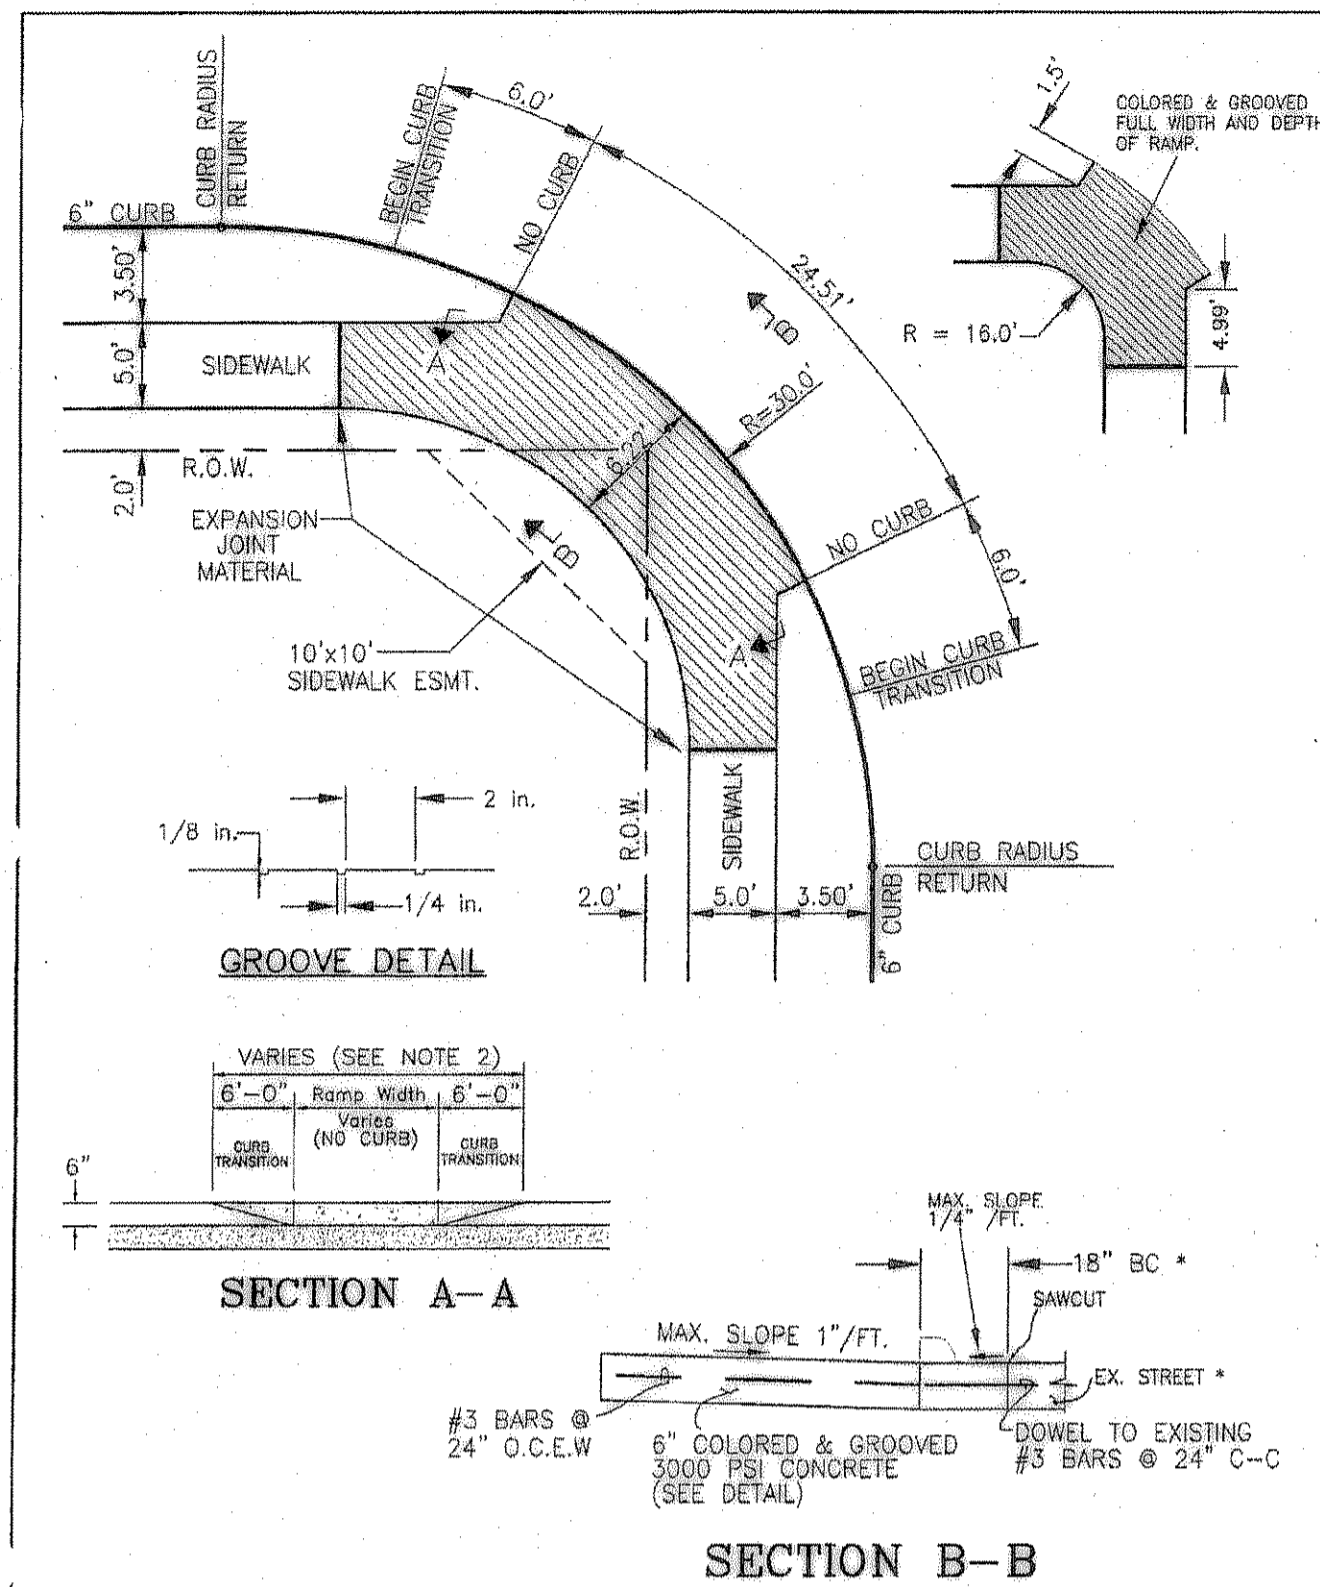

BARRIER FREE RAMP
FOR 5.0' WIDE SIDEWALK
MAJOR & MINOR ARTERIALS (30.0' RADIUS)

CITY OF ROCKWALL
"THE NEW HORIZON"


SCALE: NONE
DATE: 8/03
DRAWING NAME: HANDICAP_3

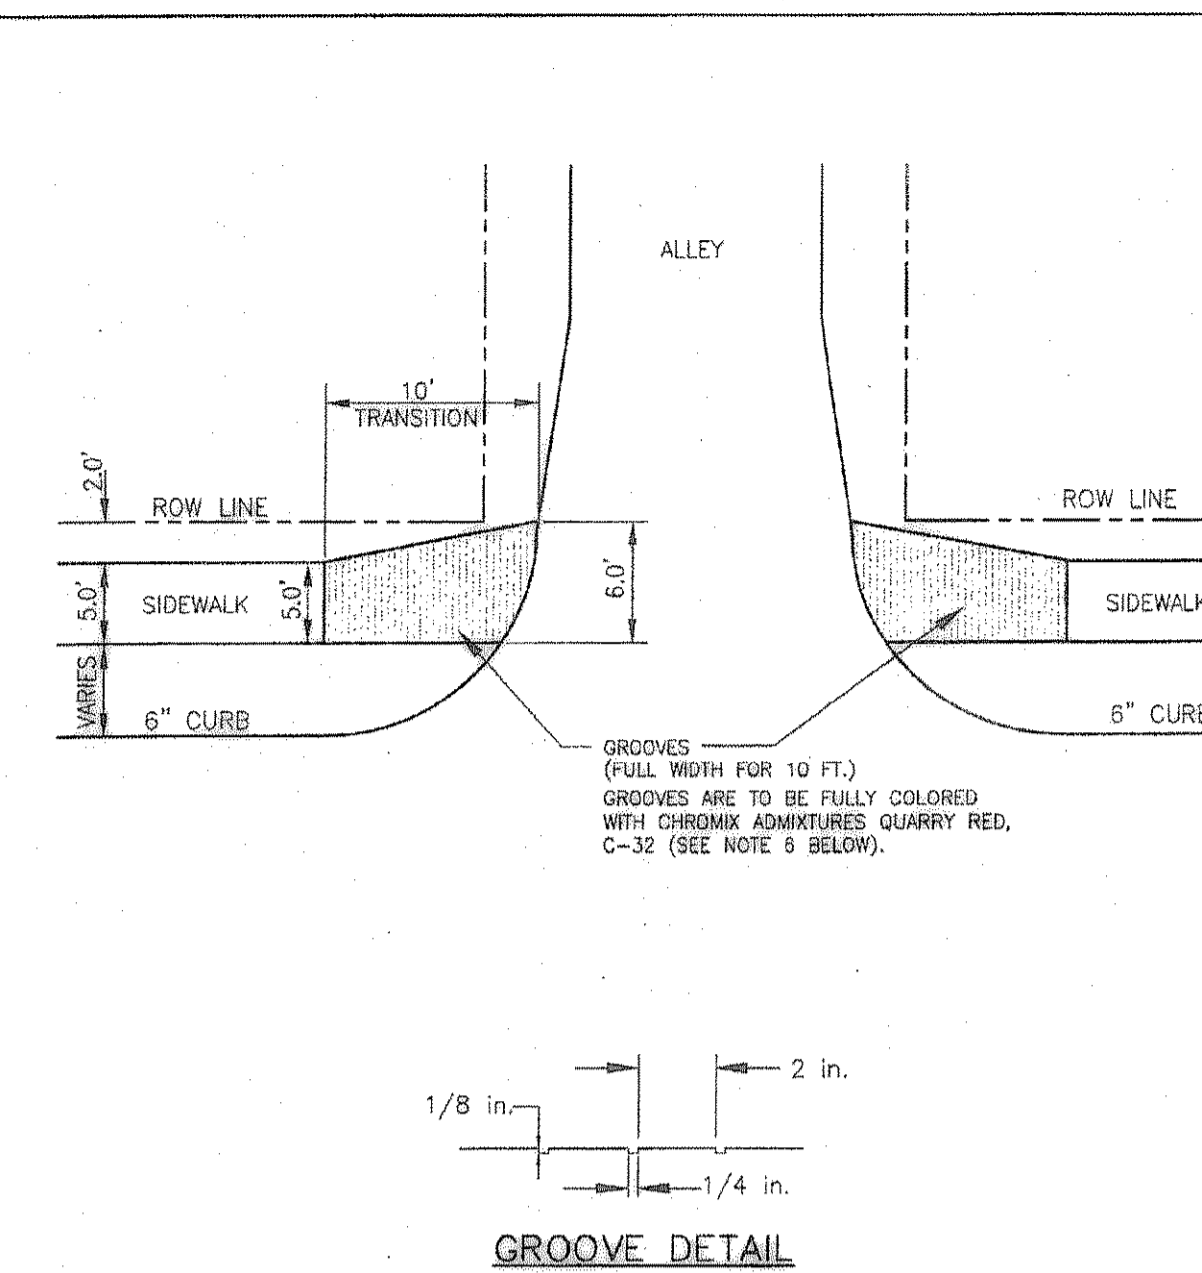

BARRIER FREE RAMP
ALLEY INTERSECTIONS

CITY OF ROCKWALL
"THE NEW HORIZON"

SCALE: NONE
DATE: 8/03
DRAWING NAME: HANDICAP_3

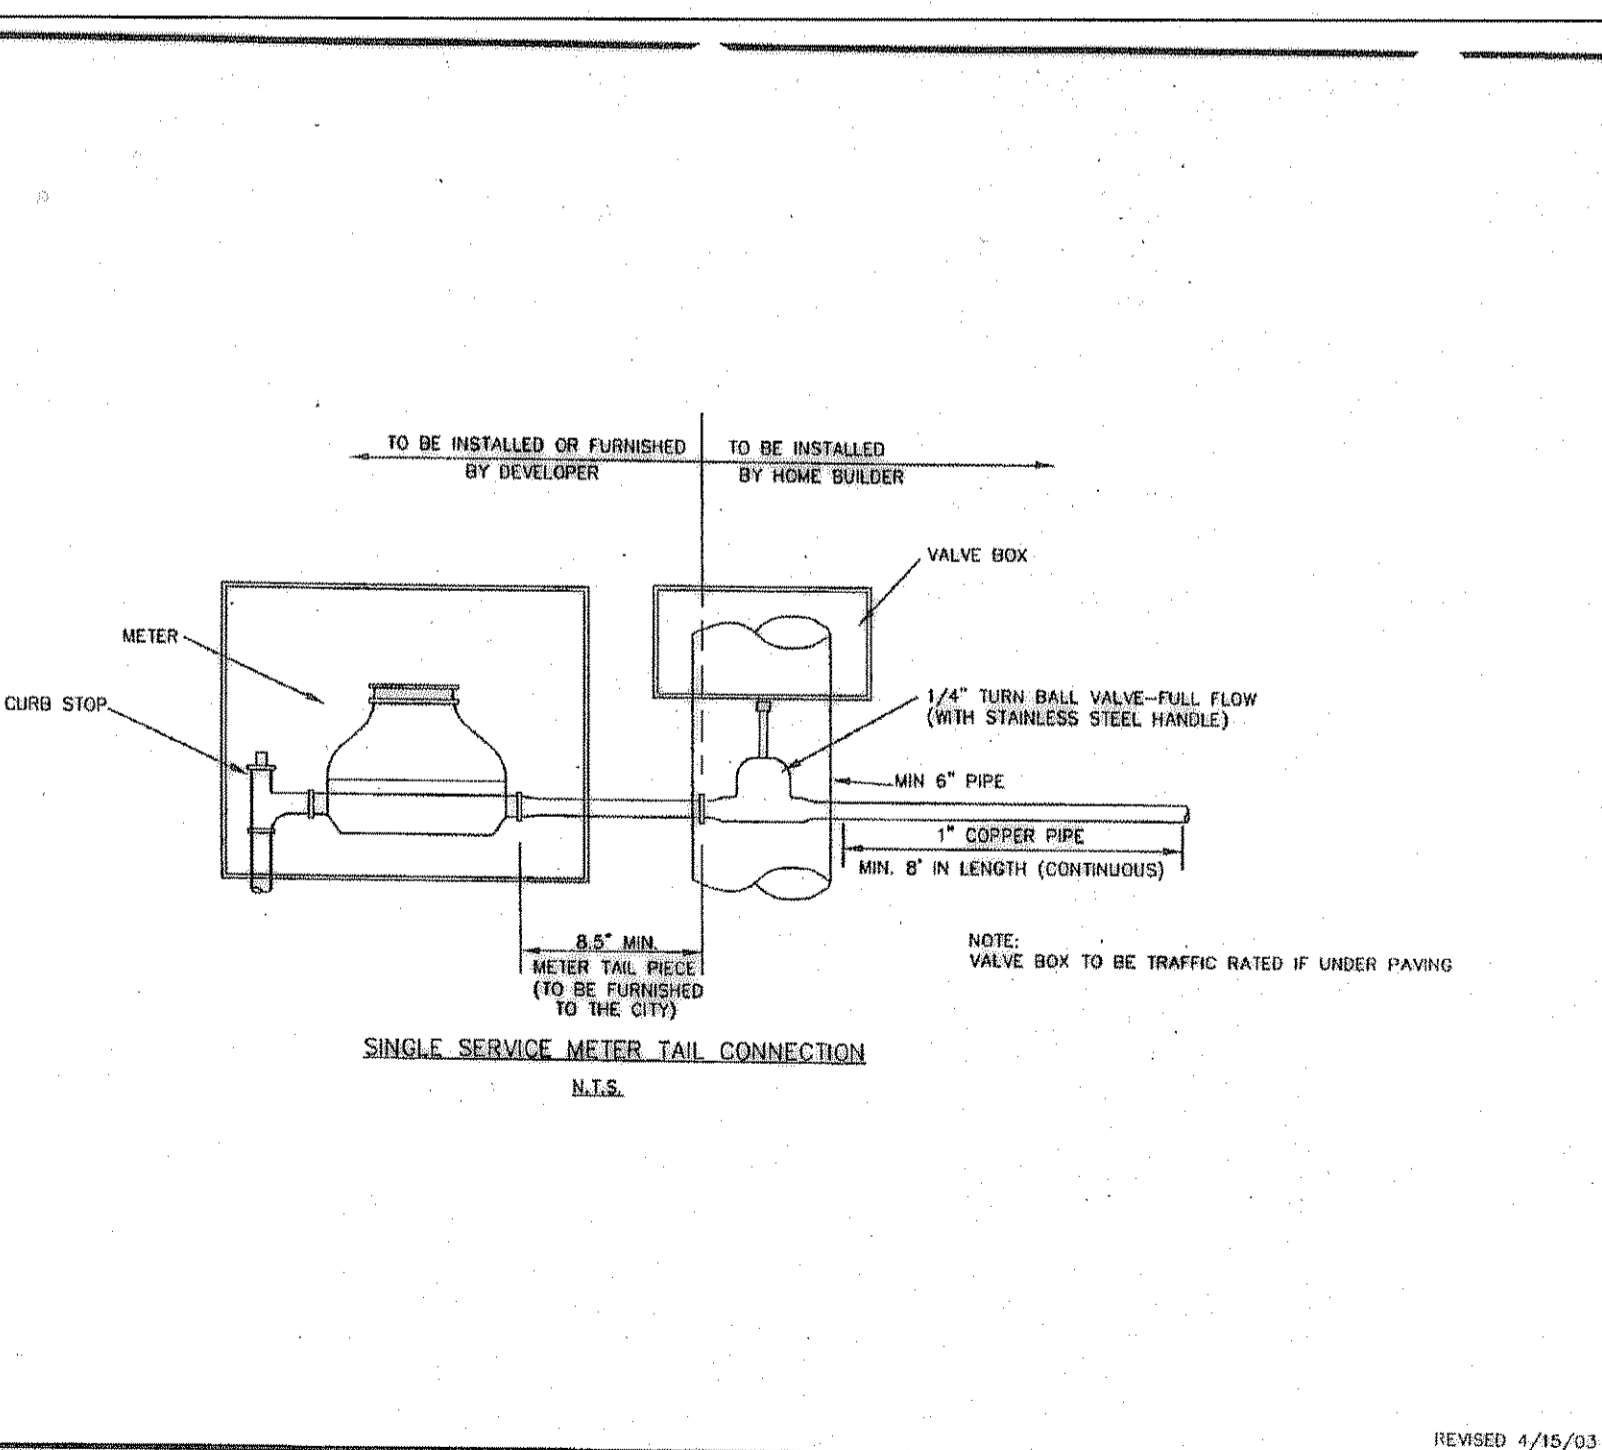

SINGLE SERVICE METER TAIL CONNECTION
N.T.S.


REVISED 4/15/03

Rotec Meter and Valve Box Series

DFW-18-AMRL-Lid

"E" Series Lid

- Flush Mount lid that fits a Cast Iron Ring
- AMR transponder slides into a molded holder under the lid to provide security and strength
- Lid has ability to custom fit most Cast Iron Rings
- Skid resistant surface texture
- Spring loaded locking device
- Security bracket option available
- "Iron" slide mount available

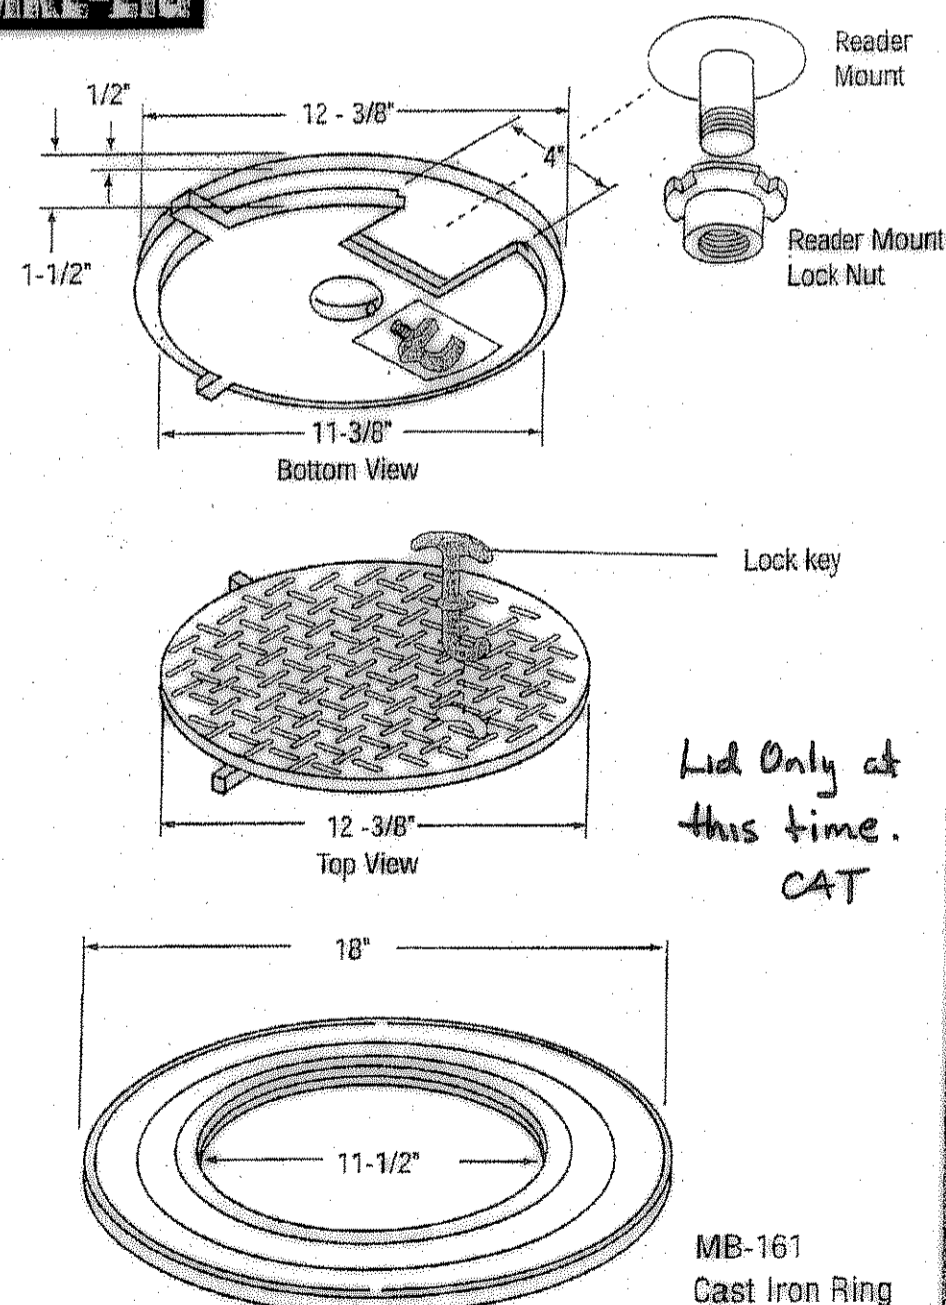


Lid Only at this time. CAT

MB-161
Cast Iron Ring

Made in USA
Pat. Pending

DFW PLASTICS, INC. P.O. Box 648 - Bedford, Texas 76095 - USA - 817.439.3400 - Fax 817.439.3780

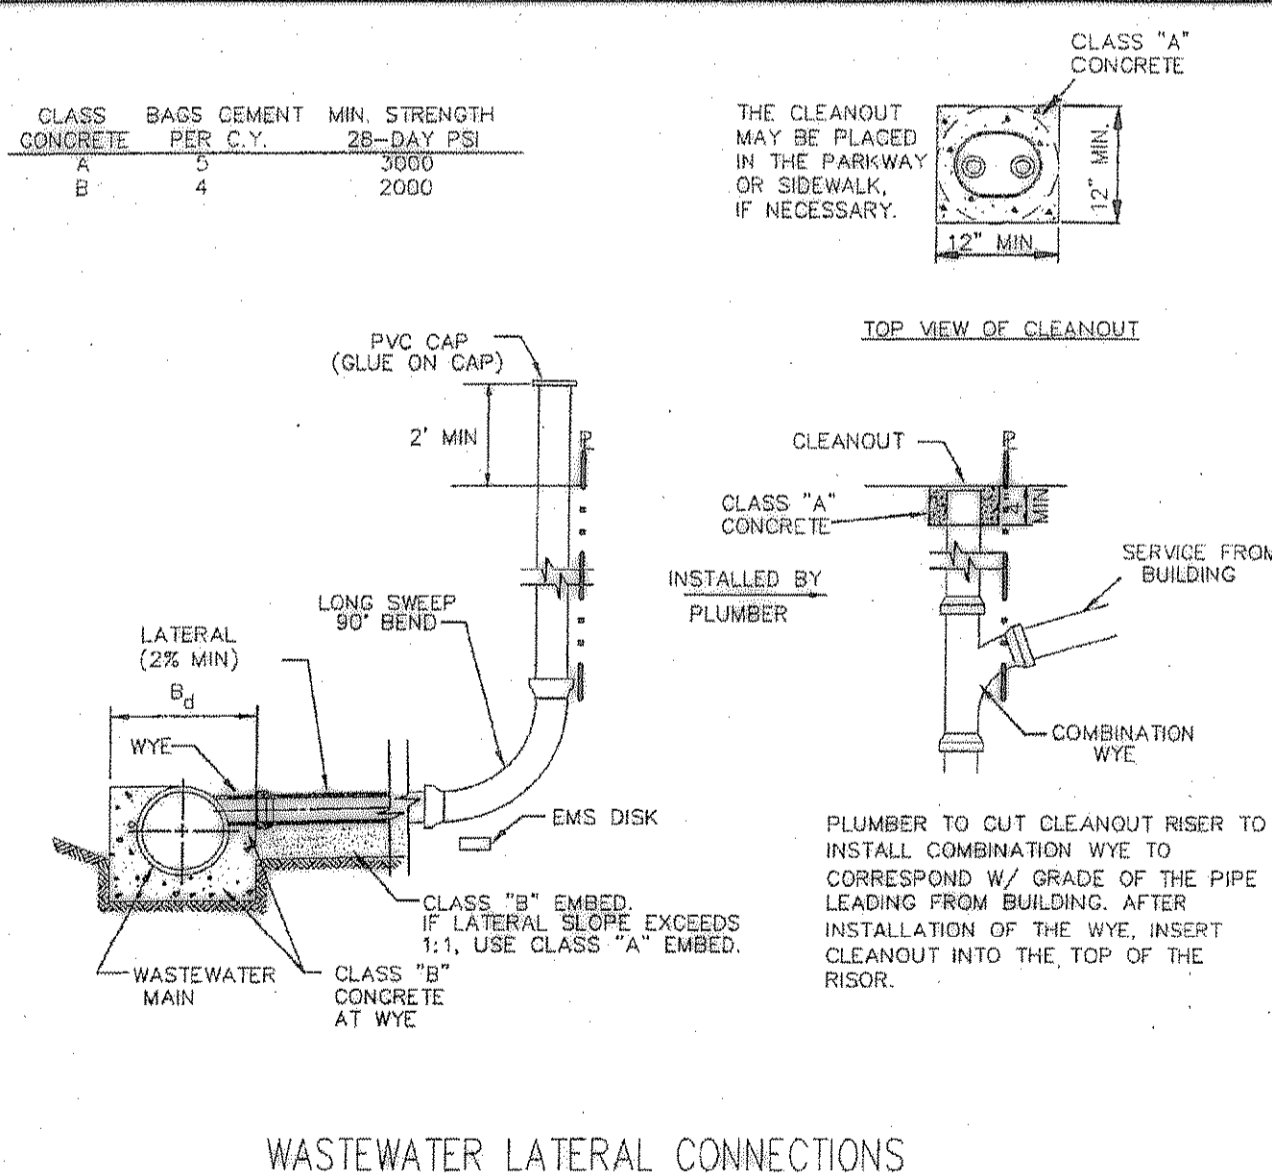

WASTEWATER LATERAL CONNECTIONS
N.T.S.

LATERAL CONNECTIONS

CITY OF ROCKWALL
"THE NEW HORIZON"


SCALE: NONE
DATE: MAY '03
DRAWING NAME: SEWER SERVICE

RECORD DRAWINGS BASED ON FIELD SURVEY (12/05) AND CONTRACTOR INFORMATION ONLY.
Mark of Mr. Doe 2-8-06

02-08-06 RECORD DRAWINGS

RIDGE ROAD TOWN CENTRE
ROCKWALL, TEXAS

Vigor PROPERTIES INC.
Ridge Road Town Centre Partners, L.P.
by its General Partners:
RIDGE ROAD PARTNERS L.L.C.

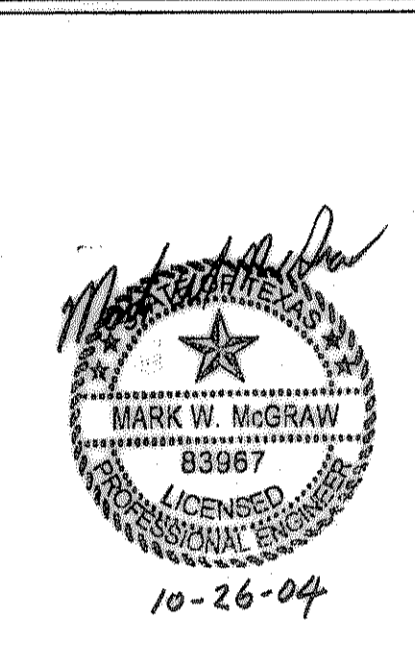

Half Associates, Inc.
ENGINEERS • ARCHITECTS • SCIENTISTS • PLANNERS • SURVEYORS
806 NORTHWEST PLAZA DRIVE
DALLAS, TEXAS 75225
FAX (214) 759-8095

Project No:	AVO # 20817	
Issued:		
Revisions:		
No.	Date	Description
1	11/05/02	FIRST SUBMITTAL
2	02/06/03	SECOND SUBMITTAL
3	04/06/03	THIRD SUBMITTAL
4	06/06/03	FOURTH SUBMITTAL
5	2/20/04	FIFTH SUBMITTAL
7	12/26/04	SEVENTH SUBMITTAL
Drawn by:		
Checked by:		
Sheet Title:	PROJECT DETAILS	
Sheet Number:	C6.5	