

E. D. ALEXANDER

ALBRIGHT

25" Trunk Sewer =
0+00 Line A Ridge Road
Village - 4 Dia. M.H. in
Spring Road Village Div.

C-16.40
M.H. 0-05

27" 90% Const.
4 Dia. M.H.


25" 11.5 Const.
4 Dia. M.H.

17" 7.5 Const.
4 Dia. M.H.

18" 7.5 Const.
4 Dia. M.H.

0+00	6+8	8+10	10+12	12+14	14+16	16+18
145	16	35	30	25	255	490
200	150	100	120	250	180	30
	23	325	165	595	150	
	25		45	45		
Total 2910						

S.W. Cor. Alexander Tract

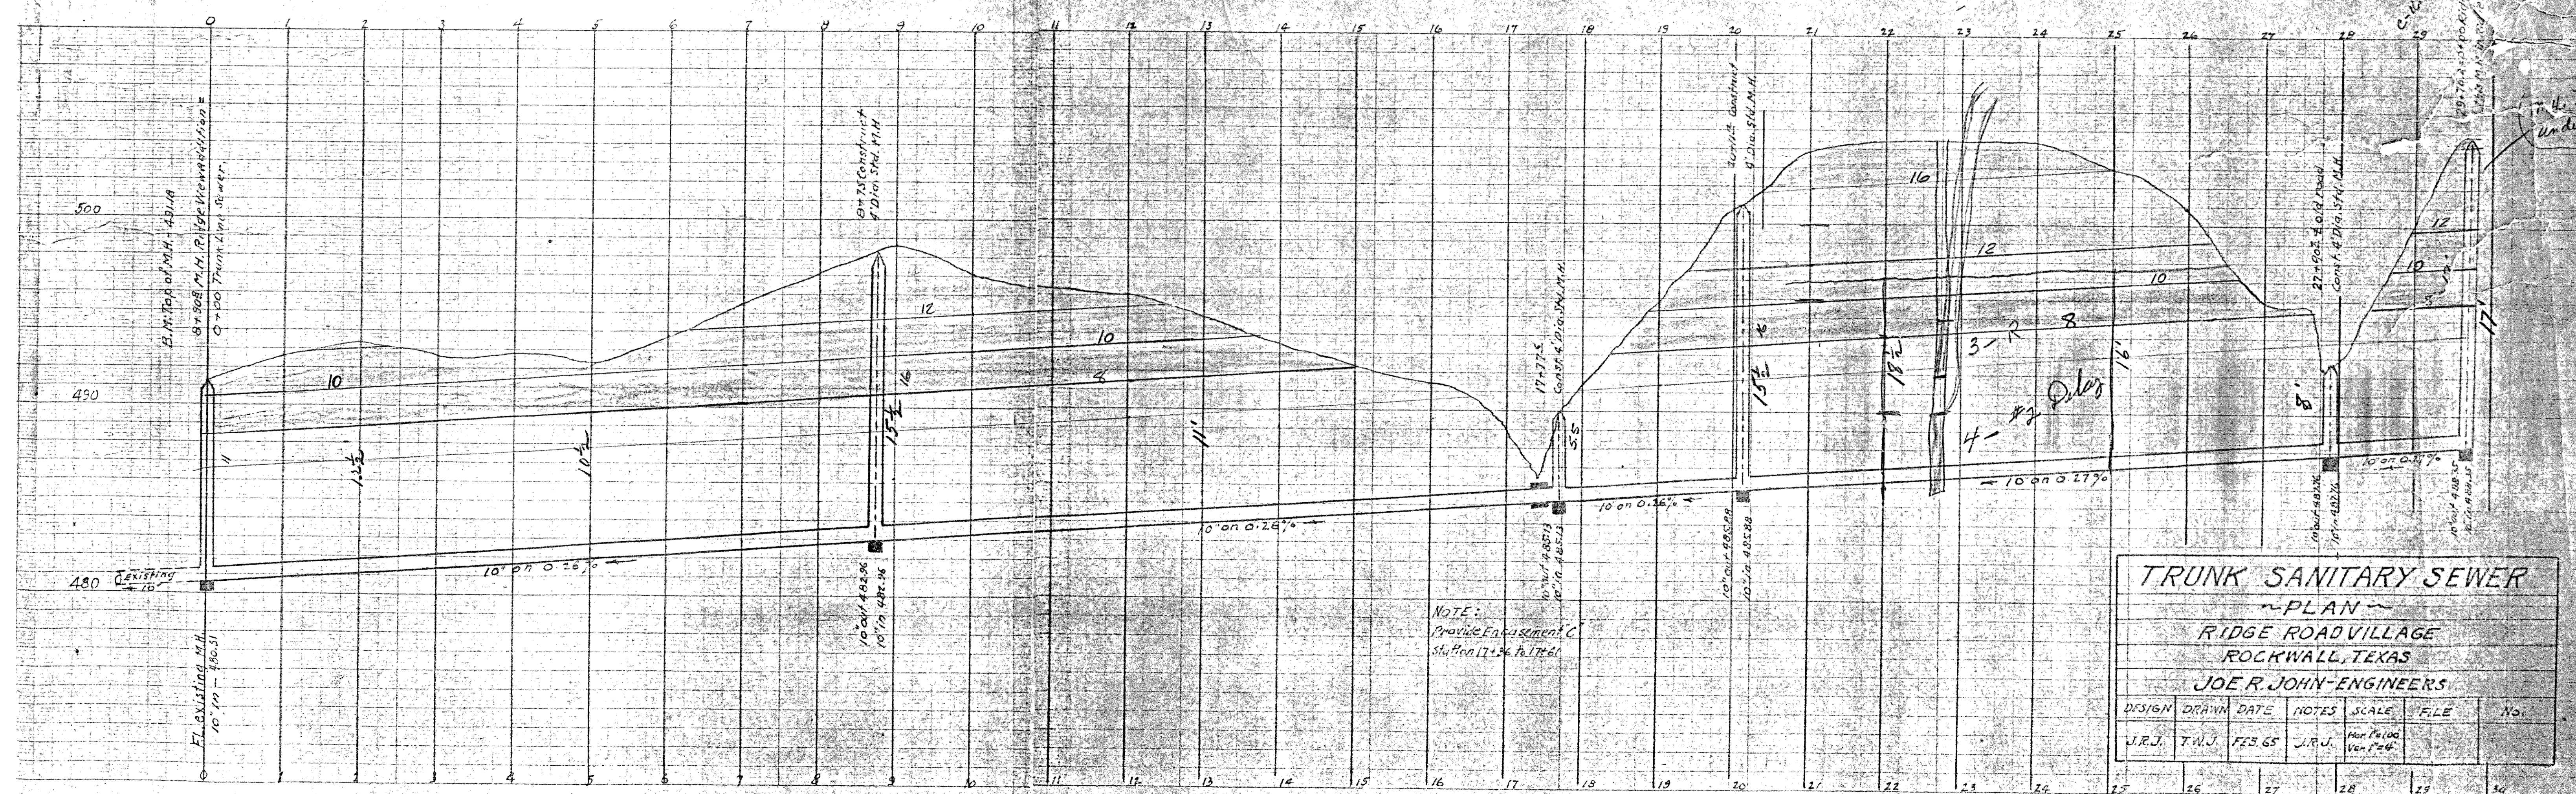

NOTE:
Provide Encasement
Station 17+26 to 17+61

TRUNK SANITARY SEWER
~ PLAN ~
RIDGE ROAD VILLAGE
ROCKWALL, TEXAS

JOE R. JOHN-ENGINEERS

DESIGN	DRAWN	DATE	NOTES	SCALE	FILE	No.
J.R.J.	T.W.J.	FEB. 65	J.R.J.	1" = 100'	100-1754	

25" Trunk Sewer =
0+00 Line A Ridge Road
Village - 4 Dia. M.H. in
Spring Road Village Div.

To be built
under ground