


*Note: Sewer Service are on Center line of all lots.
Water Service are 5' East of Center line of all lots.*

26112.7-10" Trunk Line
0+00 Line "A" Const. 4
Dio. M.H.

1182 Line "A"
0+00 Line "B"
Const. 4 Dio. M.H.

4479 Line "A"
0+00 Line "B"
Const. 4 Dio. M.H.

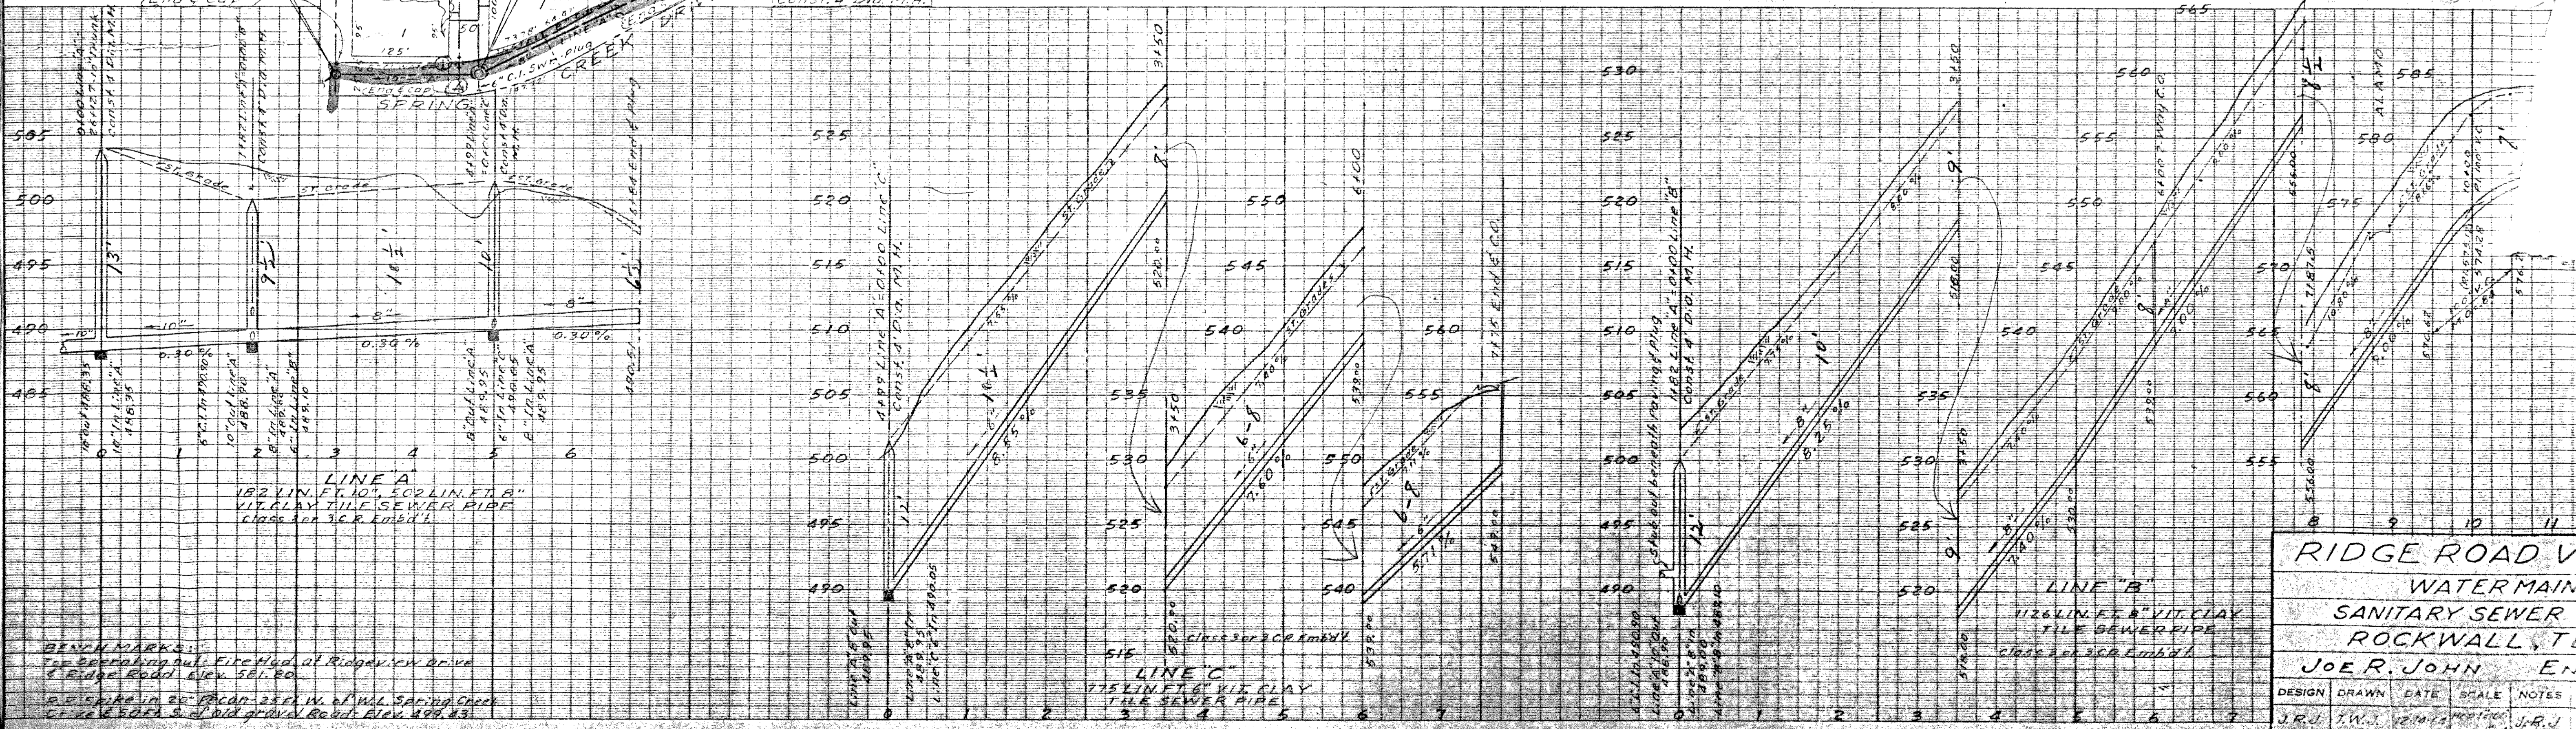

RIDGE ROAD VIL.				
WATER MAINS &				
SANITARY SEWER MAIN				
ROCKWALL, TEX.				
JOE R. JOHN ENG.				
DESIGN	DRAWN	DATE	SCALE	NOTES
J.R.J.	T.W.T.	12-18-12	VERTICAL	J.R.J.

BENCH MARKS:
Top Operating Bulb: Fire Hyd. at Ridgeview Drive
& Ridge Road Elev. 561.80

D.P. Spike in Dr. P.C. 23.1 W. of Wall Spring Creek
Corner & East S. of Old Grocery Road Elev. 498.43