


DEVELOPMENT PLANS
FOR
RIDGECREST
CITY OF ROCKWALL, TEXAS

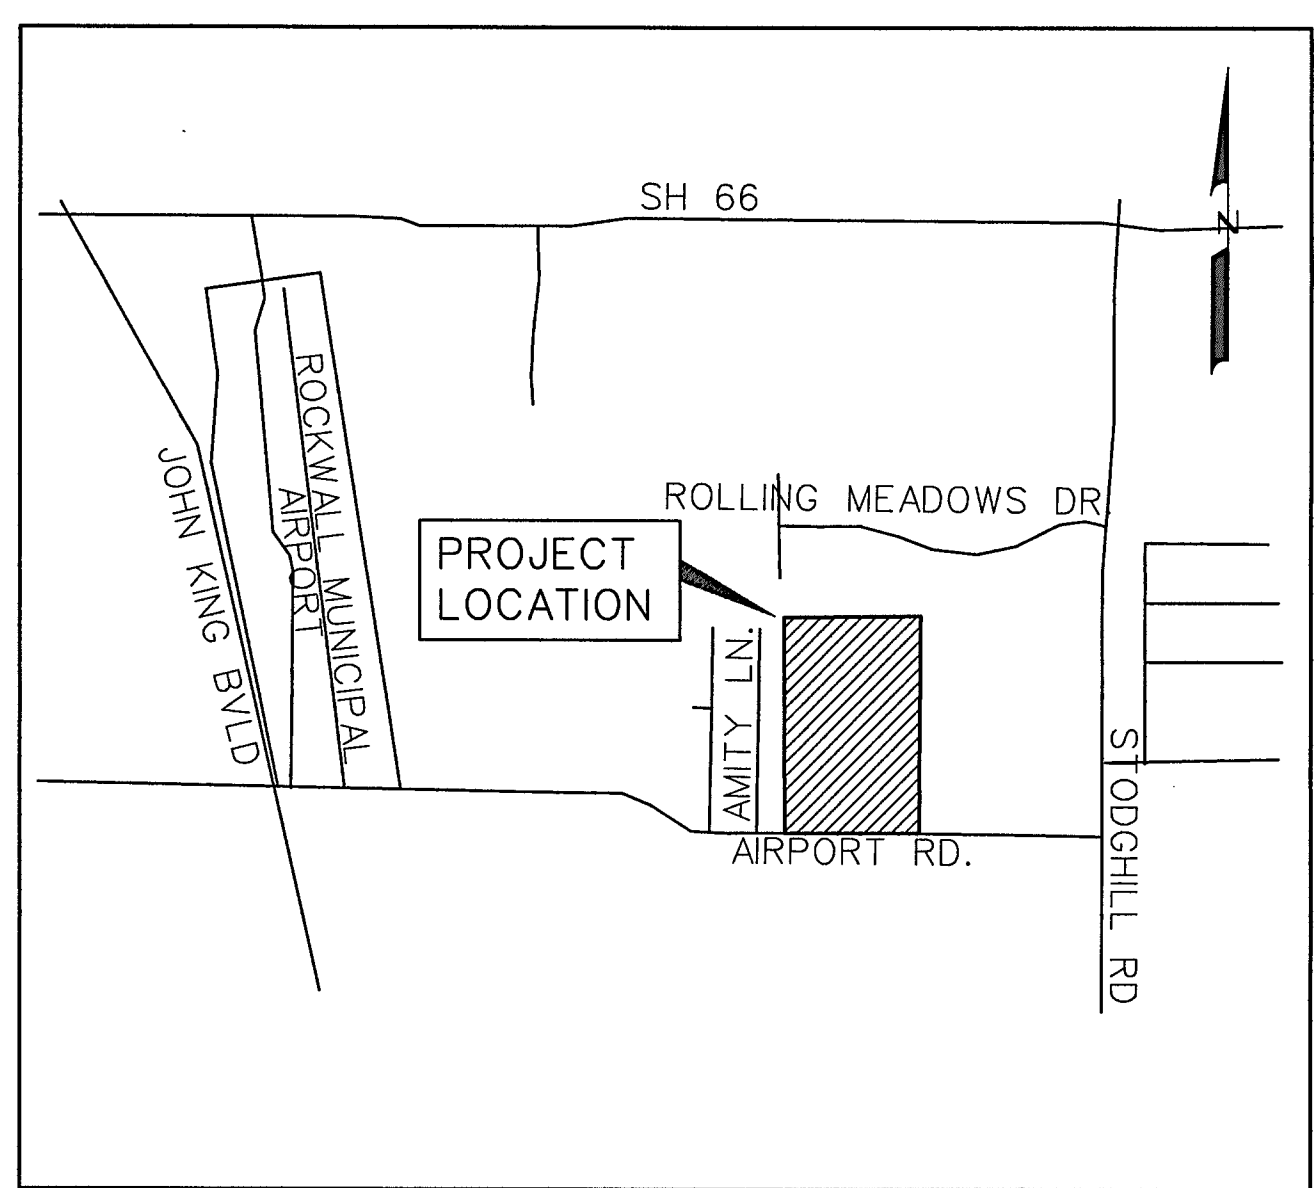

VICINITY MAP
NOT TO SCALE

INDEX

1	TITLE
2	PLAT
3	PRAIRIE VIEW ROAD
4	COYOTE CROSSING
5	FOX HOLLOW DRIVE
6	CYPRESS DRIVE
7	WATER AND SANITARY SEWER PLAN
8	SANITARY SEWER PROFILES
9	SANITARY SEWER PROFILES
10	EXISTING CONDITIONS DRAINAGE AREA MAP
11	DRAINAGE AREA MAP
12	DRAINAGE AREA MAP BLOCK C
13	DRIVEWAY CULVERT CALCULATIONS
14	STORM SEWER PLAN AND PROFILE LINES 'D-1', 'D-2' & 'D-3'
15	STORM SEWER PLAN AND PROFILE LINE 'D-4' & 'D-5'
16	DETENTION POND PLAN
17	GRADING PLAN
18	EROSION CONTROL PLAN
19	STREET SIGN PLAN

PREPARED FOR
RIDGECREST SF, LTD.

8214 WESTCHESTER DRIVE, SUITE 710 DALLAS, TEXAS 75225

CORWIN ENGINEERING, INC. — CONSULTING ENGINEERS

200 W. BELMONT, SUITE E

TBPE FIRM #5951

ALLEN, TEXAS 75013

NOTE:

CITY OF ROCKWALL STANDARDS
AND NCTCOG 3rd ADDITION STANDARDS
SHALL BE USED FOR REFERENCE.

AS-BUILT DECEMBER 2017
INFORMATION PROVIDED
BY CONTRACTORS
(NOT FIELD VERIFIED)





NO.	CITY COMMENTS	DATE
1		7/21/16
	REVISIONS	

CURVE NO.	DELTA	RADIUS	LENGTH	TANGENT	CHORD	BEARING
1.	89°10'11"	60.00'	283.61'	—	84.24'	N43°30'02"W
2.	25°37'24"	295.00'	131.93'	67.09'	130.83'	N13°58'10"E
3.	44°58'05"	305.00'	239.38'	126.24'	233.28'	N04°17'49"E
4.	18°52'33"	250.00'	82.36'	41.56'	81.99'	N08°44'57"W
5.	89°10'11"	60.00'	283.61'	—	84.24'	S44°43'35"E
6.	111°00'18"	250.00'	363.79'	363.79'	412.08'	S70°40'43"E
7.	90°49'49"	9.00'	14.27'	9.13'	12.82'	N45°16'25"E
8.	90°49'49"	9.00'	14.27'	9.13'	12.82'	N46°29'58"E
9.	45°29'46"	82.00'	65.11'	34.38'	63.42'	N32°22'35"W
10.	33°43'03"	152.00'	89.45'	46.06'	88.16'	N71°59'00"W

LINE TABLE

LINE NO.	BEARING	DISTANCE
1.	N 46°05'03" E	58.86'
2.	N 46°05'03" E	73.50'
3.	N 58°36'31" E	13.85'
4.	N 00°41'20" E	26.35'
5.	N 00°41'20" E	1.35'
6.	S 88°50'32" E	47.59'
7.	S 01°09'28" W	28.62'
8.	N 88°50'32" W	28.62'
9.	S 33°05'46" E	39.85'

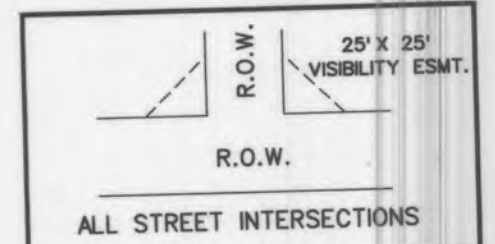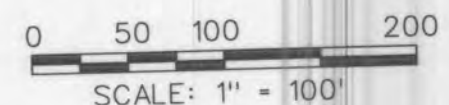

VISIBILITY & SIDEWALK EASEMENT DETAIL N.T.S.



LOCATION MAP N.T.S.

NOTES

- Bearing are referenced to Greenlee Addition (Cab. A, Slide 151).
- All lot lines are radial or perpendicular to the street unless otherwise noted by bearing.
- 1/2" iron rods with "CORWIN ENGR. INC." caps set at all boundary corners, block corners, points of curvature, points of tangency, and angle points in public right-of-way unless otherwise noted.
- B.L. - Building Line.
U.E. - Utility Easements.
C.M. - Controlling Monument.
D.E. - Drainage Easement
F.F. - Finished Floor
S.S.E. - Sanitary Sewer Easement
V.A.M.S. - Visibility, Maintenance & Sidewalk Easement
- No fences or structures allowed in any Drainage Easements.
- H.O.A. to maintain all Drainage Easements.

JEREMY EPTON
DOC. # 2015000014429

WHO FAMILY TRUST
VOL. 4768, PG. 282

CITY OF ROCKWALL GRID SYSTEM COORDINATES	
X	Y
2605979.23	7025872.53
ELEV = 580.8	

ROLLING MEADOWS ESTATES
CAB. D, SLIDE 59

CITY OF ROCKWALL GRID SYSTEM COORDINATES	
X	Y
2605015.83	7027187.53
ELEV = 572.3	

CITY OF ROCKWALL GRID SYSTEM COORDINATES	
X	Y
2605979.23	7025872.53
ELEV = 580.8	

$\Delta = 03^\circ 15' 38''$
 $R = 732.50'$
 $T = 20.85'$
 $L = 41.69'$
 $C = 41.68'$
 $B = N89^\circ 24' 02'' W$



FINAL PLAT OF **J 063**
RIDGECREST
 45 LOTS, BEING 28.94 ACRES
 BEING A REPLAT
LOT 1 & 2 BLOCK A
 OF
ROCKWALL LAKESIDE CHURCH OF CHRIST ADDITION
 SITUATED IN THE
E.M. ELLIOTT SURVEY, ABSTRACT NO. 77
 IN THE
**CITY OF ROCKWALL
 ROCKWALL COUNTY, TEXAS**
 PREPARED BY
CORWIN ENGINEERING, INC.
 200 W. BELMONT, SUITE E
 ALLEN, TEXAS 75013
 972-396-1200
 OWNER
RIDGECREST SF, LTD.
 8214 WESTCHESTER DRIVE, SUITE 710
 DALLAS, TEXAS 75225
 DECEMBER 2016 SCALE 1" = 100'
CASE # P2016-045

OWNER'S CERTIFICATE

NOW, THEREFORE, KNOW ALL MEN BY THESE PRESENTS:

STATE OF TEXAS
COUNTY OF ROCKWALL

We the undersigned owners of the land shown on this plot, and designated herein as the RIDGECREST, subdivision to the City of Rockwall, Texas, and whose name is subscribed hereto, hereby dedicate to the use of the public forever all streets, alleys, parks, water courses, drains, easements and public places thereon shown on the purpose and consideration therein expressed. We further certify that all other parties who have a mortgage or lien interest in the RIDGECREST, subdivision have been notified and signed this plot.

We understand and do hereby reserve the easement strips shown on this plot for the purposes stated and for the mutual use and accommodation of all utilities desiring to use or using same. We also understand the following:

- No buildings shall be constructed or placed upon, over, or across the utility easements as described herein.
- Any public utility shall have the right to remove and keep removed all or part of any buildings, fences, trees, shrubs, or other growths or improvements which in any way endanger or interfere with construction, maintenance or efficiency of their respective system on any of these easement strips; and any public utility shall at all times have the right of ingress or egress to, from and upon the said easement strips for purpose of construction, reconstruction, inspecting, patrolling, maintaining, and either adding to or removing all or part of their respective system without the necessity of, at any time, procuring the permission of anyone.
- The City of Rockwall will not be responsible for any claims of any nature resulting from or occasioned by the establishment of grade of streets in the subdivision.
- The developer and subdivision engineer shall bear total responsibility for storm drain improvements.
- The developer shall be responsible for the necessary facilities to provide drainage patterns and drainage controls such that properties within the drainage area are not adversely affected by storm drainage from the development.
- The detention drainage system is to be maintained, repaired and owned by the subdivision/HOA. The drainage easements shall be maintained, repaired, and replaced to approved plan conditions by the subdivision/HOA.
- No house dwelling unit, or other structure shall be constructed on any lot in this addition by the owner or any other person until the developer and/or owner has complied with all requirements of the Subdivision Regulations of the City of Rockwall regarding improvements with respect to the entire block on the street or streets on which property abuts, including the actual installation of streets with the required base and paving, curb and gutter, water and sewer, drainage structures, storm structures, storm sewers, and alleys, all according to the specifications of the City of Rockwall; or


Until an escrow deposit, sufficient to pay for the cost of such improvements, as determined by the city's engineer and/or city administrator, computed on a private commercial rate basis, has been made with the city secretary, accompanied by an agreement signed by the developer and/or owner, authorizing the city to make such improvements at prevailing private commercial rates, or have the same made by a contractor and pay for the same out of the escrow deposit, should the developer and/or owner fail or refuse to install the required improvements within the time stated in such written agreement, but in no case shall the City be obligated to make such improvements itself. Such deposit may be used by the owner and/or developer as progress payments as the work progresses in making such improvements by making certified requisitions to the city secretary, supported by evidence of work done; or

Until the developer and/or owner files a corporate surety bond with the city secretary in a sum equal to the cost of such improvements for the designated area, guaranteeing the installation thereof within the time stated in the bond, which time shall be fixed by the city council of the City of Rockwall.

We further acknowledge that the dedications and/or exaction's made herein are proportional to the impact of the Subdivision upon the public services required in order that the development will comport with the present and future growth needs of the City; we, our successors and assigns hereby waive any claim, damage, or cause of action that we may have as a result of the dedication of exactions made herein.

RIDGECREST, SF, LTD.
a Texas limited partnership
By: RIDGECREST SF, GP Corporation,
a Texas corporation, its General Partner

Richard M. Skorburg
Richard M. Skorburg
President

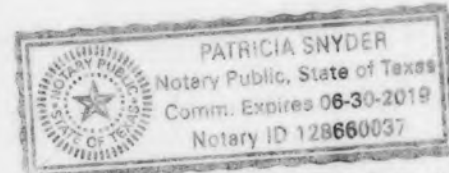

STATE OF TEXAS
COUNTY OF
Before me, the undersigned authority, on this day personally appeared RICHARD M. SKORBURG, known to me to be the person whose name is subscribed to the foregoing instrument, and acknowledged to me that he executed the same for the purpose and consideration therein stated. Given upon my hand and seal of office this 15 day of December, 2016.

Notary Public in and for the State of Texas My Commission Expires: 6-30-2019

Patricia Snyder

NOTE: It shall be the policy of the City of Rockwall to withhold issuing building permits until all streets, water, sewer and storm drainage systems have been accepted by the City. The approval of a plot by the City does not constitute any representation, assurance or guarantee that any building within such plot shall be approved, authorized or permit therefore issued, nor shall such approval constitute any representation, assurance or guarantee by the City of the adequacy and availability for water for personal use and fire protection within such plot, as required under Ordinance 83-54.

LEGAL DESCRIPTION

WHEREAS, RIDGECREST SF, LTD., is the owner of a tract of land situated in the E.M. Elliott Survey, Abstract No. 77 in Rockwall County, Texas, being all of Lot 2 Block A and a portion of Lot 1 Block A, out of Rockwall Lakeside Church of Christ Addition, an addition to the City of Rockwall, as described in Cabinet F, Slide 72-78, in the Plat Records of Rockwall County, Texas, being more particularly described as follows:

BEGINNING, at a 1/2 inch iron rod found at the southwest corner of said Rockwall Lakeside Church of Christ Addition and being the southeast corner of Greenlee Addition, an addition to the City of Rockwall, as described in Cab. A, Slide 151, in said Plat Records:

THENCE, North 01° 05' 03" East, along the west line of said Rockwall Lakeside Church of Christ Addition and along the east line of said Greenlee Addition, for a distance of 1325.57 feet, to a 1/2 inch iron rod found at the northwest corner of said Rockwall Lakeside Church Addition, being in the south line of Rolling Meadows Estates, an addition to the City of Rockwall, as described in Cab. D, Slide 59 in said Plat Records:

THENCE, South 89° 18' 40" East, along the north line of said Rockwall Lakeside Church Addition and the south line of said Rolling Meadows Estates, at 894.47 feet, passing the northeast corner of said Lot 2 Block A and the northwest corner of said Lot 1 Block A, for a total distance of 954.47 feet, to a 1/2 inch iron rod set with a yellow cap stamped "Corwin Eng. Inc.":

THENCE, South 01° 09' 28" West, departing said north and south lines, for a distance of 1328.97 feet, to a 3/8 inch iron rod found being in the north line of Airport Road (75' R.O.W.), and being the most southerly southeast corner of said Lot 1 Block A:

THENCE, North 87° 46' 13" West, along the south line of said Lot 1 Block A at 60.00 feet, passing the most southerly southwest corner of said Lot 1 Block A and the southeast corner of said Lot 2 Block A and with the north line of Airport Road, and continuing for a total distance of 482.31 feet, to a 1/2 inch iron rod found, at the point of curvature of a curve to the left, having a radius of 732.50 feet, a central angle of 03° 15' 38", and a tangent of 20.85 feet:

THENCE, along the north line of said Airport Road and the south line of said Lot 2 Block A with said curve to the left for an arc distance of 41.69 feet (Chord Bearing North 89° 24' 02" West - 41.68 feet), to a 1/2 inch iron rod found at the point of tangency:

THENCE, South 88° 58' 08" West, continuing along said lines, for a distance of 341.01 feet, to a 1/2 inch iron rod found:


THENCE, North 88° 50' 39" West, continuing along said lines, for a distance of 88.07 feet, to the POINT OF BEGINNING and containing 28.941 acres of land.

SURVEYOR CERTIFICATE

I, WARREN L. CORWIN, do hereby certify that the plot shown hereon accurately represents the results of an on-the-ground survey made under my direction and supervision and all corners are as shown thereon and there are no encroachments, conflicts, protrusions or visible utilities on the ground except as shown and said plot has been prepared in accordance with the plotting rules and regulations of the City Plan Commission of the City of Rockwall, Texas.

DATED the this 15 day of Dec., 2016.

Warren L. Corwin
WARREN L. CORWIN
R.P.L.S. No. 4621

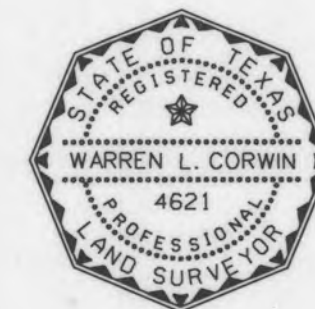


THE STATE OF TEXAS
COUNTY OF COLLIN

BEFORE ME, the undersigned, a Notary Public in and for the State of Texas, on this day personally appeared WARREN L. CORWIN, known to me to be the person whose name is subscribed to the foregoing instrument and acknowledged to me that he executed the same in the capacity therein stated and for the purposes and considerations therein expressed.

WITNESS MY HAND AND SEAL OF OFFICE, this the 15 day of Dec., 2016.

Maria E. Halford
Notary Public in and for the State of Texas

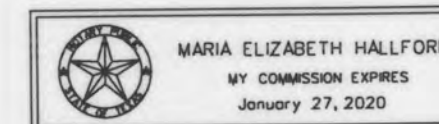

Patricia Snyder
Planning & Zoning Commission

11/15/2016
Date

APPROVED

I hereby certify that the above and foregoing plot of an addition to the City of Rockwall, Texas, was approved by the City Council of the City of Rockwall on the 11 day of Nov, 2016.

This approval shall be invalid unless the approved plot for such addition is recorded in the office of the Court Clerk of Rockwall, County, Texas, within one hundred eighty (180) days from said date of final approval.

WITNESS OUR HANDS, this 20th day of Dec., 2016.

Janice Pennington
Mayor, City of Rockwall

Kristy Cole
City Secretary

Ammy Williams
City Engineer

Filed and Recorded
Official Public Records
Shelli Miller, County Clerk
Rockwall County, Texas
12/22/2016 01:37:15 PM
\$100.00
2016000022744




COPY

Shelli Miller




FINAL PLAT OF J 064
RIDGECREST
45 LOTS, BEING 28.941 ACRES
BEING A REPLAT
LOT 1 & 2 BLOCK A
OF
**ROCKWALL LAKESIDE CHURCH
OF CHRIST ADDITION**
SITUATED IN THE
E.M. ELLIOTT SURVEY, ABSTRACT NO. 77
IN THE
**CITY OF ROCKWALL
ROCKWALL COUNTY, TEXAS**
PREPARED BY
CORWIN ENGINEERING, INC.
200 W. BELMONT, SUITE E
ALLEN, TEXAS 75013
972-396-1200
OWNER
RIDGECREST SF, LTD.
8214 WESTCHESTER DRIVE, SUITE 710
DALLAS, TEXAS 75225
DECEMBER 2016 SCALE 1" = 100'

Ridgecrest
Lots & 2, Block A
Final Plat

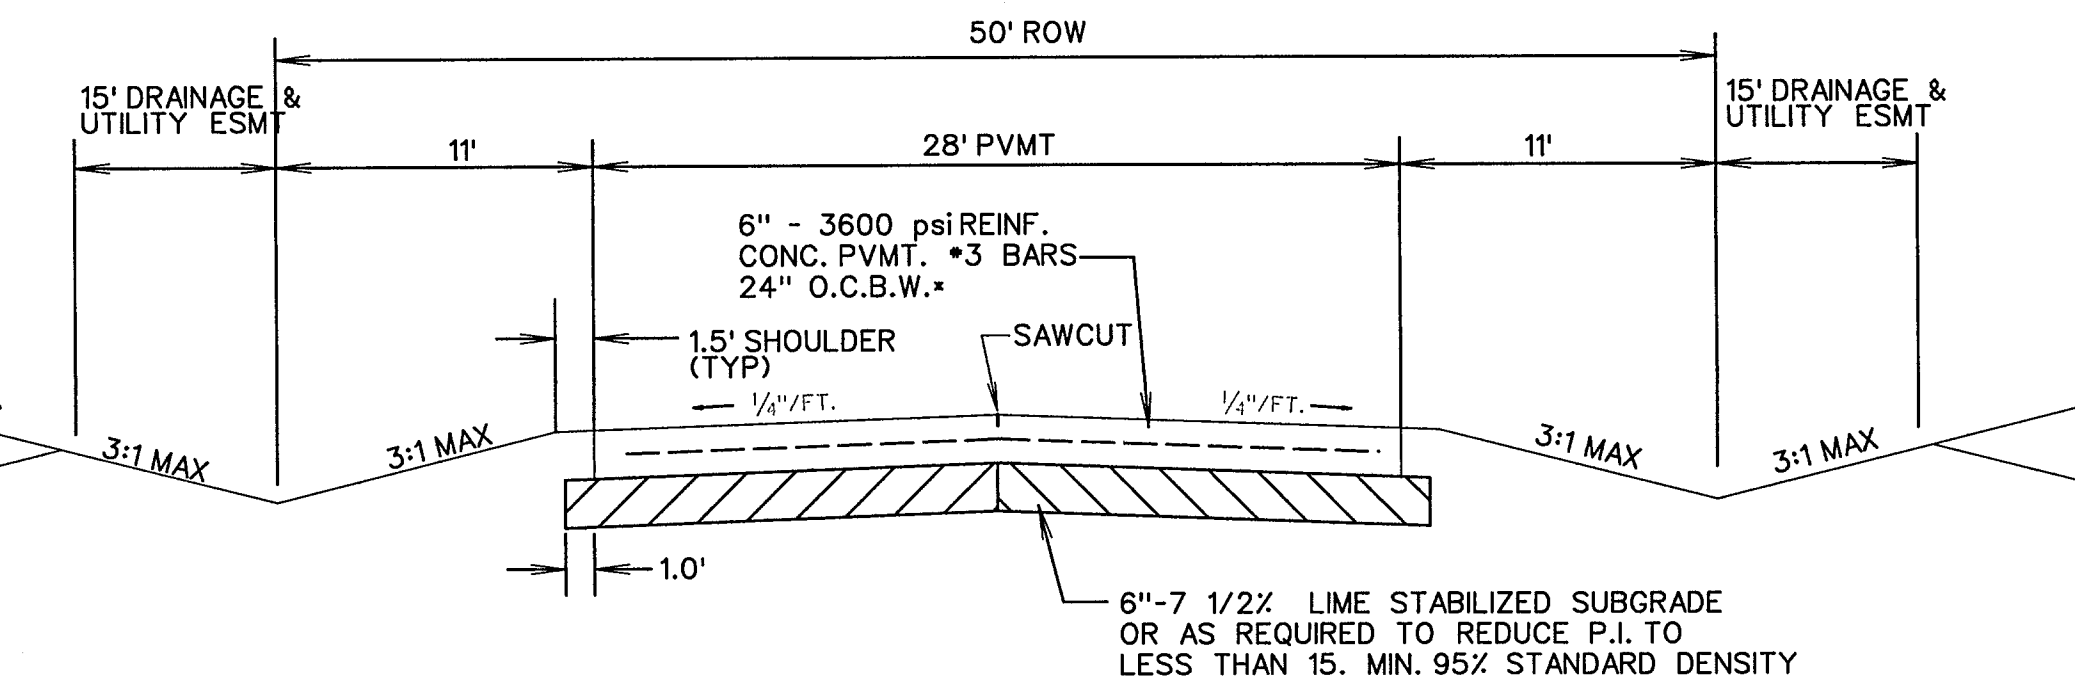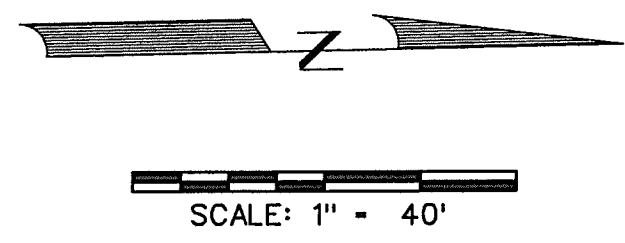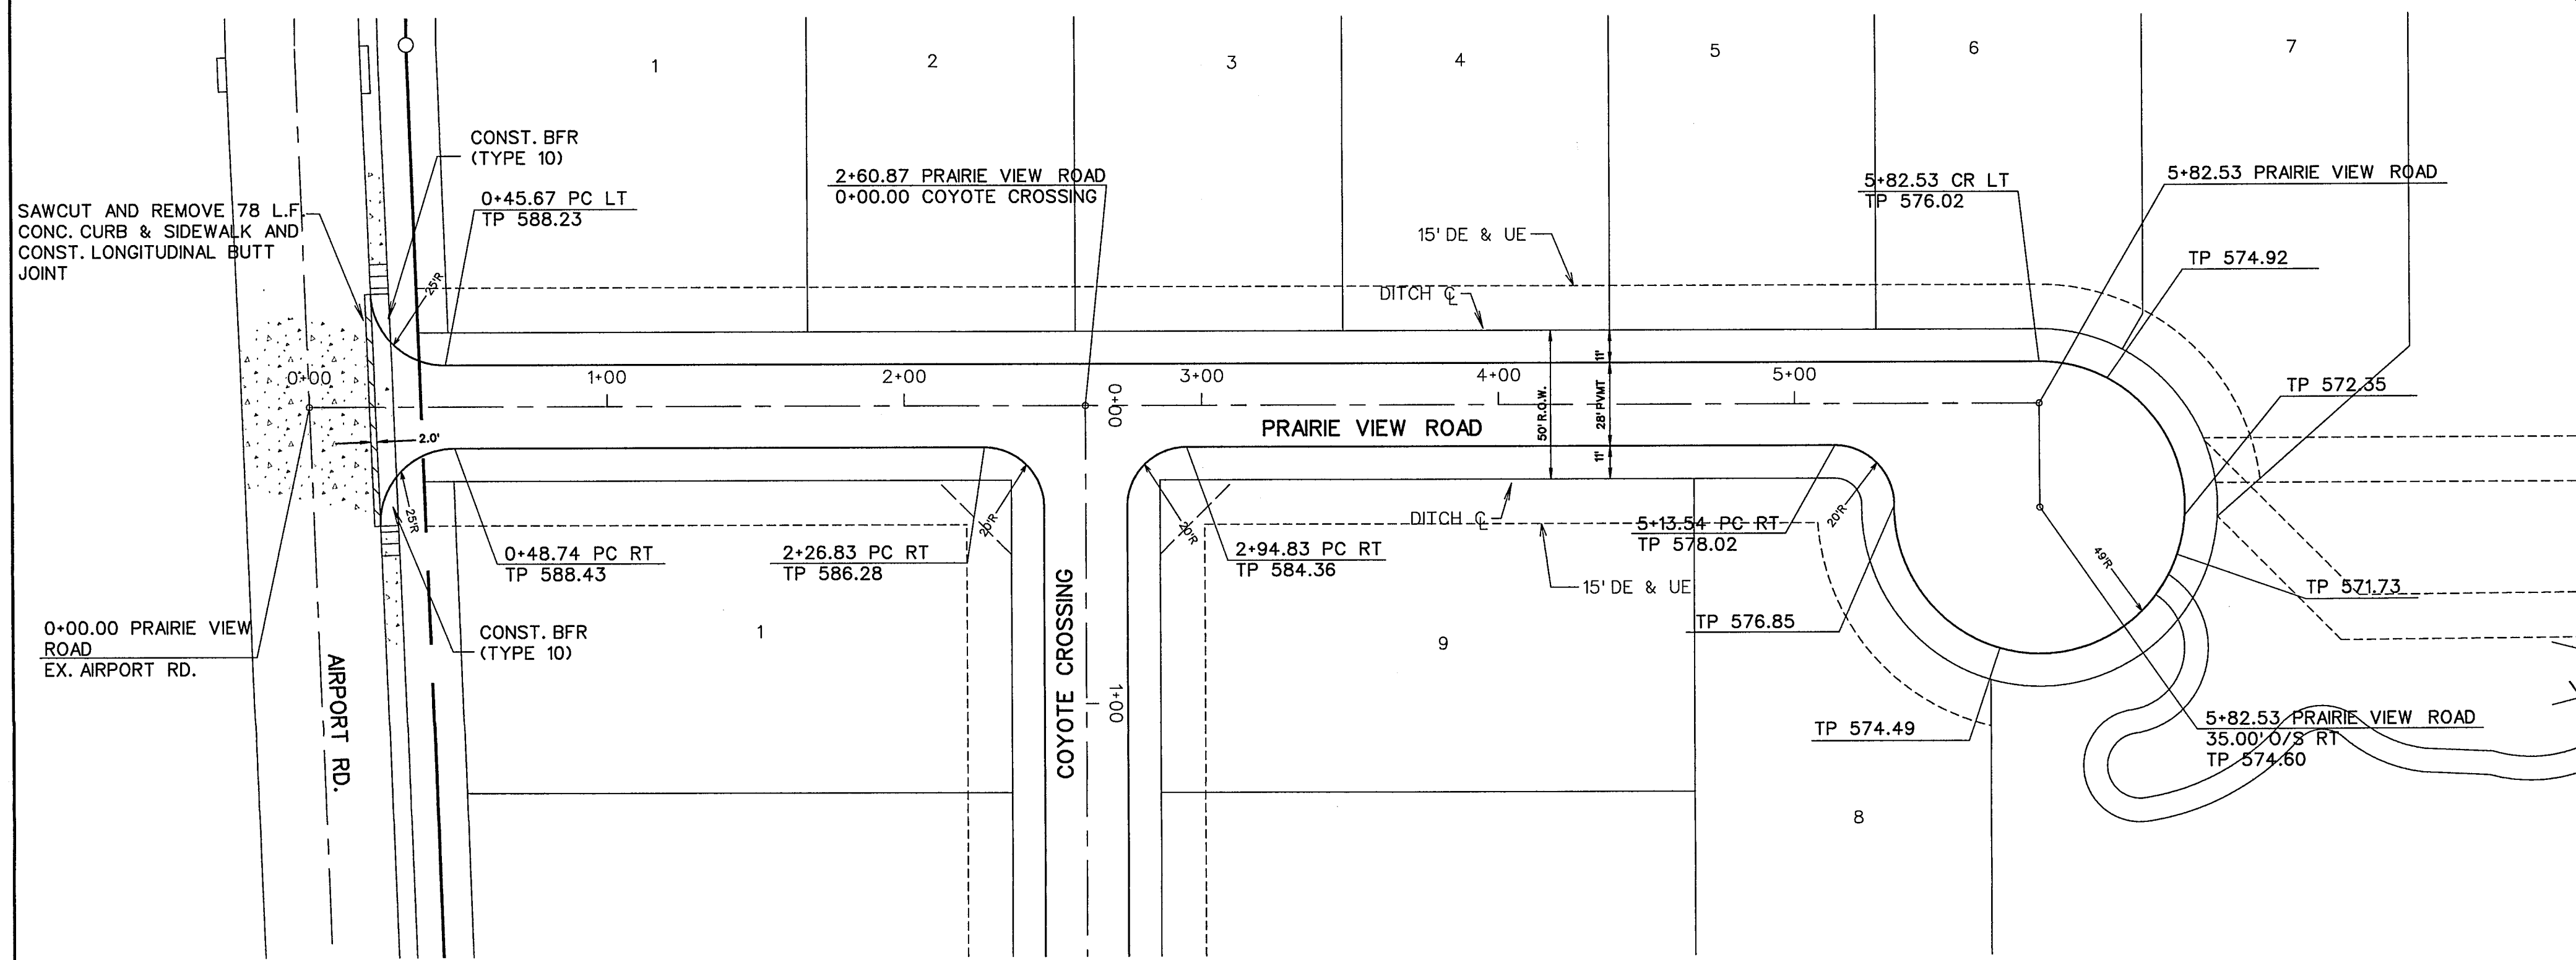

TYPICAL PAVEMENT SECTION
N.T.S.
*MIN. 6.5 SACK MIX IF HAND PLACED
6.0 SACK IF MACHINE PLACED

BENCHMARK:
" X " Cut on inlet on the south side of Airport Rd.
approx. 670' east of the centerline of Amity Ln.
ELEVATION = 589.96

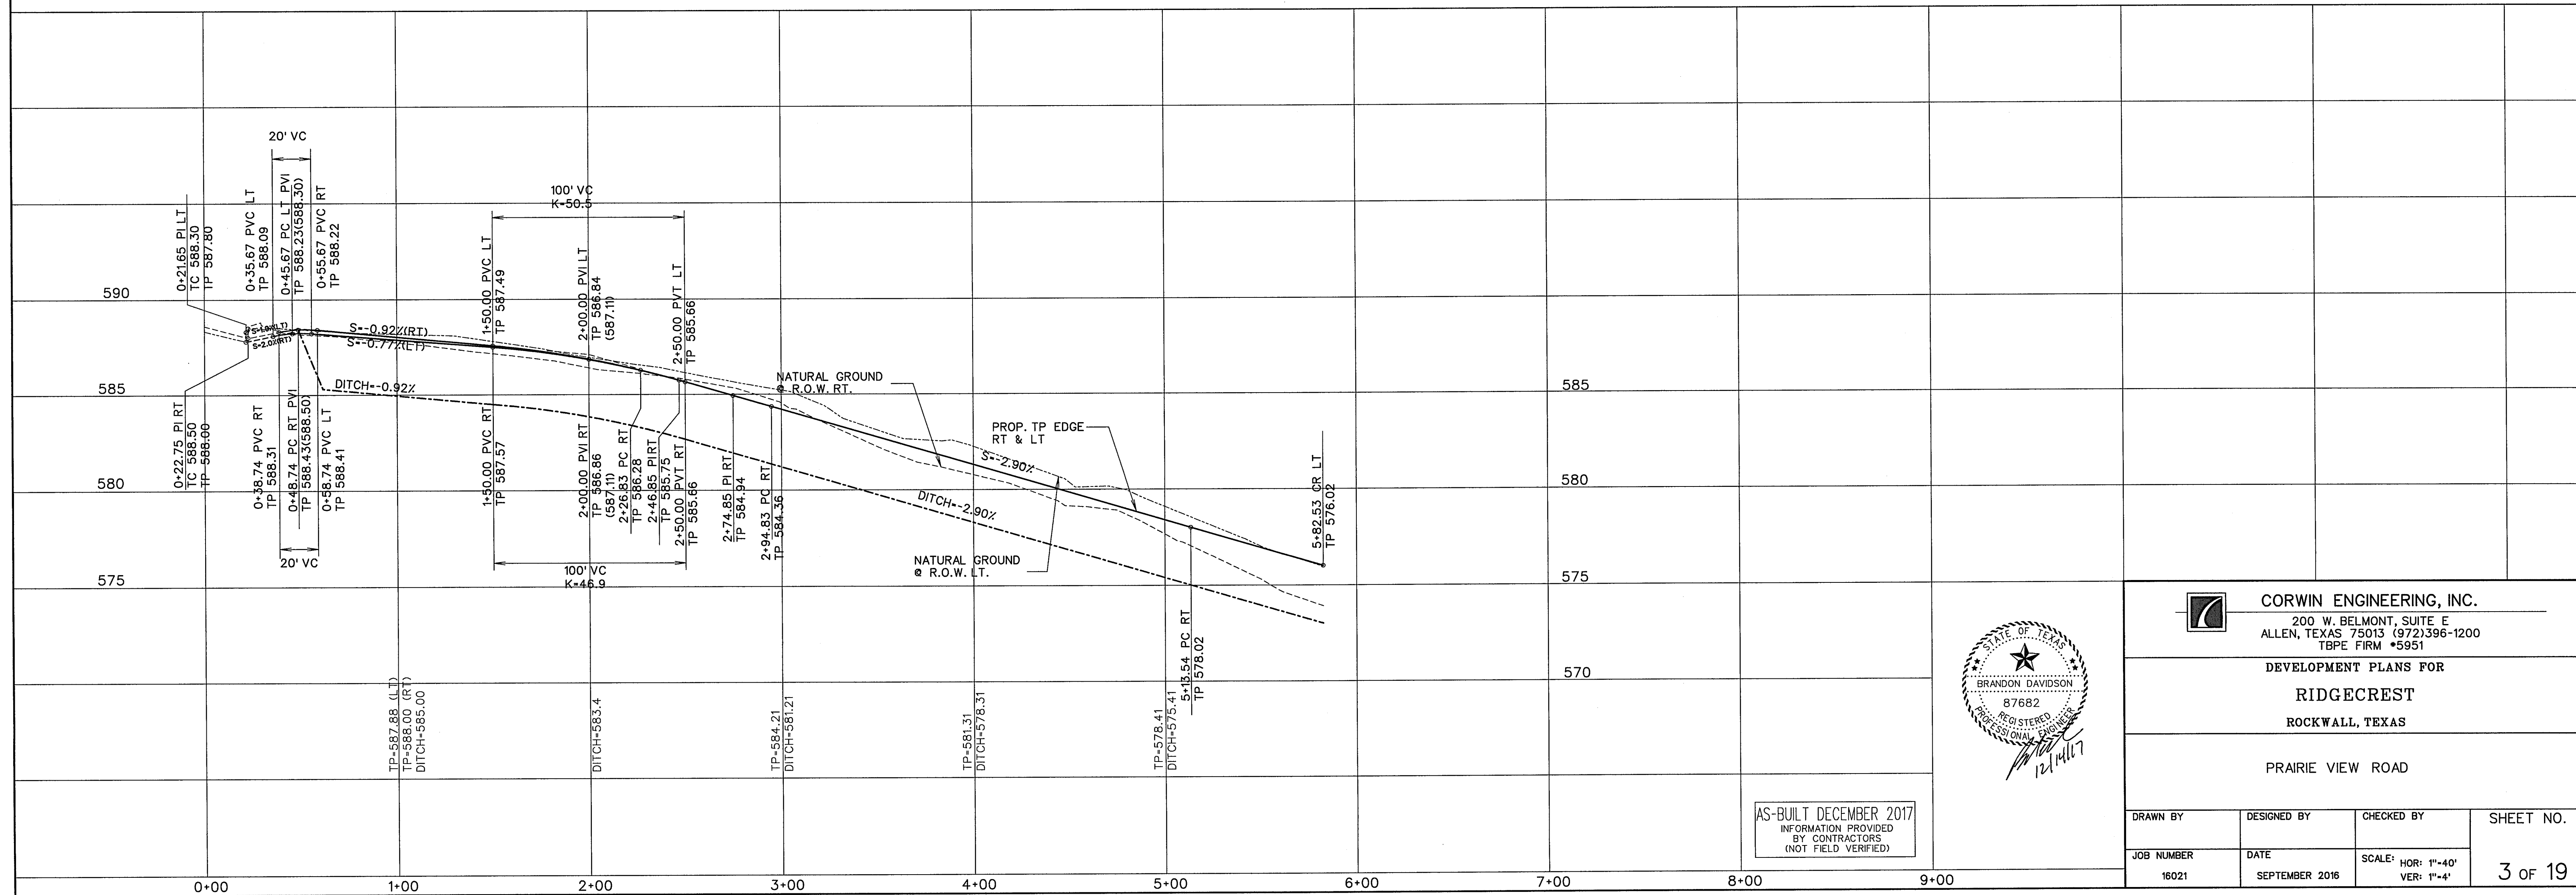


AS-BUILT DECEMBER 2017
INFORMATION PROVIDED
BY CONTRACTORS
(NOT FIELD VERIFIED)

CORWIN ENGINEERING, INC.
200 W. BELMONT, SUITE E
ALLEN, TEXAS 75013 (972)396-1200
TBE FIRM #5951

DEVELOPMENT PLANS FOR
RIDGECREST
ROCKWALL, TEXAS

PRAIRIE VIEW ROAD



DRAWN BY	DESIGNED BY	CHECKED BY	SHEET NO.
JOB NUMBER	DATE	SCALE: HOR: 1"=40' VER: 1"=4'	3 of 19
18021	SEPTEMBER 2016		

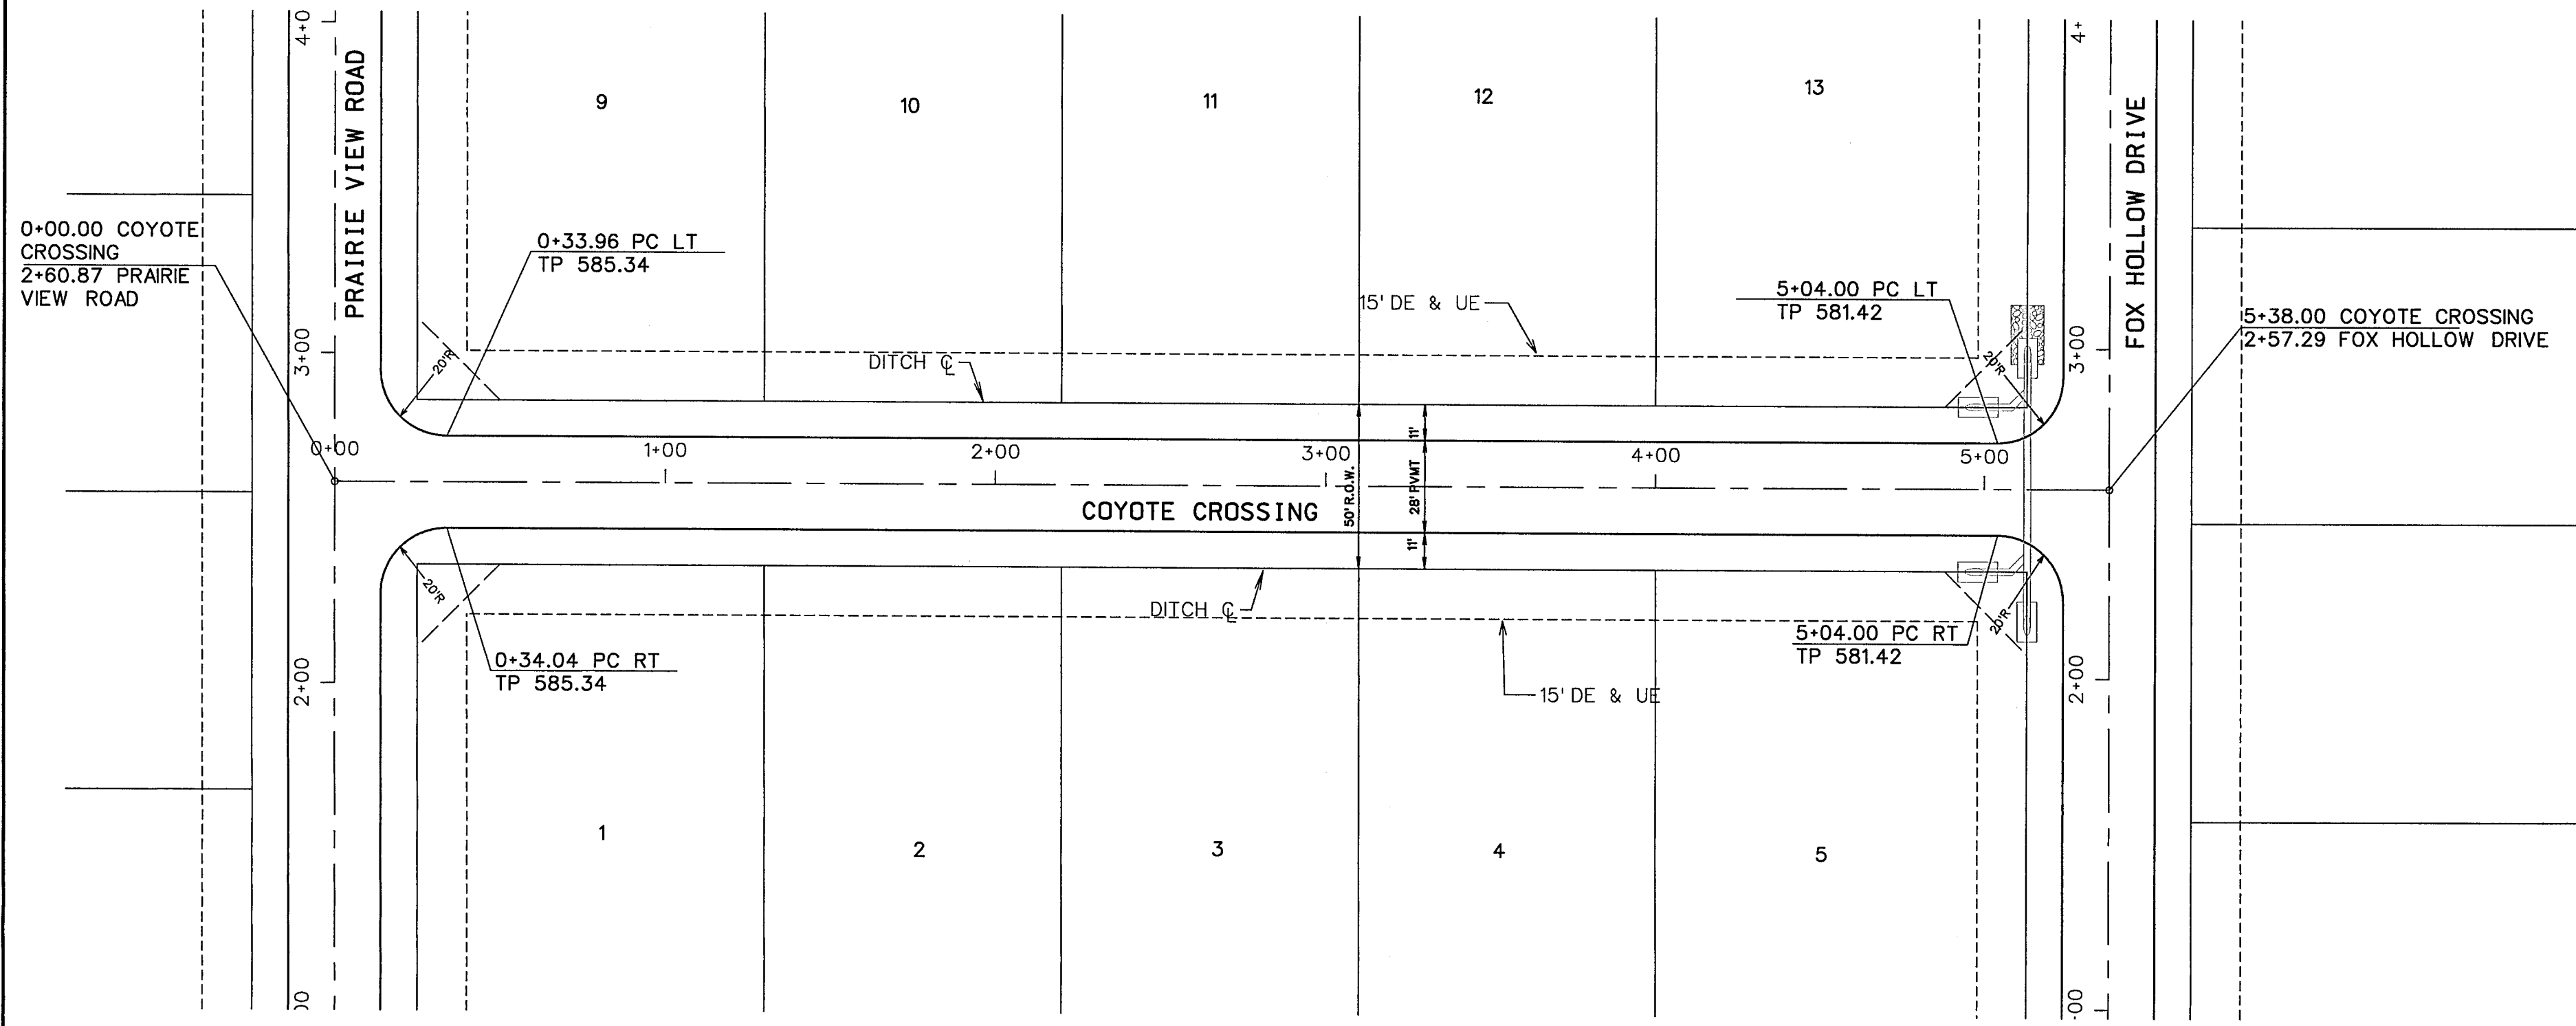

BENCHMARK:

" X " Cut on inlet on the south side of Airport Rd.
approx. 670' east of the centerline of Amity Ln.

ELEVATION = 589.96

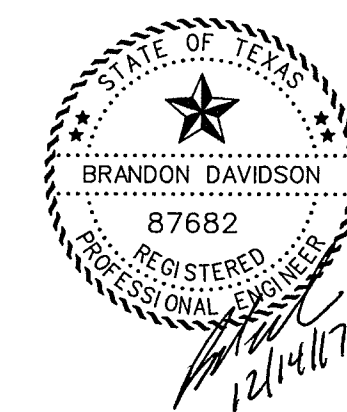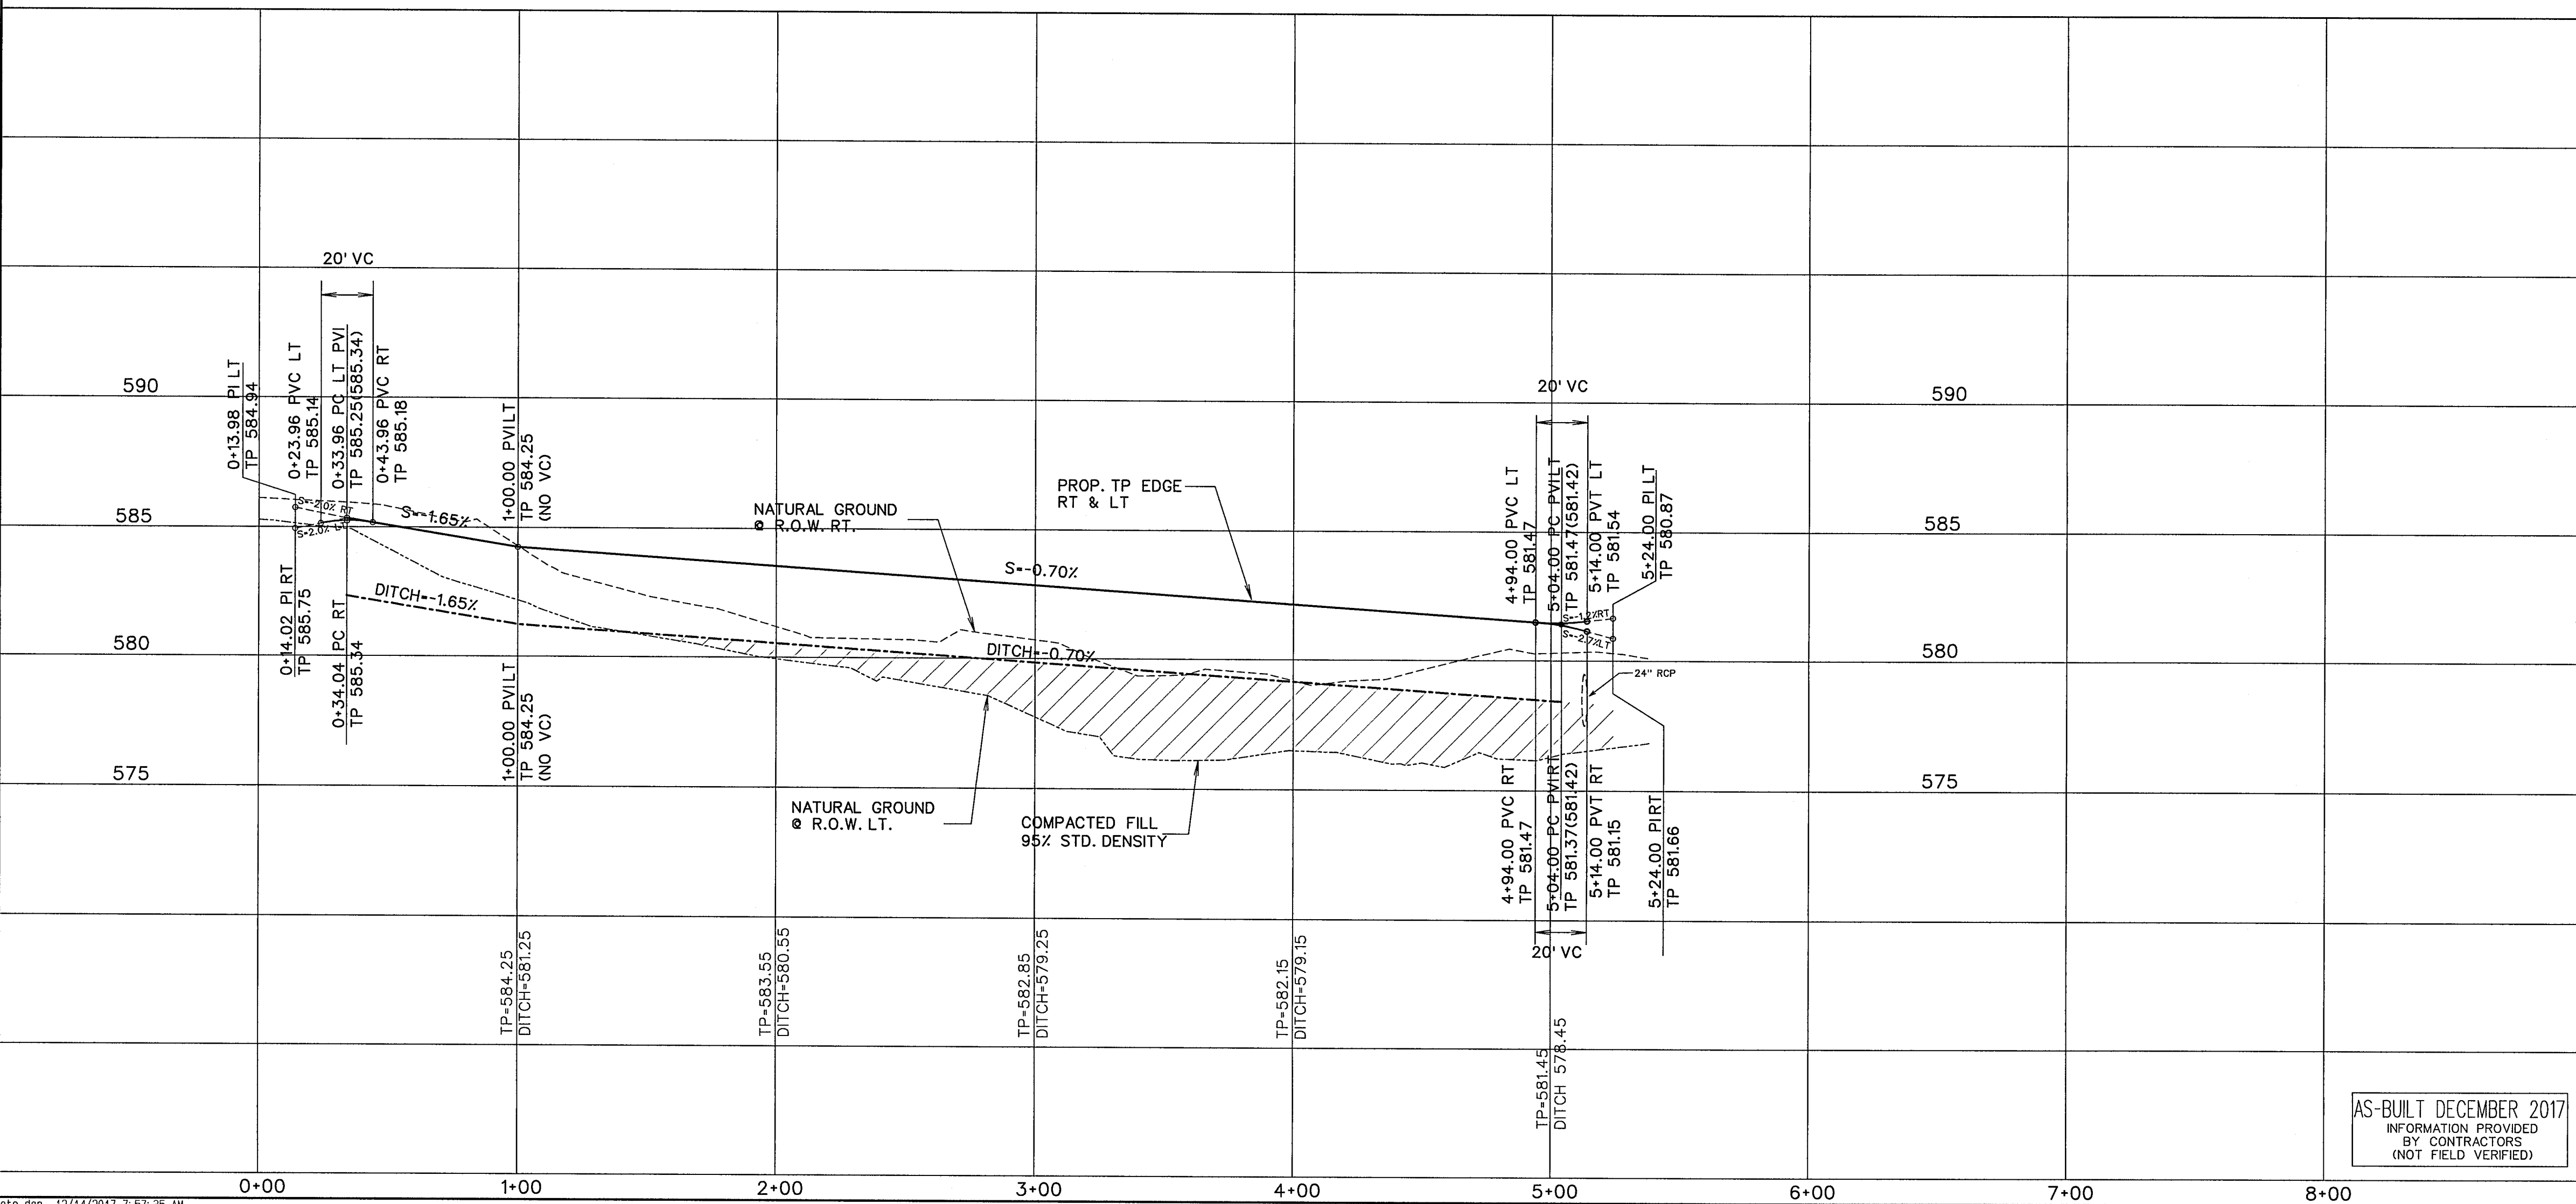



AS-BUILT DECEMBER 2017
INFORMATION PROVIDED
BY CONTRACTORS
(NOT FIELD VERIFIED)

CORWIN ENGINEERING, INC.
200 W. BELMONT, SUITE E
ALLEN, TEXAS 75013 (972)396-1200
TBPE FIRM #5951


DEVELOPMENT PLANS FOR
RIDGECREST
ROCKWALL, TEXAS

COYOTE CROSSING

DRAWN BY	DESIGNED BY	CHECKED BY	SHEET NO.
JOB NUMBER	DATE	SCALE: HOR: 1"=40' VER: 1"=4'	4 OF 19
16021	SEPTEMBER 2016		

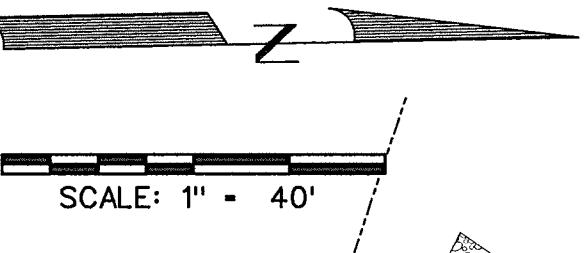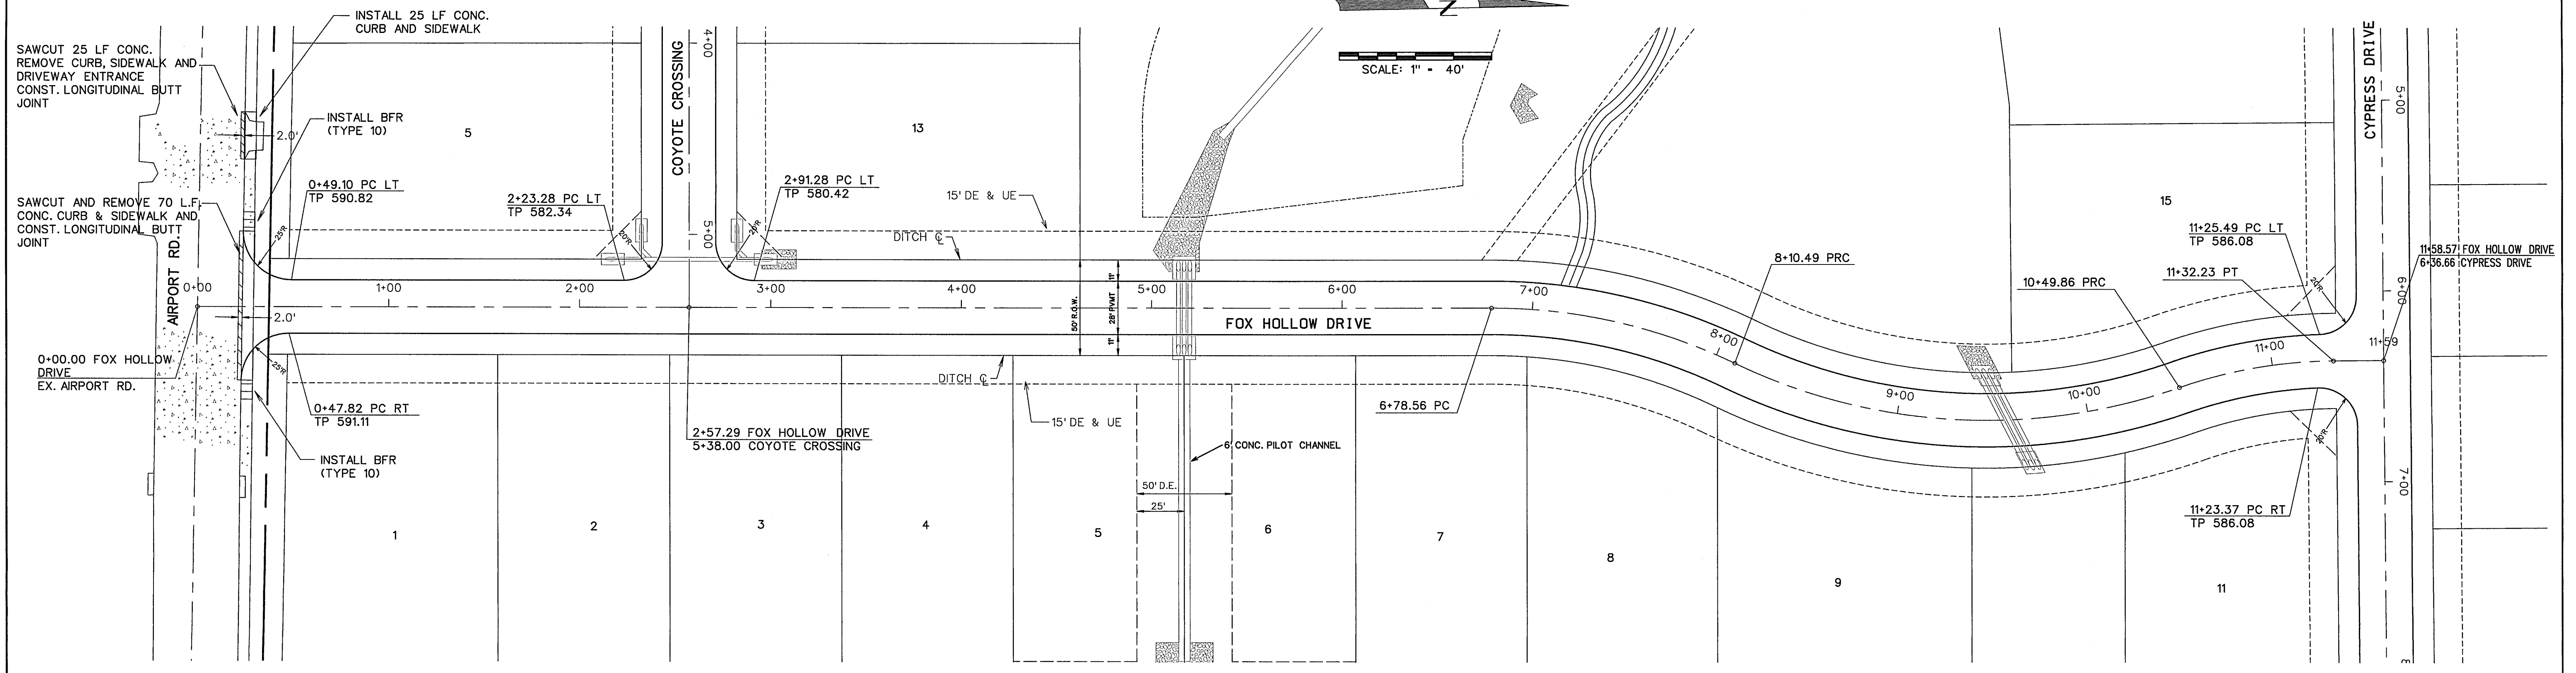

BENCHMARK:
 " X " Cut on inlet on the south side of Airport Rd.
 approx. 670' east of the centerline of Amity Ln.
 ELEVATION = 589.96

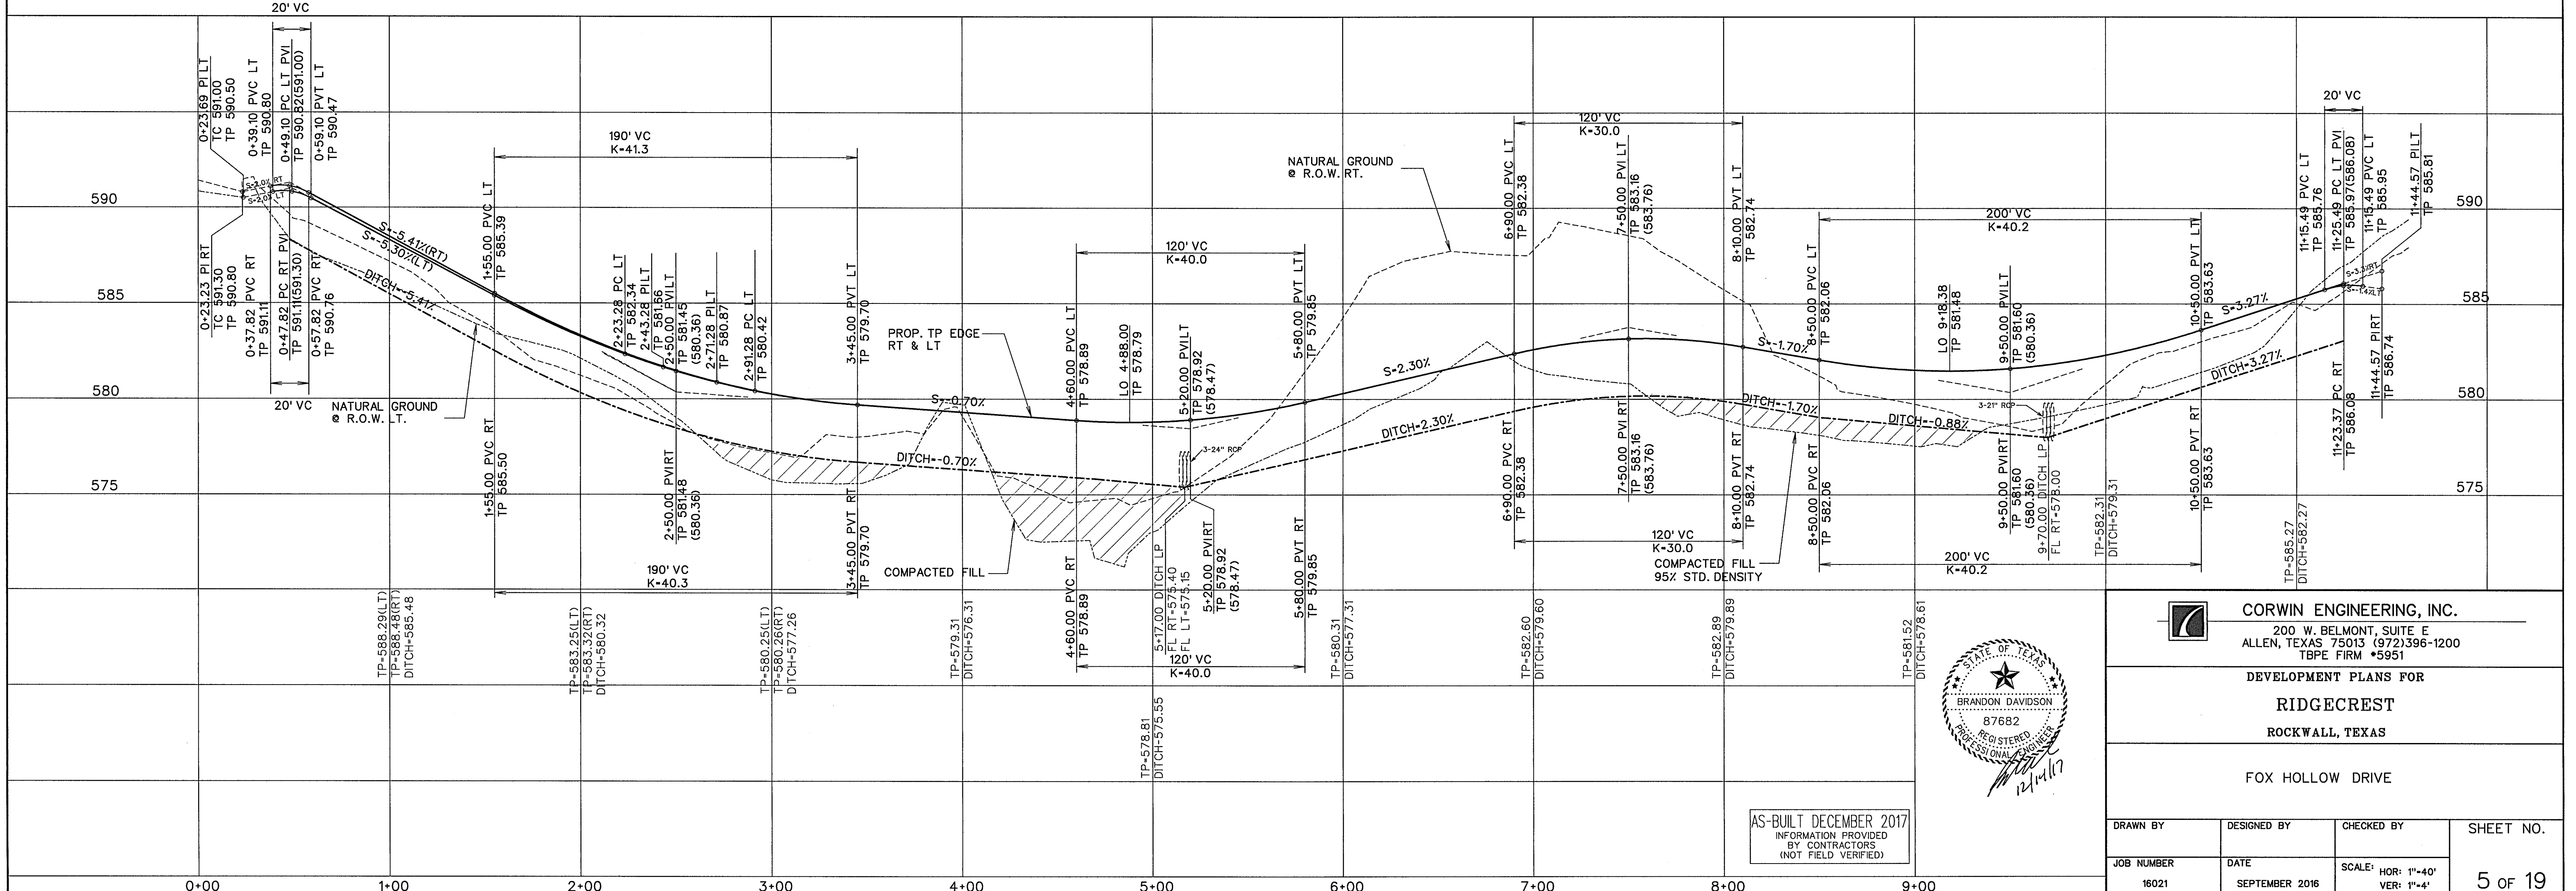

CORWIN ENGINEERING, INC.
 200 W. BELMONT, SUITE E
 ALLEN, TEXAS 75013 (972)396-1200
 TBPE FIRM #5951



DEVELOPMENT PLANS FOR
RIDGECREST
 ROCKWALL, TEXAS

FOX HOLLOW DRIVE

DRAWN BY	DESIGNED BY	CHECKED BY	SHEET NO.
JOB NUMBER	DATE	SCALE: HOR: 1"=40' VER: 1"=4'	5 OF 19
16021	SEPTEMBER 2016		



AS-BUILT DECEMBER 2017
 INFORMATION PROVIDED
 BY CONTRACTORS
 (NOT FIELD VERIFIED)

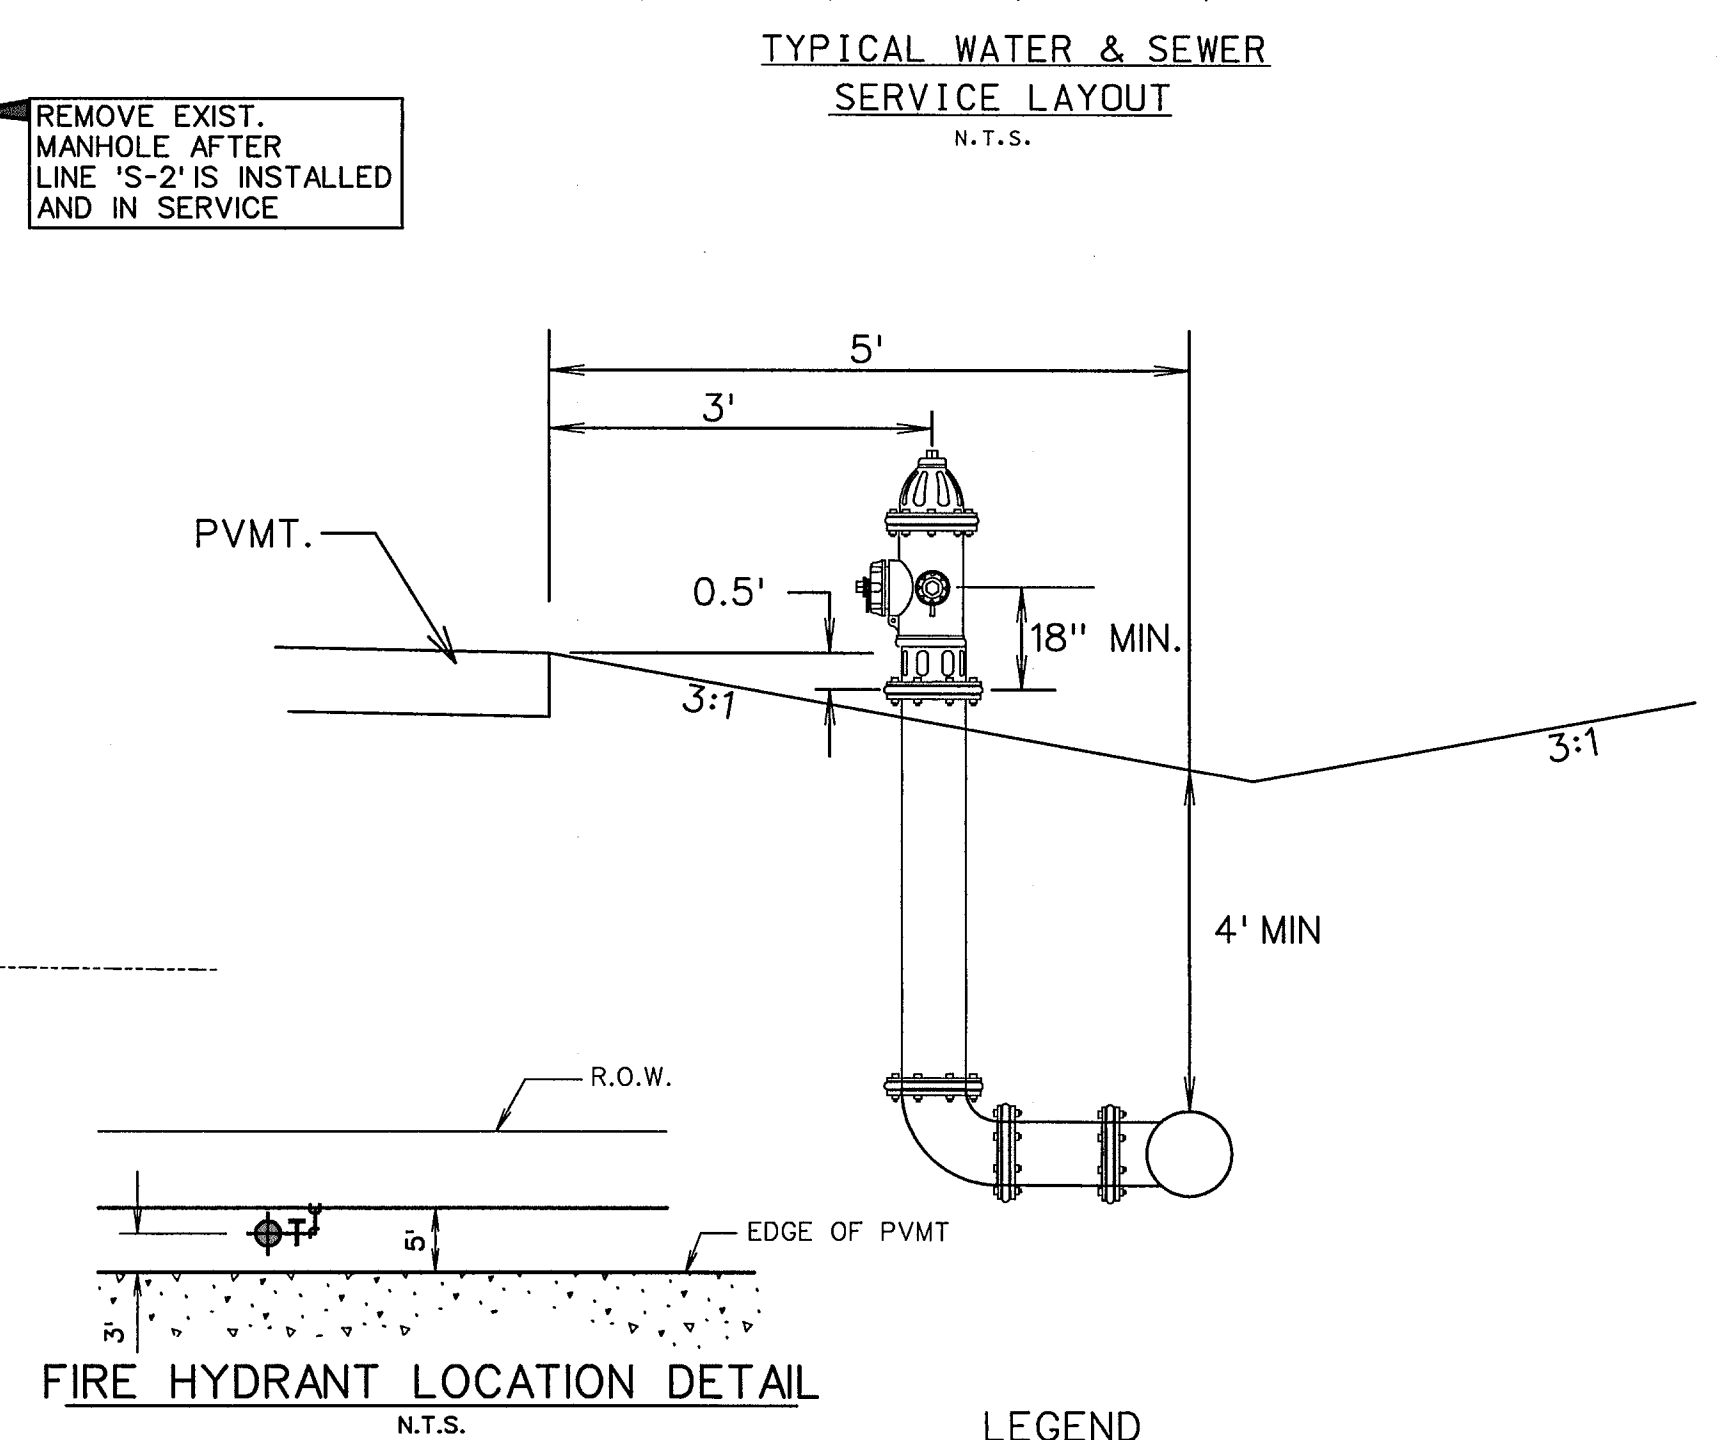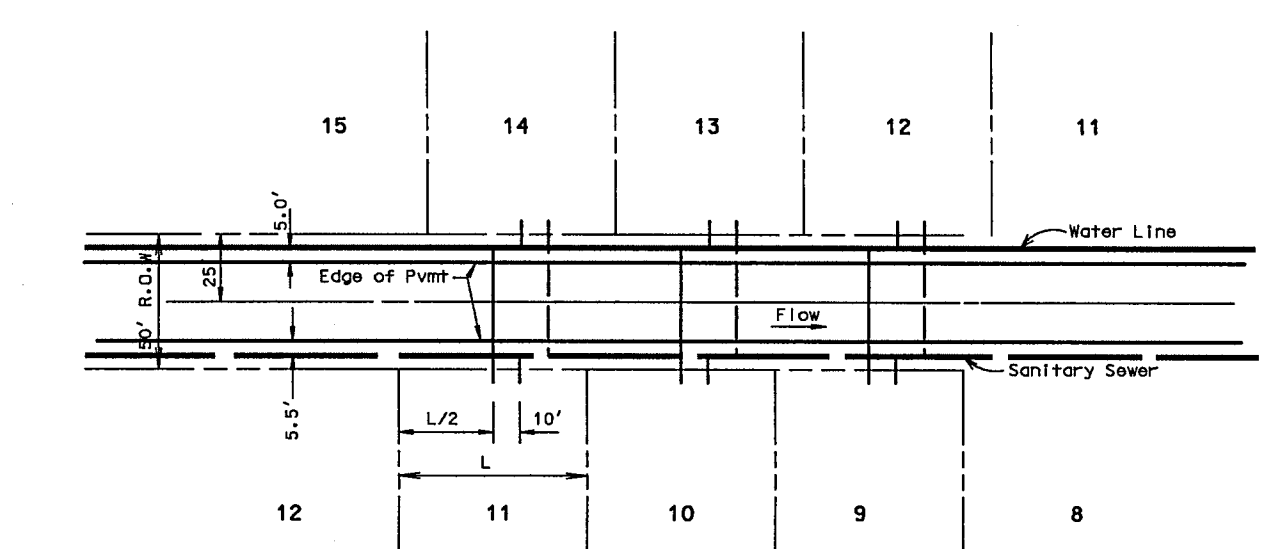

LEGEND

- PROP. WATER LINE
- PROP. FIRE HYDRANT AND VALVE
- PROP. GATE VALVE
- PROP. FLUSH VALVE
- EXIST. WATER LINE
- EXIST. FIRE HYDRANT AND VALVE
- PROP. SANITARY SEWER
- PROP. MANHOLE
- PROP. CLEANOUT
- EXIST. SANITARY SEWER
- EXIST. MANHOLE
- PROP. STORM SEWER
- PROP. CURB INLETS
- PROP. CONC. HEADWALL

NOTE:

ALL WATER LINES TO BE CLASS 200 PIPE DR-14 C-900.


ALL SANITARY SEWER PIPE TO BE SDR 35 FOR 5'-10" DEEP AND SDR 26 FOR 10' AND GREATER.

INSTALL BLUE "EMS" DISK ON WATER LINE AT EVERY 250' AND CHANGE IN DIRECTION, VALVE, AND SERVICE.

INSTALL GREEN "EMS" DISK ON SANITARY SEWER LINE EVERY 250' AND AT EVERY CHANGE IN DIRECTION, MANHOLE, CLEANOUT, AND SERVICE.

ALL MANHOLES TO BE RAVEN EPOXY LINED AND SEALED OR APPROVED EQUAL TO BE SPARK AND PRESSURE TESTED.

1	ADDED 3- 1" IRRIGATION SERVICES	1-3-17
NO.	REVISIONS	DATE
<p>CORWIN ENGINEERING, INC. 200 W. BELMONT, SUITE E ALLEN, TEXAS 75013 (972)396-1200 TBPE FIRM #5951</p>		
<p>DEVELOPMENT PLANS FOR</p> <p>RIDGECREST</p> <p>ROCKWALL, TEXAS</p>		
<p>WATER AND SANITARY SEWER PLAN</p>		
DRAWN BY	DESIGNED BY	CHECKED BY
JOB NUMBER	DATE	SCALE:
16021	SEPTEMBER 2016	1"=60'
		SHEET NO.
		7 OF 19

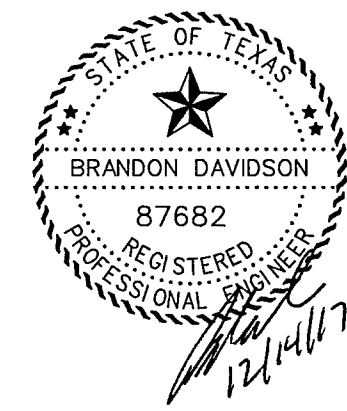


AS-BUILT DECEMBER 2017
INFORMATION PROVIDED BY CONTRACTORS (NOT FIELD VERIFIED)


CURVE TABLE

CURVE NO.	DELTA	RADIUS	LENGTH	TANGENT
1.	25°37'24"	314.50'	140.65'	71.52'
2.	46°11'36"	285.50'	230.18'	121.76'
3.	05°22'20"	204.50'	19.72'	9.59'
4.	19°56'54"	250.00'	87.04'	43.97'
5.	13°49'11"	250.00'	60.30'	30.30'

SERVICE SCHEDULE

TYPE	SIZE	NO.
SANITARY	4"	46
WATER	1"	46
IRRIGATION	1"	3

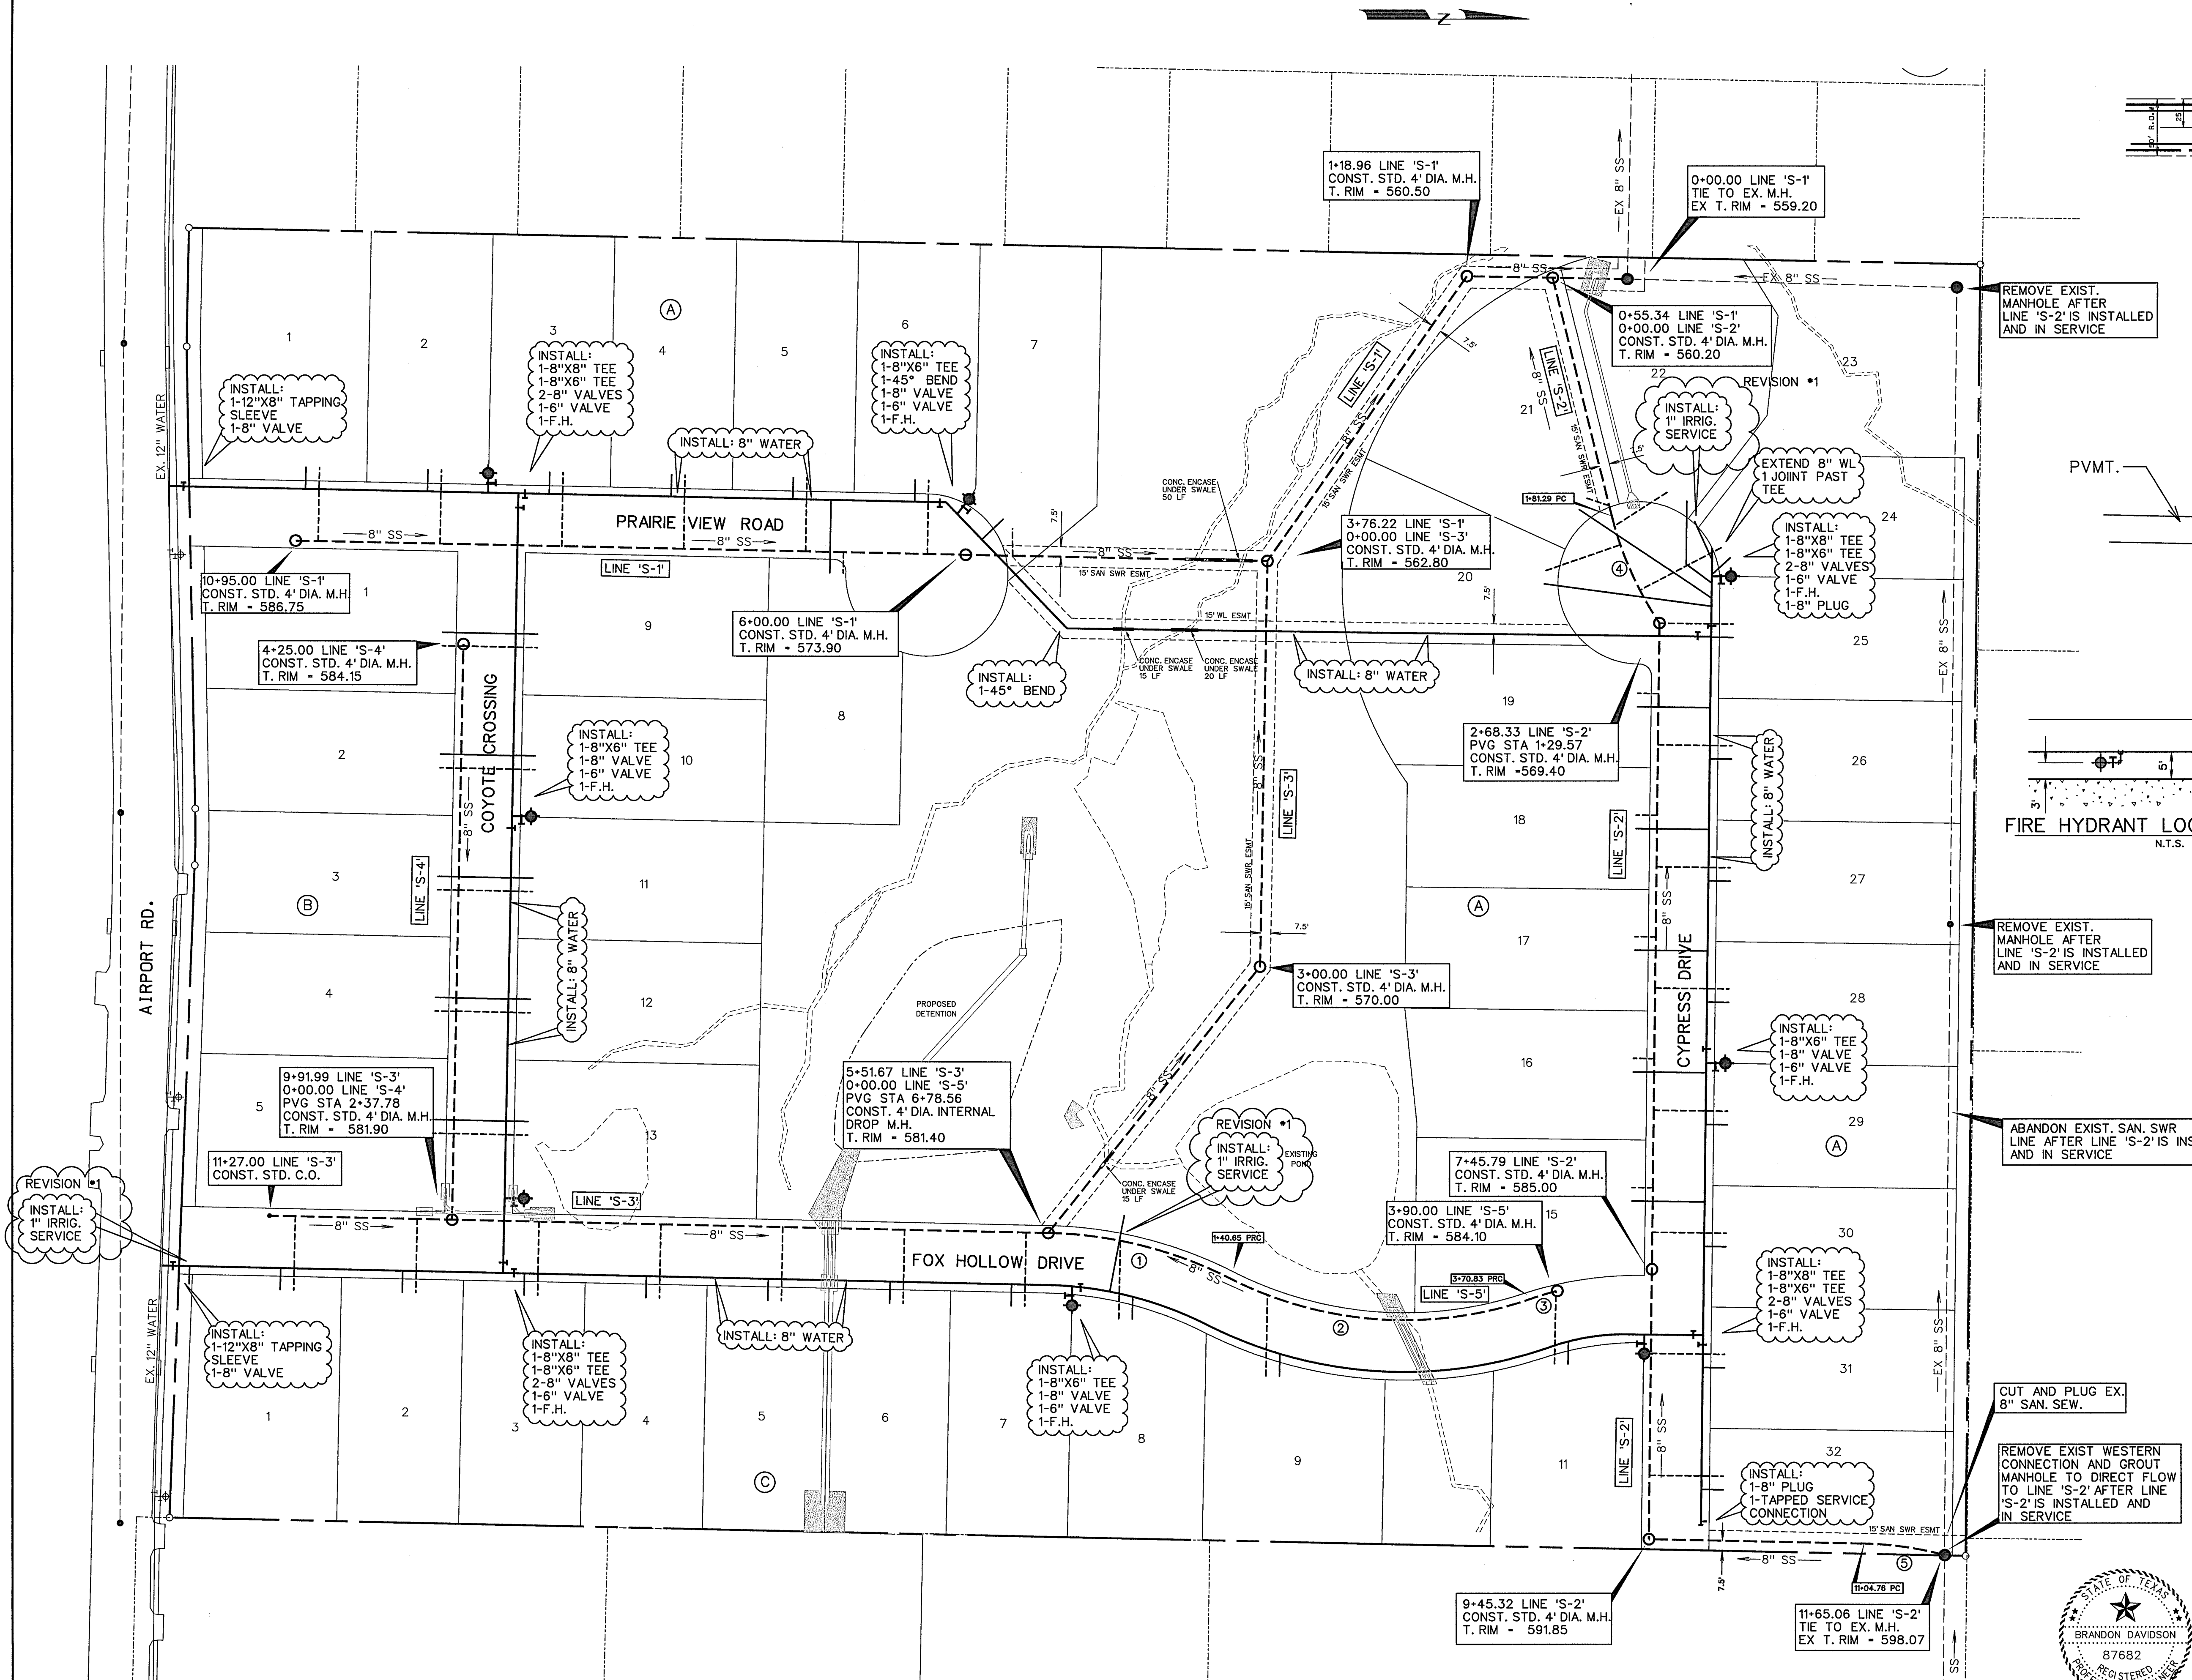

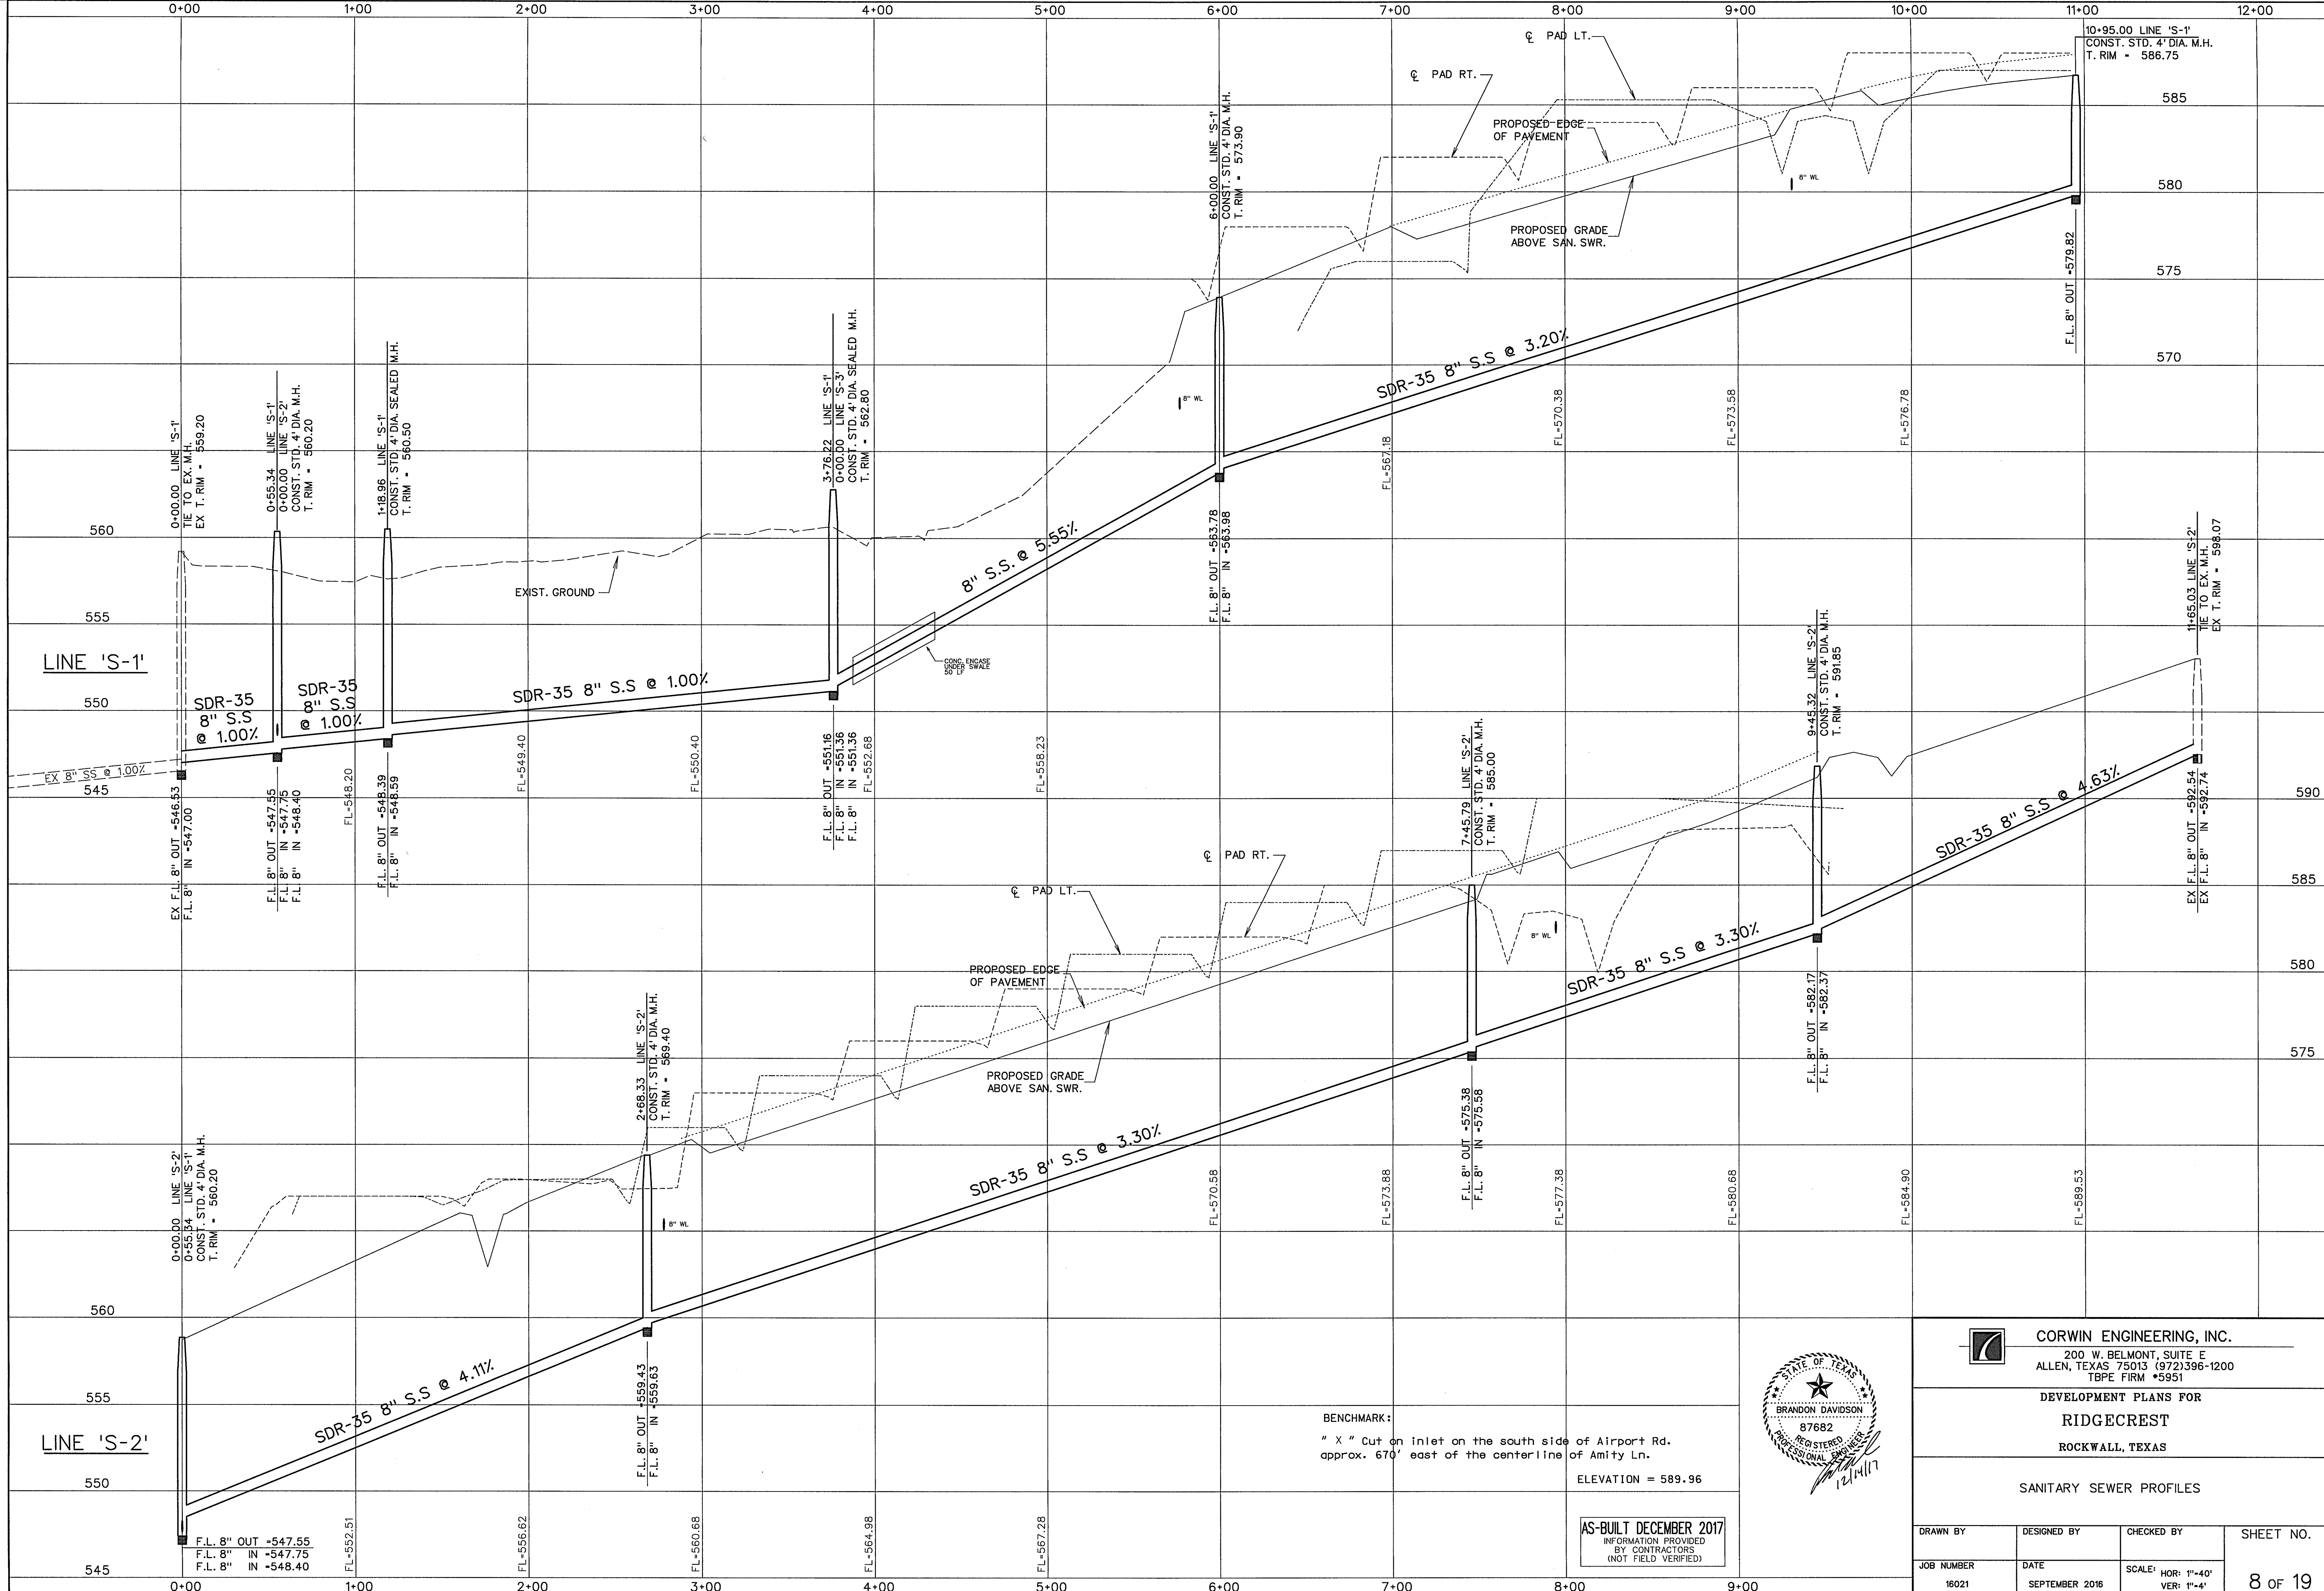

BENCHMARK:
 " X " Cut on Inlet on the south side of Airport Rd.
 approx. 670' east of the centerline of Amity Ln.
 ELEVATION = 589.96

AS-BUILT DECEMBER 2017
 INFORMATION PROVIDED
 BY CONTRACTORS
 (NOT FIELD VERIFIED)




CORWIN ENGINEERING, INC.
 200 W. BELMONT, SUITE E
 ALLEN, TEXAS 75013 (972)396-1200
 TBPE FIRM #5951

DEVELOPMENT PLANS FOR
RIDGECREST
 ROCKWALL, TEXAS

SANITARY SEWER PROFILES

DRAWN BY	DESIGNED BY	CHECKED BY	SHEET NO.
16021	SEPTEMBER 2016	SCALE: HOR: 1"=40' VER: 1"=4'	8 OF 19

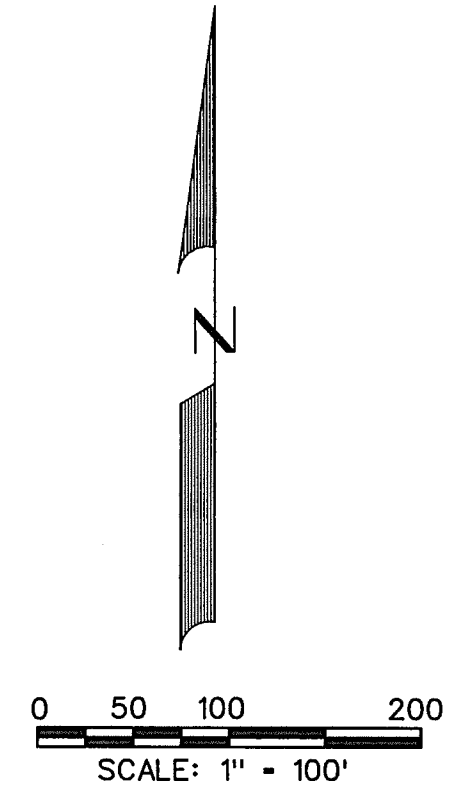

RUNOFF COMPUTATIONS

Area #	Area (sf)	Area (acres)	Runoff Coefficient	CA	Tc (min)	I (100) (in/hr)	Q(100) (cfs)
EX	1260892	28.9	0.35	10.13	20	8.30	84.1
OS1	409276	9.40	0.50	4.70	10	9.80	46.0
OS2	479004	11.0	0.35	3.65	20	8.30	31.9
OS3	641464	14.7	0.35	5.15	20	8.30	42.8


- LEGEND**
- PROP. STORM SEWER
 - PROP. CURB INLETS
 - PROP. CONC. HEADWALL
 - EXIST. STORM SEWER
 - DRAINAGE AREA DIVIDE
 - FLOW ARROW
 - DRAINAGE AREA NO.

CORWIN ENGINEERING, INC.
 200 W. BELMONT, SUITE E
 ALLEN, TEXAS 75013 (972)396-1200
 TBPE FIRM #5951


DEVELOPMENT PLANS FOR
RIDGECREST
 ROCKWALL, TEXAS


EXISTING CONDITIONS DRAINAGE AREA MAP

DRAWN BY	DESIGNED BY	CHECKED BY	SHEET NO.
JOB NUMBER	DATE	SCALE:	10 OF 19
16021	SEPTEMBER 2016	1"=100'	

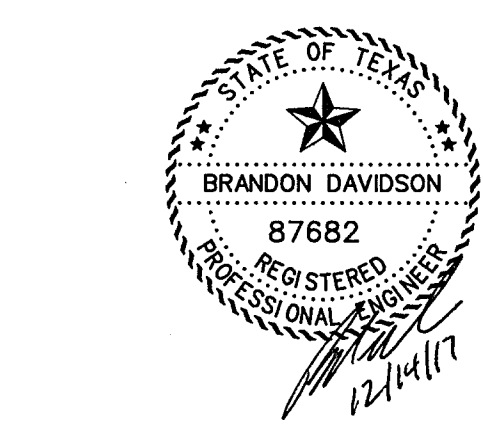

AS-BUILT DECEMBER 2017
 INFORMATION PROVIDED
 BY CONTRACTORS
 (NOT FIELD VERIFIED)

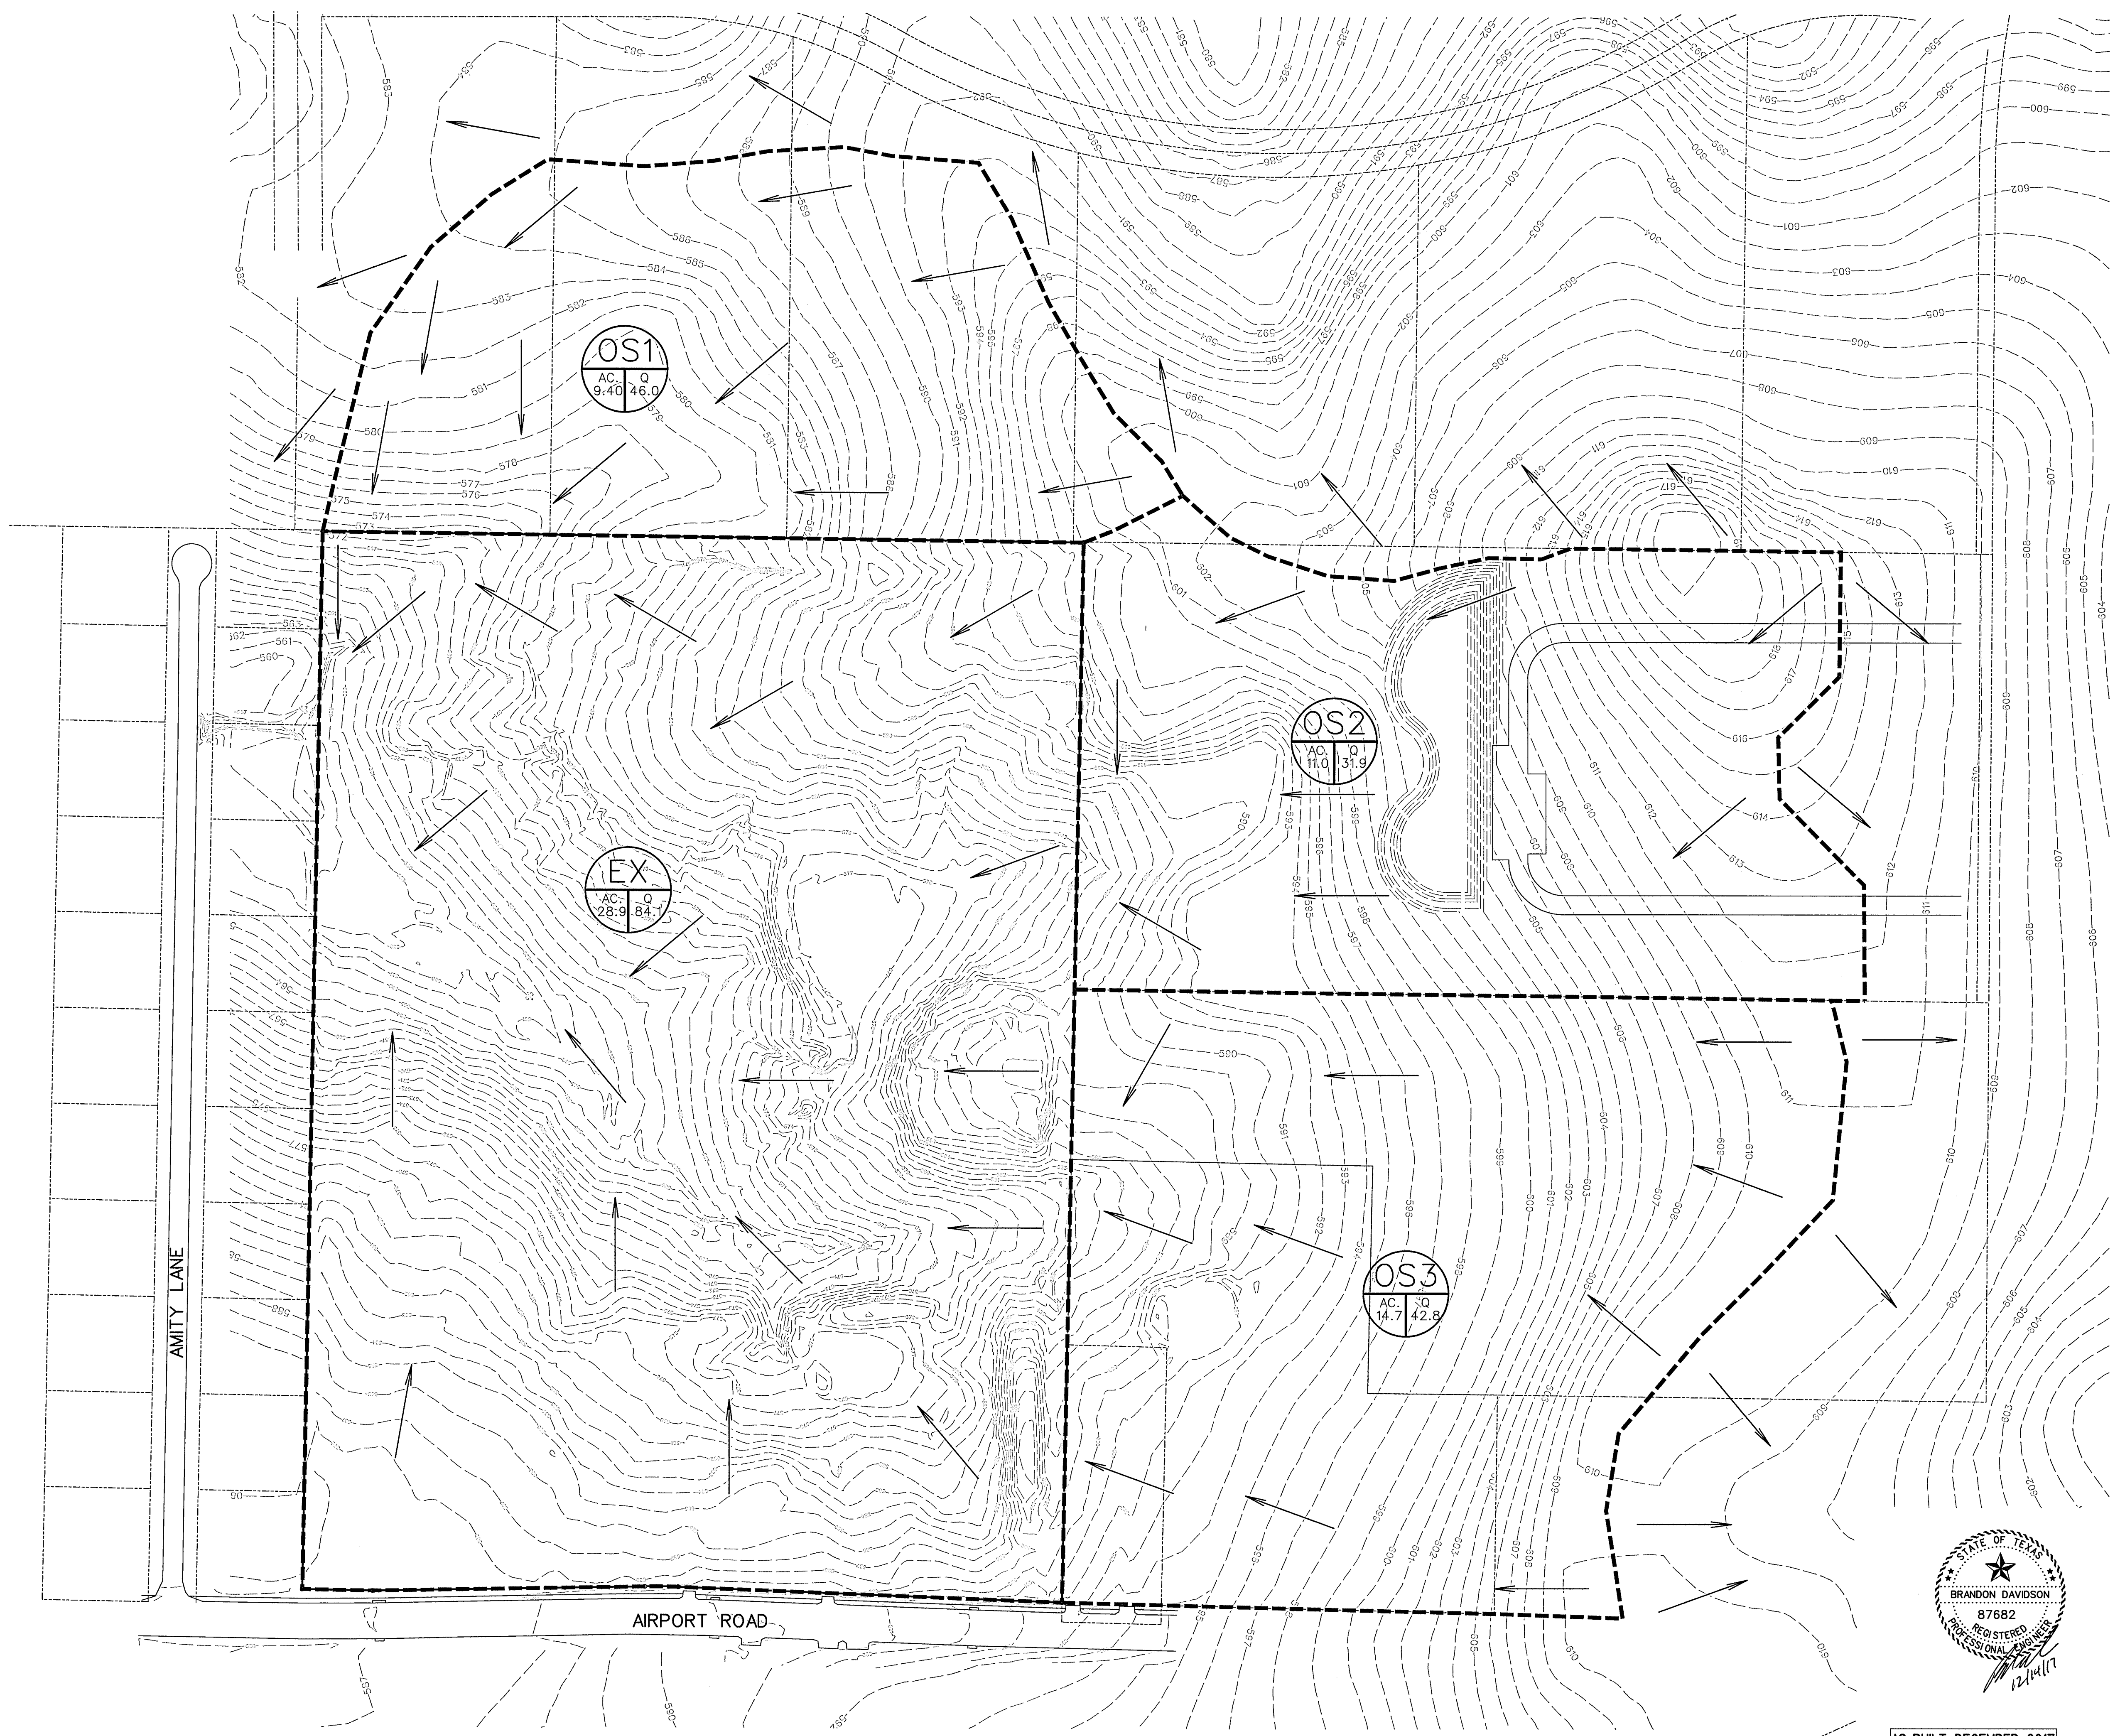

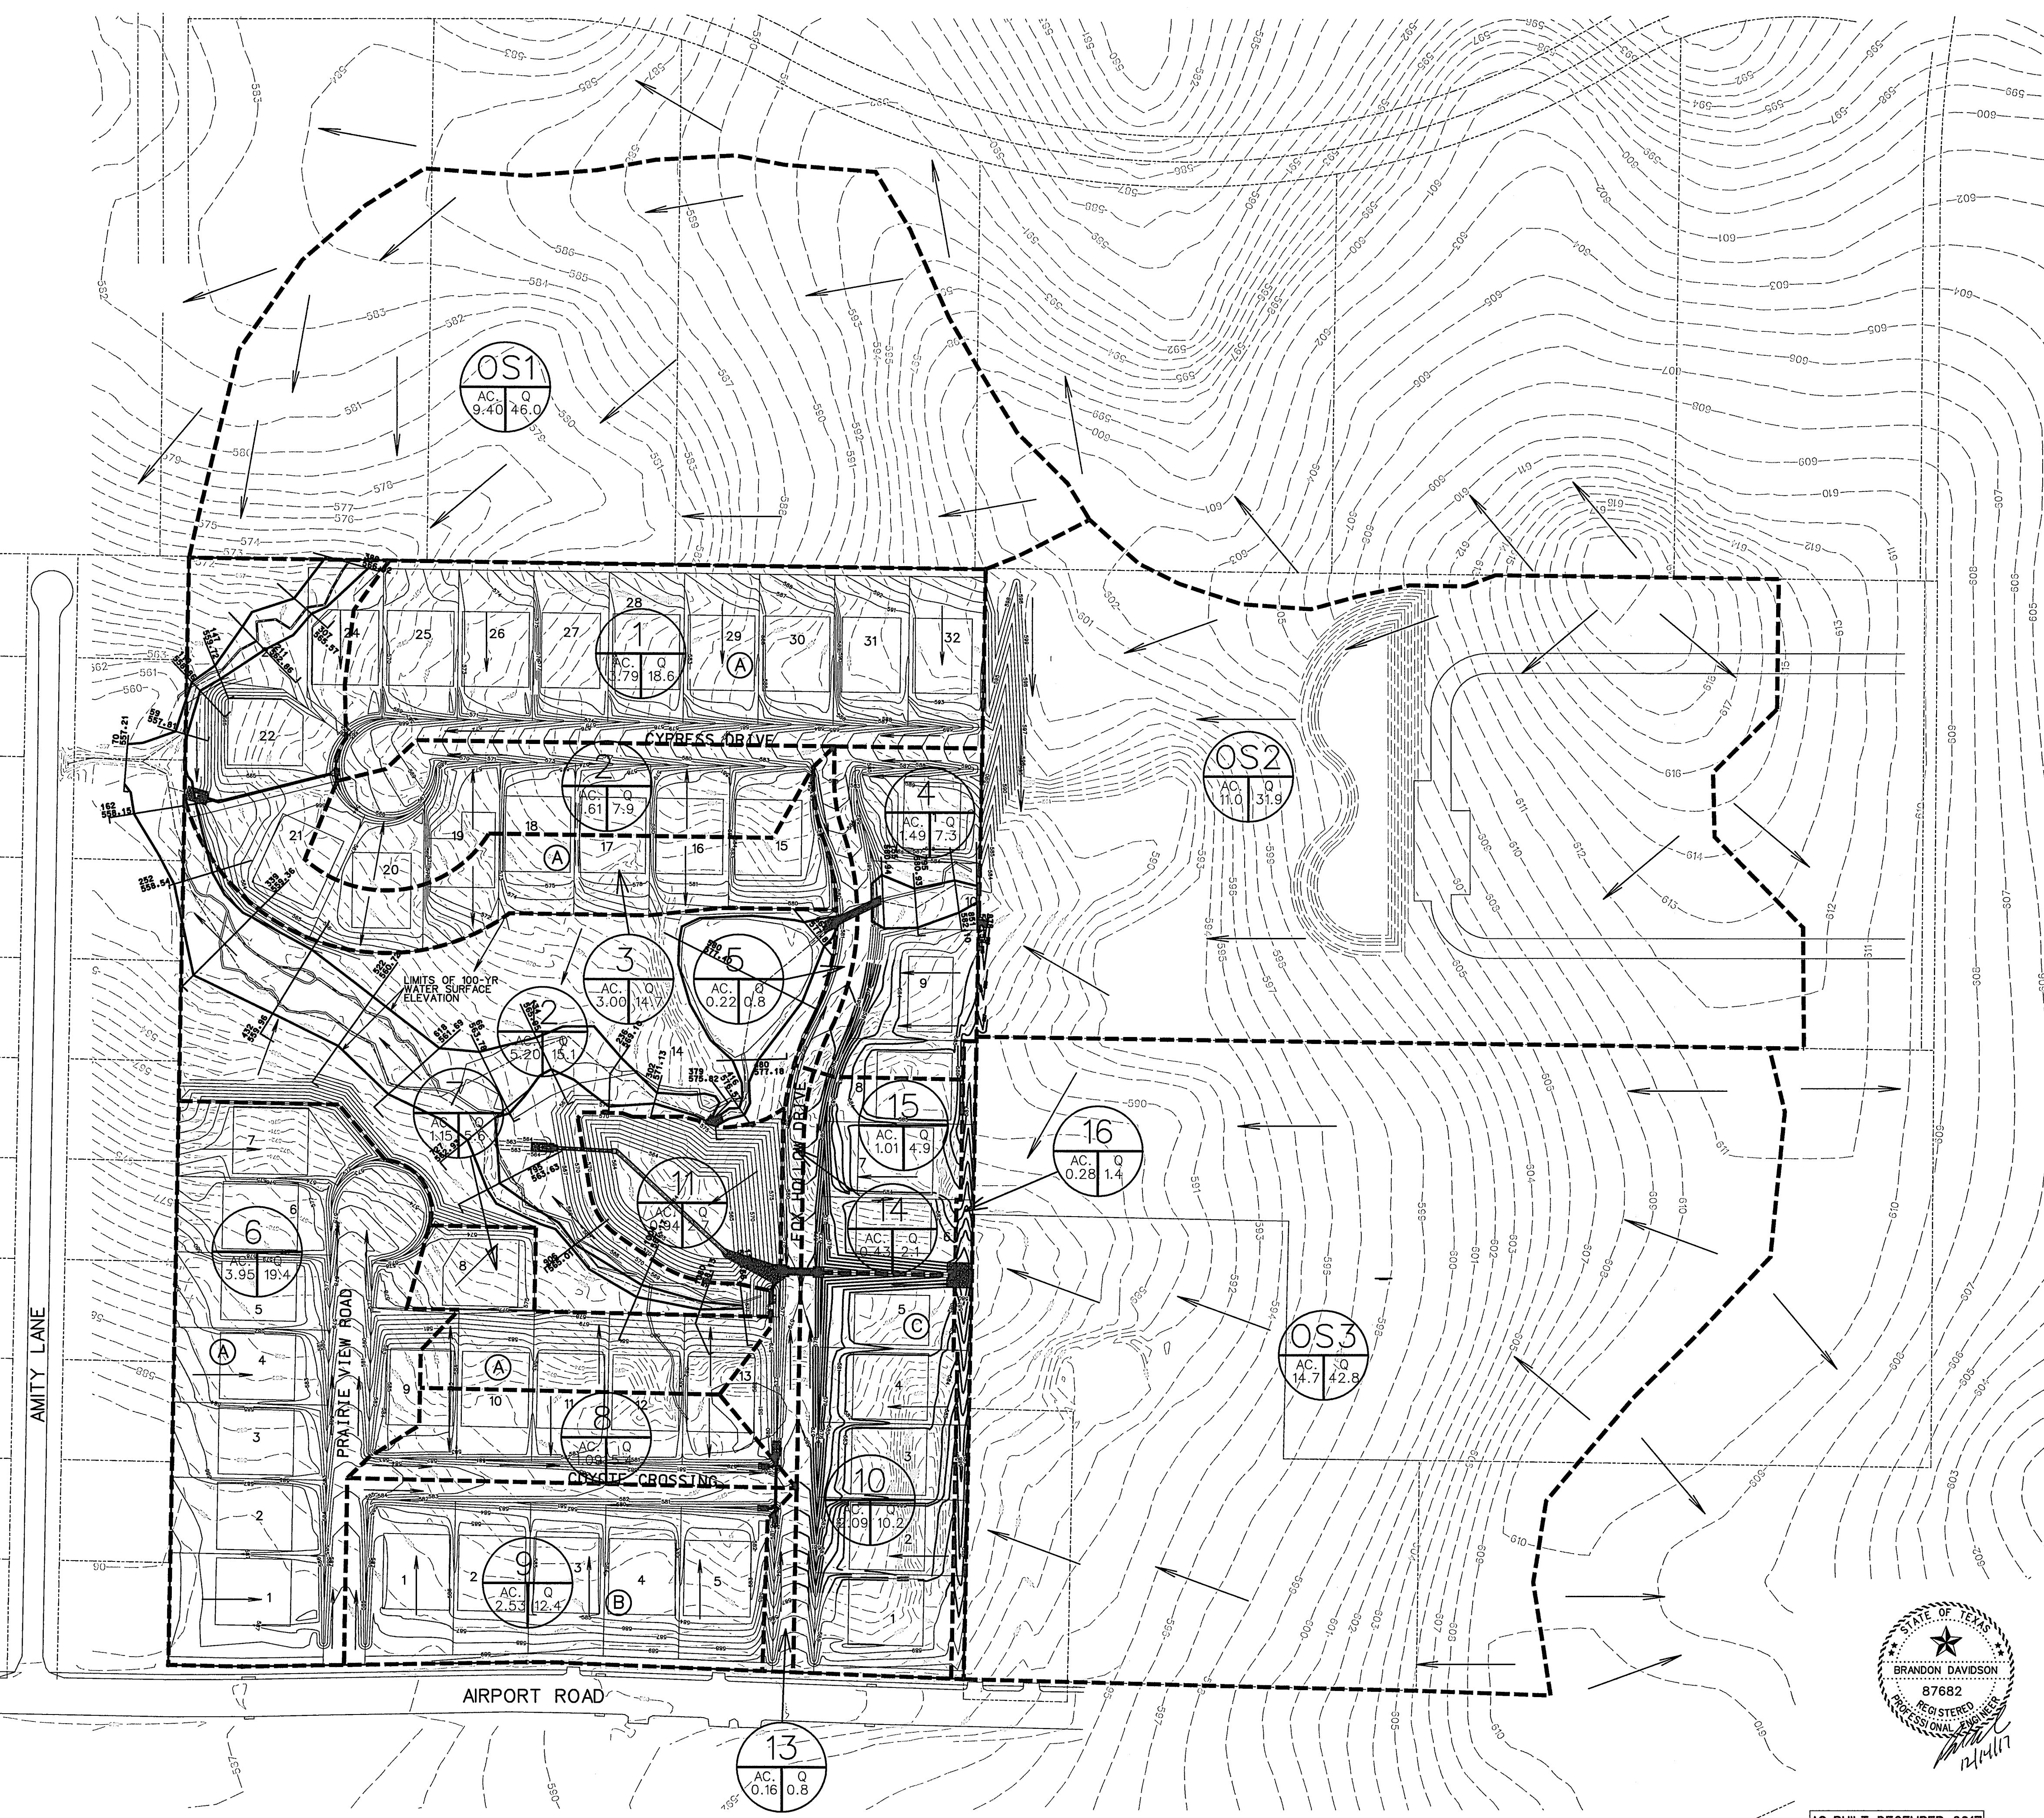

RUNOFF COMPUTATIONS

Area #	Area (sq)	Area (acres)	Runoff Coefficient	CA	Tc (min)	Q(100) (m/hr)	Q(100) (cfs)
1	165276	3.79	0.50	1.90	10	9.80	18.8
2	70096	1.61	0.50	0.80	10	9.80	7.9
3	130744	3.00	0.50	1.50	10	9.80	14.7
4	64955	1.49	0.50	0.75	10	9.80	7.3
5	9612	0.22	0.35	0.68	20	9.80	0.8
6	172090	3.95	0.50	1.98	10	9.80	19.4
7	50138	1.15	0.50	0.58	10	9.80	5.6
8	47649	1.09	0.50	0.55	10	9.80	5.4
9	110082	2.53	0.50	1.26	10	9.80	12.4
10	91009	2.09	0.50	1.04	10	9.80	10.2
11	40952	0.94	0.35	0.33	20	8.30	2.7
12	226943	5.20	0.35	1.82	20	8.30	15.1
13	7076	0.16	0.50	0.68	10	9.80	0.8
14	16913	0.43	0.50	0.22	10	9.80	2.1
15	43821	1.01	0.50	0.50	10	9.80	4.9
16	12348	0.28	0.50	0.14	10	9.80	1.4
OS1	469276	9.40	0.50	4.70	10	9.80	46.0
OS2	475004	11.0	0.35	3.65	20	8.30	31.9
OS3	641484	14.7	0.35	5.15	20	8.30	42.8

- LEGEND**
- PROP. STORM SEWER
 - PROP. CURB INLETS
 - PROP. CONC. HEADWALL
 - EXIST. STORM SEWER
 - DRAINAGE AREA DIVIDE
 - FLOW ARROW
 - DRAINAGE AREA NO.





AS-BUILT DECEMBER 2017
 INFORMATION PROVIDED
 BY CONTRACTORS
 (NOT FIELD VERIFIED)

CORWIN ENGINEERING, INC.
 200 W. BELMONT, SUITE E
 ALLEN, TEXAS 75013 (972)396-1200
 TBPE FIRM #5951

DEVELOPMENT PLANS FOR
RIDGECREST
 ROCKWALL, TEXAS

DRAINAGE AREA MAP

DRAWN BY	DESIGNED BY	CHECKED BY	SHEET NO.
JOB NUMBER	DATE	SCALE:	11 OF 19
16021	SEPTEMBER 2016	1"=100'	

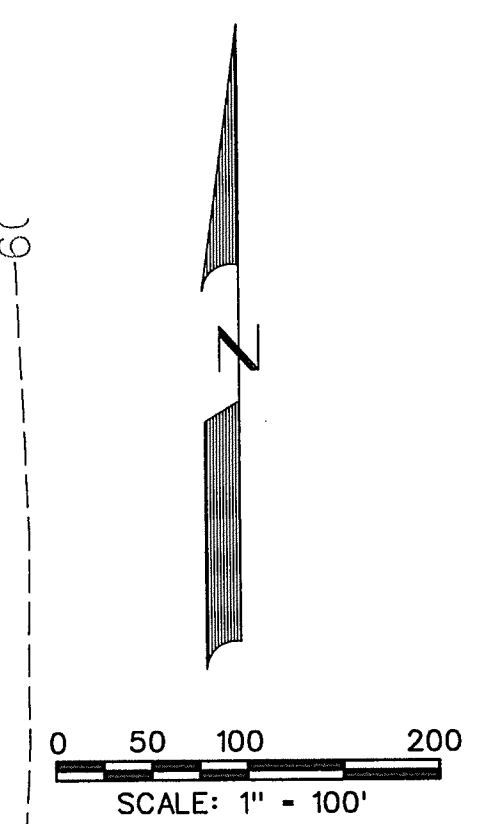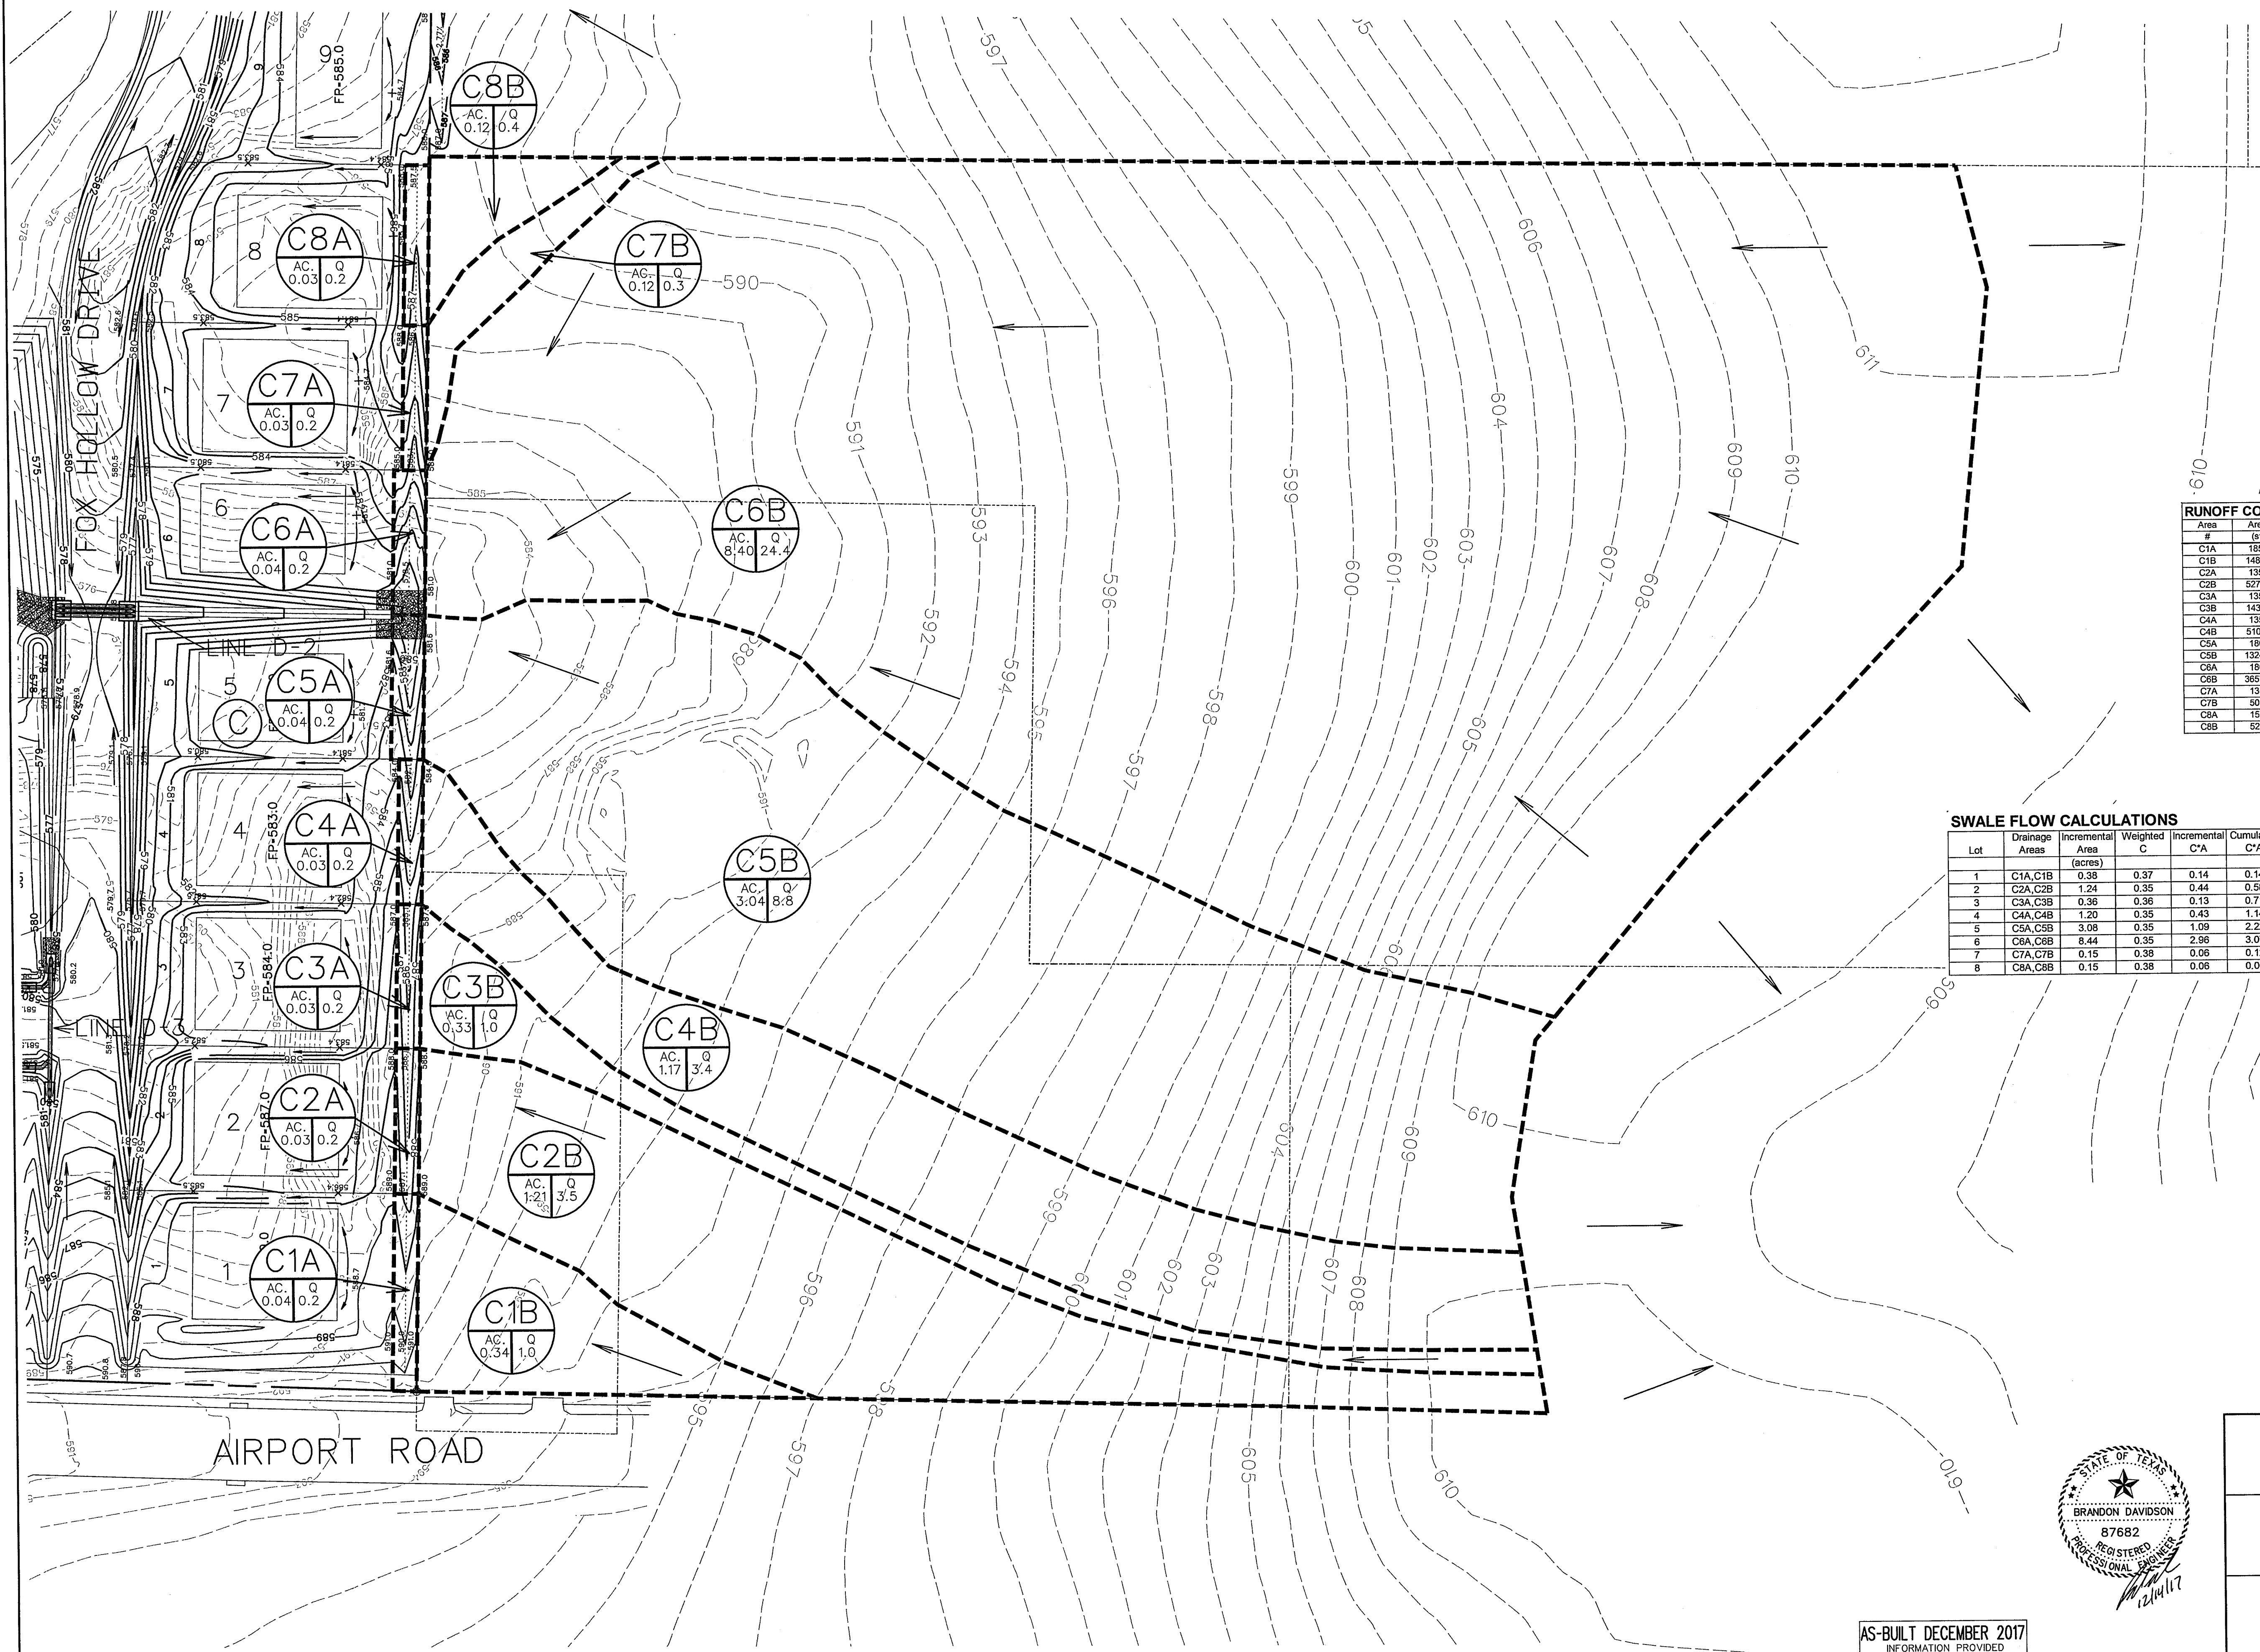


FM 3549

RUNOFF COMPUTATIONS

Area #	Area (sf)	Area (acres)	Runoff Coefficient	CA	Tc (min)	I(100) (in/hr)	Q(100) (cfs)	Weighted C
C1A	1850	0.04	0.50	0.02	10	9.80	0.2	
C1B	14881	0.34	0.35	0.12	20	8.30	1.0	0.37
C2A	1350	0.03	0.50	0.02	10	9.80	0.2	
C2B	52707	1.21	0.35	0.42	20	8.30	3.5	0.35
C3A	1350	0.03	0.50	0.02	10	9.80	0.2	
C3B	14355	0.33	0.35	0.12	20	8.30	1.0	0.36
C4A	1350	0.03	0.50	0.02	10	9.80	0.2	
C4B	51042	1.17	0.35	0.41	20	8.30	3.4	0.35
C5A	1800	0.04	0.50	0.02	10	9.80	0.2	
C5B	132485	3.04	0.35	1.06	20	8.30	8.8	0.35
C6A	1800	0.04	0.50	0.02	10	9.80	0.2	
C6B	365700	8.40	0.35	2.94	20	8.30	24.4	0.35
C7A	1350	0.03	0.50	0.02	10	9.80	0.2	
C7B	5051	0.12	0.35	0.04	20	8.30	0.3	0.38
C8A	1500	0.03	0.50	0.02	10	9.80	0.2	
C8B	5237	0.12	0.35	0.04	10	9.80	0.4	0.38

SWALE FLOW CALCULATIONS

Lot	Drainage Areas	Incremental Area (acres)	Weighted C	Incremental C'A	Cumulative C'A	Tc* (min)	I(100) (in/hr)	Q(100) (cfs)	Swale Slope (ft/R)	Manning's "n" value	Flow Depth (ft)	Flow Velocity (ft/s)
1	C1A,C1B	0.38	0.37	0.14	0.14	20	8.3	1.2	2.17%	0.036	0.39	2.0
2	C2A,C2B	1.24	0.35	0.44	0.58	20	8.3	4.8	1.11%	0.036	0.74	2.2
3	C3A,C3B	0.36	0.36	0.13	0.71	20	8.3	5.9	1.11%	0.036	0.80	2.3
4	C4A,C4B	1.20	0.35	0.43	1.14	20	8.3	9.4	3.33%	0.036	0.77	3.9
5	C5A,C5B	3.08	0.35	1.09	2.22	20	8.3	18.4	3.33%	0.036	1.00	4.6
6	C6A,C6B	8.44	0.35	2.96	3.07	20	8.3	25.5	5.11%	0.036	1.04	5.9
7	C7A,C7B	0.15	0.38	0.06	0.12	20	8.3	1.0	3.33%	0.036	0.34	2.2
8	C8A,C8B	0.15	0.38	0.06	0.06	20	8.3	0.5	1.40%	0.036	0.30	1.4

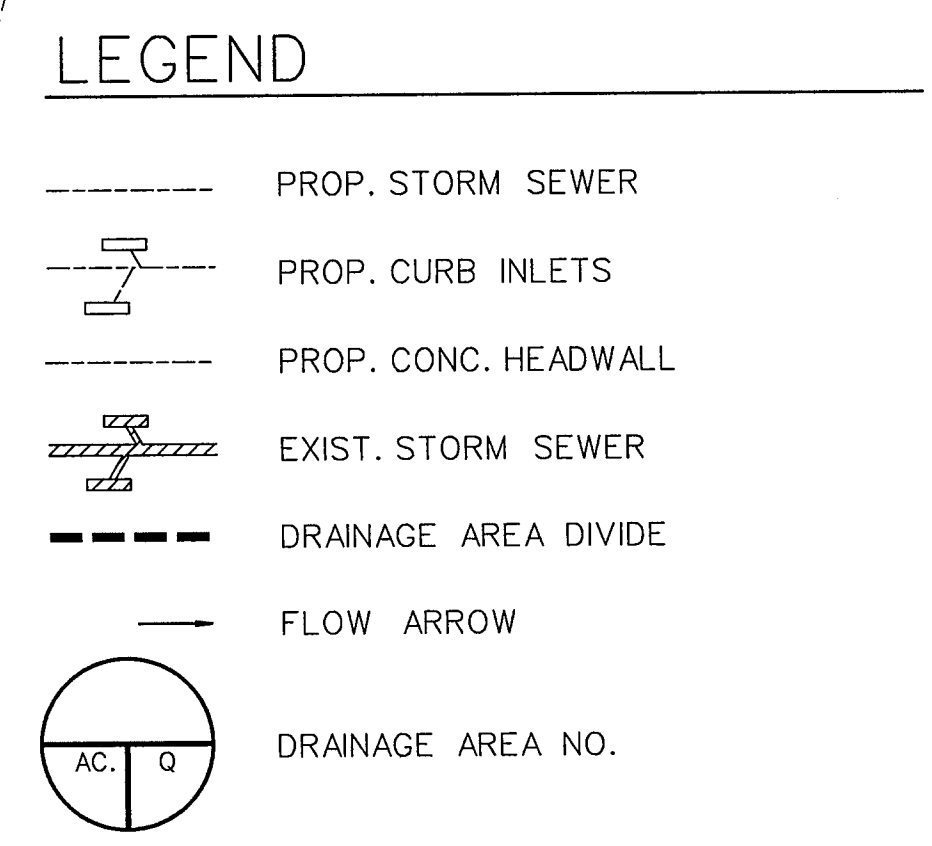

AIRPORT ROAD

AS-BUILT DECEMBER 2017
 INFORMATION PROVIDED
 BY CONTRACTORS
 (NOT FIELD VERIFIED)



CORWIN ENGINEERING, INC.
 200 W. BELMONT, SUITE E
 ALLEN, TEXAS 75013 (972) 396-1200
 TBPE FIRM #5951

DEVELOPMENT PLANS FOR
RIDGECREST
 ROCKWALL, TEXAS

DRAINAGE AREA MAP
 BLOCK C



DRAWN BY	DESIGNED BY	CHECKED BY	SHEET NO.
JOB NUMBER	DATE	SCALE:	12 OF 19
16021	SEPTEMBER 2016	1"=100'	

DRIVEWAY CULVERT CALCULATIONS

Block	Lot	OUTLET CONTROL										INLET CONTROL														
		Receives Drainage	Drainage Area (sf)	Flow (cfs)	Ditch Slope	Ditch Capacity (cfs)	Pipe Size (in)	No. of Barrels	Area (sf)	Full Flow Velocity (fps)	Head (ft)	Hydraulic Slope (ft/ft)	Outlet Flowline (ft)	Ditch Depth (ft)	Starting Tailwater (ft)	Length @ Flowline (ft)	Headwater Elevation (ft)	Headwater Depth (ft)	Upstream Soffit Elev. (ft)	Headwater Required (ft)	Inlet Flowline (ft)	Headwater Elevation (ft)	Headwater Depth (ft)	Inlet or Outlet Control?	U/S Elev. (ft)	U/S vs. Soffit (ft)
A	1	1	27981	3.1	0.92%	232	18	1	1.7671	1.8	0.05	0.0009	0.00	0.73	1.50	36	1.56	1.23	1.83	0.14	0.33	1.22	0.89	Outlet Control	1.56	-0.27
A	2	1-2	46881	5.3	0.92%	102	18	1	1.7671	3.0	0.14	0.0025	0.00	0.89	1.50	36	1.66	1.33	1.83	0.38	0.33	1.47	1.13	Outlet Control	1.66	-0.17
A	3	1-3	65781	7.4	2.90%	463	18	1	1.7671	4.2	0.27	0.0050	0.00	0.82	1.50	36	1.81	0.77	2.54	0.76	1.04	2.55	1.51	Inlet Control	2.55	0.01
A	4	1-4	84681	9.5	2.90%	316	21	1	2.4053	4.0	0.24	0.0036	0.00	0.90	1.75	38	2.01	0.91	2.85	0.68	1.10	2.65	1.55	Outlet Control	2.65	-0.20
A	5	1-5	103581	11.7	2.90%	316	21	1	2.4053	4.8	0.36	0.0054	0.00	0.97	1.75	38	2.14	1.04	2.85	1.01	1.10	2.99	1.89	Inlet Control	2.99	0.14
A	6	1-6	122568	13.8	2.90%	316	24	1	3.1416	4.4	0.30	0.0037	0.00	1.03	2.00	40	2.30	1.14	3.16	0.83	1.16	2.99	1.83	Outlet Control	2.99	-0.17
A	7	1-7	144251	16.2	2.90%	463	24	1	3.1416	5.2	0.41	0.0051	0.00	1.09	2.00	40	2.41	1.25	3.16	1.15	1.16	3.31	2.15	Inlet Control	3.31	0.15
A	8	8-9	24606	2.8	2.90%	463	18	1	1.7671	1.6	0.04	0.0007	0.00	0.57	1.50	36	1.54	0.50	2.54	0.11	1.04	1.90	0.86	Outlet Control	1.90	-0.64
A	9 (Both)	9	20644	3.0	1.65%	463	18	1	1.7671	1.7	0.04	0.0008	0.00	0.65	1.50	36	1.55	0.96	2.09	0.12	0.59	1.47	0.87	Outlet Control	1.55	-0.54
A	10	9-10	17842	2.0	0.70%	232	18	1	1.7671	1.1	0.02	0.0004	0.00	0.65	1.50	36	1.52	1.27	1.75	0.06	0.25	1.06	0.81	Outlet Control	1.52	-0.23
A	11	9-11	27743	3.1	0.70%	232	18	1	1.7671	1.8	0.05	0.0009	0.00	0.77	1.50	36	1.56	1.30	1.75	0.13	0.25	1.14	0.88	Outlet Control	1.56	-0.20
A	12	9-12	37645	4.2	0.70%	232	18	1	1.7671	2.4	0.09	0.0016	0.00	0.86	1.50	36	1.60	1.35	1.75	0.25	0.25	1.25	1.00	Outlet Control	1.60	-0.15
A	13 (Front)	9-13	47648	5.4	0.70%	232	18	1	1.7671	3.0	0.14	0.0026	0.00	0.95	1.50	36	1.67	1.41	1.75	0.40	0.25	1.40	1.15	Outlet Control	1.67	-0.09
A	13 (Side)	9-13, Block B	175779	19.8	0.70%	232	21	2	2.4053	4.1	0.26	0.0039	0.00	1.54	1.75	38	2.03	1.76	2.02	0.73	0.27	1.87	1.60	Outlet Control	2.03	0.01
A	14	N/A	Open Space																							
A	15 (Both)	15	12830	1.4	3.27%	232	18	1	1.7671	0.8	0.01	0.0002	0.00	0.43	1.50	36	1.51	0.33	2.68	0.03	1.18	1.96	0.78	Outlet Control	1.96	-0.72
A	16	15-16	19744	2.2	3.30%	232	18	1	1.7671	1.3	0.02	0.0004	0.00	0.50	1.50	36	1.53	0.34	2.69	0.07	1.19	2.01	0.82	Outlet Control	2.01	-0.68
A	17	15-17	29644	3.3	3.30%	232	18	1	1.7671	1.9	0.06	0.0010	0.00	0.59	1.50	36	1.56	0.38	2.69	0.15	1.19	2.09	0.90	Outlet Control	2.09	-0.60
A	18	15-18	39545	4.4	3.30%	232	18	1	1.7671	2.5	0.10	0.0018	0.00	0.66	1.50	36	1.61	0.43	2.69	0.27	1.19	2.21	1.02	Outlet Control	2.21	-0.48
A	19	15-19	52442	5.9	3.30%	232	18	1	1.7671	3.3	0.17	0.0032	0.00	0.73	1.50	36	1.70	0.51	2.69	0.48	1.19	2.42	1.23	Outlet Control	2.42	-0.27
A	20	15-20	64441	7.2	3.30%	232	18	1	1.7671	4.1	0.26	0.0048	0.00	0.79	1.50	36	1.80	0.61	2.69	0.73	1.19	2.66	1.48	Outlet Control	2.66	-0.02
A	21	15-21	70096	7.9	3.30%	232	18	1	1.7671	4.5	0.31	0.0056	0.00	0.82	1.50	36	1.86	0.67	2.69	0.86	1.19	2.80	1.61	Inlet Control	2.80	0.11
A	22	22-32	221705	24.9	3.30%	232	21	2	2.4053	5.2	0.42	0.0062	0.00	1.25	1.75	38	2.19	0.94	3.00	1.16	1.25	3.29	2.03	Inlet Control	3.29	0.28
A	23	N/A	Open Space																							
A	24	24-32	173576	19.5	3.30%	232	21	2	2.4053	4.1	0.26	0.0038	0.00	1.15	1.75	38	2.02	0.77	3.00	0.71	1.25	2.84	1.59	Outlet Control	2.84	-0.16
A	25	25-32	155728	17.5	3.30%	232	21	2	2.4053	3.6	0.21	0.0031	0.00	1.10	1.75	38	1.97	0.72	3.00	0.57	1.25	2.70	1.45	Outlet Control	2.70	-0.30
A	26	26-32	135549	15.2	3.30%	232	18	2	1.7671	4.3	0.29	0.0053	0.00	1.04	1.50	36	1.83	0.65	2.69	0.80	1.19	2.74	1.55	Inlet Control	2.74	0.05
A	27	27-32	116199	13.1	3.30%	232	18	2	1.7671	3.7	0.21	0.0039	0.00	0.98	1.50	36	1.75	0.56	2.69	0.59	1.19	2.53	1.34	Outlet Control	2.53	-0.16
A	28	28-32	98849	11.1	3.30%	232	21	1	2.4053	4.6	0.33	0.0049	0.00	0.93	1.75	38	2.10	0.85	3.00	0.92	1.25	3.05	1.80	Inlet Control	3.05	0.05
A	29	29-32	77498	8.7	3.30%	232	21	1	2.4053	3.6	0.20	0.0030	0.00	0.85	1.75	38	1.97	0.71	3.00	0.57	1.25	2.70	1.44	Outlet Control	2.70	-0.31
A	30	30-32	58148	6.5	3.30%	232	18	1	1.7671	3.7	0.21	0.0039	0.00	0.76	1.50	36	1.75	0.56	2.69	0.59	1.19	2.53	1.34	Outlet Control	2.53	-0.16
A	31	31-32	38798	4.4	3.30%	232	18	1	1.7671	2.5	0.09	0.0017	0.00	0.66	1.50	36	1.61	0.42	2.69	0.26	1.19	2.20	1.01	Outlet Control	2.20	-0.49
A	32	32	19448	2.2	3.30%	232	18	1	1.7671	1.2	0.02	0.0004	0.00	0.50	1.50	36	1.53	0.34	2.69	0.07	1.19	2.00	0.82	Outlet Control	2.00	-0.68
B	1 (Both)	1	28739	3.2	0.70%	232	18	1	1.7671	1.8	0.05	0.0009	0.00	0.78	1.50	36	1.56	1.31	1.75	0.14	0.25	1.15	0.89	Outlet Control	1.56	-0.19
B	2	1-2	48239	5.4	0.70%	232	18	1	1.7671	3.1	0.15	0.0027	0.00	0.95	1.50	36	1.67	1.42	1.75	0.41	0.25	1.41	1.16	Outlet Control	1.67	-0.08
B	3	1-3	67574	7.6	0.70%	232	18	1	1.7671	4.3	0.29	0.0052	0.00	1.07	1.50	36	1.83	1.58	1.75	0.80	0.25	1.80	1.55	Inlet Control	1.83	0.08
B	4	1-4	87046	9.8	0.70%	232	21	1	2.4053	4.1	0.26	0.0038	0.00	1.18	1.75	38	2.02	1.76	2.02	0.71	0.27	1.86	1.59	Outlet Control	2.02	0.01
B	5 (Front)	1-5	101644	11.4	0.70%	232	21	1	2.4053	4.8	0.35	0.0052	0.00	1.25	1.75	38	2.12	1.86	2.02	0.97	0.27	2.12	1.85	Inlet Control	2.12	0.11
B	5 (Side)	5	15495	1.7	5.41%	232	18	1	1.7671	1.0	0.02	0.0003	0.00	0.42	1.50	36	1.52	-0.43	3.45	0.04	1.95	2.74	0.79	Outlet Control	2.74	-0.71
C	1	1-C1-2B	52552	5.9	5.41%	232	18	1	1.7671	3.3	0.17	0.0032	0.00	0.67	1.50	36	1.70	-0.25	3.45	0.48	1.95	3.18	1.23	Outlet Control	3.18	-0.27
C	2	1-2, C1-3B	132168	14.9	3.00%	232	18	2	1.7671	4.2	0.27	0.0050	0.00	1.05	1.50	36	1.82	0.74	2.58	0.76	1.08	2.59	1.51	Inlet Control	2.59	0.01
C	3	1-3, C1-4B	156373	17.6	0.70%	232	21	2	2.4053	3.7	0.21	0.0031	0.00	1.47	1.75	38	1.97	1.70	2.02	0.58	0.27	1.72	1.45	Outlet Control	1.97	-0.05
C	4	1-4, C1-5B	236679	21.0	0.70%	232	24	2	3.1416	4.6	0.33	0.0049	0.00	1.77	2.00	40	2.28	2.00	2.28	0.79	0.28	2.07	1.79	Outlet Control	2.28	0.00
C	5	1-5, C1-5B	258131	29.0	0.70%	232	24	2	3.1416	4.6	0.33	0.0041	0.00	1.77	2.00	40	2.33	2.05	2.28	0.92	0.28	2.20	1.92	Outlet Control	2.33	0.05
C	6	6-8, C7-8B	125947	14.2	2.30%	232	18	2	1.7671	4.0	0.25	0.0045	0.00	1.09	1.50	36	1.79	0.96	2.33	0.69	0.83	2.27	1.44	Outlet Control	2.27	-0.06
C	7	7-8, CBB	28233	3.2	2.30%	232	18	1	1.7671	1.8	0.05	0.0009	0.00	0.62	1.50	36	1.56	0.73	2.33	0.14	0.83	1.72	0.89	Outlet Control	1.72	-0.61
C	8	8	10874	1.2	2.30%	232	18	1	1.7671	0.7	0.01	0.0001	0.00	0.43	1.50	36	1.51	0.68	2.33	0.02	0.83	1.60	0.77	Outlet Control	1.60	-0.73
C	9	8-9	29706	3.3	0.88%	232	18	1	1.7671	1.9	0.06	0.0010	0.00	0.75	1.50	36	1.56	1.25	1.82	0.15	0.32	1.22	0.90	Outlet Control	1.56	-0.25
C	10	N/A	Open Space																							
C	11	11 (Both)	23327	2.6	3.27%	232	18	1	1.7671	1.5	0.03	0.0006	0.00	0.54	1.50	36	1.54	0.36	2.68	0.10	1.18	2.02	0.85	Outlet Control	2.02	-0.65

Inlet Control vs. Outlet Control

Block	Lot	Outlet Control (ft)	Elevation Inlet Control (ft)	Governing Control	Headwater Elevation (ft)	Headwater Depth (ft)	U/S Elev. vs. Soffit (ft)
A	1	1.56	1.22	Outlet Control	1.56	1.23	-0.27
A	2	1.66	1.47	Outlet Control	1.66	1.33	-0.17
A	3	1.81	2.55	Inlet Control	2.55	1.51	0.01
A	4	2.01	2.65	Inlet Control	2.65	1.55	-0.20
A	5	2.14	2.99				

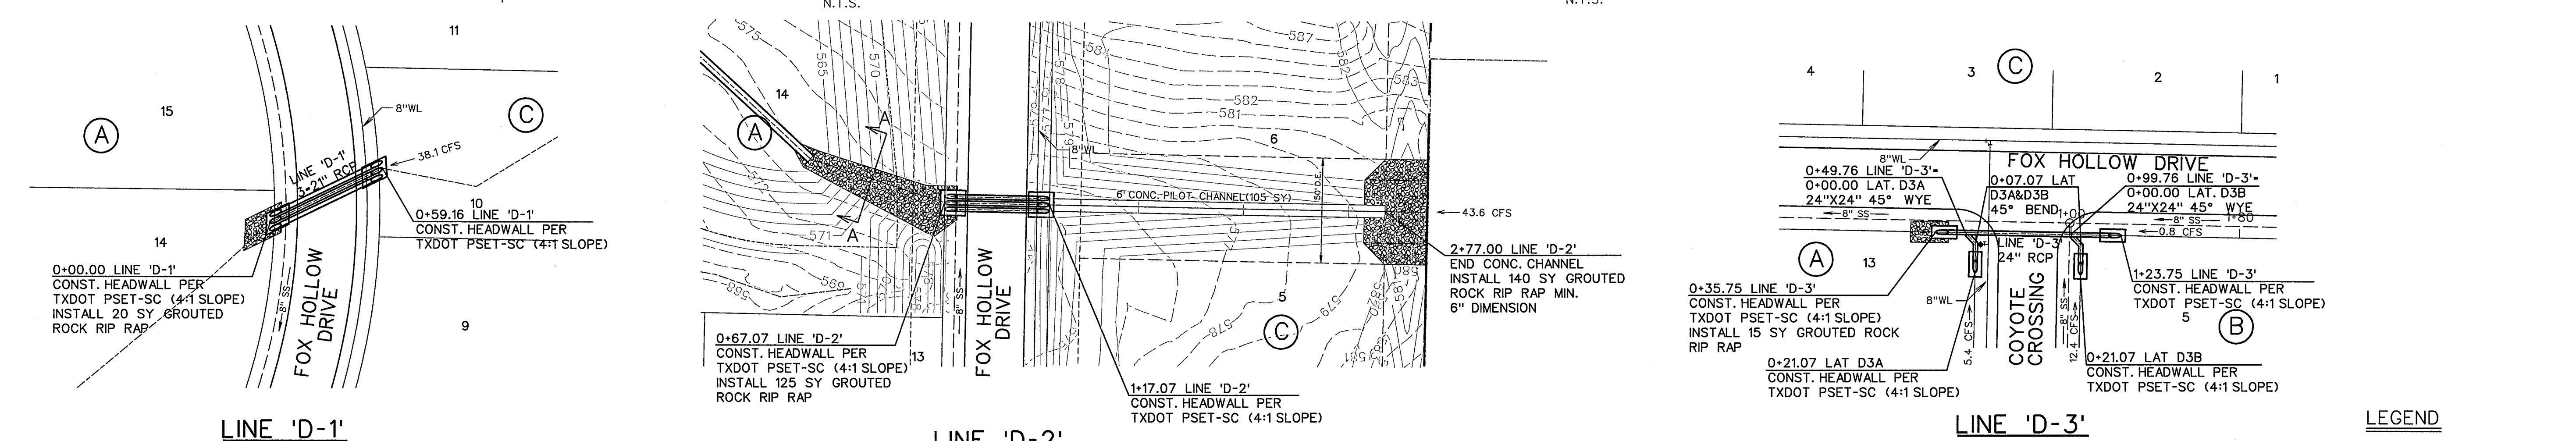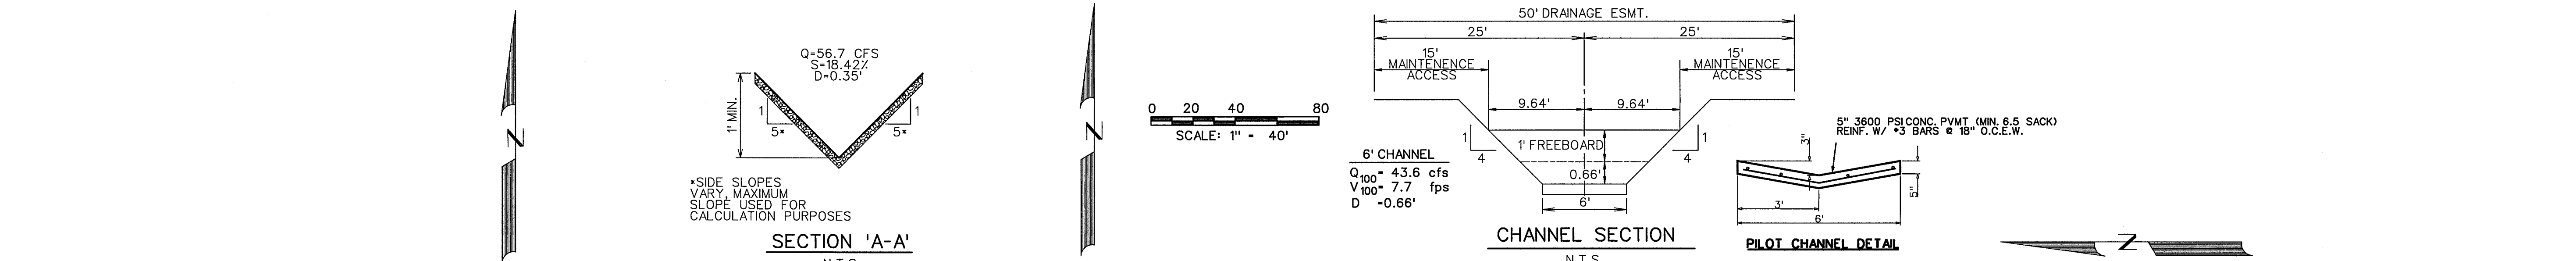


CULVERT CALCULATIONS





Line	AREA NO.	Total Area (Acres)	C	Tc (min)	I(100) (in/hr)	Flow (cfs)	Culvert Slope (%)	Pipe Size (in)	No. of Barrels	Area (sq ft)	Full Flow Velocity (fps)	Head (ft)	Hydraulic Slope (ft/ft)	OUTLET CONTROL		INLET CONTROL		Inlet or Outlet Control?	U/S Elev. (ft)	U/S vs. Pavement (ft)	Edge of Freeboard (ft)					
														Flowline (ft)	Tailwater (ft)	Flowline (ft)	Headwater (ft)									
Line D-1	4.082	12.5	0.37	20.0	8.3	38.1	0.50%	24	3	2,405.3	6.0	0.43	0.0064	577.70	579.45	59.16	580.05	578.75	1.20	578.00	580.08	Inlet Control	580.08	0.33	581.48	1.40
Line D-2	10.15, 16.083	18.1	0.38	20.0	8.3	56.8	0.50%	24	3	3,141.6	6.0	0.56	0.0070	574.90	576.90	50	577.53	577.15	1.57	575.15	577.72	Inlet Control	577.72	0.57	578.79	1.07

NOTE:

- No fences or structures allowed in any Drainage Easements.
- H.O.A. to maintain all Drainage Easements.


NOTE ALL STORM SEWER PIPE SHALL BE CLASS IV RCP UNLESS NOTED OTHERWISE.

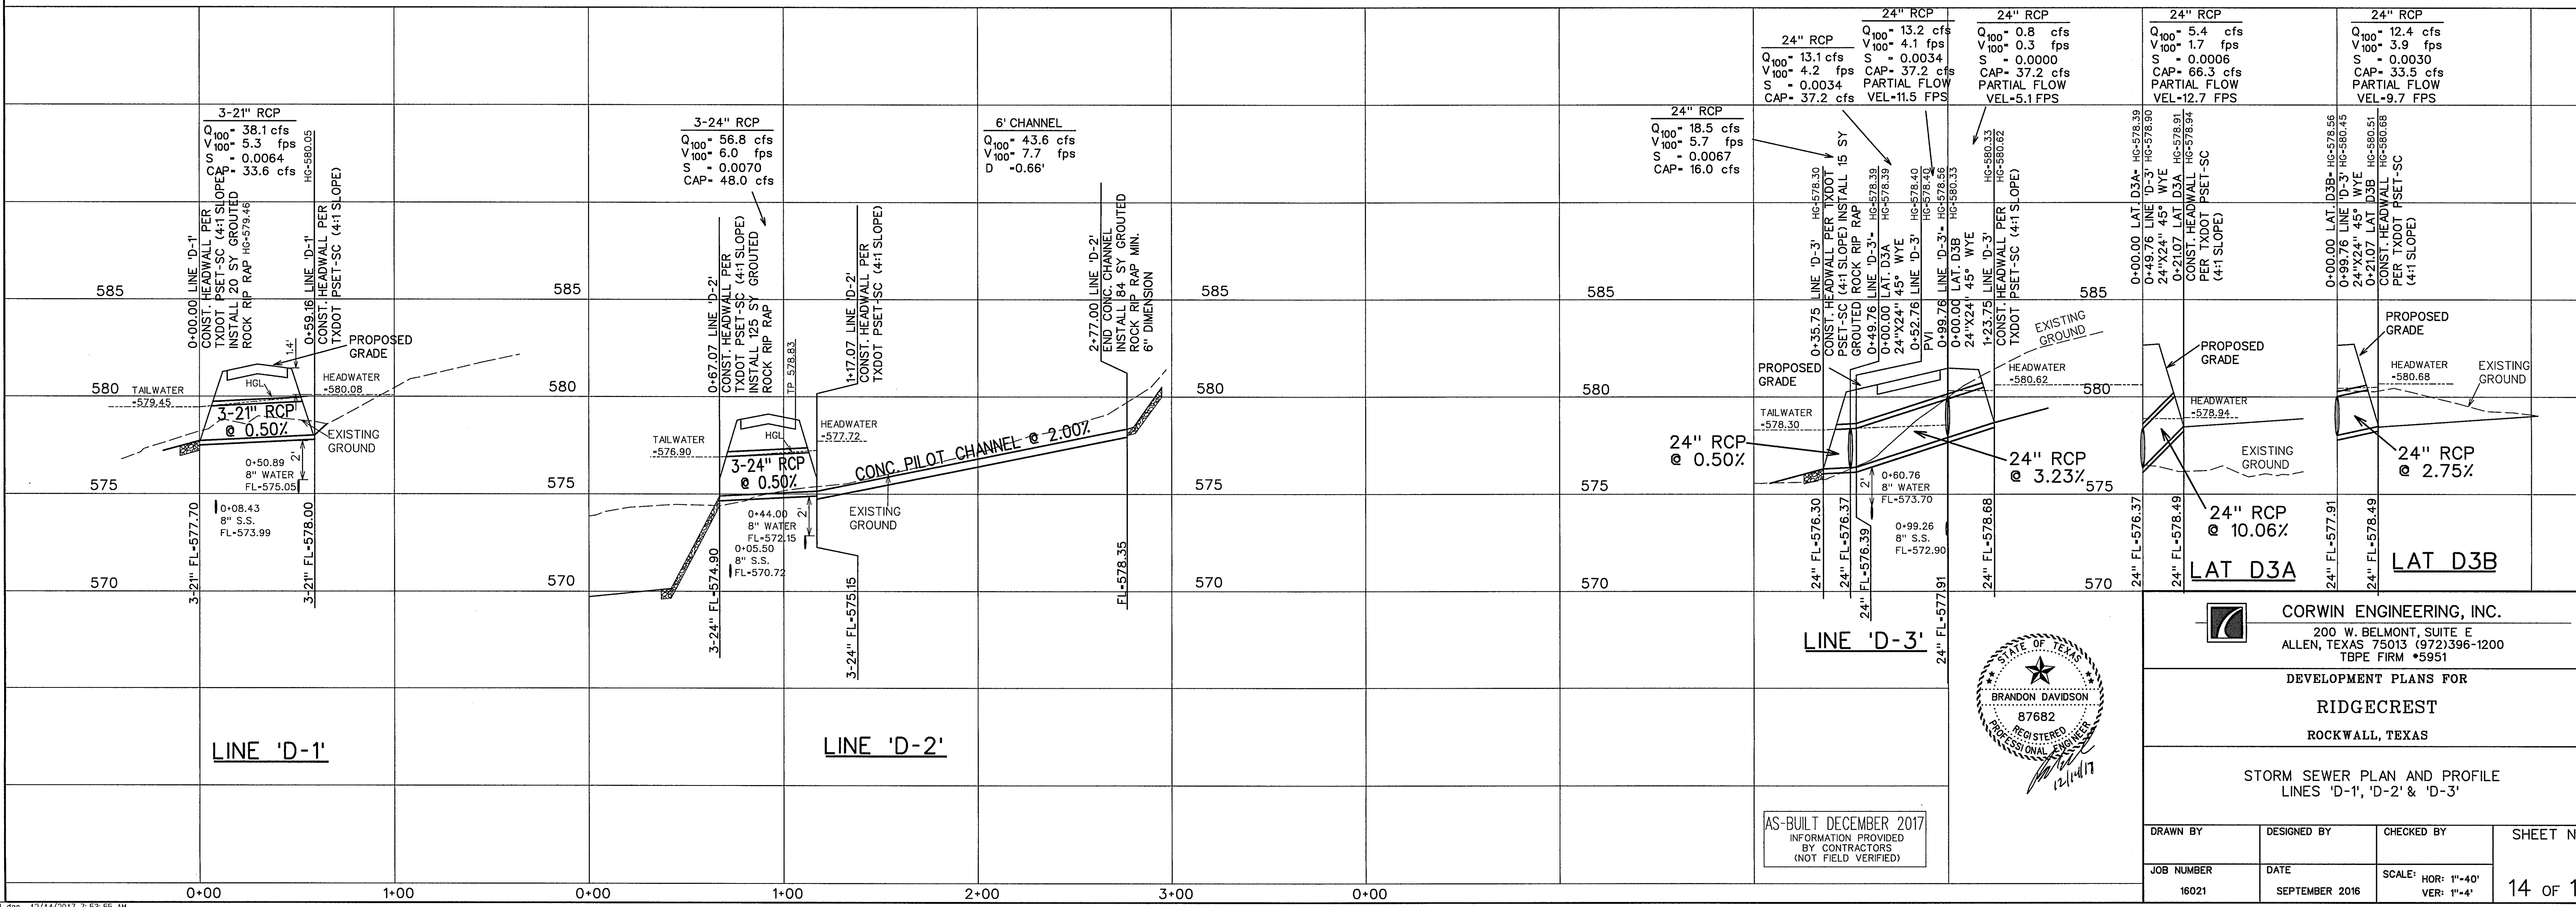

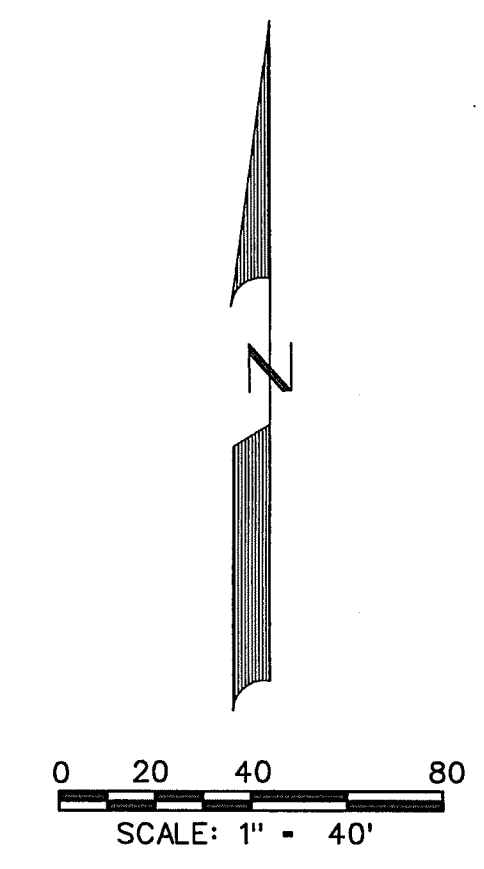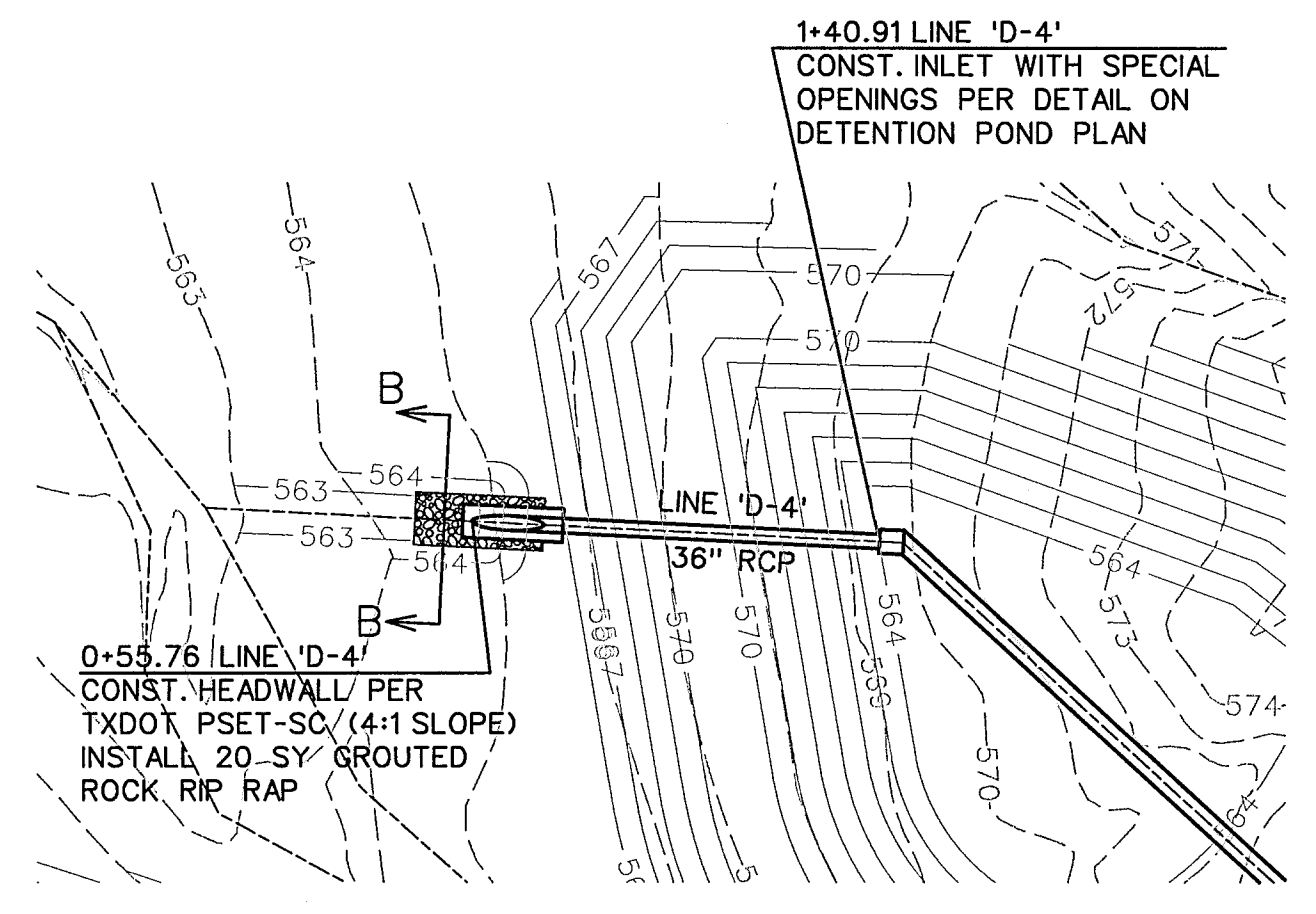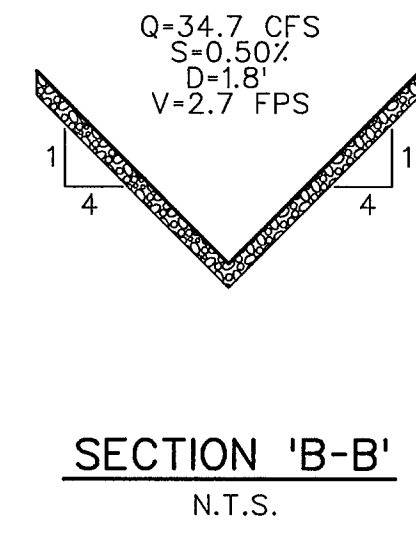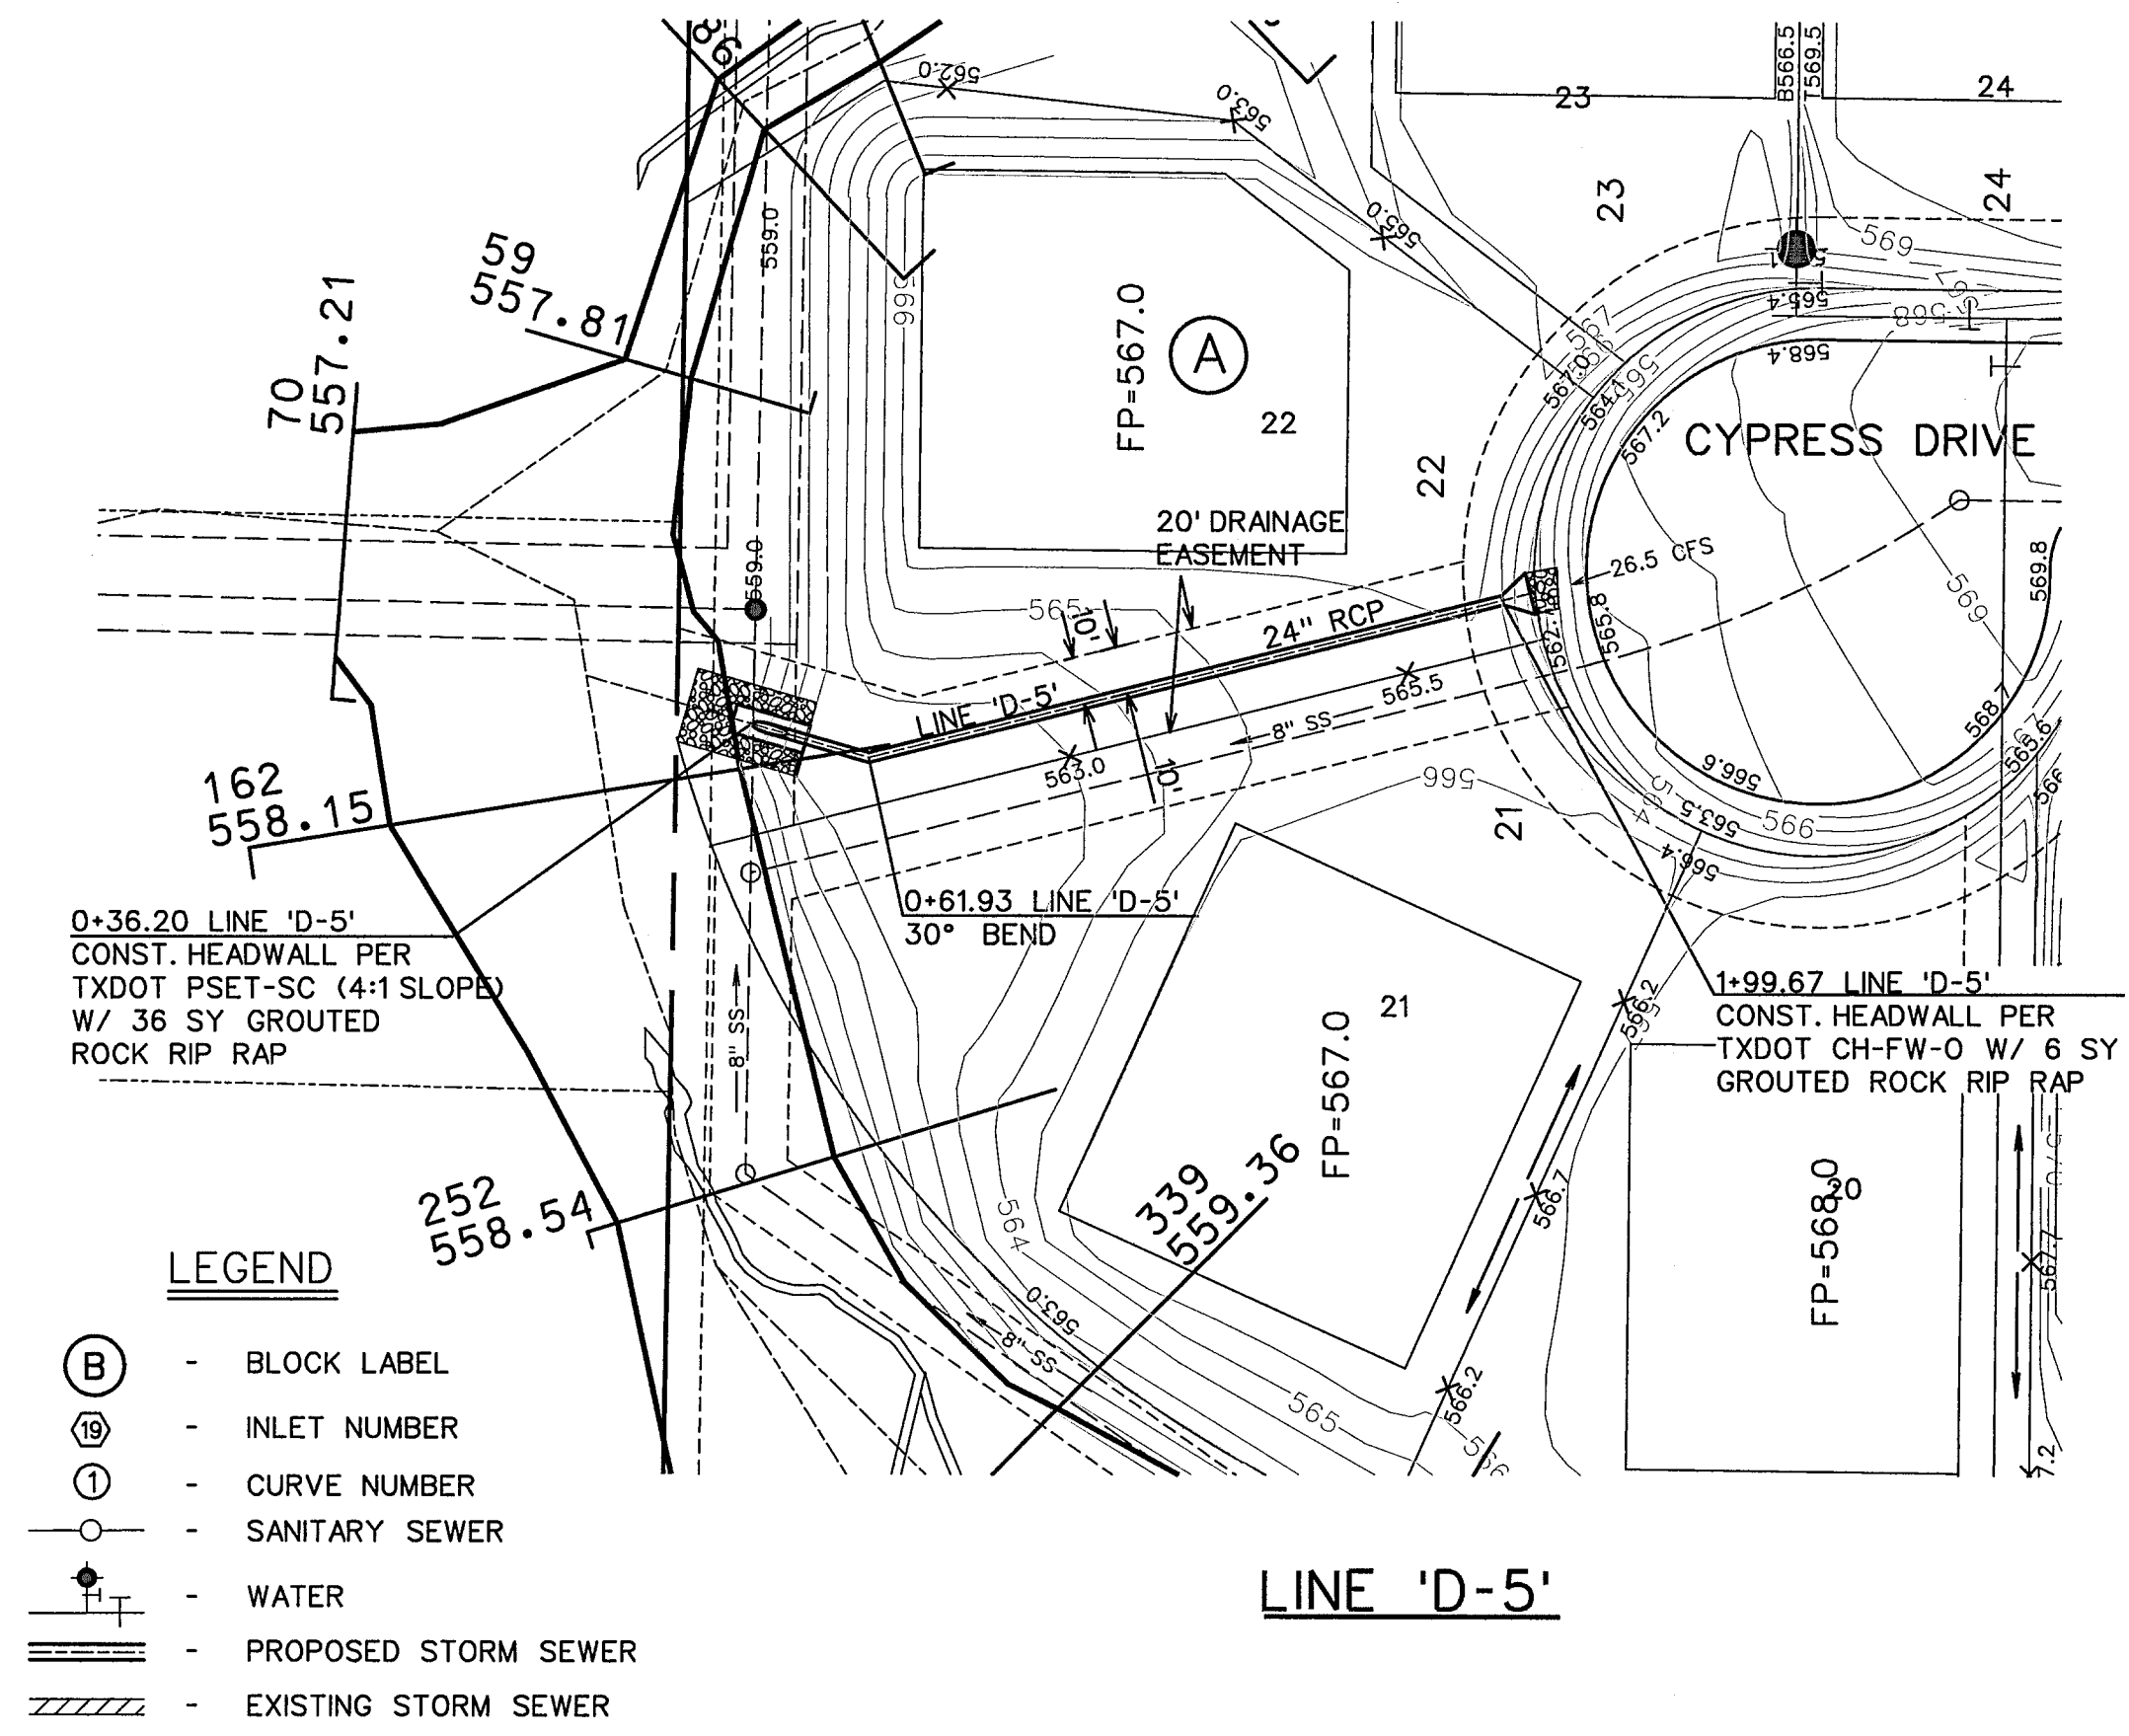

LINE 'D-4'
STORM SEWER CALCULATIONS

Upstream Station	Downstream Station	Distance (ft)	AREA (Acres)	Total Area Picked Up (Acres)	C	CA	CA	Tc (Min)	Design Storm (Years)	I (in/hr)	Q (CFS)	S	Pipe Size (in)	Velocity (fps)	Velocity Head (ft)	K	Flow Time (Min)	Time at DIS (Min)	Δ Velocity Head (ft)	Hydraulic Grade Upstream	Hydraulic Grade Downstream	
Line D3																						
1+23.75	0+99.76	23.99	13	0.16	0.16	0.50	0.08	10.00	100	9.80	0.8	0.0000	24	5.1	0.40	0.70	0.08	10.08	0.28	580.62	580.33	
0+99.76	0+52.76	47.00	D3B	2.53	2.53	0.50	1.26	1.34	10.08	100	9.79	13.2	0.0034	24	11.5	2.05	0.50	0.07	10.15	1.77	580.33	578.56
0+52.76	0+49.76	3.00	PVI	0.00	0.00	0.50	0.00	1.34	10.15	100	9.78	13.1	0.0034	24	4.2	0.27	1.00	0.01	10.16	0.00	579.40	578.40
0+49.76	0+35.75	14.01	D3A	1.09	1.09	0.50	0.55	1.89	10.15	100	9.78	18.5	0.0067	24	5.9	0.54	0.50	0.04	10.19	0.00	578.39	578.39
0+35.75	0+00.00	21.07																				
Line D3A																						
0+21.07	0+00.00	21.07	8	1.09	1.09	0.50	0.55	0.55	10.00	100	9.80	5.4	0.0006	24	1.7	0.05	0.70	0.21	10.21	0.03	578.94	578.91
0+00.00	0+00.00	0.00																				
Line D3B																						
0+21.07	0+00.00	21.07	9	2.53	2.53	0.50	1.26	1.26	10.00	100	9.80	12.4	0.0030	24	3.9	0.24	0.70	0.09	10.09	0.17	580.68	580.51
0+00.00	0+00.00	0.00																				
Line D4																						
1+45.91	0+64.57	81.34	Pond	23.26	23.26																	
0+64.57	0+64.57	0.00																				
Line D5																						
1+99.67	1+00.00	99.67	1,2	5.40	5.40	0.50	2.70	2.70	10.00	100	9.80	26.5	0.0137	24	15.2	3.59	1.00	0.11	10.11		562.29	562.29
1+00.00	0+61.93	38.07	PVI	0.00	0.00	0.50	0.00	2.70	10.11	100	9.78	26.4	0.0137	24	4.2	0.27	1.00	0.15	10.26	0.00	560.92	560.92
0+61.93	0+36.20	25.73	Bend	0.00	0.00	0.50	0.00	2.70	10.26	100	9.76	26.4	0.0136	24	4.2	0.27	0.45	0.10	10.36	0.12	560.45	560.28
0+36.20	0+36.20	0.00																				

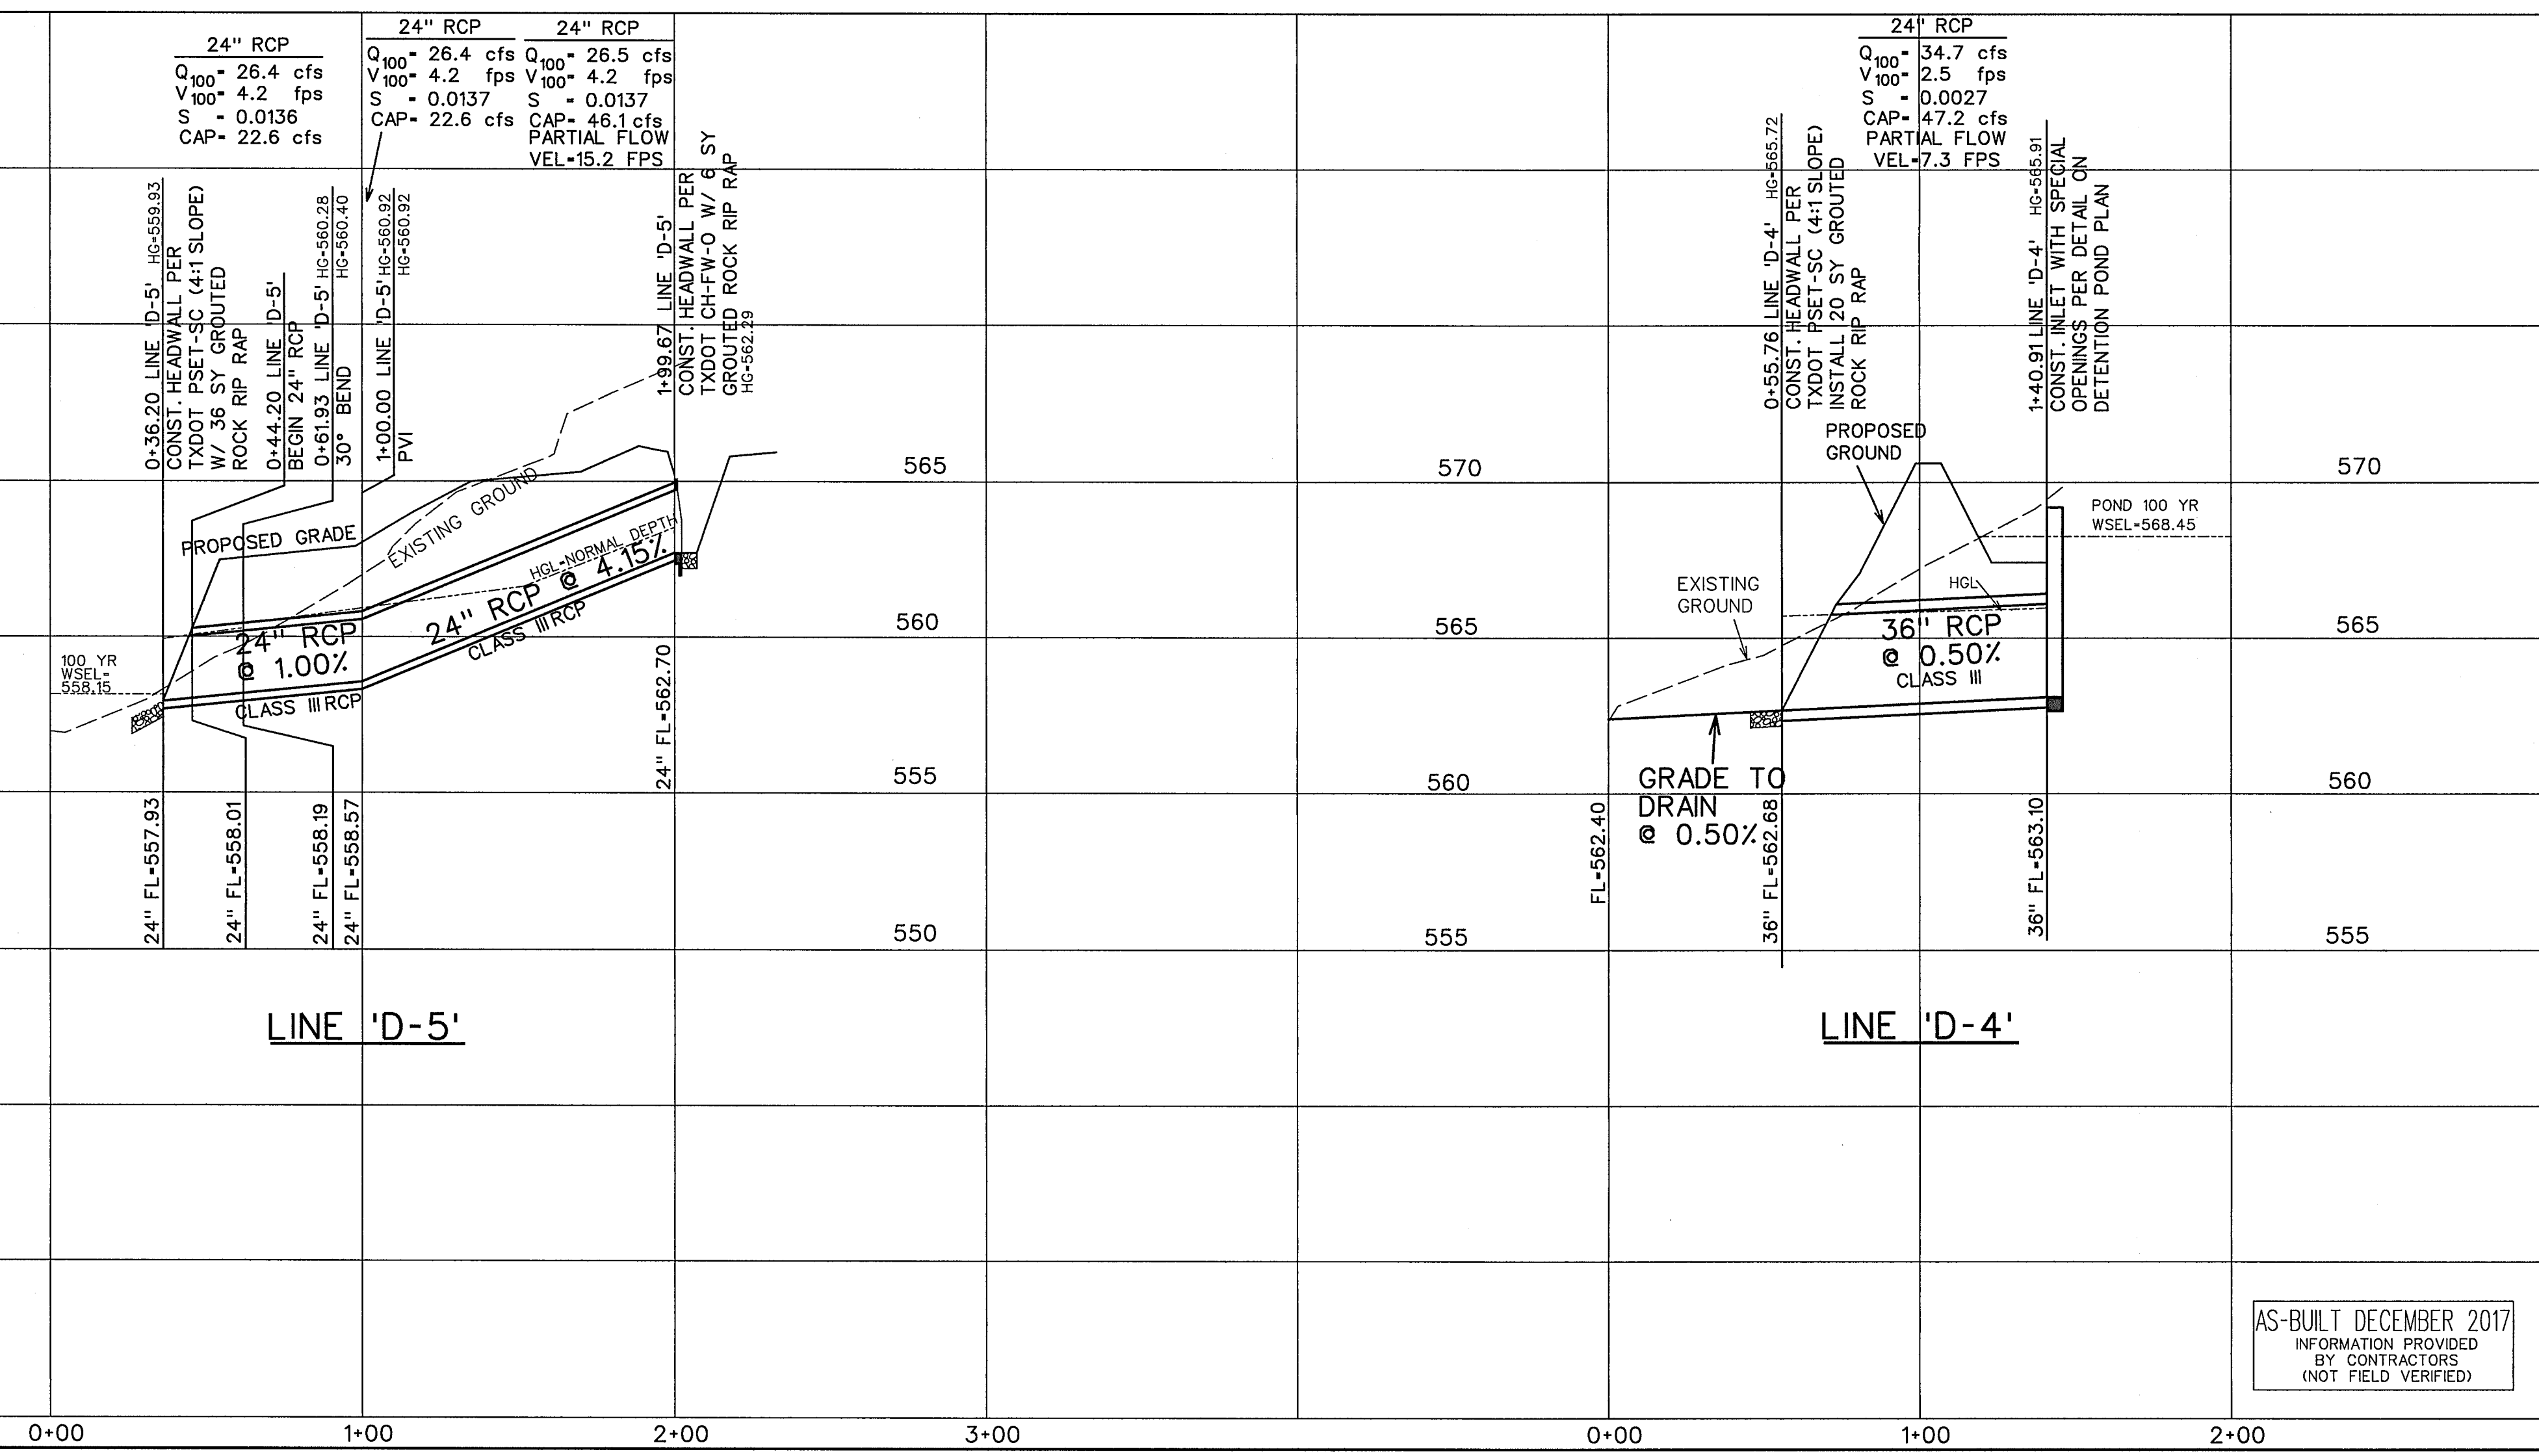

AS-BUILT DECEMBER 2017
INFORMATION PROVIDED
BY CONTRACTORS
(NOT FIELD VERIFIED)

CORWIN ENGINEERING, INC.
200 W. BELMONT, SUITE E
ALLEN, TEXAS 75013 (972)396-1200
TBPE FIRM #5951

DEVELOPMENT PLANS FOR
RIDGECREST
ROCKWALL, TEXAS

STORM SEWER PLAN AND PROFILE
LINE 'D-4' & 'D-5'

DRAWN BY	DESIGNED BY	CHECKED BY	SHEET NO.
16021	SEPTEMBER 2016		15 OF 19

THIS PROPERTY WILL OVERDETAIN RUNOFF FROM AREAS 8,9,10,11 AND OS3 TO ACCOUNT FOR THE FREE RELEASE OF AREAS 1-7 AND 12 SO THAT TOTAL DEVELOPED CONDITIONS RUNOFF FROM THE SITE DOES NOT EXCEED THE RUNOFF UNDER EXISTING CONDITIONS.

Ridgecrest

5-Year Storm

Pre-Project Runoff Calculations

Area #	Area (sf)	Area (acres)	Existing Runoff Coefficient	CA	Tc (min)	Rainfall Intensity (in/hr)	Q - Undeveloped (cfs)
EX	1260692	28.94	0.35		20	4.9	49.6

Allowed Release = 49.6

Post-Project Runoff Calculations

Area #	Area (sf)	Area (acres)	Runoff Coefficient	CA	Tc (min)	Rainfall Intensity (in/hr)	Q - Post Development (cfs)
1-10,13-16	993786	22.8	0.50		10	6.1	69.6
11-12	267595	6.14	0.35		20	4.9	49.6

Proposed Release = 80.1
Flow Recution Required = 30.5

Inflow to Pond

Drainage Area (sf)	Area (acres)	Runoff Coefficient	CA	Tc (min)	Rainfall Intensity (in/hr)	Q
8-10,13-16	330877	7.60	0.50	3.80	10	23.2
11,OS3	682416	15.67	0.35	5.48	20	26.9

Weighted C Value = 0.39898045
Proposed Inflow to Pond = 50.0
Allowed Release = 19.6

10-Year Storm

Pre-Project Runoff Calculations

Area #	Area (sf)	Area (acres)	Existing Runoff Coefficient	CA	Tc (min)	Rainfall Intensity (in/hr)	Q - Undeveloped (cfs)
EX	1260692	28.94	0.35		20	5.9	59.8

Allowed Release = 59.8

Post-Project Runoff Calculations

Area #	Area (sf)	Area (acres)	Runoff Coefficient	CA	Tc (min)	Rainfall Intensity (in/hr)	Q - Post Development (cfs)
1-10,13-16	993786	22.8	0.50		10	7.1	82.4
11-12	267595	6.14	0.35		20	5.9	59.8

Proposed Release = 93.7
Flow Recution Required = 33.9

Inflow to Pond

Drainage Area (sf)	Area (acres)	Runoff Coefficient	CA	Tc (min)	Rainfall Intensity (in/hr)	Q
8-10,13-16	330877	7.60	0.50	3.80	10	27.0
11,OS3	682416	15.67	0.35	5.48	20	29.9

Weighted C Value = 0.40
Proposed Inflow to Pond = 58.3
Allowed Release = 25.4

25-Year Storm

Pre-Project Runoff Calculations

Area #	Area (sf)	Area (acres)	Existing Runoff Coefficient	CA	Tc (min)	Rainfall Intensity (in/hr)	Q - Undeveloped (cfs)
EX	1260692	28.94	0.35		20	6.6	66.9

Allowed Release = 66.9

Post-Project Runoff Calculations

Area #	Area (sf)	Area (acres)	Runoff Coefficient	CA	Tc (min)	Rainfall Intensity (in/hr)	Q - Post Development (cfs)
1-10,13-16	993786	22.8	0.50		10	8.3	94.7
11-12	267595	6.14	0.35		20	6.6	66.9

Proposed Release = 108.9
Flow Recution Required = 42.0

Inflow to Pond

Drainage Area (sf)	Area (acres)	Runoff Coefficient	CA	Tc (min)	Rainfall Intensity (in/hr)	Q
8-10,13-16	330877	7.60	0.50	3.80	10	31.5
11,OS3	682416	15.67	0.35	5.48	20	36.2

Weighted C Value = 0.40
Proposed Inflow to Pond = 67.7
Allowed Release = 25.7

50-Year Storm

Pre-Project Runoff Calculations

Area #	Area (sf)	Area (acres)	Existing Runoff Coefficient	CA	Tc (min)	Rainfall Intensity (in/hr)	Q - Undeveloped (cfs)
EX	1260692	28.94	0.35		20	7.5	76.0

Allowed Release = 76.0

Post-Project Runoff Calculations

Area #	Area (sf)	Area (acres)	Runoff Coefficient	CA	Tc (min)	Rainfall Intensity (in/hr)	Q - Post Development (cfs)
1-10,13-16	993786	22.8	0.50		10	9	102.7
11-12	267595	6.14	0.35		20	7.5	76.0

Proposed Release = 118.8
Flow Recution Required = 42.8

Inflow to Pond

Drainage Area (sf)	Area (acres)	Runoff Coefficient	CA	Tc (min)	Rainfall Intensity (in/hr)	Q
8-10,13-16	330877	7.60	0.50	3.80	10	34.2
11,OS3	682416	15.67	0.35	5.48	20	41.1

Weighted C Value = 0.40
Proposed Inflow to Pond = 75.3
Allowed Release = 32.5

100-Year Storm

Pre-Project Runoff Calculations

Area #	Area (sf)	Area (acres)	Existing Runoff Coefficient	CA	Tc (min)	Rainfall Intensity (in/hr)	Q - Undeveloped (cfs)
EX	1260692	28.94	0.35		20	8.3	84.1

Allowed Release = 84.1

Post-Project Runoff Calculations

Area #	Area (sf)	Area (acres)	Runoff Coefficient	CA	Tc (min)	Rainfall Intensity (in/hr)	Q - Post Development (cfs)
1-10,13-16	993786	22.8	0.50		10	9.8	111.8
11-12	267595	6.14	0.35		20	8.3	84.1

Proposed Release = 129.8
Flow Recution Required = 45.6

Inflow to Pond

Drainage Area (sf)	Area (acres)	Runoff Coefficient	CA	Tc (min)	Rainfall Intensity (in/hr)	Q
8-10,13-16	330877	7.60	0.50	3.80	10	37.2
11,OS3	682416	15.67	0.35	5.48	20	45.5



Weighted C Value = 0.40
Proposed Inflow to Pond = 82.7
Allowed Release = 37.2

Detention Pond Stage Discharge Calculations

Weir Equation - $Q = 3.33^{1/3} H^{3/2} L$
Orifice Equation - $Q = 0.61 A (2gH)^{1/2}$


Opening #	Flowline (ft)	Area (sf)	Total Length (ft)	Centroid (ft)
Opening #1	1.15' wide x 2' tall square opening	563.10	2,300	564.1
Opening #2	2-4.5' wide x 1' tall openings	567.95	8,000	568.45

Stage (ft)	Weir Flow			Orifice Flow			Opening #2			Total Release (cfs)	
	Flow Type	Weir Length (ft)	Head (ft)	Release (cfs)	Area (sf)	Head (ft)	Release (cfs)	Flow Type	Weir Length (ft)		Head (ft)
563.10	Weir	1.18	0.00	0.0	N/A			N/A			0.0
563.50	Weir	1.18	0.40	1.0	N/A			N/A			1.0
564.00	Weir	1.18	0.90	3.4	N/A			N/A			3.4
564.50	Weir	1.18	1.40	6.5	N/A			N/A			6.5
565.00	Weir	1.18	1.90	10.3	N/A			N/A			10.3
565.50	Orifice	N/A		2.3	1.40	13.1	N/A	N/A			13.1
566.00	Orifice	N/A		2.3	1.90	15.3	N/A	N/A			15.3
566.50	Orifice	N/A		2.3	2.40	17.2	N/A	N/A			17.2
567.00	Orifice	N/A		2.3	2.90	18.9	N/A	N/A			18.9
567.26	Orifice	N/A		2.3	3.15	19.7	N/A	N/A			19.7
567.50	Orifice	N/A		2.3	3.40	20.4	N/A	N/A			20.4
567.91	Orifice	N/A		2.3	3.81	21.6	N/A	N/A			21.6
567.90	Orifice	N/A		2.3	3.80	21.6	N/A	N/A			21.6
568.00	Orifice	N/A		2.3	3.90	21.9	Weir	9	0.05	0.3	22.2
568.19	Orifice	N/A		2.3	4.09	22.4	Weir	9	0.24	3.5	25.9
568.37	Orifice	N/A		2.3	4.27	22.9	Weir	9	0.42	8.2	31.1
568.50	Orifice	N/A		2.3	4.40	23.2	Weir	9	0.55	12.1	35.3
568.50	Orifice	N/A		2.3	4.40	23.2	Weir	9	0.55	12.2	35.3
569.00	Orifice	N/A		2.3	4.90	24.5	Orifice			0.55	32.1
569.50	Orifice	N/A		2.3	5.40	25.7	Orifice			1.05	44.4
570.00	Orifice	N/A		2.3	5.90	26.9	Orifice			1.55	54.0

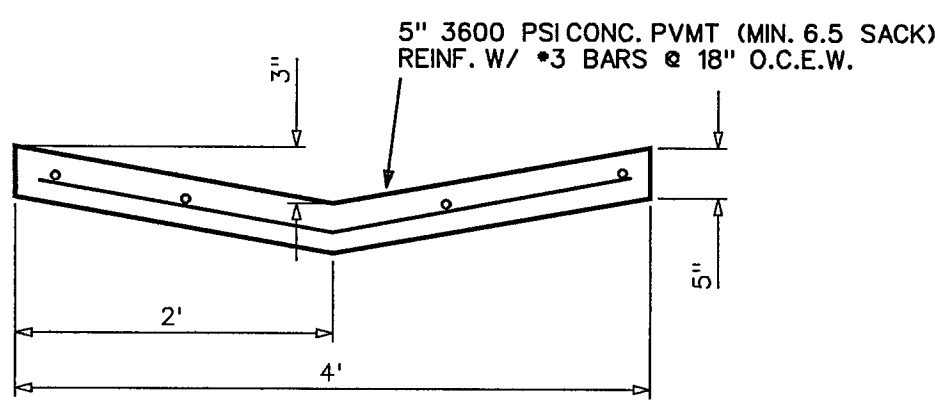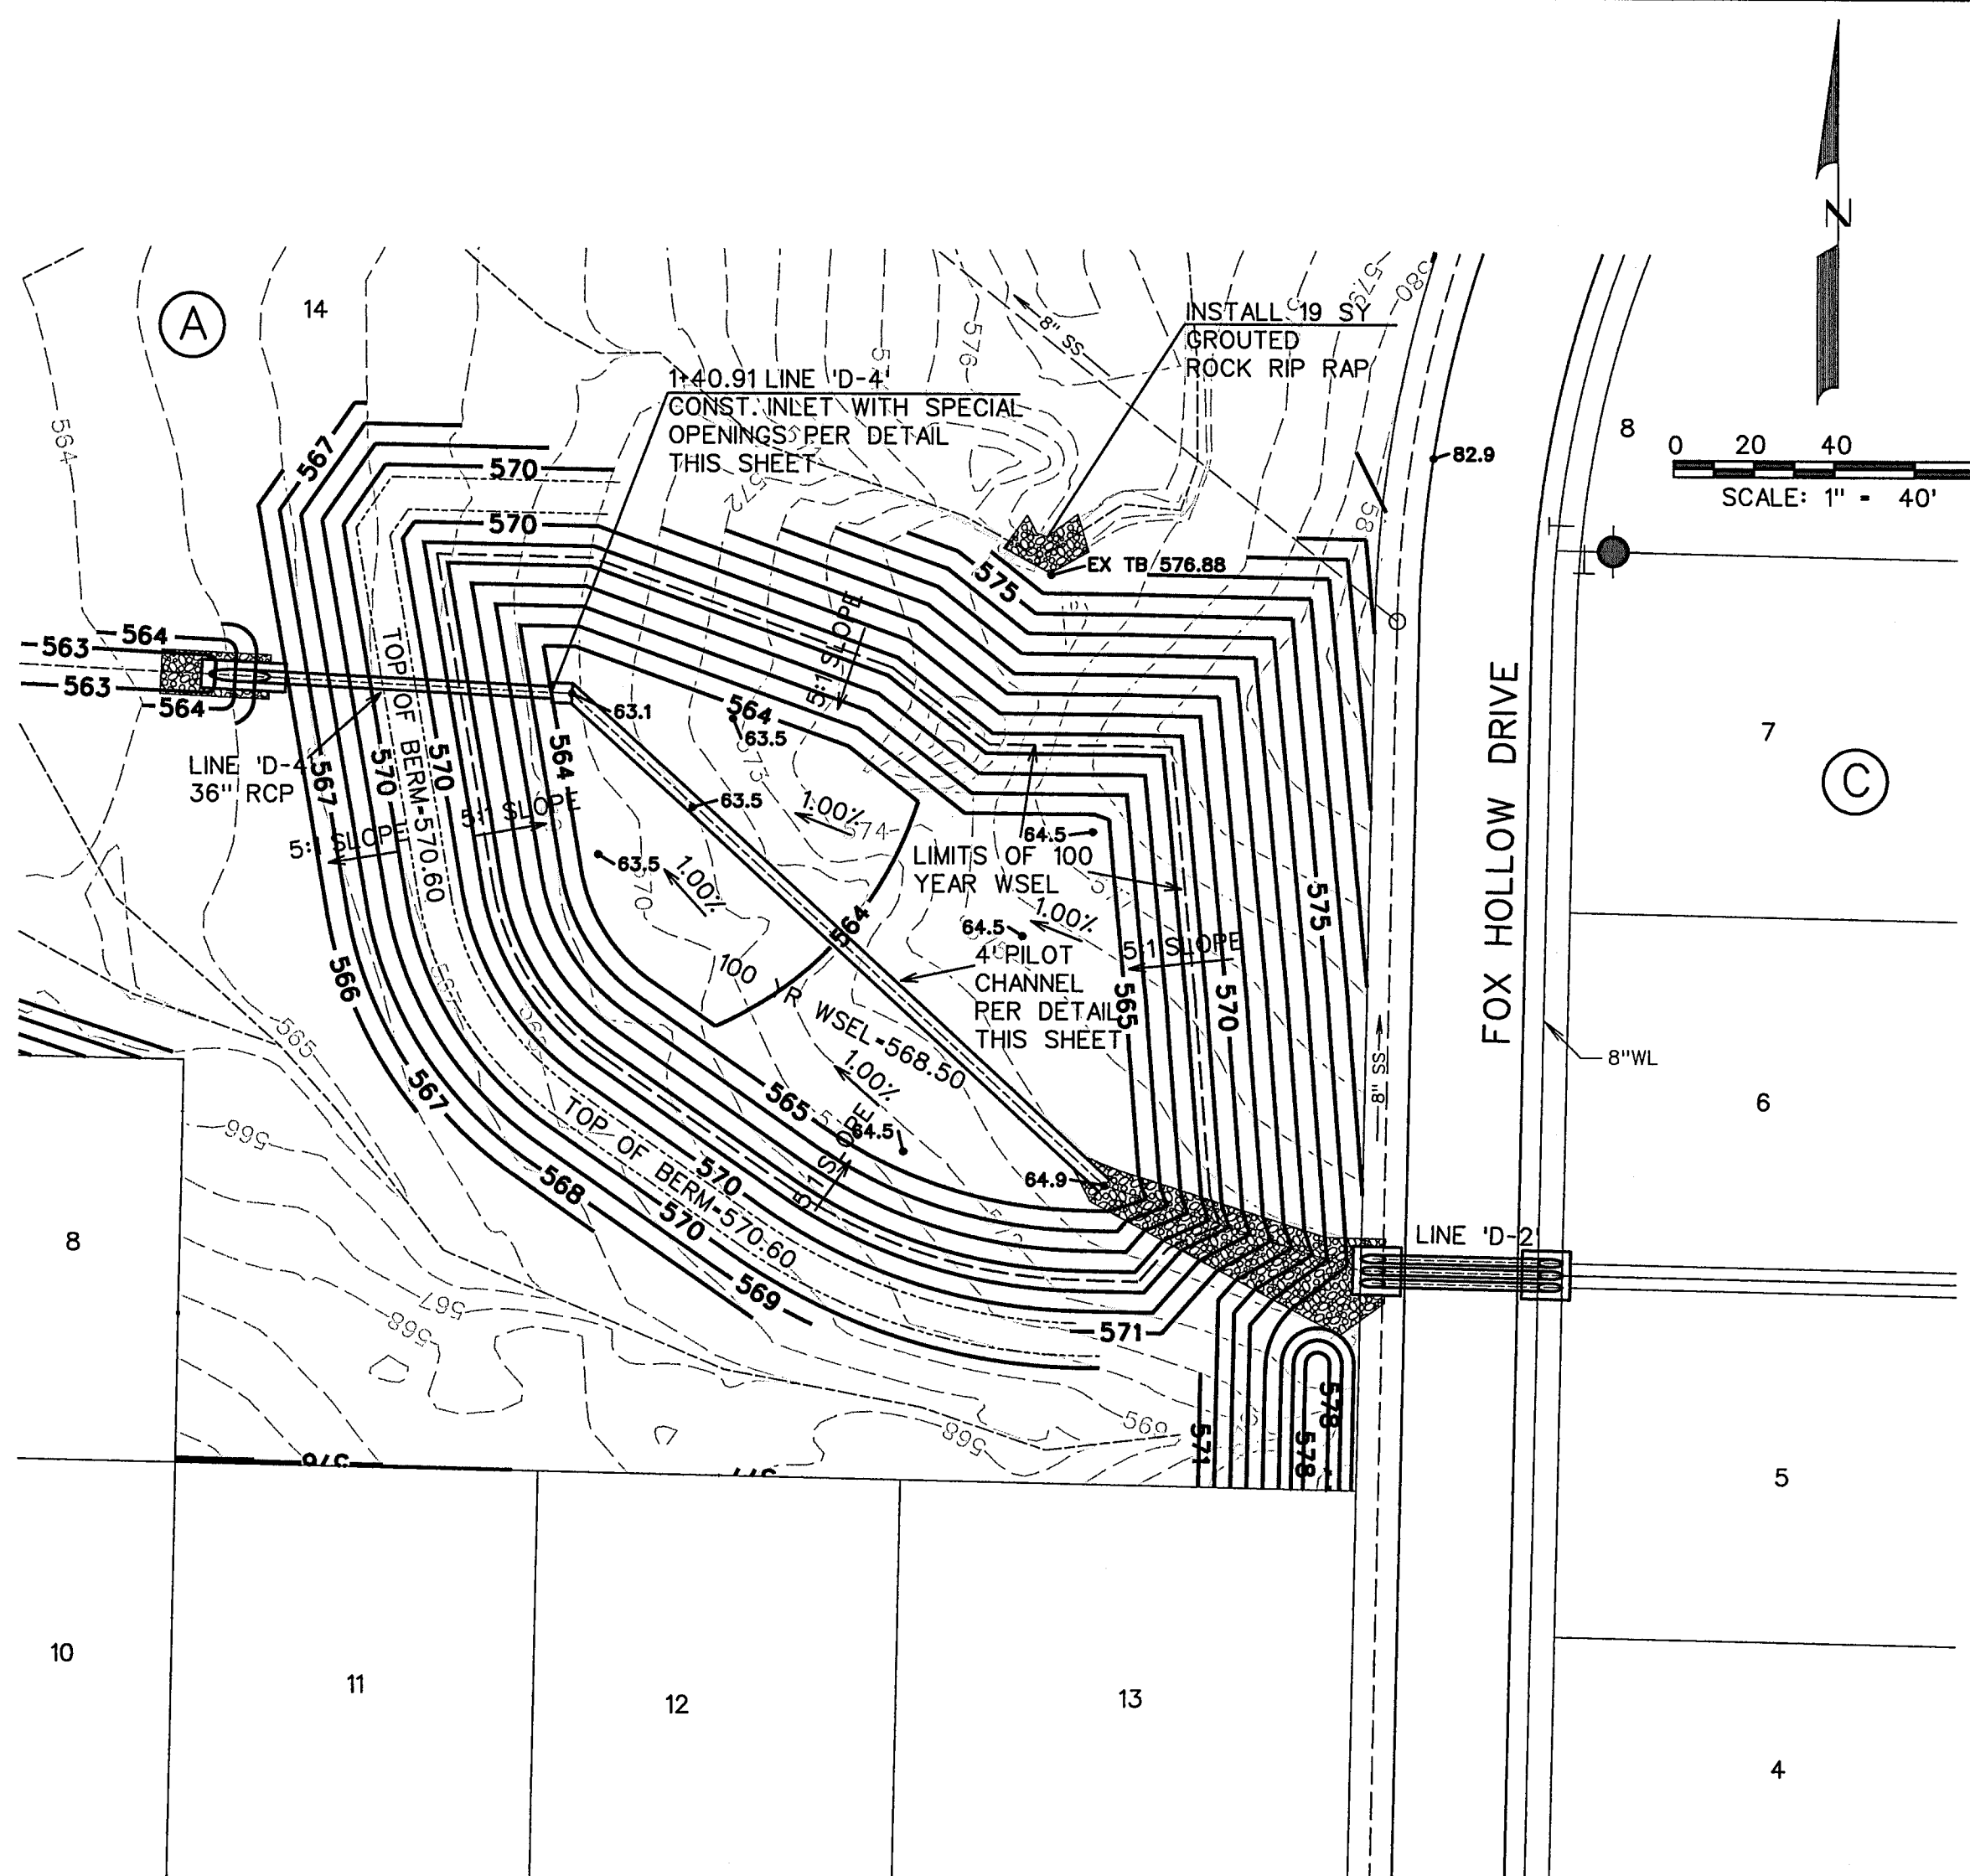

PILOT CHANNEL DETAIL

NOTE: NO PAVING TO BE INSTALLED UNTIL THE DETENTION SYSTEM IS CONSTRUCTED AND FULLY FUNCTIONING ALONG WITH THE BOTTOM AND SIDES OF THE DETENTION POND TO HAVE EITHER SOD OR ANCHORED SEEDED CURLEX INSTALLED.

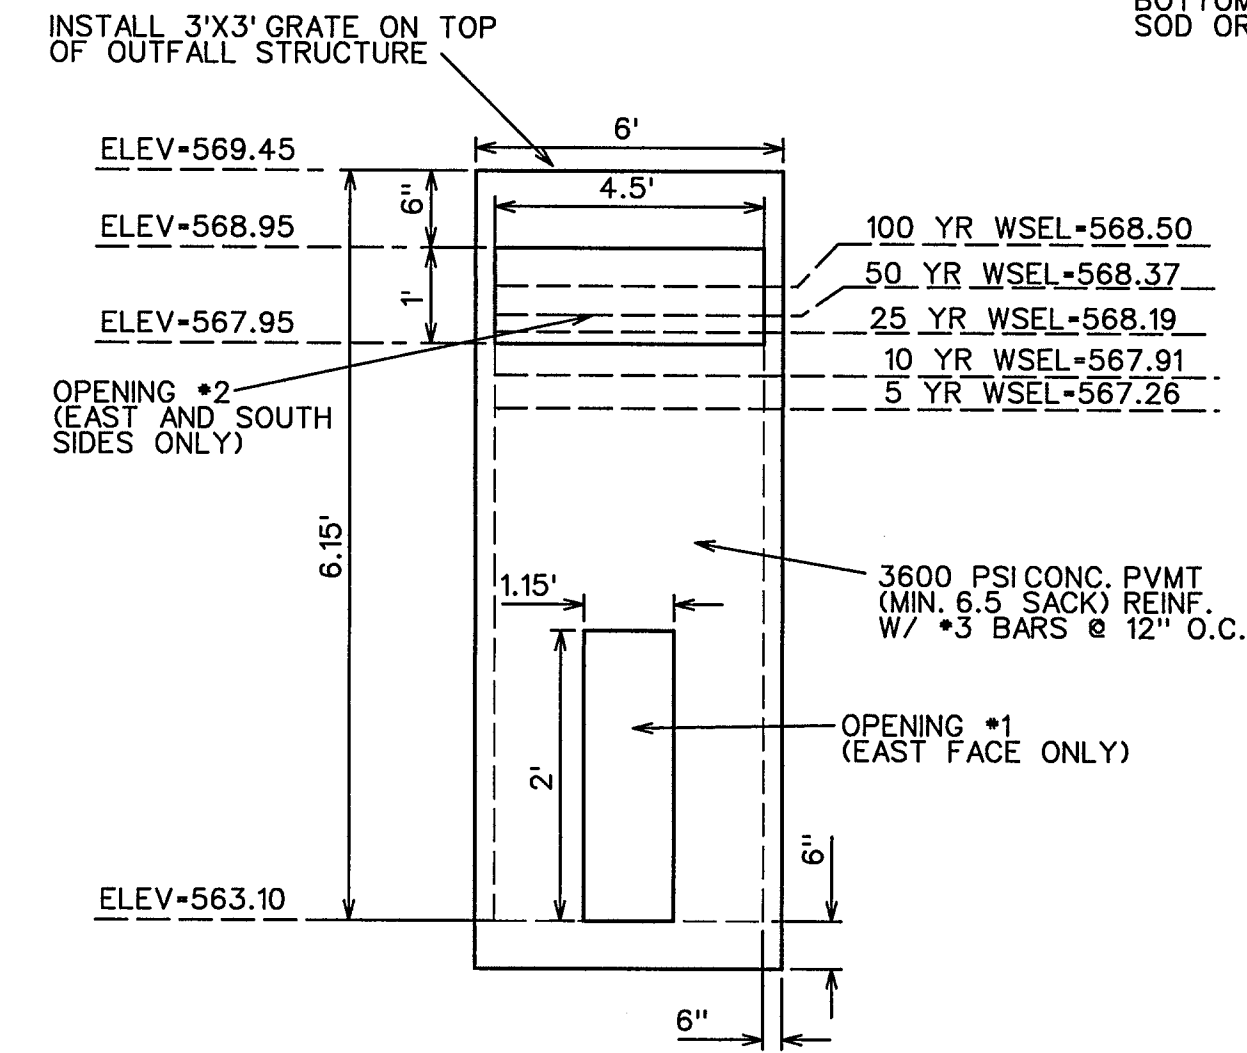

SPECIAL INLET OPENINGS DETAIL

Elevation Calculations

Event	Maximum Release Rate	Actual Release Rate	Storage Requirement	Occurs at Elevation
5-year	19.6	19.7	49352	567.26
10-year	25.4	21.6	62721	567.91
25-year	25.7	25.9	68251	568.19
50-year	32.5	31.1	72073	568.37
100-year	37.2	35.3	76227	568.50

DETENTION CALCULATIONS - 5 Year

Storm Duration	Outflow Duration	Area (AC.)	Future "C"	Future "K"	Future "CA"	Rainfall Intensity (cfs)	Inflow (cfs)	Volume (cubic ft.)	Volume (cubic ft.)	Volume (cubic ft.)	Volume (cubic ft.)	Outflow (cfs)
10	20	23.26	0.40	1.00	9.28	6.10	56.6	33989	11802	22166	0.51	19.7
20	30	23.26	0.40	1.00	9.28	4.50	45.5	54573	17704	36889	0.85	19.7
30	40	23.26	0.40	1.00	9.28	4.10	38.1	68494	23605	44889	1.03	19.7
40	50	23.26	0.40	1.00	9.28	3.40	31.6	75734	29506	46227	1.06	19.7
50	60	23.26	0.40	1.00	9.28	2.80	26.0	77961	35407	42554	0.98	19.7
60	70	23.26	0.40	1.00	9.28	2.60	24.1	68871	41309	45562	1.05	19.7
70	80	23.26	0.40	1.00	9.28	2.40	22.3	93553	47210	46343	1.06	19.7
80	90	23.26	0.40	1.00	9.28	2.30	21.3	102463	53111	49362	1.13	19.7
90	100	23.26	0.40	1.00	9.28	2.10	19.5	105248	59012	46235	1.06	19.7
100	110	23.26	0.40	1.00	9.28	1.90	17.6	105804	64914	40891	0.94	19.7

DETENTION CALCULATIONS - 10 Year

Storm Duration	Outflow Duration	Area (AC.)	Future "C"	Future "K"	Future "CA"	Rainfall Intensity (cfs)	Inflow (cfs)	Volume (cubic ft.)	Volume (cubic ft.)	Volume (cubic ft.)	Volume (cubic ft.)	Outflow (cfs)
10	20	23.26	0.40	1.00	9.28	7.10	65.9	39537	12977	26551	0.61	21.6
20	30	23.26	0.40	1.00	9.28	5.30	51.0	91683	31045	46245	1.06	21.6
30	40	23.26	0.40	1.00	9.28	4.80	44.5	80189	25953	54238	1.25	21.6
40	50	23.26	0.40	1.00	9.28	4.00	37.1	89098	32442	56657	1.30	21.6
50	60	23.26	0.40	1.00	9.28	3.50	32.5	97451	38930	58521	1.34	21.6
60	70	23.26	0.40	1.00	9.28	3.00	27.6	100236	45418	54817	1.26	21.6
70	80	23.26	0.40	1.00	9.28	2.80	26.0	109148	51907	67290	1.31	21.6
80	90	23.26	0.40	1.00	9.28	2.60	24.1	115828	58395	67433	1.32	21.6
90	100	23.26	0.40	1.00	9.28	2.50	23.2	125295	64883	60411	1.39	21.6
100	110	23.26	0.40	1.00	9.28	2.40	22.3	133648	71372	62276	1.43	21.6
110	120	23.26	0.40	1.00	9.28	2.30	21.3	140581	77860	62721	1.44	21.6

DETENTION CALCULATIONS - 25 Year

Storm Duration	Outflow Duration	Area (AC.)	Future "C"	Future "K"	Future "CA"	Rainfall Intensity (cfs)	Inflow (cfs)	Volume (cubic ft.)	Volume (cubic ft.)	Volume (cubic ft.)	Volume (cubic ft.)	Outflow (cfs)
10	20	23.26	0.40	1.00	9.28	8.30	77.0	46220	15523	30697	0.70	25.9
20	30	23.26	0.40	1.00	9.28	6.60	61.3	73506	23284	50222	1.15	25.9
30	40	23.26	0.40	1.00	9.28	5.50	51.0	91683	31045	60654	1.40	25.9
40	50	23.26	0.40	1.00	9.28	4.60	42.7	102463	38906	63567	1.46	25.9
50	60	23.26	0.40	1.00	9.28	4.00	37.1	111373	46568	64805	1.49	25.9
60	70	23.26	0.40	1.00	9.28	3.50	32.5	116942	54329	62813	1.44	25.9
70	80	23.26	0.40	1.00	9.28	3.30	30.6	126636	62090	66545	1.53	25.9
80	90	23.26	0.40	1.00	9.28	3.10	28.8	138103	69852	68251	1.57	25.9
90	100	23.26	0.40									





NOTE:
RETAINING WALLS 3' IN HEIGHT AND OVER
NEED AN ENGINEERED SEALED PLAN.
(PLANS TO BE SUBMITTED PRIOR
TO ENGINEERING APPROVAL)

⊗ DRIVEWAY LOCATION SO MAXIMUM 14%
SLOPE OR UNDER IS MAINTAINED, OR AS TO
AVOID INLET.
(DRIVEWAY MAY BE PLACED AT ALTERNATE
LOCATION WITH USE OF A DROP GARAGE AS
LONG AS MAXIMUM SLOPE IS 14% OR UNDER)

LEGEND
SPOT ELEVATION 706.2
EXIST. CONTOUR — 700 —
PROP. CONTOUR — 704 —
RETAINING WALL - - - - -

Note:
Each lot will need a detailed grading plan
with building permit submittal. This is a
general grading plan for site work only.

- NOTES:
1. Finish Floor Elevation to be 0.70 Feet above Finished Pad.(FP)
 2. Additional Erosion Control to be installed in Parkways as determined by the City Inspector.
 3. Finished Pad Elevations are within ± 0.3 Feet.
 4. All fill compacted to min 95% std. density using sheeps foot roller.

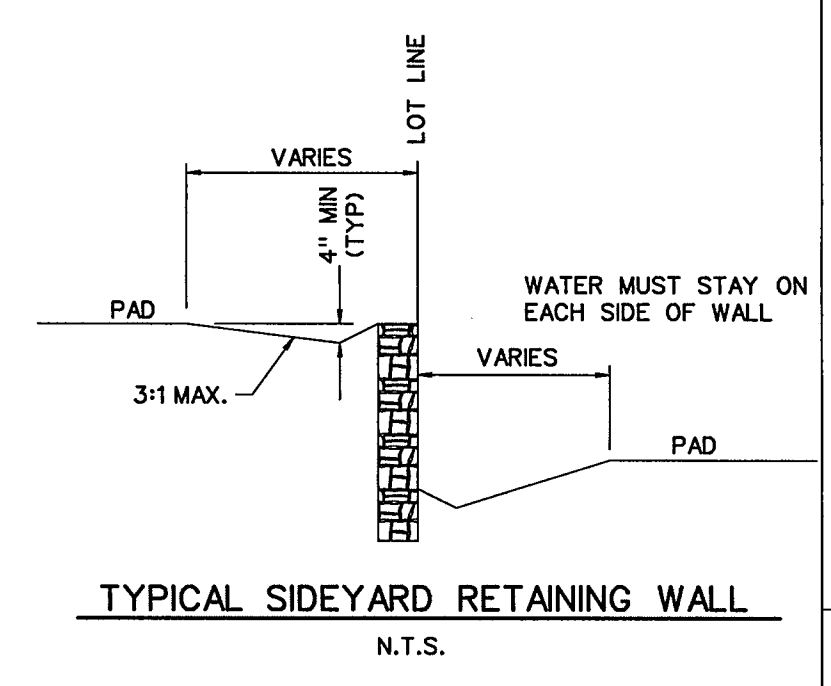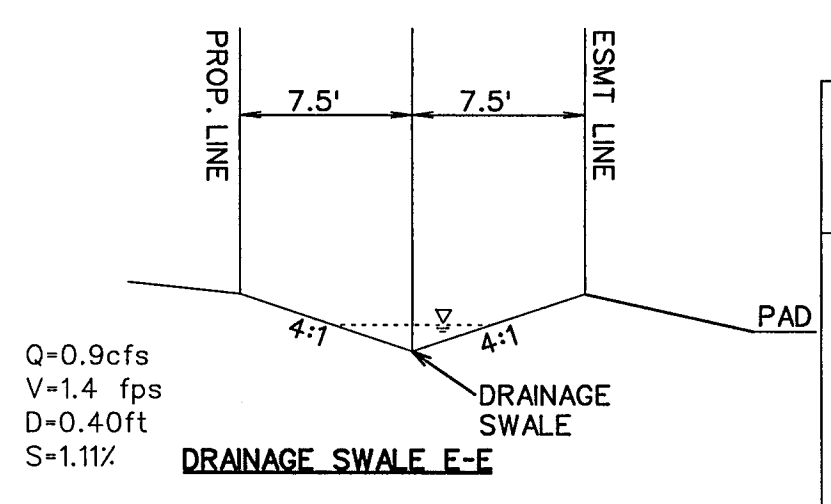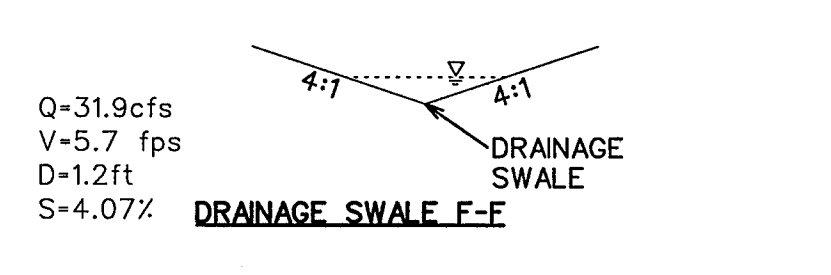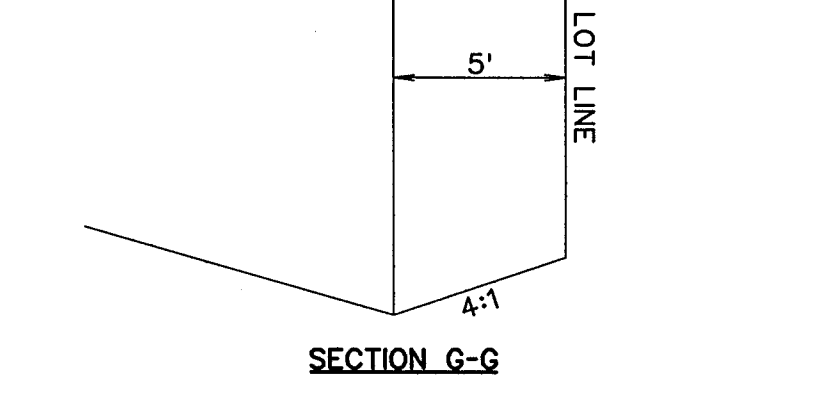

CORWIN ENGINEERING, INC.
200 W. BELMONT, SUITE E
ALLEN, TEXAS 75013 (972) 396-1200
TBPE FIRM #5951


DEVELOPMENT PLANS FOR
RIDGECREST
ROCKWALL, TEXAS

GRADING PLAN


DRAWN BY	DESIGNED BY	CHECKED BY	SHEET NO.
JOB NUMBER	DATE	SCALE:	17 OF 19
16021	SEPTEMBER 2016	1"=50'	






SEE SHEET 12 FOR DRAINAGE CALCULATIONS FOR SWALES A-A THROUGH D-D

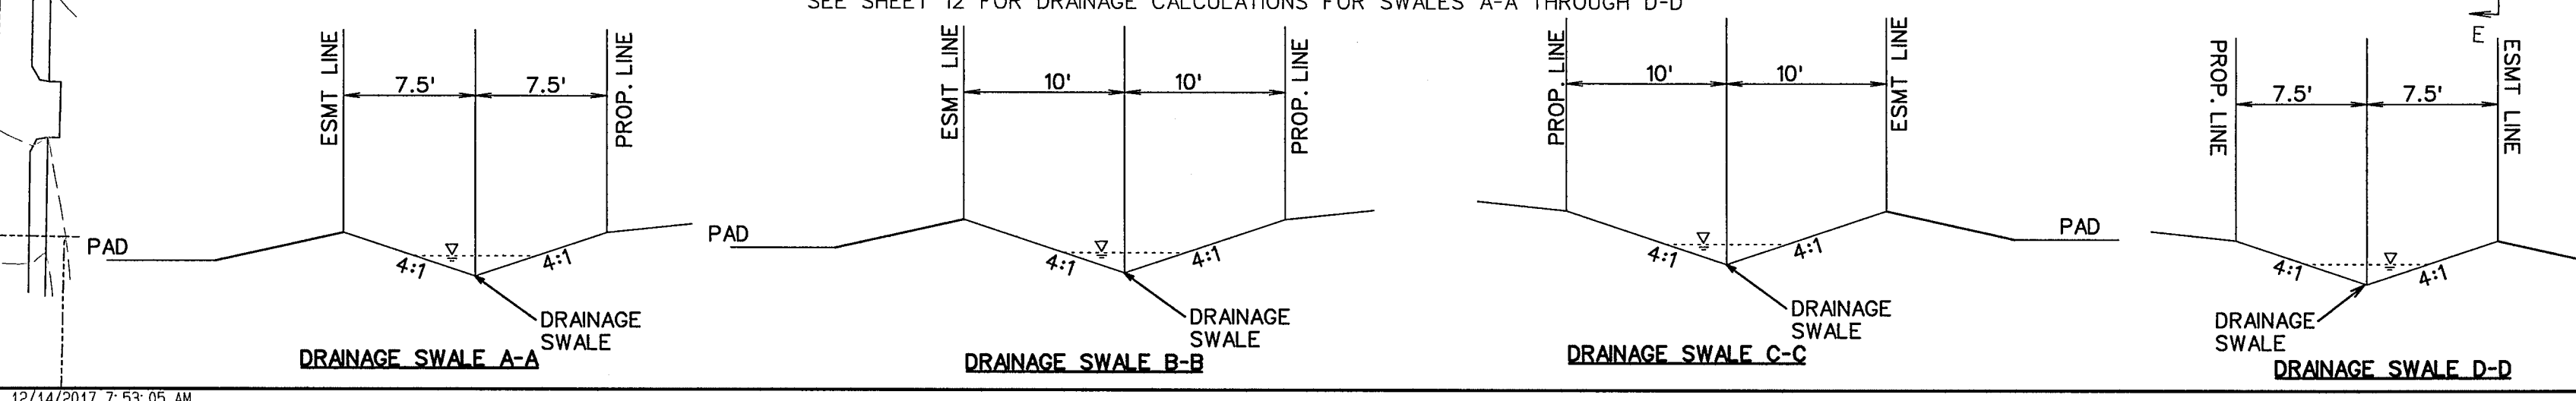


AS-BUILT DECEMBER 2017
INFORMATION PROVIDED
BY CONTRACTORS
(NOT FIELD VERIFIED)

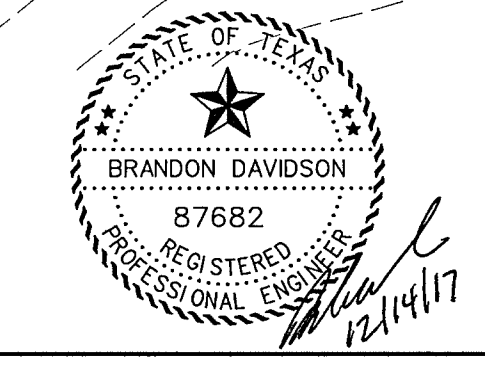

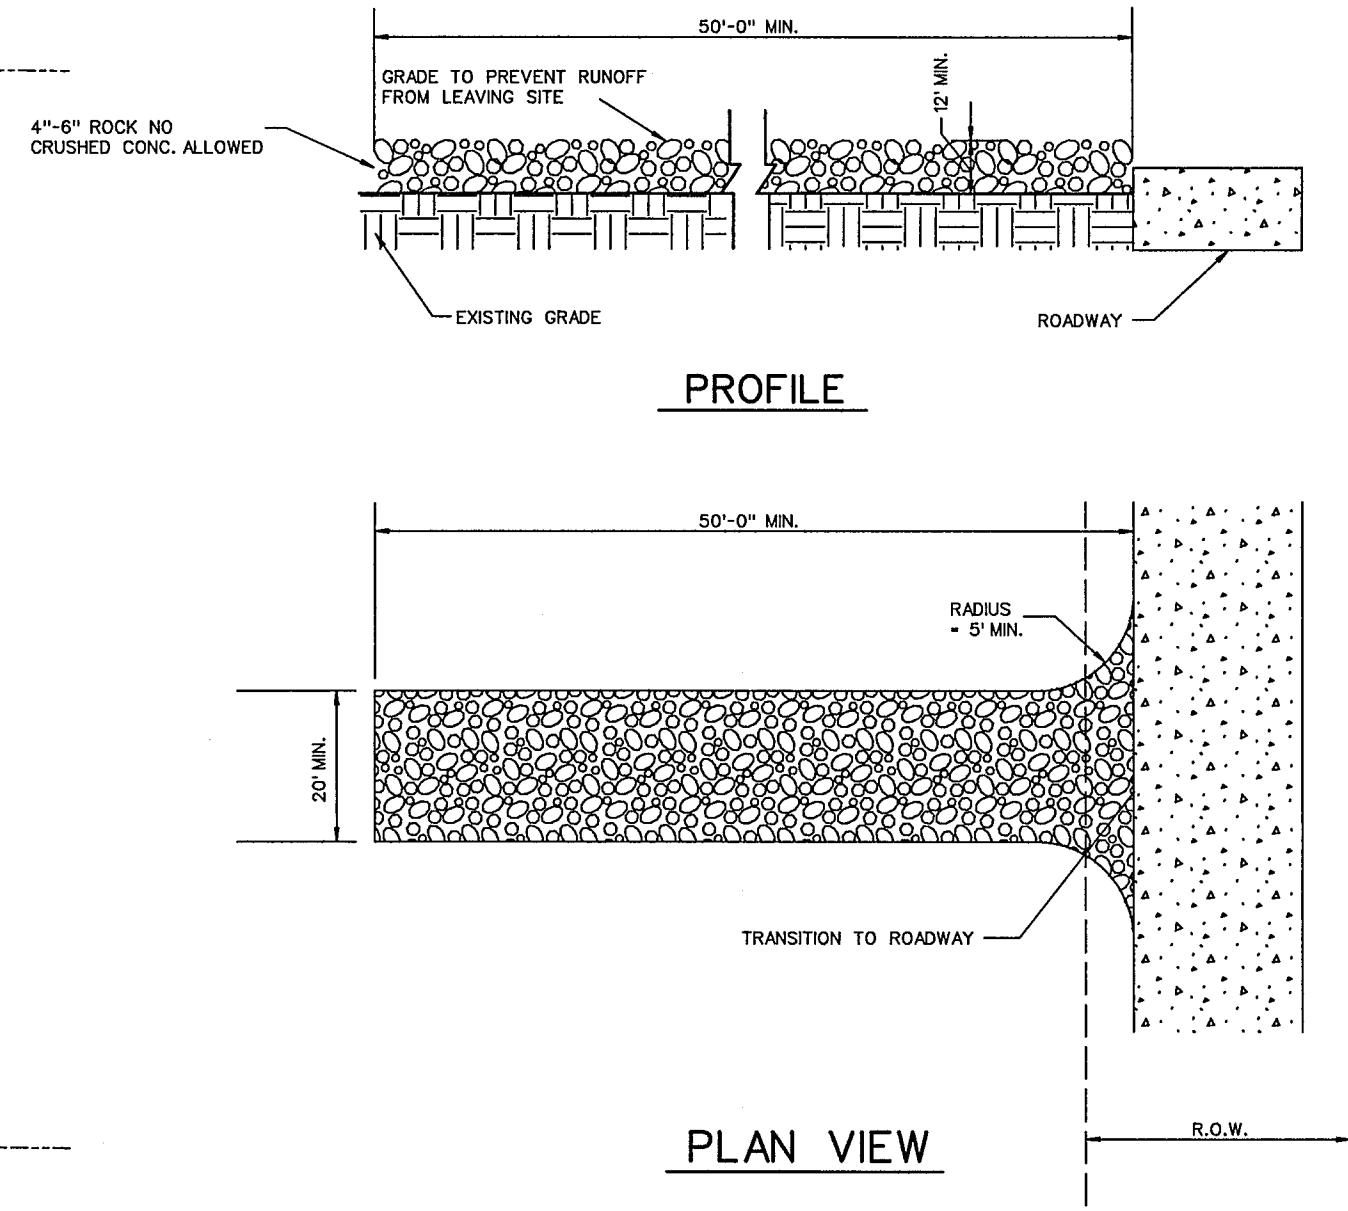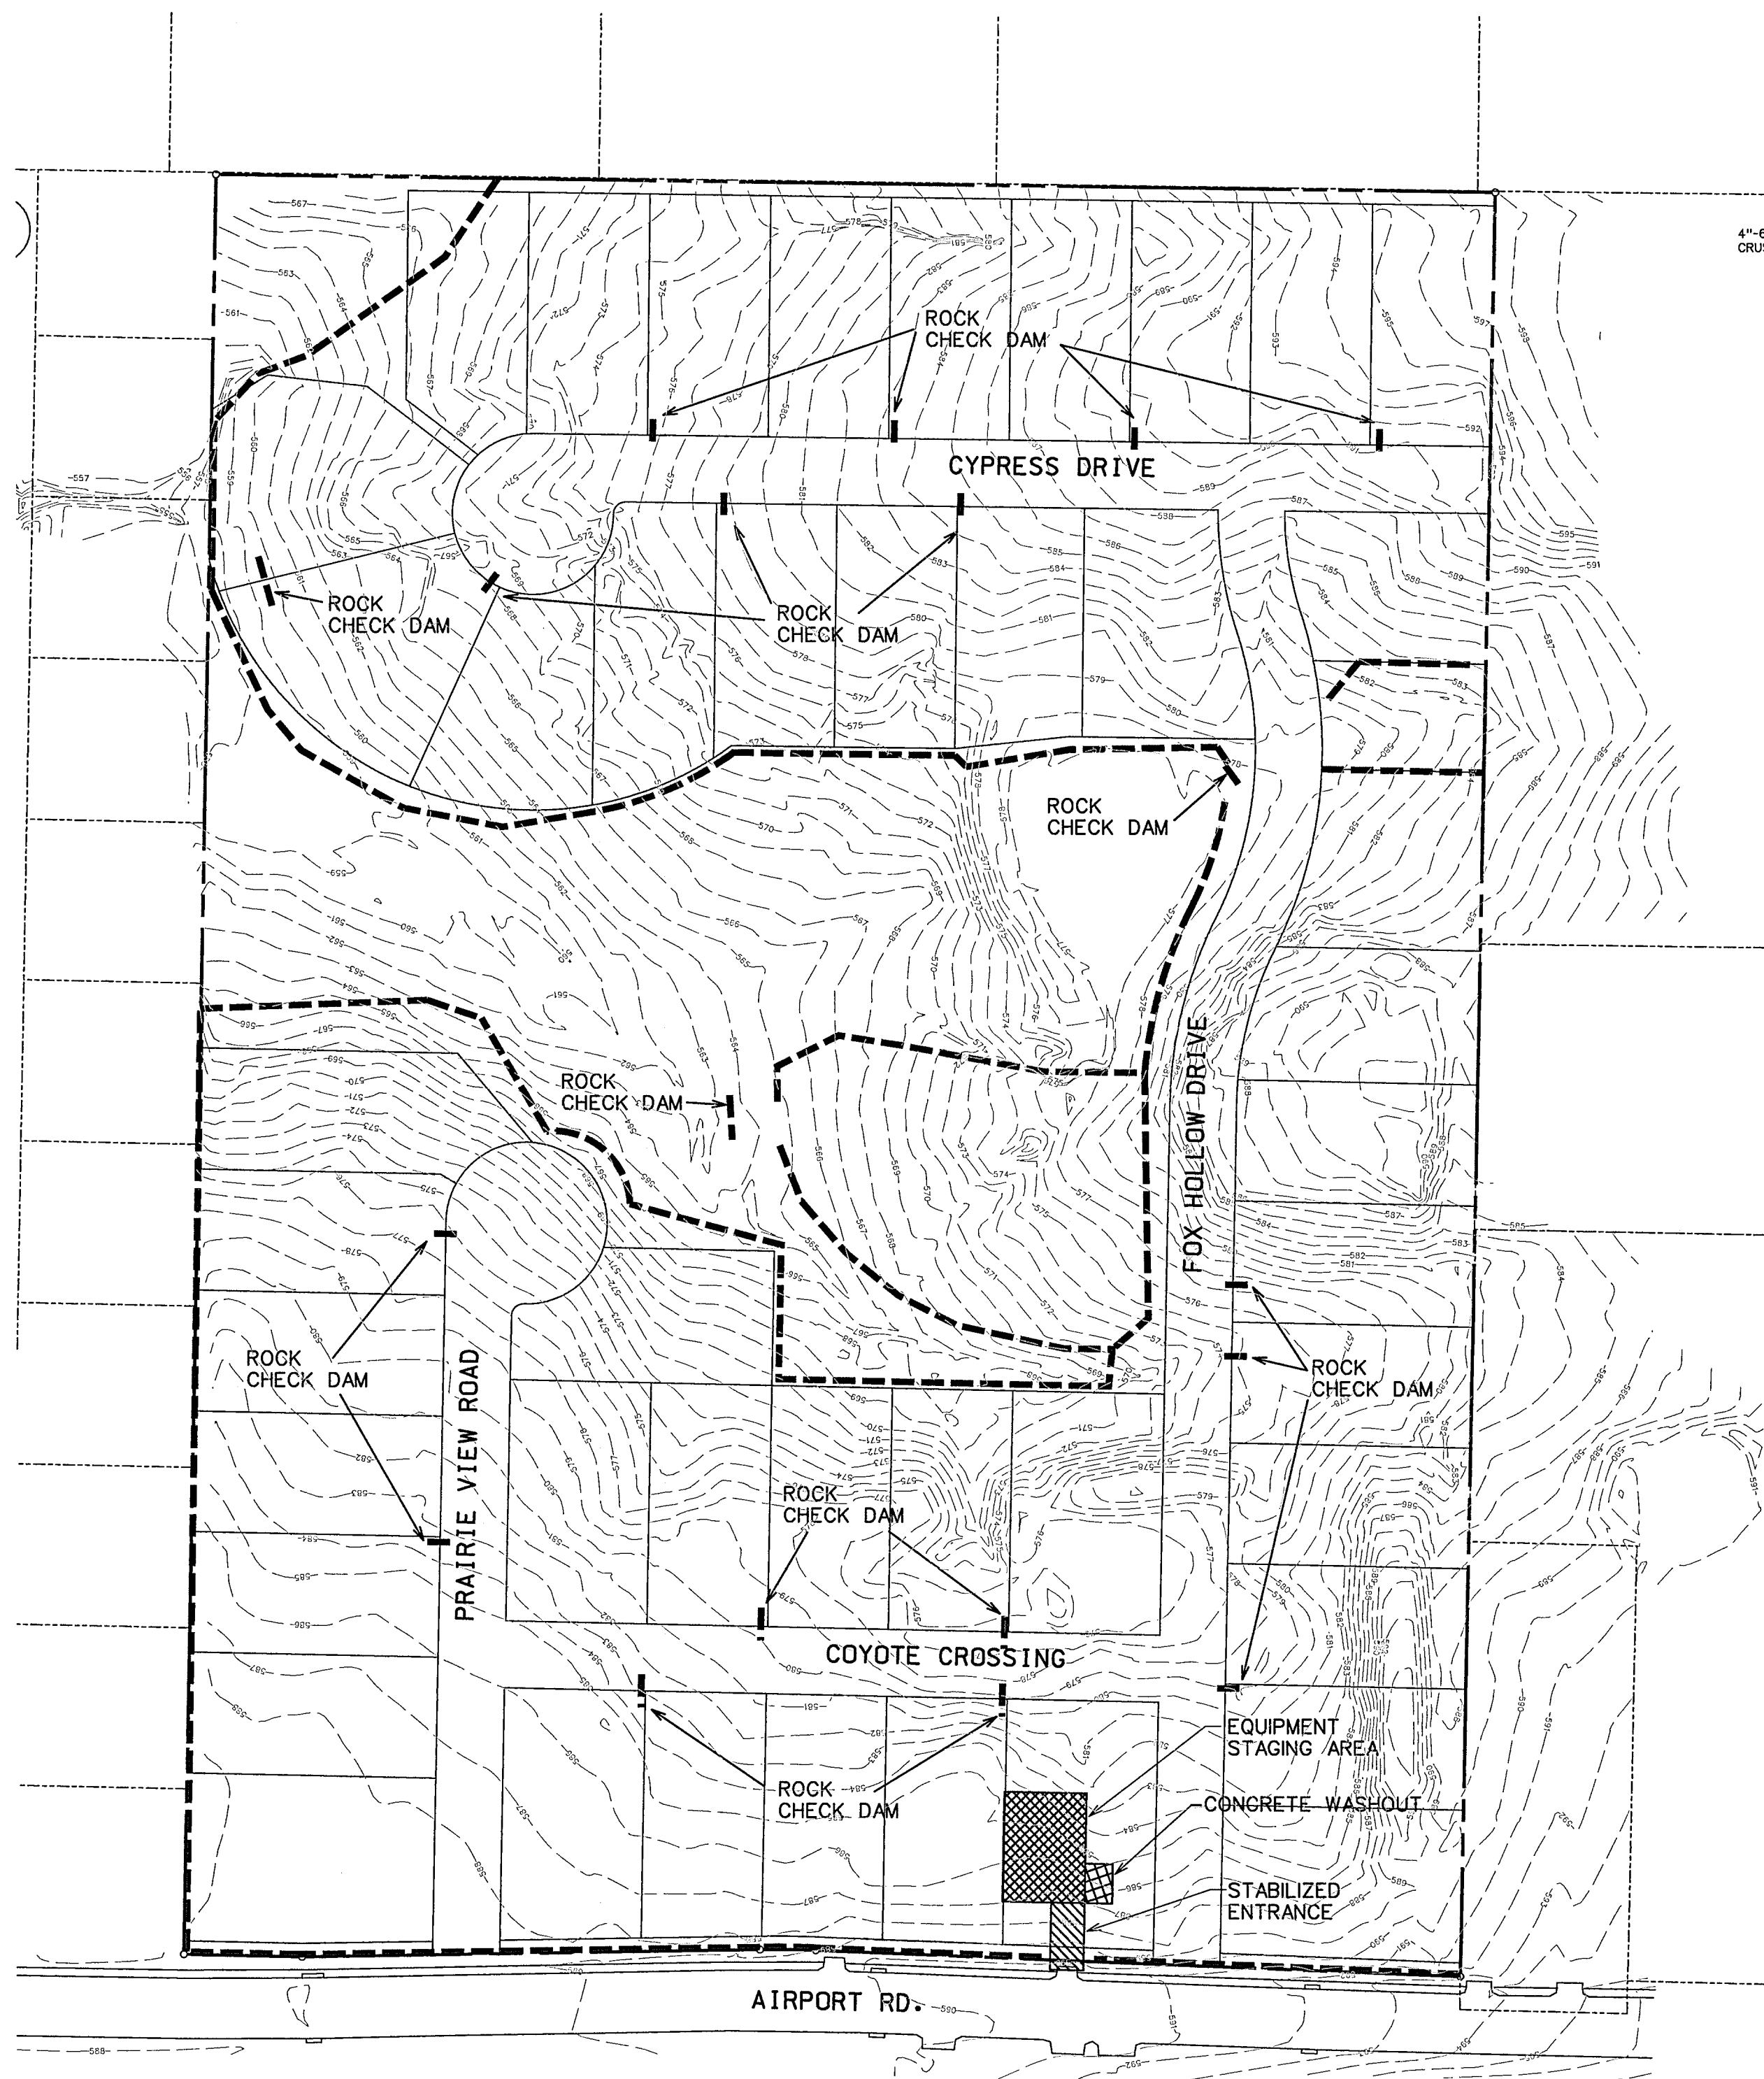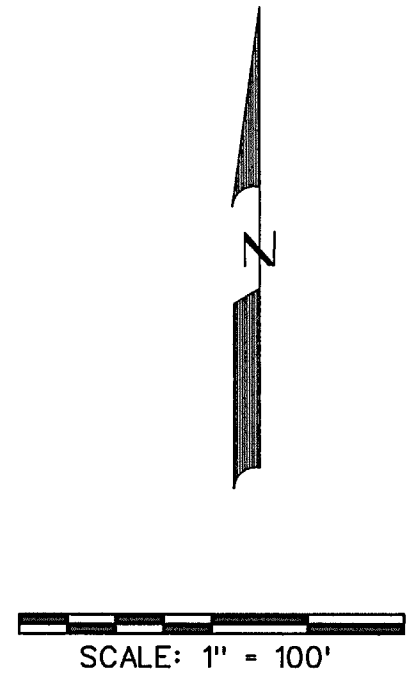

STABILIZED ENTRANCE DETAIL

- CONSTRUCTION SEQUENCE**
1. GRADING CONTRACTOR TO INSTALL TEMPORARY STABILIZED ENTRANCE.
 2. INSTALL SILT FENCE AS SHOWN, (TS-600 POLY FELT) PER C.O.G. SPECIFICATIONS.
 3. CONSTRUCT SEDIMENT BASIN
 4. PERFORM GRADING AND UTILITY CONSTRUCTION.
 5. AFTER THE INLET BOTTOMS ARE CONSTRUCTED, THE INLETS SHALL BE FILLED WITH STONE AND COVERED WITH A FILTER FABRIC (TS-600 POLY FELT OR EQUIVALENT) BY UTILITY CONTRACTOR.
 6. PRIOR TO CITY RELEASING PAVING, SOD OR SEEDED CURLEX SHALL BE INSTALLED ON SIDES AND BOTTOM OF ALL DETENTION PONDS AND ALL DETENTION PONDS MUST BE FUNCTIONING.
 7. AFTER PAVING AND COMPLETION OF INLETS, INLET FILTERS SHALL BE INSTALLED IN ALL INLETS AND MAINTAINED UNTIL RE-VEGETATION HAS BEEN COMPLETED BY PAVING CONTRACTOR.
 8. SILT FENCE SHALL REMAIN IN PLACE UNTIL RE-VEGETATION HAS BEEN COMPLETED.
 9. PAVING CONTRACTOR SHALL REMOVE TEMPORARY STABILIZED ENTRANCE.
 10. PRIOR TO CITY ACCEPTANCE THE PAVING CONTRACTOR SHALL BE RESPONSIBLE FOR REMOVING ANY MUD OR SILT WHICH COLLECTS ON THE EXISTING AND NEW PAVEMENT AND INSTALLING A 4-FOOT STRIP OF CURLEX ALONG THE EDGE OF PAVEMENT THROUGHOUT THE ENTIRE SITE.
 11. 75%-80% OF ALL DISTURBED AREA TO HAVE A MINIMUM 1" STAND OF GRASS PRIOR TO ENGINEERING ACCEPTANCE.
 12. AT TIME OF ACCEPTANCE, ALL INLET PROTECTION IS TO BE REMOVED


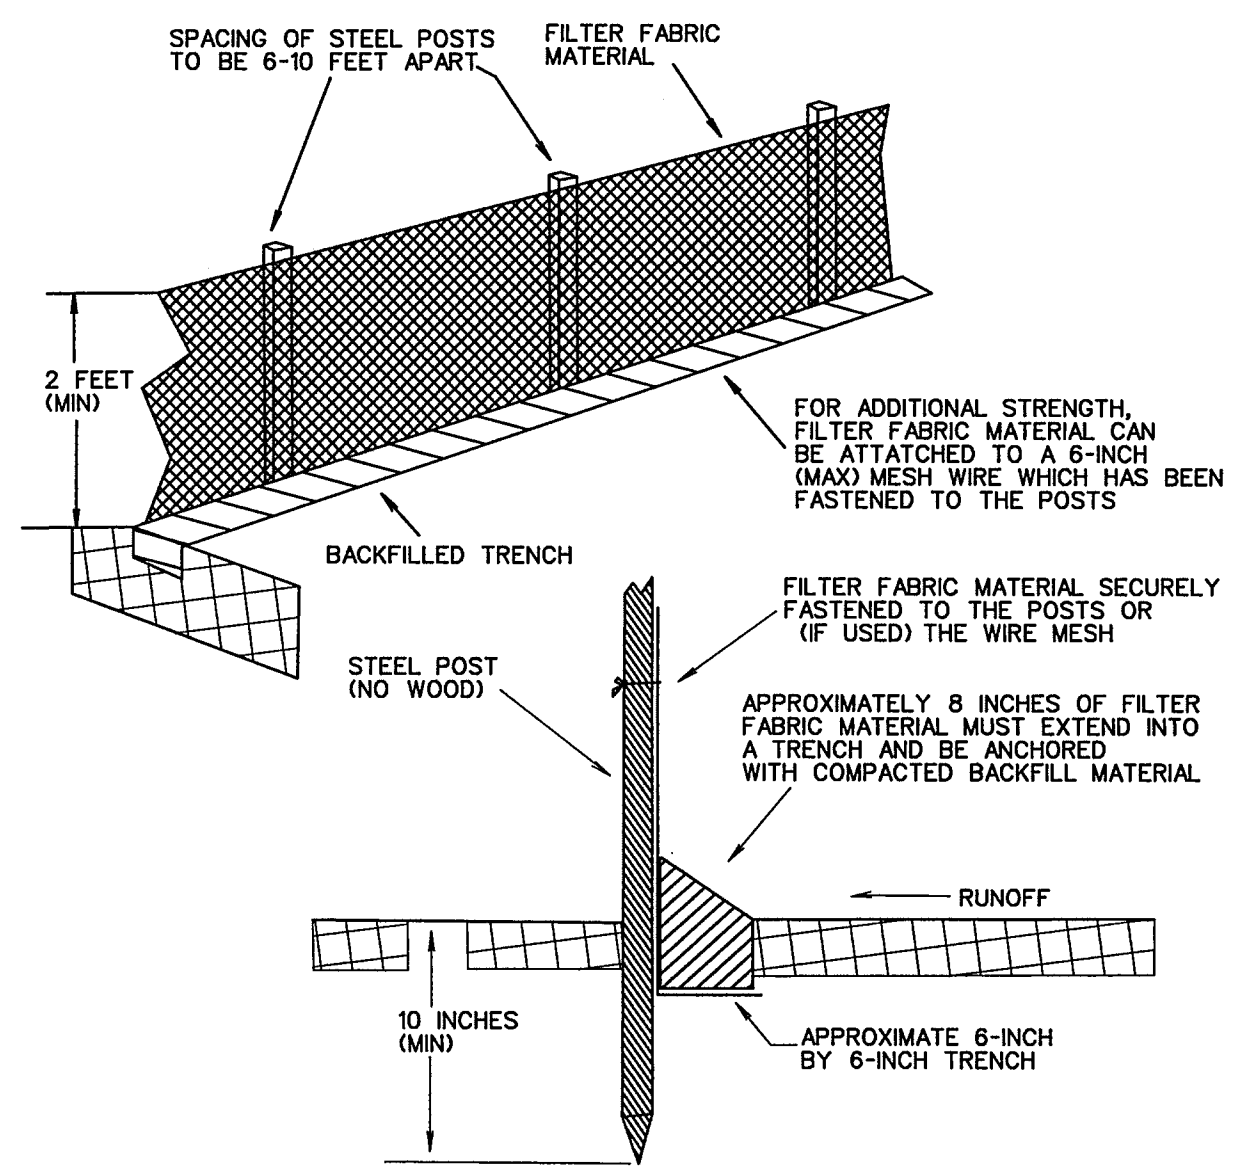


FILTER FABRIC FENCE DETAIL

- LEGEND**
- SILT FENCE (BEFORE CONSTRUCTION) - - - - -

AS-BUILT DECEMBER 2017
INFORMATION PROVIDED BY CONTRACTORS (NOT FIELD VERIFIED)

<p>CORWIN ENGINEERING, INC. 200 W. BELMONT, SUITE E ALLEN, TEXAS 75013 (972)396-1200 TBPE FIRM #5951</p>			
<p>DEVELOPMENT PLANS FOR RIDGECREST ROCKWALL, TEXAS</p>			
<p>EROSION CONTROL PLAN</p>			
DRAWN BY	DESIGNED BY	CHECKED BY	SHEET NO.
JOB NUMBER	DATE	SCALE:	18 OF 19
16021	SEPTEMBER 2016	1"=100'	

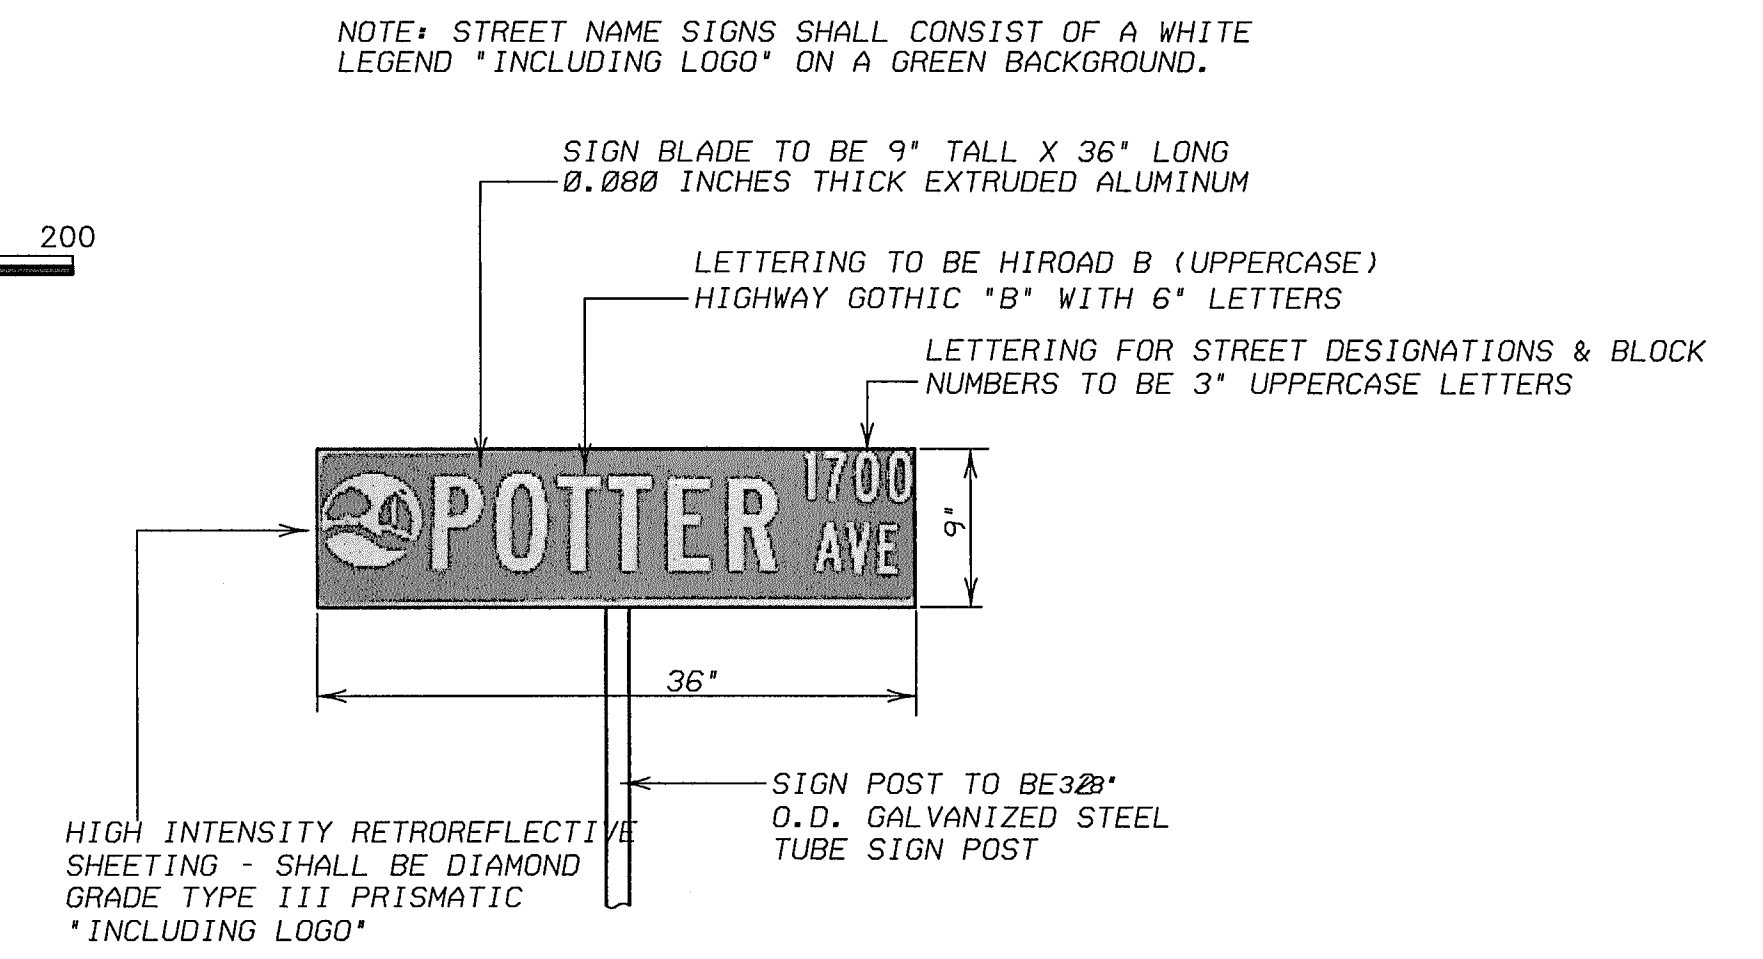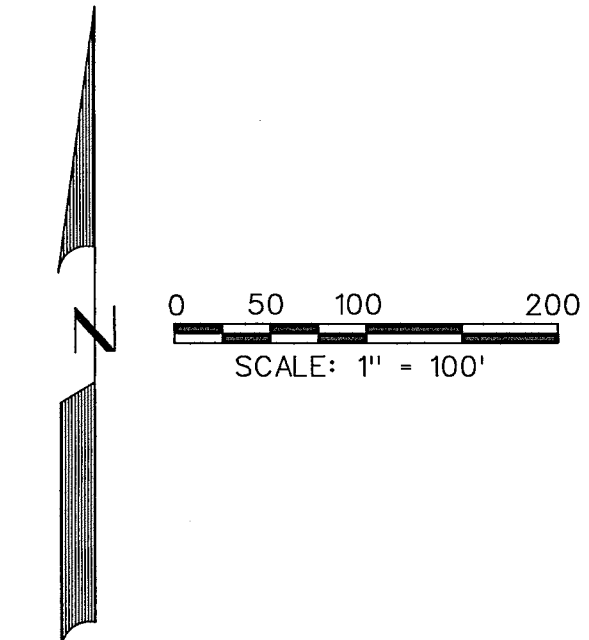

STREET SIGN DETAIL
NOT TO SCALE

STREET SIGN NOTES

- All signage installed shall comply with the current "Texas Manual on Uniform Traffic Control Devices" and the "Standard Highway Sign Designs for Texas".
- The developer shall be responsible for furnishing and installing all regulatory, warning and street name signs and sign mounts in accordance with the approved engineering plans.
- Block Numbers are required on all street name blades.
- Street Name Blades shall be nine inch (9") tall extruded aluminum. The blades shall be 0.080 inches thick.
- High Intensity Retro reflective Sheeting for Street, Regulatory, and Warning Signs - shall be high intensity diamond grade type III prismatic.
- The Lettering for the street blades shall be HIROAD B with all uppercase fonts. "Highway Gothic B" with six-inch letters. Letters for abbreviated street designations shall be three inches (3") tall with all uppercase fonts (i.e., LN, PKWY, CT, etc.). Block numbers shall be three-inch (3") tall.
- The street sign background shall be green and the legend shall be white.
- The street sign blade must incorporate the current City of Rockwall logo.
- For a street with a cul-de-sac end, a standard W 14-2a shall be mounted over the street name blade.
- Sign posts shall be 2 3/8" O.D. galvanized steel tube sign post with a galvanized finish.
- Sign clamps and brackets shall be high strength aluminum.
- For a street with a cul-de-sac end, a standard W 14-2a shall be mounted over the street name blade, if the cul-de-sac is not clearly visible from the adjoining roadway, or is located in excess of 400 linear feet from the adjoining roadway.

- LEGEND**
- STREET LIGHT
 - STOP SIGN
 - STREET NAME BLADE
 - 30 MPH SPEED LIMIT SIGN

AS-BUILT DECEMBER 2017
INFORMATION PROVIDED
BY CONTRACTORS
(NOT FIELD VERIFIED)

CORWIN ENGINEERING, INC. 200 W. BELMONT, SUITE E ALLEN, TEXAS 75013 (972)396-1200 TBPE FIRM #5951			
DEVELOPMENT PLANS FOR RIDGECREST ROCKWALL, TEXAS			
SIGN AND LIGHT PLAN			
DRAWN BY	DESIGNED BY	CHECKED BY	SHEET NO.
JOB NUMBER 16021	DATE SEPTEMBER 2016	SCALE: 1"=100'	19 OF 19