




DRAINAGE AREA	TOTAL AREA (AC)	LAND USE	C VALUE	C*A	Tc (MIN)	INTENSITY 5 YR (IN/HR)	DISCHARGE 5 YR (CFS)	INTENSITY 25 YR (IN/HR)	DISCHARGE 25 YR (CFS)	INTENSITY 100 YR (IN/HR)	DISCHARGE 100 YR (CFS)	NOTES
A	3.32	CHURCH	0.80	2.66	10	5.85	15.54	7.59	20.16	9.22	24.49	
B	0.78	RES	0.50	0.39	5	7.19	2.80	9.19	3.58	11.10	4.33	
C	14.59	RES	0.50	7.30	15	4.97	36.26	6.51	47.49	7.95	58.00	
D	2.11	CHURCH	0.80	1.69	10	5.85	9.87	7.59	12.81	9.22	15.56	
E	8.43	RES	0.50	4.22	15	4.97	20.95	6.51	27.44	7.95	33.51	
A, B, C, D, & E	29.23	MIXED	0.56	16.26	15	4.97	80.81	6.51	105.85	7.95	129.27	

RECORD DOCUMENT


This Record Document (As Built) has been prepared based on information provided by others. The Engineer has not verified the accuracy and/or completeness of this information and shall not be responsible for any errors or omissions which may be incorporated herein as a result.

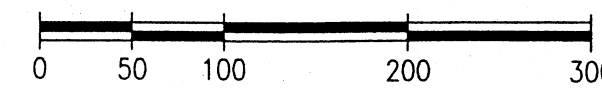

Graphic Scale In Feet



J. Stanton
2/13/2012

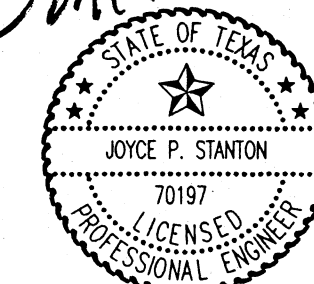

DI SCIULLO-TERRY, STANTON & ASSOCIATES, INC.
ENGINEERING AND SURVEYING
401-A WEST ABRAM STREET • ARLINGTON, TEXAS 76010
(817) 275-3351
ESTABLISHED 1953 FIRM NUMBER F-615

ST A

DRAINAGE AREA MAP

LOT 22R
SKYVIEW COUNTRY ESTATES No. 3
ROCKWALL COUNTY, TEXAS

DESIGNED: JPS	DATE: NOVEMBER, 2011	SHEET: 7
DRAWN: CM, JCS	SCALE: 1"=100'	
CHECKED: JPS	PROJECT No.: E-1030	