

- IRF IRON ROD FOUND
- CRF CAPPED IRON ROD FOUND
- IPF IRON PIPE FOUND
- IRS 1/2" IRON ROD SET WITH "DISCULLO & TERRY" PLASTIC CAP
- PRCT PLAT RECORDS OF ROCKWALL COUNTY, TEXAS
- DRCT DEED RECORDS OF ROCKWALL COUNTY, TEXAS
- OHE OVERHEAD ELECTRIC LINE
- OHT OVERHEAD TELEPHONE LINE
- OHTV OVERHEAD CABLE TELEVISION LINE
- UGE UNDERGROUND ELECTRIC LINE
- BC BACK OF CURB
- TC TOP OF CURB
- T.O.P. TOP OF PAVEMENT
- C&G CURB & GUTTER
- ASPH ASPHALT
- CONC CONCRETE
- W WATER LINE
- SS SANITARY SEWER MAIN

- LEGEND**
- RCP REINFORCED CONCRETE PIPE
  - CMF CORRUGATED METAL PIPE
  - FL FLOWLINE
  - P.L. PROPERTY LINE
  - GAS MANHOLE
  - GAS METER (GM)
  - WATER METER (WM)
  - TELEPHONE TERMINAL BOX
  - LIGHT POLE (LP)
  - GROUND LIGHT (GL)
  - POWER POLE (PP) / ELECTRIC RISER (LER)
  - UNDERGROUND TELEPHONE MARKER (UTM)
  - UNDERGROUND FIBER OPTIC CABLE MARKER (UFM)
  - UNDERGROUND GAS MARKER (UGM)
  - SANITARY SEWER MANHOLE (SSMH)
  - CLEANOUT (SSCO)
  - WATER VALVE (WV)
  - FIRE HYDRANT (FH)
  - IRRIGATION CONTROL VALVE (ICV)
  - SPRINKLER HEAD (SH)
  - SIGN
  - MAIL BOX (MB)
  - AIR CONDITIONER (AC)
  - CREPE MYRTLE
  - BRADFORD PEAR
  - PAVEMENT

**NOTES:**

Coordinates and bearings recited hereon are referenced to the NAD83 State Plane Coordinate System, Texas North Central Zone 4202 (reference line ~ monumented east right-of-way line of Breezy Hill Lane along subject property N00°44'35"W).

Location of underground utilities is approximate. Locations and sizes shown are taken from plans and are adjusted to fit visible objects shown. All underground utilities must be exposed prior to construction to verify location and size.


Only trees 4" in trunk diameter and larger are shown.

\* Future right-of-way & pavement lines shown plotted hereon are according to TXDOT Draft Preferred Alignment & Access Plan for FM 552 (CS: 1017-01-015 ~ From SH 205 to FM 1141) dated June 2011.

Easements shown plotted hereon are according to plats for subject & adjoining properties. No additional easement research was performed.

**BENCH MARK:**

BM No. 1 (Set): North rim of sanitary sewer manhole located on north side of FM Road 552, approximately 220 feet west of drive entrance to Ridgeview Church and approximately 95 feet north of west intersection of Windy Lane.

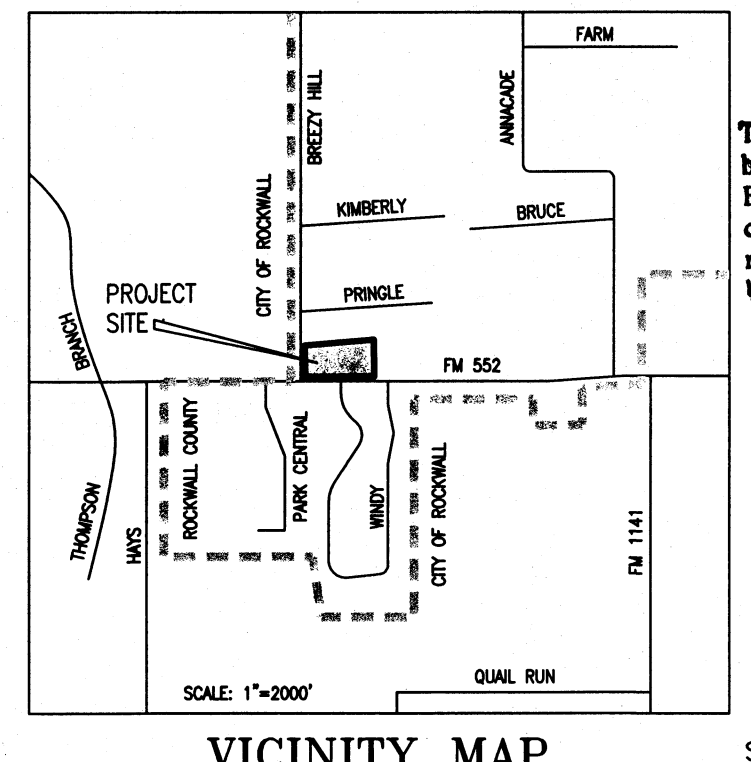

**RECORD DOCUMENT**

This Record Document (As Built) has been prepared based on information provided by others. The Engineer has not verified the accuracy and/or completeness of this information and shall not be responsible for any errors or omissions which may be incorporated herein as a result.

**TOPOGRAPHIC SURVEY**

**RIDGEVIEW BAPTIST CHURCH**

1362 E. F.M. NO. 552

ROCKWALL COUNTY, TEXAS

JOHN SIMMONS SURVEY ~ ABSTRACT NO. 190

DATE: JULY 2011 SCALE: 1"=40' FILE: P:\GHLA\RIDGEVIEW CHURCH-ROCKWALL TOPO

DI SCIULLO-TERRY, STANTON & ASSOCIATES, INC.

ENGINEERING AND SURVEYING

FIRM #615 ESTABLISHED, 1953

401-A WEST ABRAM STREET \* P.O. BOX 506

ARLINGTON, TEXAS 76010 \* 817-275-3361

©DISCIULLO-TERRY, STANTON & ASSOCIATES, INC. 2011

T-490