




WASTEWATER MANHOLE PRECAST		North Central Texas Council of Governments	STANDARD SPECIFICATION REFERENCE 6.7
DATE NOV. '96	STANDARD DRAWING NO. 5020		

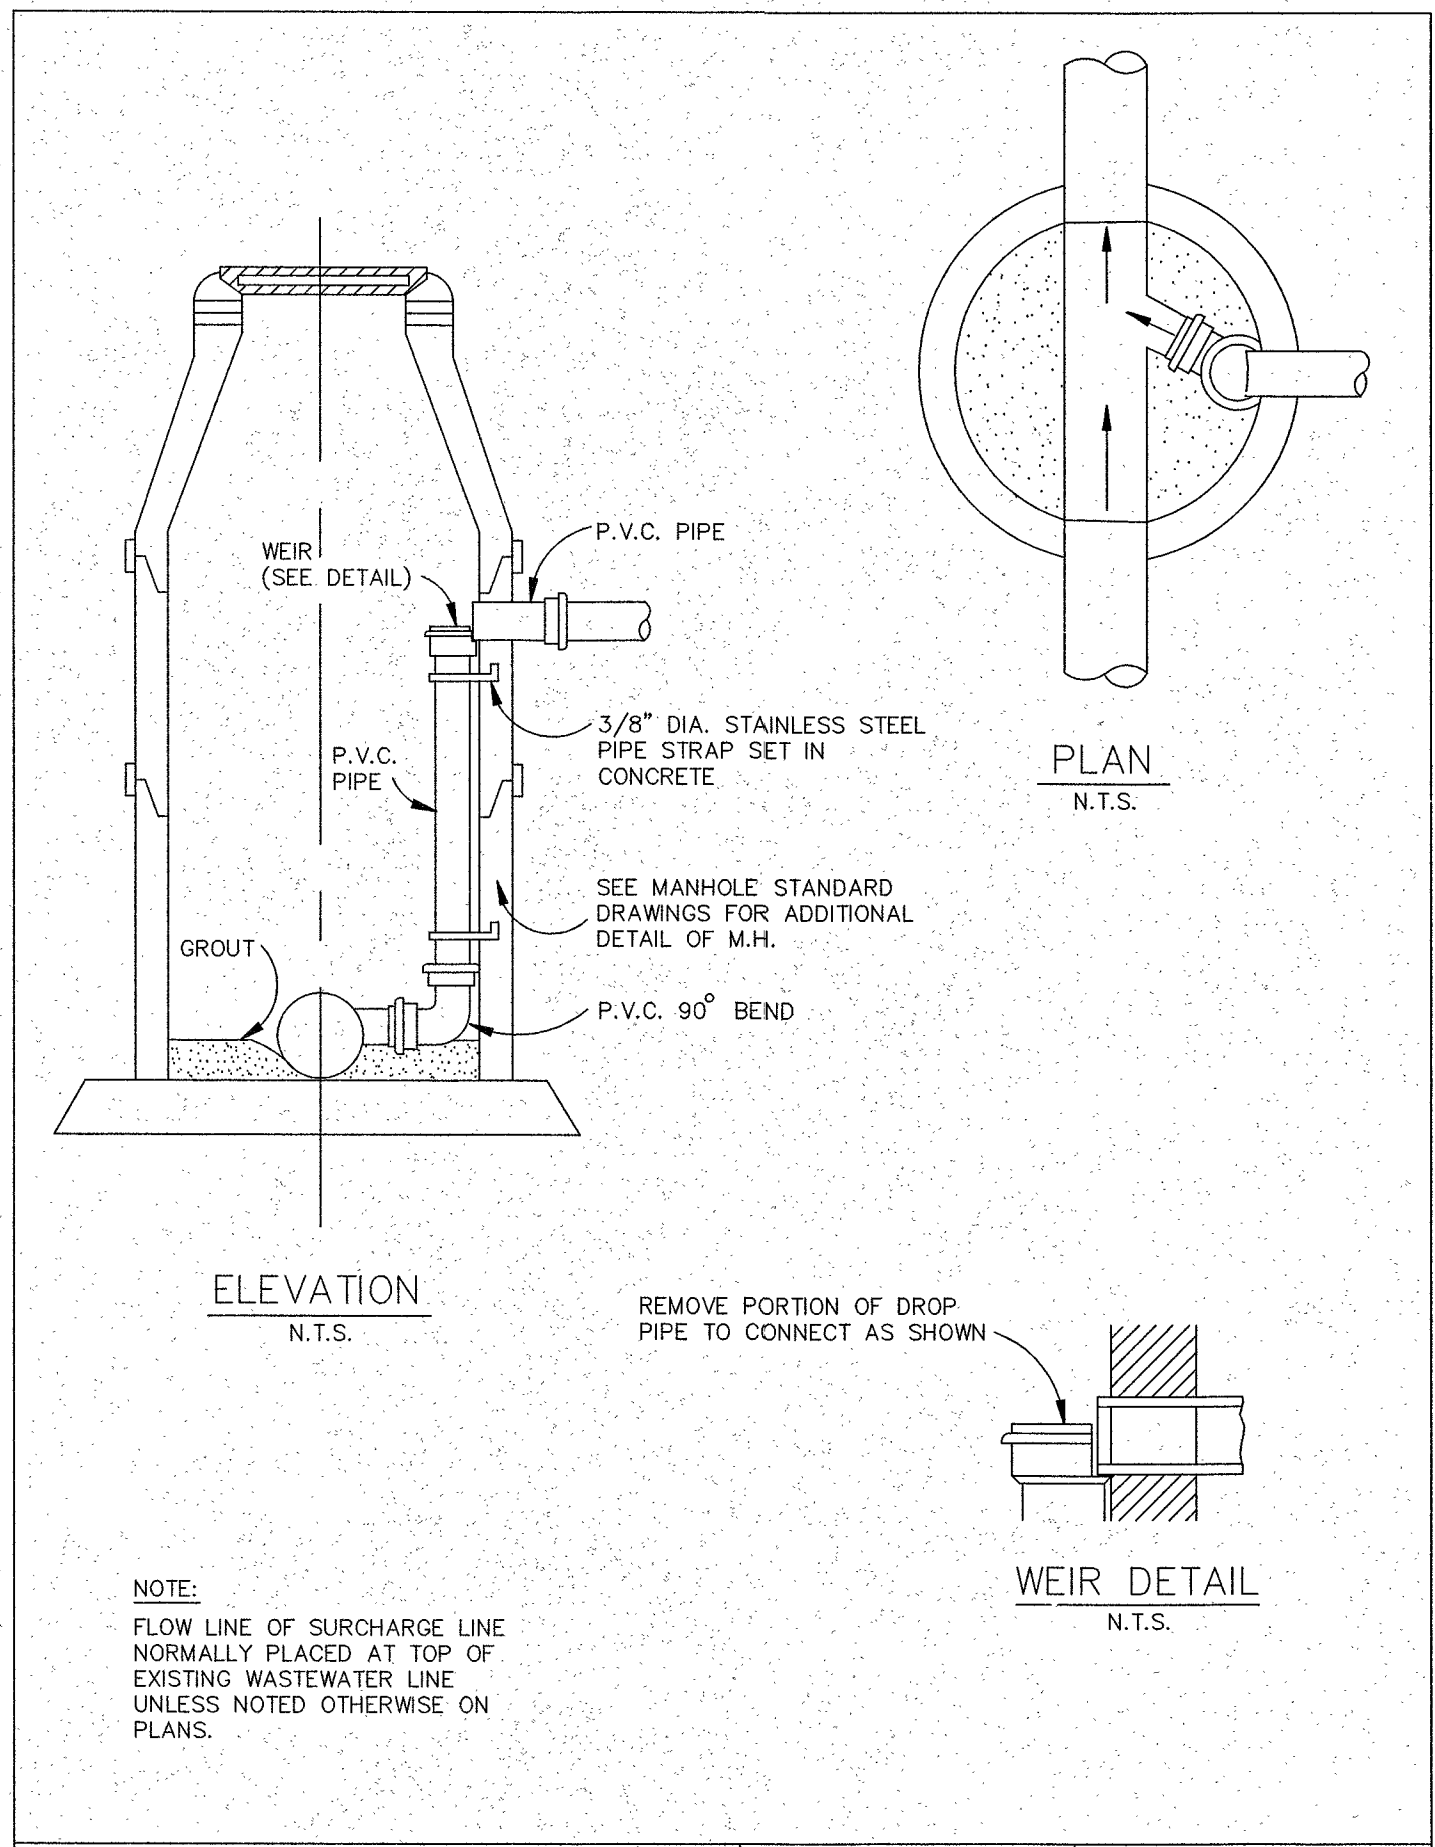


WASTEWATER MANHOLE INSIDE DROP CONNECTION		North Central Texas Council of Governments	STANDARD SPECIFICATION REFERENCE 6.7
DATE NOV. '96	STANDARD DRAWING NO. 5080		

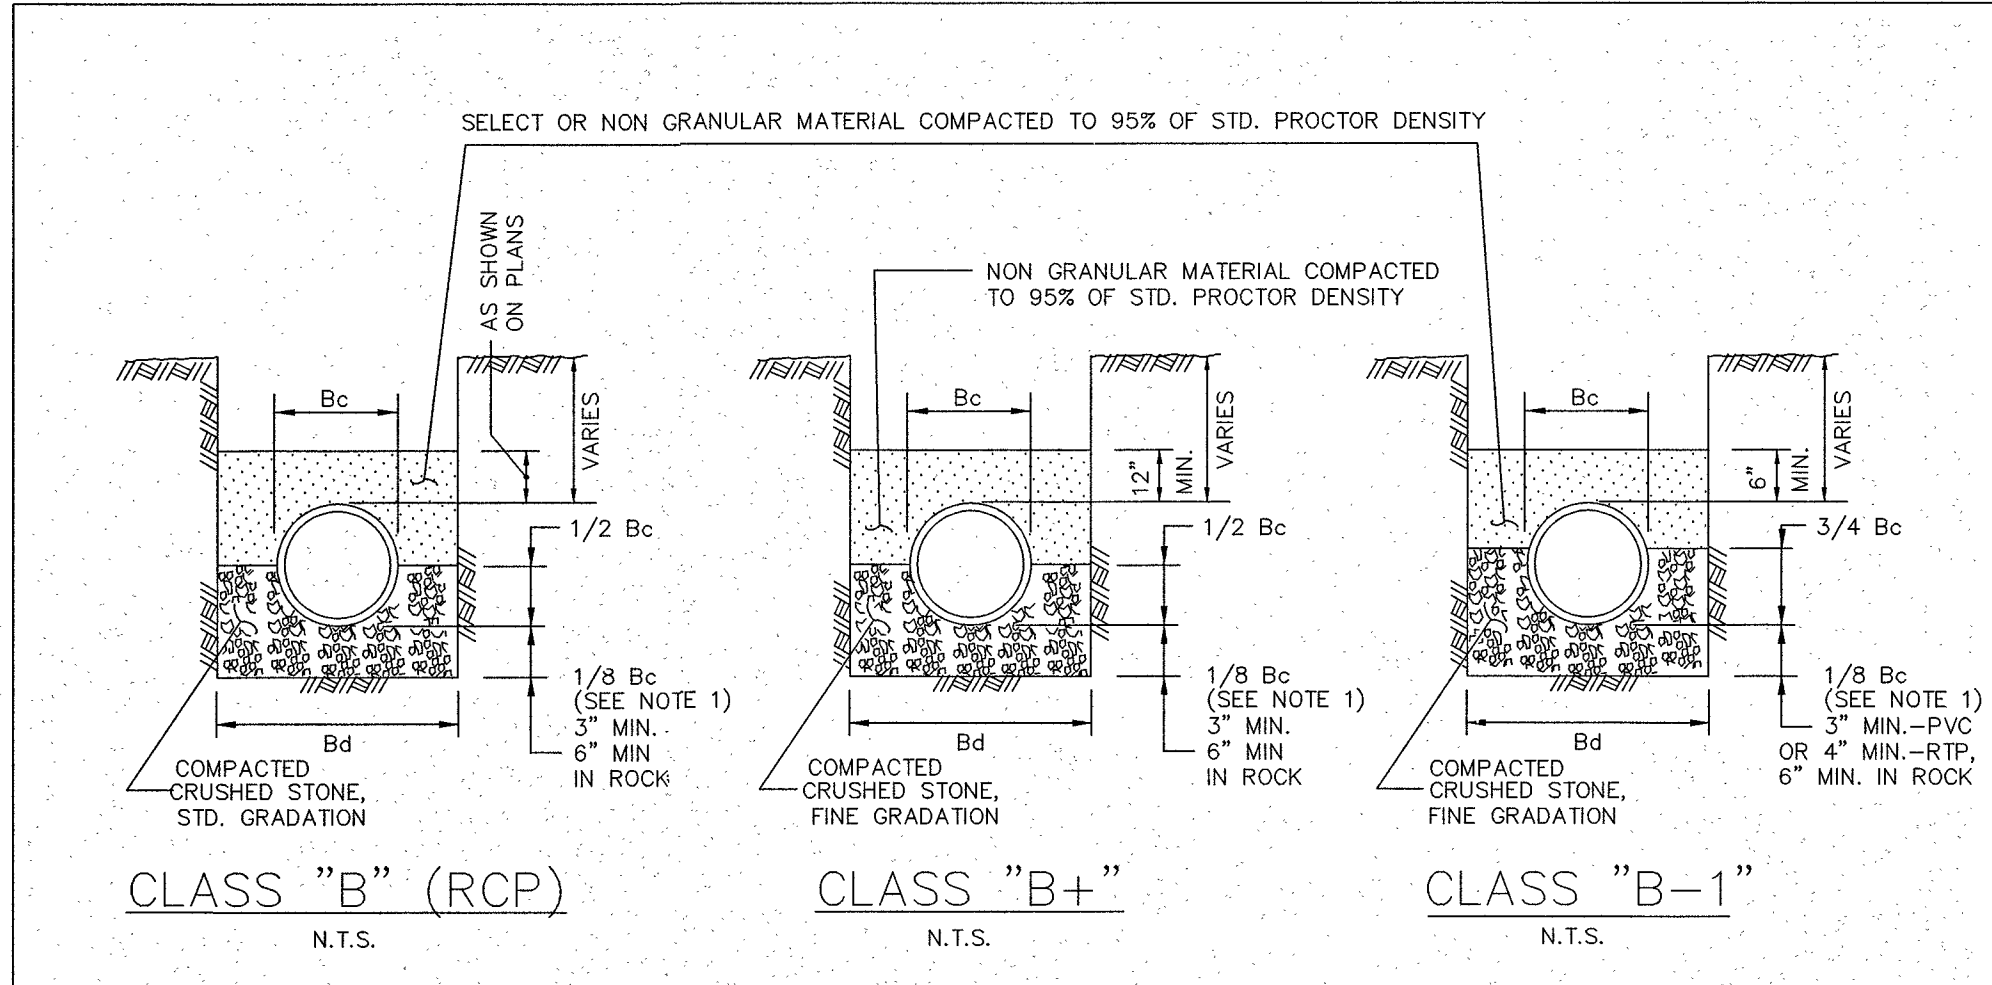


EMBEDMENT CLASS "B", "B+", & "B-1"		North Central Texas Council of Governments	STANDARD SPECIFICATION REFERENCE 6.2
DATE NOV. '96	STANDARD DRAWING NO. 3020	CITY OF ROCKWALL MODIFIED AUGUST 2003	

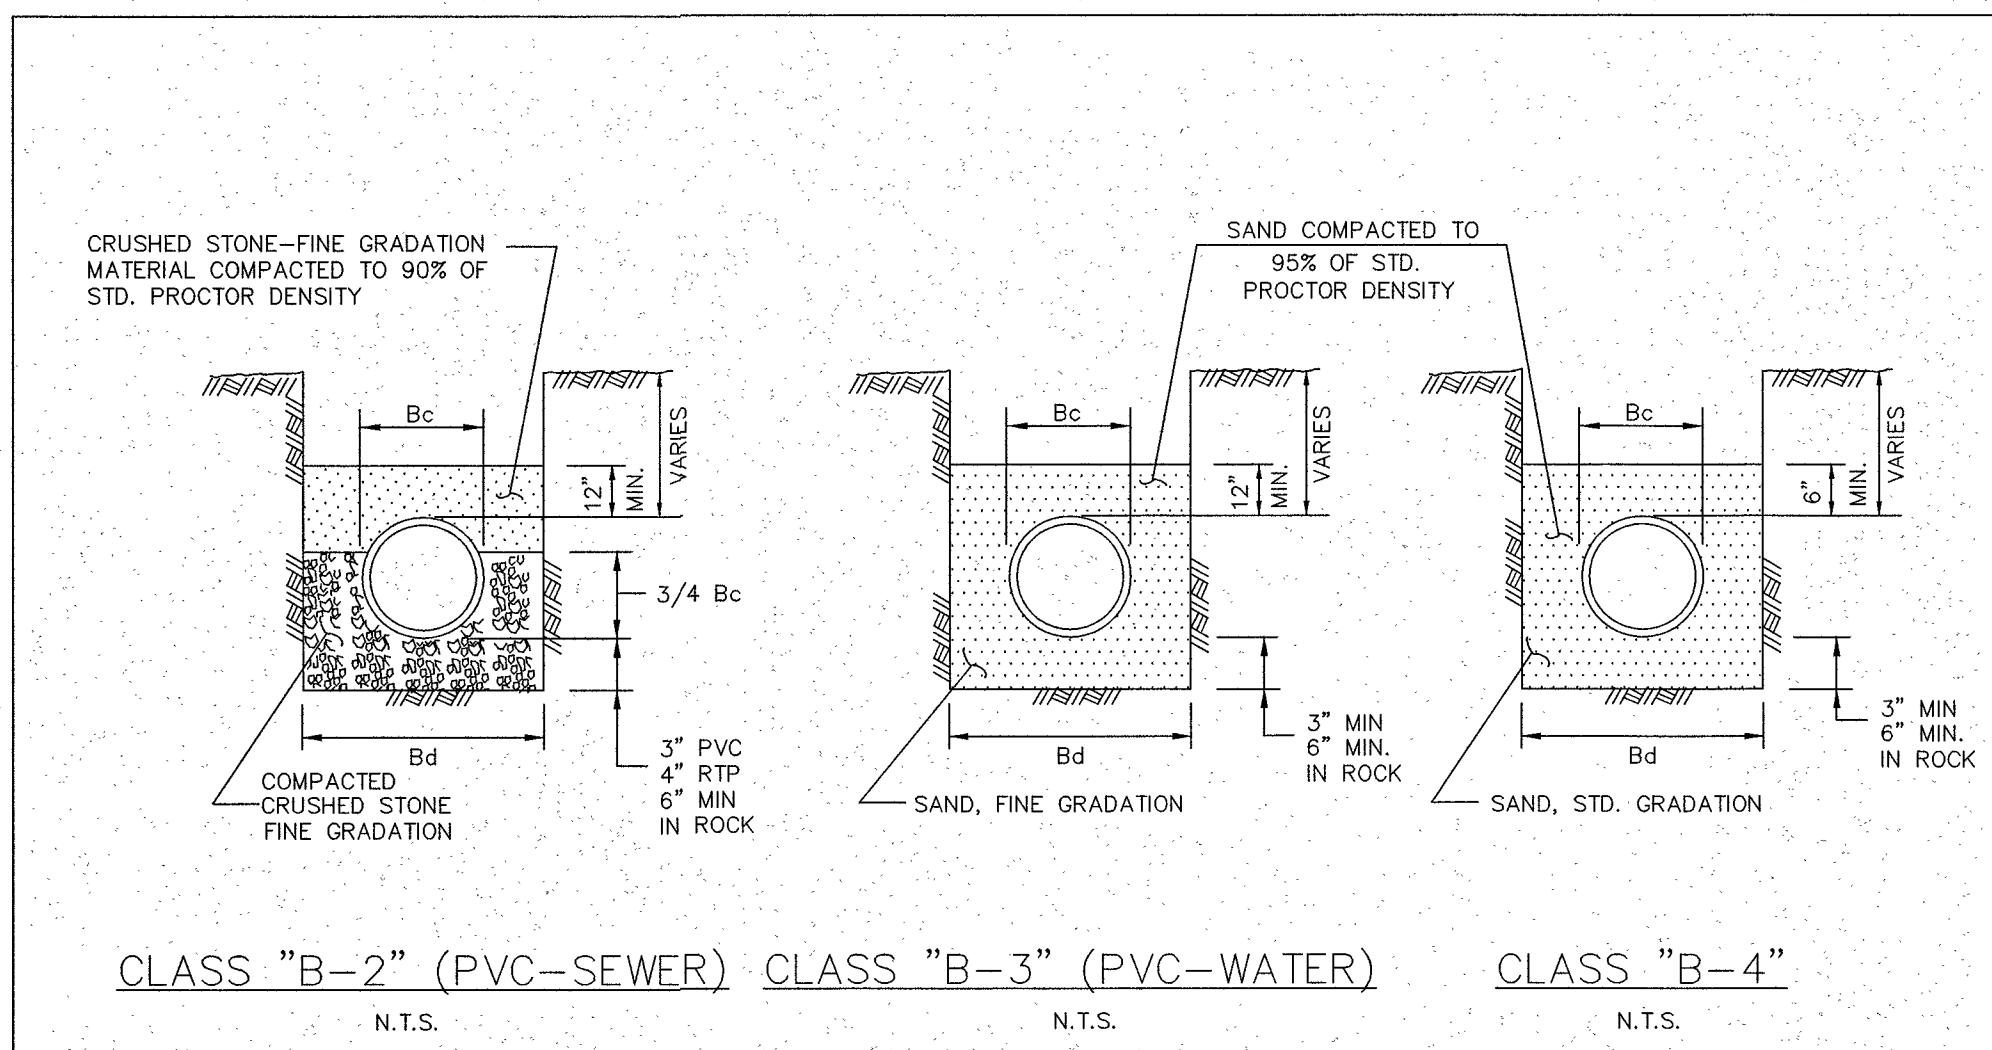

EMBEDMENT CLASS "B-2", "B-3", & "B-4"		North Central Texas Council of Governments	STANDARD SPECIFICATION REFERENCE 6.2
DATE NOV. '96	STANDARD DRAWING NO. 3030	CITY OF ROCKWALL MODIFIED AUGUST 2003	

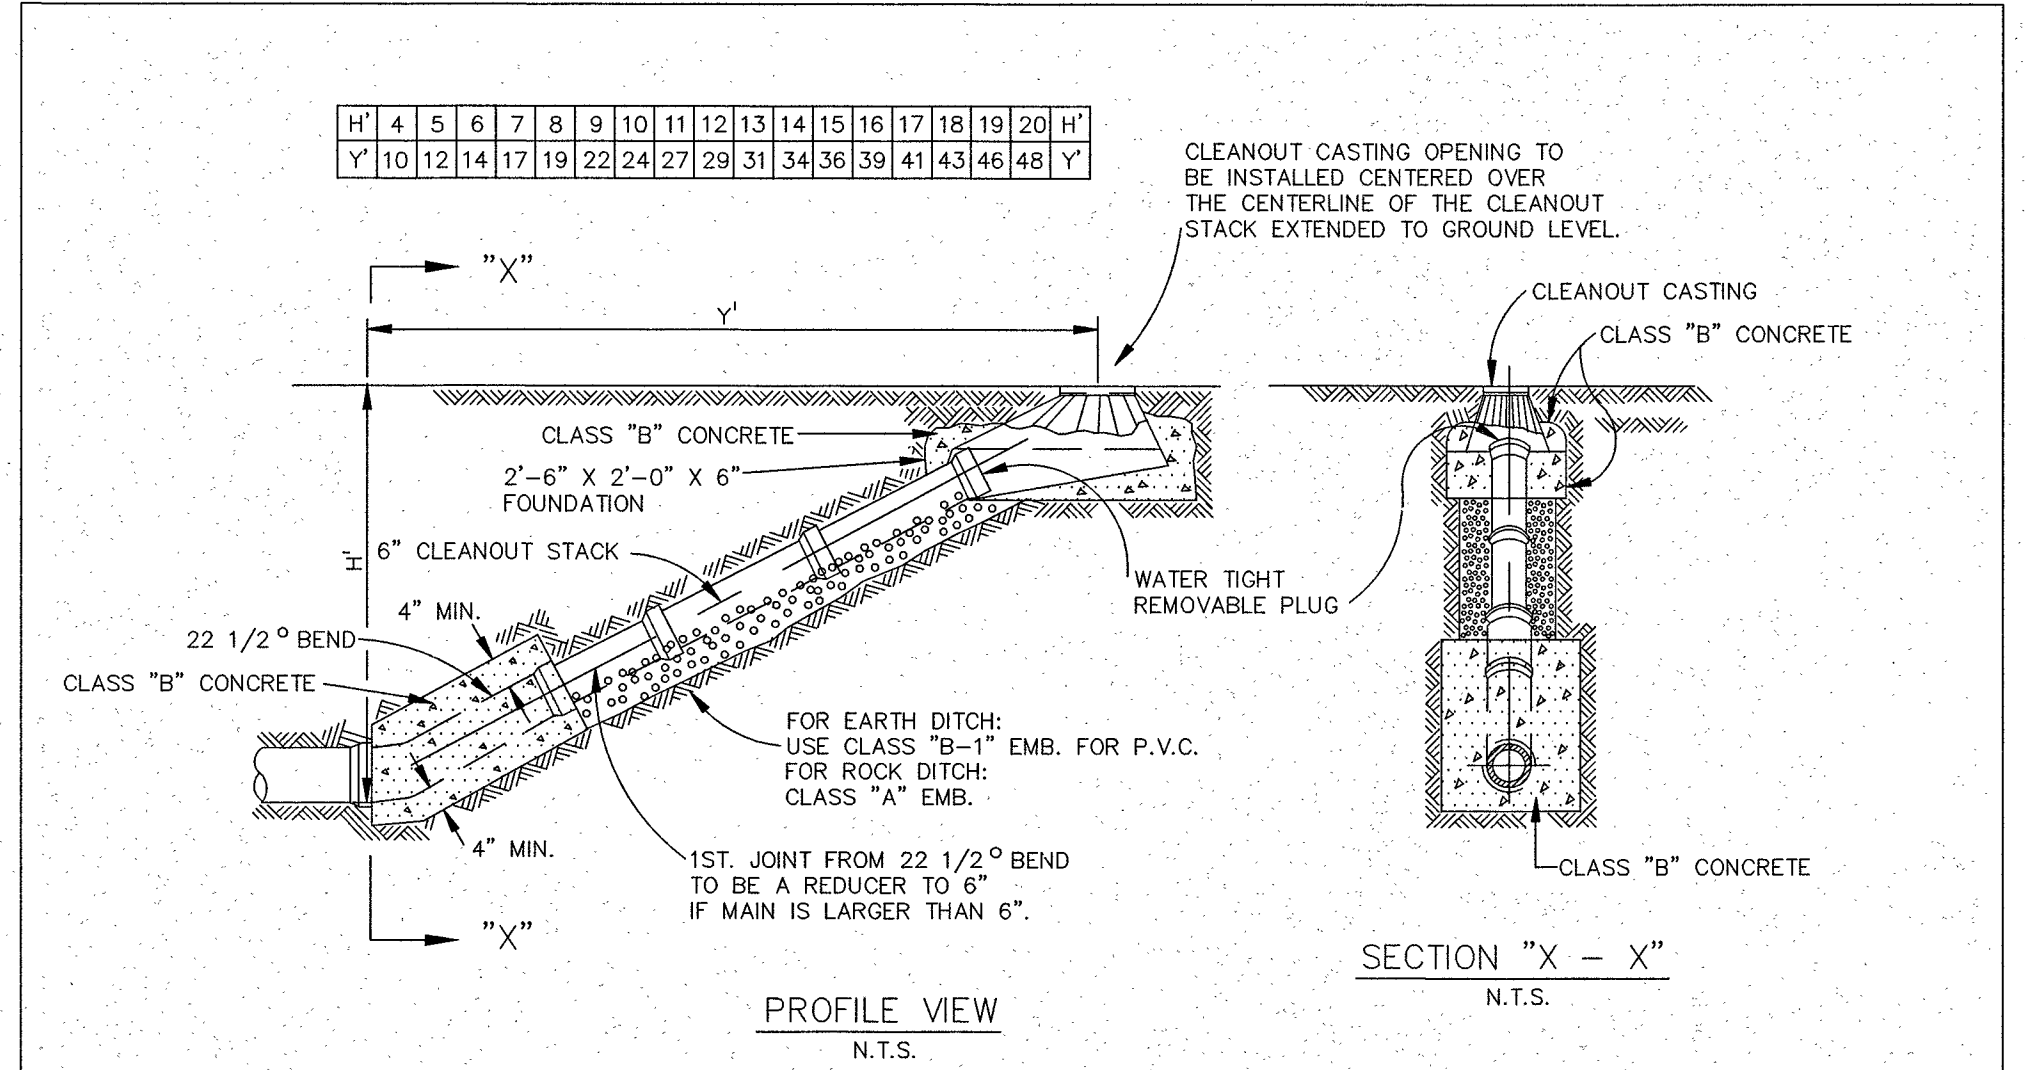

WASTEWATER MAIN CLEANOUT		North Central Texas Council of Governments	STANDARD SPECIFICATION REFERENCE 6.7
DATE NOV. '96	STANDARD DRAWING NO. 5110	CITY OF ROCKWALL MODIFIED AUGUST 2003	

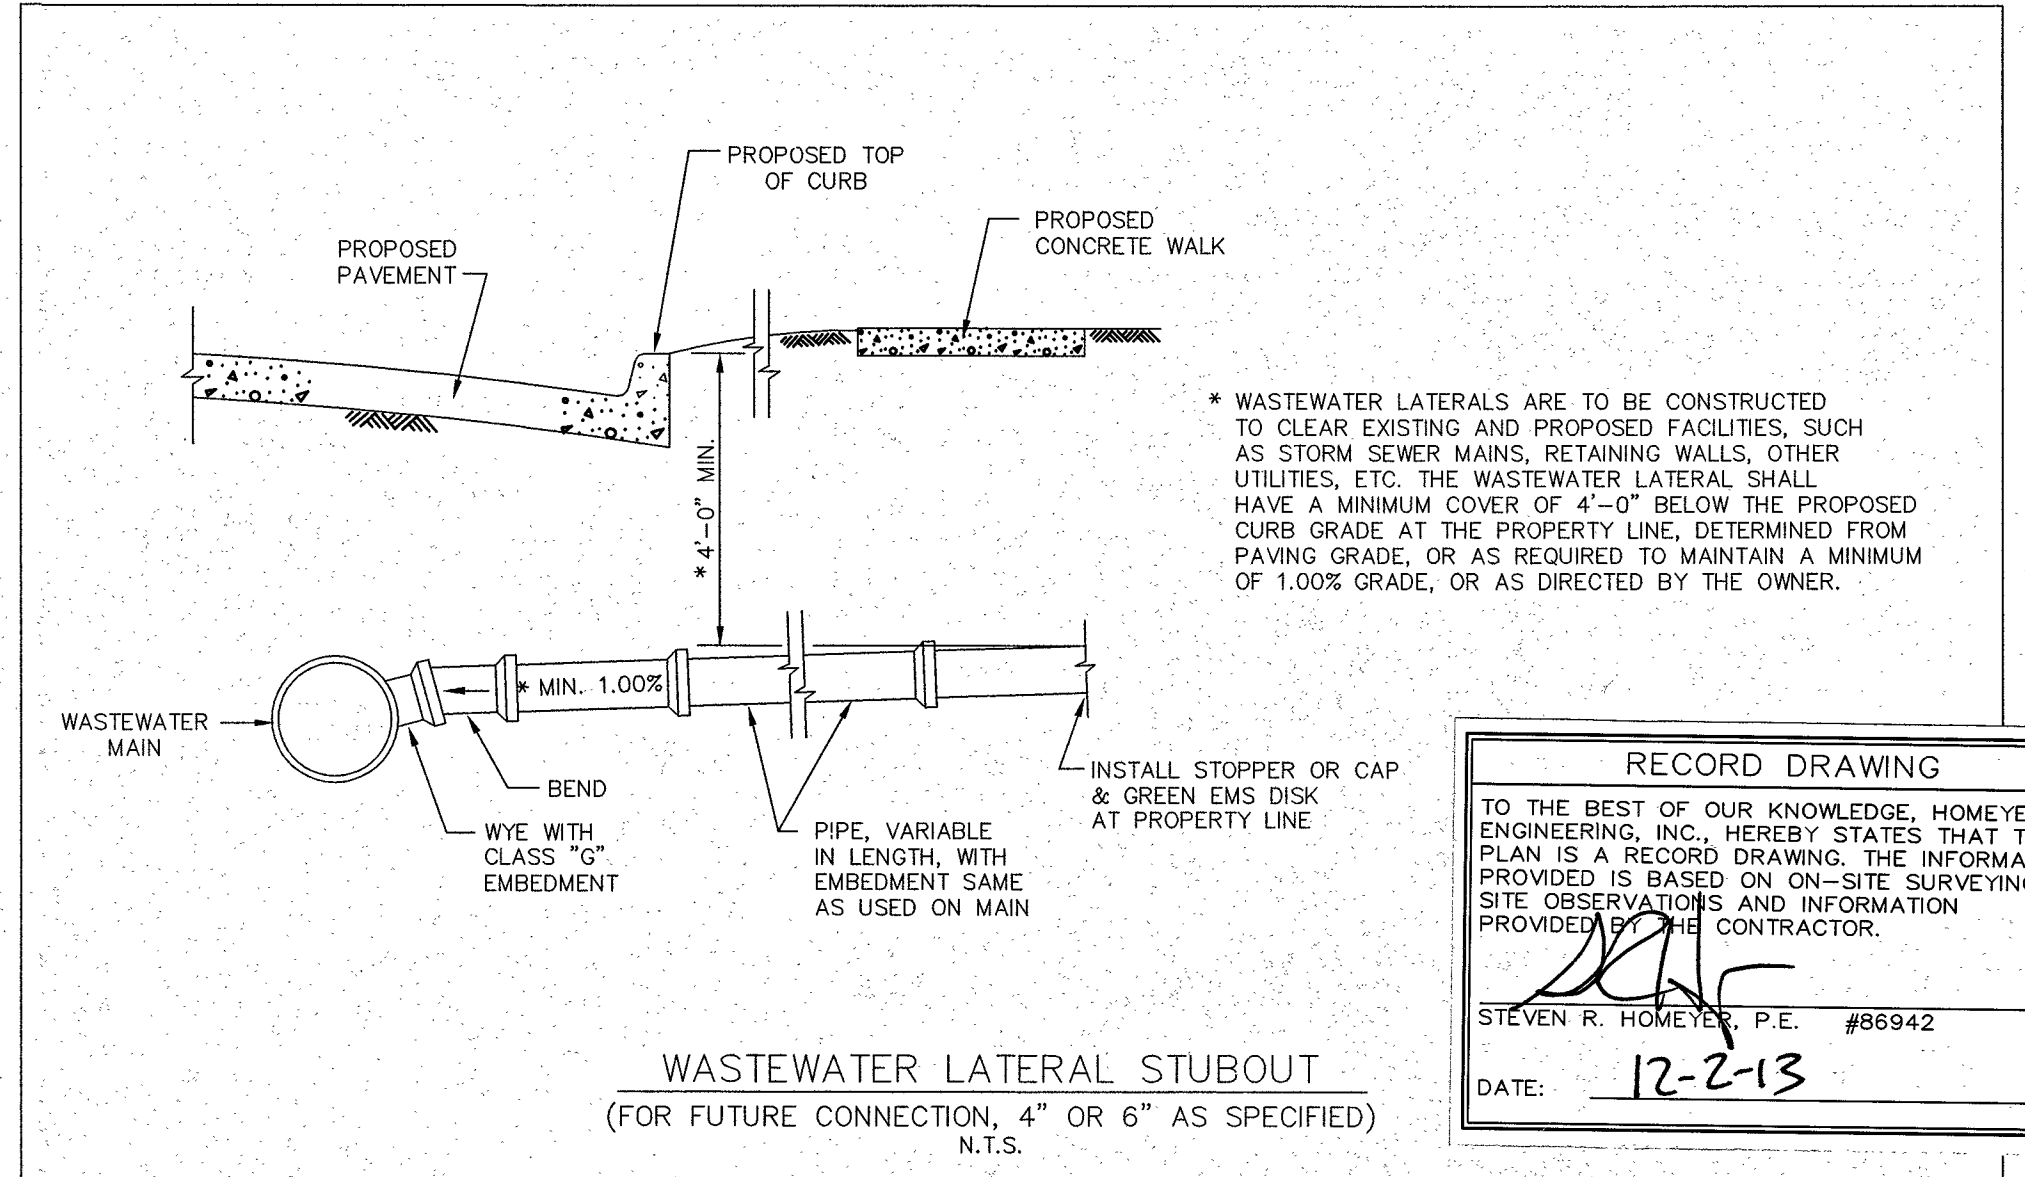

WASTEWATER LATERAL STUBOUT IN ADVANCE OF PAVING		North Central Texas Council of Governments	STANDARD SPECIFICATION REFERENCE 6.7
DATE NOV. '96	STANDARD DRAWING NO. 5150	CITY OF ROCKWALL MODIFIED AUGUST 2003	

NOTE:


THE CITY OF ROCKWALL CONSTRUCTION STANDARDS & NCTCOG 3RD EDITION APPLY, WHETHER INDICATED ON THESE PLANS OR NOT.

RECORD DRAWING


TO THE BEST OF OUR KNOWLEDGE, HOMMEYER ENGINEERING, INC. HEREBY STATES THAT THIS PLAN IS A RECORD DRAWING. THE INFORMATION PROVIDED IS BASED ON ON-SITE SURVEYING, SITE OBSERVATIONS AND INFORMATION PROVIDED BY THE CONTRACTOR.

STEVEN R. HOMMEYER, P.E. #86942

DATE: 12-2-13

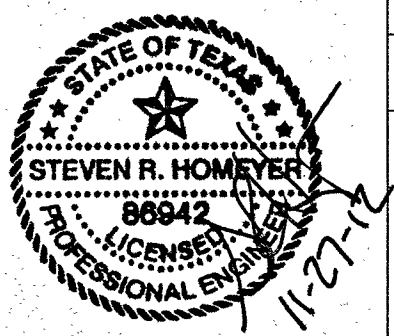

**HOMMEYER ENGINEERING, INC.**  
 ENGINEERING, INC.  
 T.B.P.E. FIRM REGISTRATION NO. F-B4440  
 P.O. BOX 294527 • LEWISVILLE, TEXAS • 75029  
 972-906-9985 PHONE • 972-906-9987 FAX  
 WWW.HEI.US.COM

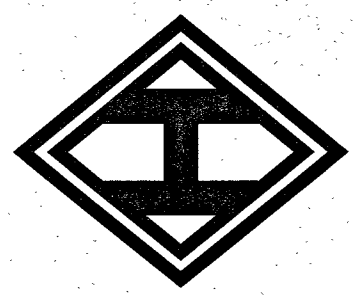

ROCK RIDGE ASSISTED LIVING AND MEMORY CARE  
 LOT 1R, BLOCK A,  
 FLAGSTONE CORNERS  
 CITY OF ROCKWALL  
 ROCKWALL COUNTY, TEXAS

UTILITY DETAILS

DRAWN: SRH  
 DATE: 11/27/12  
 HEI #: 12-112  
 SHEET NO: C19