

RECORD DRAWING


TO THE BEST OF OUR KNOWLEDGE, HOMEYER ENGINEERING, INC., HEREBY STATES THAT THIS PLAN IS A RECORD DRAWING. THE INFORMATION PROVIDED IS BASED ON ON-SITE SURVEYING, SITE OBSERVATIONS AND INFORMATION PROVIDED BY THE CONTRACTOR.

STEVEN R. HOMEYER, P.E. #86942
DATE: 12-2-13

NOTE:


THE CITY OF ROCKWALL CONSTRUCTION STANDARDS & NCTCOG 3RD EDITION APPLY, WHETHER INDICATED ON THESE PLANS OR NOT.

HOMEYER ENGINEERING, INC.
ENGINEERING, INC.
TBEPE FIRM REGISTRATION NO. F-8440
P.O. BOX 294527 • LEWISVILLE, TEXAS • 75029
972-906-9985 PHONE • 972-906-9987 FAX
WWW.HEI.US.COM

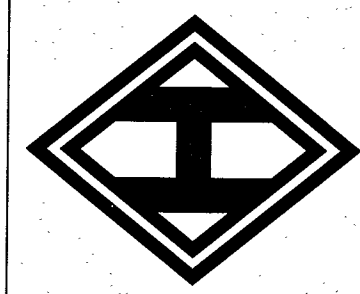

ROCK RIDGE ASSISTED LIVING AND MEMORY CARE
LOT 1R, BLOCK A,
FLAGSTONE CORNERS
CITY OF ROCKWALL
ROCKWALL COUNTY, TEXAS

STORM DETAILS

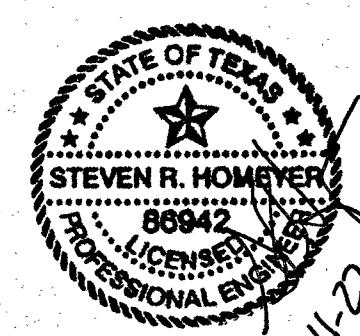

DRAWN: SRH
DATE: 11/27/12
HEI #: 12-112
SHEET NO: C20