


**NOTE:**  
THE CITY OF ROCKWALL CONSTRUCTION STANDARDS & NCTCOG 3RD EDITION APPLY, WHETHER INDICATED ON THESE PLANS OR NOT.

**RECORD DRAWING**  
TO THE BEST OF OUR KNOWLEDGE, HOMEYER ENGINEERING, INC. HEREBY STATES THAT THIS PLAN IS A RECORD DRAWING. THE INFORMATION PROVIDED IS BASED ON ON-SITE SURVEYING, SITE OBSERVATIONS AND INFORMATION PROVIDED BY THE CONTRACTOR.  
STEVEN R. HOMEYER, P.E. #86942  
DATE: 12-2-13

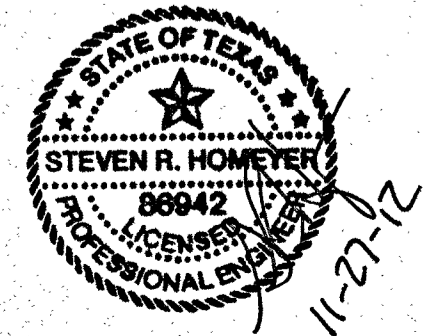

**HOMEYER ENGINEERING, INC.**  
ENGINEERING, INC.  
FIRM REGISTRATION NO. F-8440  
P.O. BOX 294527 • LEWISVILLE, TEXAS • 75029  
972-906-9985 PHONE • 972-906-9987 FAX  
WWW.HEI.US.COM

ROCK RIDGE ASSISTED LIVING AND MEMORY CARE  
LOT 1R, BLOCK A,  
FLAGSTONE CORNERS  
CITY OF ROCKWALL  
ROCKWALL COUNTY, TEXAS

PAVING DETAILS

DRAWN: SRH  
DATE: 11/27/12  
HEI #: 12-112  
SHEET NO: C21