

TOTAL AREA=7.06AC, AREA DETAINED=3.05 AC.

1. VOLUME REQUIRED

FREQUENCY = 10 YEAR

PRESENT CONDITION: Td = 20 DESIGN TIME, C = 0.35, I = 5.68 IN/HR, Q = C²*A = 6.06 CFS
 PROPOSED CONDITION: Td = 10 DESIGN TIME, C = 0.30, I = 7.19 IN/HR, Q = C²*A = 19.74 CFS

MAX. RELEASE RATE = PRESENT CONDITION-DIRECT DISCHARGE
 MAX. RELEASE RATE = 6.06 - 0.00 = 6.06 CFS

TIME	INTENSITY	DISCHARGE	INFLOW	OUTFLOW	STORAGE
10	7.19	19.74	11,841.93	3,639.04	8,202.89
15	6.35	17.43	15,887.68	4,547.55	11,340.13
20	5.68	15.59	18,709.92	5,437.06	13,272.86
25	5.14	14.11	21,163.98	6,308.57	14,855.41
30	4.70	12.90	23,222.70	7,176.08	16,046.62
35	4.33	11.89	24,960.29	8,035.59	16,924.70
40	4.01	11.00	26,417.68	8,895.10	17,522.58
45	3.73	10.24	27,644.50	9,744.61	17,900.89
50	3.50	9.61	28,622.50	10,514.12	17,908.38
55	3.29	9.03	29,302.47	11,223.63	17,978.84
60	3.10	8.51	30,634.20	11,933.14	17,901.06
70	2.78	7.63	32,050.62	14,352.16	17,698.46
80	2.53	6.94	33,333.28	16,371.18	16,962.10
90	2.32	6.37	34,389.36	18,190.20	16,199.16

FREQUENCY = 25 YEAR

PRESENT CONDITION: Td = 20 DESIGN TIME, C = 0.35, I = 6.61 IN/HR, Q = C²*A = 7.06 CFS
 PROPOSED CONDITION: Td = 10 DESIGN TIME, C = 0.30, I = 8.22 IN/HR, Q = C²*A = 22.56 CFS

MAX. RELEASE RATE = PRESENT CONDITION-DIRECT DISCHARGE
 MAX. RELEASE RATE = 7.06 - 0.00 = 7.06 CFS

TIME	INTENSITY	DISCHARGE	INFLOW	OUTFLOW	STORAGE
10	8.22	22.56	13,539.34	4,233.71	9,305.64
15	7.33	20.12	18,108.77	5,292.13	12,816.64
20	6.61	18.14	21,773.34	6,350.56	15,422.78
25	6.01	16.50	24,486.18	7,408.98	17,077.19
30	5.50	15.10	27,175.50	8,467.41	18,708.09
35	5.07	13.92	29,226.02	9,525.84	19,700.18
40	4.69	12.87	30,687.72	10,584.26	20,103.46
45	4.37	12.00	31,598.26	11,642.69	20,955.57
50	4.08	11.20	32,598.80	12,701.12	20,897.69
55	3.83	10.51	33,634.08	13,759.54	20,874.51
60	3.60	9.88	34,672.20	14,817.97	20,757.23
70	3.21	8.81	37,008.09	16,334.82	20,673.27
80	2.90	7.98	38,710.40	18,051.67	19,658.73
90	2.64	7.25	39,132.72	20,188.53	17,944.20

FREQUENCY = 50 YEAR

PRESENT CONDITION: Td = 20 DESIGN TIME, C = 0.35, I = 7.42 IN/HR, Q = C²*A = 7.92 CFS
 PROPOSED CONDITION: Td = 10 DESIGN TIME, C = 0.30, I = 9.01 IN/HR, Q = C²*A = 24.73 CFS

MAX. RELEASE RATE = PRESENT CONDITION-DIRECT DISCHARGE
 MAX. RELEASE RATE = 7.92 - 0.00 = 7.92 CFS

TIME	INTENSITY	DISCHARGE	INFLOW	OUTFLOW	STORAGE
10	9.01	24.73	14,838.47	4,752.51	10,085.96
15	8.16	22.40	20,159.25	5,930.84	14,228.41
20	7.42	20.37	24,441.48	7,128.77	17,312.72
25	6.77	18.58	27,875.48	8,316.88	19,558.60
30	6.20	17.05	30,534.20	9,505.02	21,029.18
35	5.70	15.65	32,857.85	10,693.15	21,844.70
40	5.23	14.41	34,887.00	11,881.28	22,405.72
45	4.86	13.34	36,619.88	13,069.40	22,850.48
50	4.50	12.35	37,957.50	14,257.53	22,709.97
55	4.19	11.50	38,954.12	15,445.66	22,508.46
60	3.90	10.71	39,539.80	16,633.79	21,906.02
70	3.41	9.36	39,313.89	19,010.04	20,303.85
80	3.00	8.24	39,288.00	21,386.30	18,901.71
90	2.66	7.30	39,428.18	24,762.55	15,665.63

FREQUENCY = 100 YEAR

PRESENT CONDITION: Td = 20 DESIGN TIME, C = 0.35, I = 8.3 IN/HR, Q = C²*A = 8.86 CFS
 PROPOSED CONDITION: Td = 10 DESIGN TIME, C = 0.30, I = 9.8 IN/HR, Q = C²*A = 26.90 CFS

MAX. RELEASE RATE = PRESENT CONDITION-DIRECT DISCHARGE
 MAX. RELEASE RATE = 8.86 - 0.00 = 8.86 CFS

TIME	INTENSITY	DISCHARGE	INFLOW	OUTFLOW	STORAGE
10	9.80	26.90	16,140.80	5,316.15	10,824.65
15	9.00	24.71	22,255.30	6,545.19	15,710.11
20	8.30	22.78	27,340.20	7,974.23	19,365.96
25	7.50	20.59	30,881.25	9,303.26	21,577.99
30	7.00	19.49	33,091.10	10,632.30	23,458.80
35	6.40	17.57	36,889.80	11,961.34	24,928.46
40	5.90	16.20	38,889.20	13,290.38	25,598.83
45	5.40	14.82	40,222.70	14,619.41	25,402.89
50	5.00	13.73	41,175.00	15,948.45	25,226.55
55	4.60	12.80	43,480.80	17,277.49	25,203.31
60	4.30	12.35	44,689.00	18,606.53	25,082.48
70	4.00	10.98	46,116.00	21,284.80	24,831.40
80	3.70	10.16	48,751.20	23,922.88	24,828.33
90	3.40	9.33	50,366.20	26,560.75	23,817.45

2. VOLUME PROVIDED

SOUTHERN POND

ELEV	AREA	AVE. AREA	VOLUME	CUM. VOL.
537	7,378.14	6,716.39	6,716.39	26,239.15
536	6,058.84	5,458.81	5,458.81	19,520.76
535	4,958.97	4,319.05	4,319.05	14,061.96
534	3,793.12	3,299.12	3,299.12	9,722.81
533	2,819.11	2,395.02	2,395.02	6,443.80
532	1,978.92	1,644.85	1,644.85	4,044.78
531	1,410.77	1,183.45	1,183.45	2,323.94
530	956.13	781.51	781.51	1,166.48
529	566.89	404.98	404.98	404.98
528	243.08			

3. ALLOWABLE DISCHARGE (7.06-3.05=4.01 AC)

A. DETAINED = 6.06 CFS
 B. UN-DETAINED = C²*A=0.9*7.19*4.01 = 25.95 CFS
 C. TOTAL = 32.00 CFS

A. DETAINED = 7.06 CFS
 B. UN-DETAINED = C²*A=0.9*8.22*4.01 = 29.66 CFS
 C. TOTAL = 36.72 CFS

A. DETAINED = 7.92 CFS
 B. UN-DETAINED = C²*A=0.9*9.01*4.01 = 32.52 CFS
 C. TOTAL = 40.44 CFS

A. DETAINED = 8.86 CFS
 B. UN-DETAINED = C²*A=0.9*9.8*4.01 = 35.36 CFS
 C. TOTAL = 44.22 CFS

4. WATER SURFACE ELEVATION

19,520.76 - 14,061.96 CF = 536.00' - 535.00'
 = 5,458.80 CF = 1.00'
 = 17,978.84 - 14,061.96 = 3,916.88 CF = 0.72'
 W.S ELEV = 535.72'

26,239.15 - 19,520.76 CF = 537.00' - 536.00'
 = 6,716.39 CF = 1.00'
 = 20,934.51 - 19,520.76 = 1,413.75 CF = 0.21'
 W.S ELEV = 536.21'

26,239.15 - 19,520.76 CF = 537.00' - 536.00'
 = 6,716.39 CF = 1.00'
 = 22,950.49 - 19,520.76 = 3,429.73 CF = 0.51'
 W.S ELEV = 536.51'

26,239.15 - 19,520.76 CF = 537.00' - 536.00'
 = 6,716.39 CF = 1.00'
 = 26,203.31 - 19,520.76 = 6,682.55 CF = 0.99'
 W.S ELEV = 536.99'



DOUPRATE & ASSOCIATES, INC.
 ENGINEERING - PROJECT MANAGEMENT - SURVEYING
 2235 RIDGE RD., # 200 ROCKWALL, TEXAS 75087
 PHONE: (972)771-0004 FAX: (972)771-0006


DETENTION POND # 1 (3.05 AC. CAPACITY)
FLAGSTONE ESTATES
 CITY OF ROCKWALL
 ROCKWALL COUNTY, TEXAS

REVISION
 KEB
 CHECKED
 D.L.B.
 DRAWN
 9/04
 DATE
 014 82A DETENTION POND #1
 32A
 OF

REVISED TO CONFORM TO CONSTRUCTION RECORDS.
 DATE: 1/27/06

* * FOR REFERENCE PURPOSES ONLY * *

HOMEYER ENGINEERING, INC.
 ENGINEERING, INC.
 TBE FIRM REGISTRATION NO. F-B4440
 P.O. BOX 294527 • LEWISVILLE, TEXAS • 75029
 972-906-9985 PHONE • 972-906-9987 FAX
 WWW.HEI.US.COM

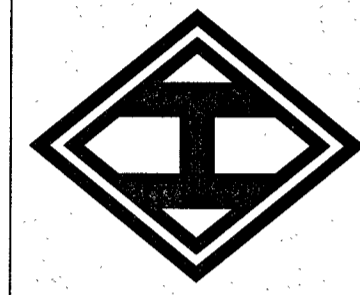

ROCK RIDGE ASSISTED LIVING AND MEMORY CARE
 AND MEMORY CARE
 LOT 1R, BLOCK A,
 FLAGSTONE CORNERS
 CITY OF ROCKWALL
 ROCKWALL COUNTY, TEXAS

DOUPRATE & ASSOCIATES
 DETENTION POND #1

DRAWN: SRH
 DATE: 11/27/12
 HEI #: 12-112
 SHEET NO:
 C10