

LEGEND

I.R.F.	IRON ROD FOUND
S.I.R.	SET IRON ROD
"X"	CUT X IN CONCRETE
F.C.P.	FENCE CORNER POST
///	ASPHALT
⊙	TELEPHONE MANHOLE
⊗	POWER POLE
⊙	LIGHT POLE
⊗	WATER VALVE
⊙	SANITARY SEWER MANHOLE
⊗	FIRE HYDRANT
⊙	WATER METER


- ### NOTES:
- CITY OF ROCKWALL CONSTRUCTION STANDARDS AND NCTCOG 3RD EDITION APPLY WHETHER INDICATED ON THESE PLANS OR NOT.
 - ALL RESPONSIBILITY FOR ADEQUACY OF DESIGN REMAINS WITH THE DESIGN ENGINEER. THE CITY OF ROCKWALL, IN REVIEWING AND RELEASING PLANS FOR CONSTRUCTION, ASSUMES NO RESPONSIBILITY FOR ADEQUACY OR ACCURACY OF DESIGN.
 - ALL EXISTING TREES SHALL REMAIN UNLESS NOTED OTHERWISE. THE CONTRACTOR SHALL BE RESPONSIBLE FOR REMOVING UNDER BRUSH AND ANY DEBRIS FOUND UNDER TREES.

BENCHMARK INFORMATION


TBM #1 - 60D NAIL FOUND AT THE SOUTHEAST CORNER OF THE PROPOSED TRACT, APPROXIMATELY 400 LF SOUTHEAST FROM THE INTERSECTION OF RALPH HALL PARKWAY AND FLAGSTONE CREEK BLVD.
ELEVATION = 533.13

THE CONTRACTOR SHALL CONTACT DIG-TESS AT 1-800-344-8377 A MINIMUM OF 48 HOURS PRIOR TO THE COMMENCEMENT OF ANY CONSTRUCTION ACTIVITIES

RECORD DRAWING
 TO THE BEST OF OUR KNOWLEDGE, HOMEYER ENGINEERING, INC. HEREBY STATES THAT THIS PLAN IS A RECORD DRAWING. THE INFORMATION PROVIDED IS BASED ON ON-SITE SURVEYING, SITE OBSERVATIONS AND INFORMATION PROVIDED BY THE CONTRACTOR.
 STEVEN R. HOMEYER, P.E. #86942
 DATE: 12-2-13

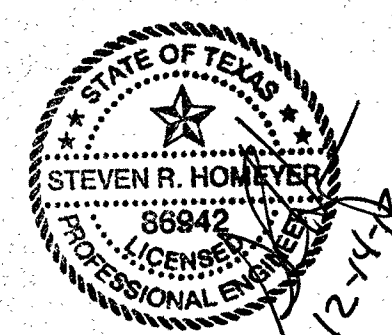

HOMEYER ENGINEERING, INC.
 TBP# FIRM REGISTRATION NO. F-8440
 P.O. BOX 294527 • LEWISVILLE • TEXAS • 75059
 972-906-9985 • PHONE • 972-906-9987 FAX
 WWW.HEI.US.COM

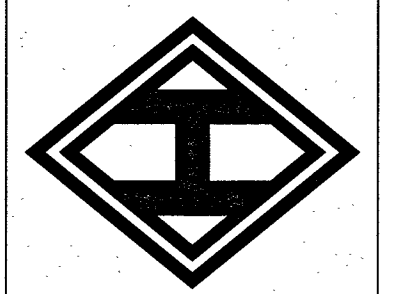

ROCK RIDGE ASSISTED LIVING AND MEMORY CARE
 LOT 1R, BLOCK A,
 FLAGSTONE CORNERS
 CITY OF ROCKWALL
 ROCKWALL COUNTY, TEXAS

DEMOLITION PLAN

REVISIONS:
 12/14/12
 1. CURB FOR REVISED DRIVEWAY TO REMAIN

DRAWN: SRH
 DATE: 11/27/12
 HEI #: 12-112
 SHEET NO: C2