


NOTE:
THE CITY OF ROCKWALL CONSTRUCTION STANDARDS & NCTCOG 3RD EDITION APPLY, WHETHER INDICATED ON THESE PLANS OR NOT.

RECORD DRAWING

TO THE BEST OF OUR KNOWLEDGE, HOMEYER ENGINEERING, INC., HEREBY STATES THAT THIS PLAN IS A RECORD DRAWING. THE INFORMATION PROVIDED IS BASED ON ON-SITE SURVEYING, SITE OBSERVATIONS AND INFORMATION PROVIDED BY THE CONTRACTOR.

STEVEN R. HOMEYER, P.E. #86942

DATE: 12-2-13

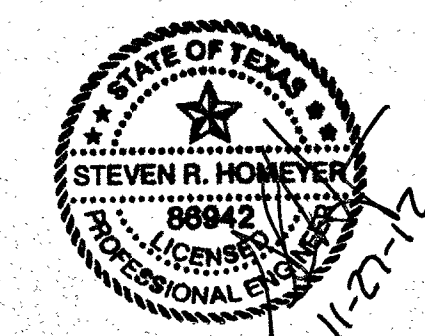

ROCK RIDGE ASSISTED LIVING AND MEMORY CARE, LOT 1R, BLOCK A, FLAGSTONE CORNERS, CITY OF ROCKWALL, TEXAS, ROCKWALL COUNTY, TEXAS

EROSION CONTROL DETAILS

DRAWN: SRH
DATE: 11/27/12
HEI #: 12-112
SHEET NO: C22

HOMEYER ENGINEERING, INC.
TBP# FIRM REGISTRATION NO. F-8440
P. O. BOX 294527 • LEWISVILLE, TEXAS • 75039
972-906-9985 PHONE • 972-906-9987 FAX
WWW.HEI.US.COM

