

- GENERAL NOTES**
- GENERAL NOTES:
 - ALL PARKING SPACE LIMIT LINES SHALL BE 4" SOLID WHITE LINES.
 - AISLE MARKINGS SHOWN ARE EXAMPLES ONLY. OTHER METHODS TO INDICATE A NO PARKING AREA ARE ACCEPTABLE. AISLE MARKINGS SHALL BE WHITE.
 - DIMENSIONS OF LIMIT LINES, AISLE MARKINGS, AND SYMBOL (WITH OR WITHOUT BACKGROUND) MAY VARY + 10%.
 - PAVEMENT MARKING SYMBOLS (WITH BACKGROUND):
 - ARE REQUIRED UNLESS STATED ELSEWHERE IN THE PLANS.
 - SHOULD BE PLACED TOWARD THE FAR END OF THE PARKING SPACES SO AS TO BE VISIBLE TO MOTORISTS IN THE TRAVEL LANE.
 - MAY BE PAINTED OR PREFABRICATED MATERIAL, AND
 - SHALL BE 30" X 30" MINIMUM.
 - WITH APPROVAL OF THE ENGINEER, PREFABRICATED PAVEMENT MARKING SYMBOLS WITH BACKGROUND OF OTHER DIMENSIONS EXCEEDING THE 30" X 30" MINIMUM MAY BE USED. ALTERNATIVE DESIGNS SHALL INCLUDE A PROPORTION SIZED SYMBOL OF ACCESSIBILITY, AND SHALL CONFORM TO THE ILLUSTRATED COLORS FOR BACKGROUND, SYMBOL AND BORDER.
 - AN R7-8 SIGN:
 - SHALL BE REQUIRED FOR EACH ACCESSIBLE PARKING SPACE.
 - SHALL NOT BE PLACED BETWEEN TWO ACCESSIBLE PARKING SPACES.
 - SHALL NOT BE PLACED IN A LOCATION THAT RESTRICTS MOVEMENT OF WHEELCHAIRS WITHIN THE ADJACENT SIDEWALK, AND
 - SHALL HAVE A MINIMUM MOUNTING HEIGHT OF 7 FEET. IF MOUNTED TO WALL OR LOCATED SO AS NOT TO BE NEAR PEDESTRIAN TRAFFIC MINIMUM MOUNTING HEIGHT MAY BE 7 FEET.
 - POST MOUNTED SIGNS SHOULD BE PLACED APPROXIMATELY 1 FOOT (OR GREATER) BEHIND THE CURB TO PREVENT DAMAGE FROM VEHICLE OVERHANG.
 - SIGNS MAY BE MOUNTED DIRECTLY TO AN ADJACENT WALL OF A BUILDING WHEN POST MOUNTING IS IMPRACTICAL.


NOTE:
CITY OF ROCKWALL CONSTRUCTION STANDARDS APPLY WHETHER INDICATED ON THESE PLANS OR NOT.

RECORD DRAWING


TO THE BEST OF OUR KNOWLEDGE, HOMEYER ENGINEERING, INC., HEREBY STATES THAT THIS PLAN IS A RECORD DRAWING. THE INFORMATION PROVIDED IS BASED ON ON-SITE SURVEYING, SITE OBSERVATIONS AND INFORMATION PROVIDED BY THE CONTRACTOR.

STEVEN R. HOMEYER, P.E. #86942

DATE: 12-2-13

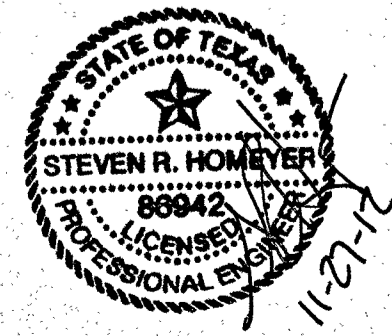

HOMEYER ENGINEERING, INC.
ENGINEERING, INC.
TBEPE FIRM REGISTRATION NO. F-84440
P.O. BOX 294527 • LEWISVILLE, TEXAS • 75029
972-906-9985 PHONE • 972-906-9987 FAX
WWW.HEI.US.COM

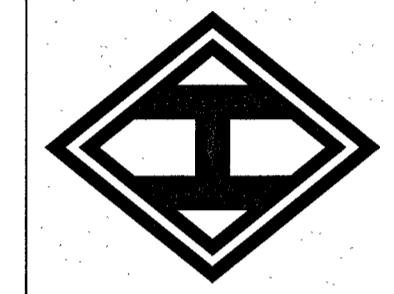

ROCK RIDGE ASSISTED LIVING AND MEMORY CARE
LOT 1R, BLOCK A,
FLAGSTONE CORNERS
CITY OF ROCKWALL
ROCKWALL COUNTY, TEXAS

ADA DETAILS

DRAWN: SRH
DATE: 11/27/12
HEI #: 12-112
SHEET NO: C23