


RECORD DRAWING  
 TO THE BEST OF OUR KNOWLEDGE, HOMER ENGINEERING, INC., HEREBY STATES THAT THIS PLAN IS A RECORD DRAWING. THE INFORMATION PROVIDED IS BASED ON ON-SITE SURVEYING, SITE OBSERVATIONS AND INFORMATION PROVIDED BY THE CONTRACTOR.  
 STEVEN R. HOMER, P.E. #86942  
 DATE: 12-2-13

NOTE:  
 THE CITY OF ROCKWALL CONSTRUCTION STANDARDS & NCTCOG 3RD EDITION APPLY, WHETHER INDICATED ON THESE PLANS OR NOT.

**HOMER**  
 ENGINEERING, INC.  
 TBP# FIRM REGISTRATION NO. F-84440  
 P.O. BOX 294527 • LEWISVILLE, TEXAS • 75029  
 972-906-9985 • 972-906-9987 FAX  
 WWW.HEI.US.COM

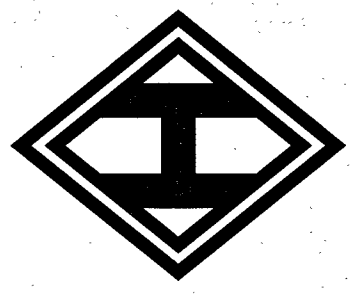

ROCK RIDGE ASSISTED LIVING  
 AND MEMORY CARE  
 LOT 1R, BLOCK A,  
 FLAGSTONE CORNERS  
 CITY OF ROCKWALL  
 ROCKWALL COUNTY, TEXAS

MISCELLANEOUS  
 DETAILS

DRAWN: SRH  
 DATE: 11/27/12  
 HEI #: 12-112  
 SHEET NO:  
 C25