


**HOMMEYER ENGINEERING, INC.**  
 ENGINEERING, INC.  
 P.O. BOX 294527 • LEWISVILLE, TEXAS • 75039  
 972-906-9985 PHONE • 972-906-9987 FAX  
 WWW.HEI.US.COM

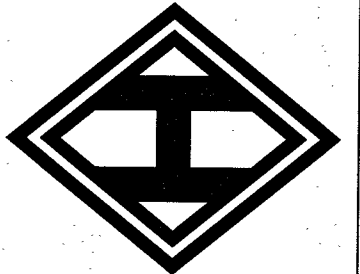

ROCK RIDGE ASSISTED LIVING  
 AND MEMORY CARE  
 LOT 1R, BLOCK A,  
 FLAGSTONE CORNERS  
 CITY OF ROCKWALL  
 ROCKWALL COUNTY, TEXAS

**EROSION CONTROL PLAN**

**RECORD DRAWING**  
 TO THE BEST OF OUR KNOWLEDGE, HOMMEYER ENGINEERING, INC., HEREBY STATES THAT THIS PLAN IS A RECORD DRAWING. THE INFORMATION PROVIDED IS BASED ON ON-SITE SURVEYING, SITE OBSERVATIONS AND INFORMATION PROVIDED BY THE CONTRACTOR.  
 STEVEN R. HOMMEYER, P.E. #86942  
 DATE: 12-2-13

**DEVELOPER**  
 Signature Assisted Living, LLC  
 106 Decker Court, Suite 200  
 Irving, Texas 75062  
 Contact: Pete Russell  
 Phone: 941-953-3757

**ENGINEER**  
 Hommeyer Engineering, Inc.  
 P.O. Box 294527  
 Lewisville, Texas 75029  
 Contact: Steven R. Hommeyer, PE  
 Phone: 972-906-9985


EROSION CONTROL LEGEND			
T.C.	TOP OF CURB	N.G.	NATURAL GROUND
G	GUTTER	---	EXISTING CONTOURS
T.P.	TOP OF PAVEMENT	---	PROPOSED CONTOURS
[Symbol]	CONSTRUCTION ENTRANCE	SF	PROPOSED SILT FENCE
[Symbol]	INLET PROTECTION	[Symbol]	ROCK BERM

THE CONTRACTOR SHALL CONTACT DIG-TESS AT 1-800-344-8377 A MINIMUM OF 48 HOURS PRIOR TO THE COMMENCEMENT OF ANY CONSTRUCTION ACTIVITIES

**BENCHMARK INFORMATION**  
 TBM #1 - 1/2" CAPPED IRON ROD LOCATED WITHIN THE MEDIAN DIG-TESS AT 1-800-344-8377 A MINIMUM OF 48 HOURS PRIOR TO THE COMMENCEMENT OF ANY CONSTRUCTION ACTIVITIES.  
 ELEVATION = 546.28  
 ELEVATIONS SHOWN ARE BASED ON THE CITY OF ROCKWALL GIS NETWORK MONUMENT NUMBER R016.  
 ELEVATION = 558.72'

**NOTES:**

- CITY OF ROCKWALL CONSTRUCTION STANDARDS & NCTCOG 3RD EDITION APPLY WHETHER INDICATED ON THESE PLANS OR NOT.
- ALL RESPONSIBILITY FOR ADEQUACY OF DESIGN REMAINS WITH THE DESIGN ENGINEER. THE CITY OF ROCKWALL, IN REVIEWING AND RELEASING PLANS FOR CONSTRUCTION, ASSUMES NO RESPONSIBILITY FOR ADEQUACY OR ACCURACY OF DESIGN.

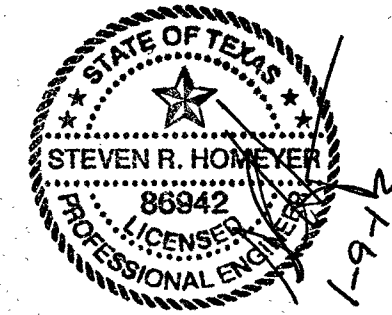

**REVISIONS:**  
 12/14/12  
 1. CONSTRUCTION ENTRANCE RELOCATED  
 01/09/13  
 1. CONSTRUCTION ENTRANCE ADDED FOR ENTRY FROM RALPH HALL PKWY

DRAWN: SRH

DATE: 11/27/12

HEI #: 12-112

SHEET NO:

C6