

SITE CONSTRUCTION PLANS

FOR


ROCKWALL CENTRAL

APPRAISAL DISTRICT

PARKING LOT EXPANSION

IN THE

CITY OF ROCKWALL, TEXAS

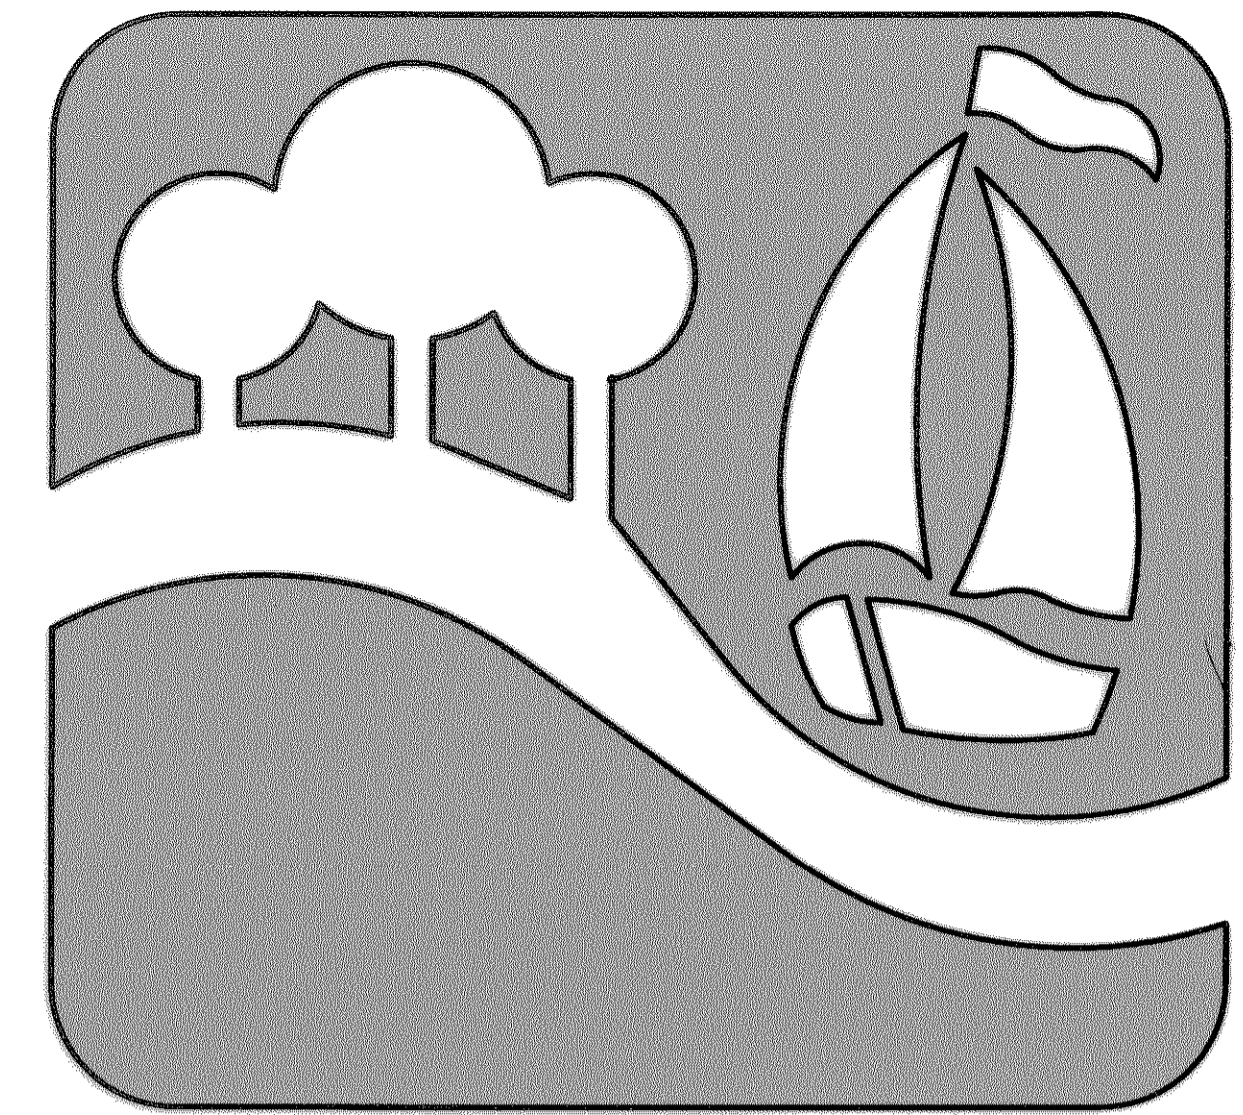


"THE NEW HORIZON"

RCAD PARKING LOT 22102


SHEET INDEX

Sheet No.	Description
1	Cover Sheet
C1	Dimension Control
C2	Grading Plan
C3	Erosion Control
C4	Typical Details & Notes

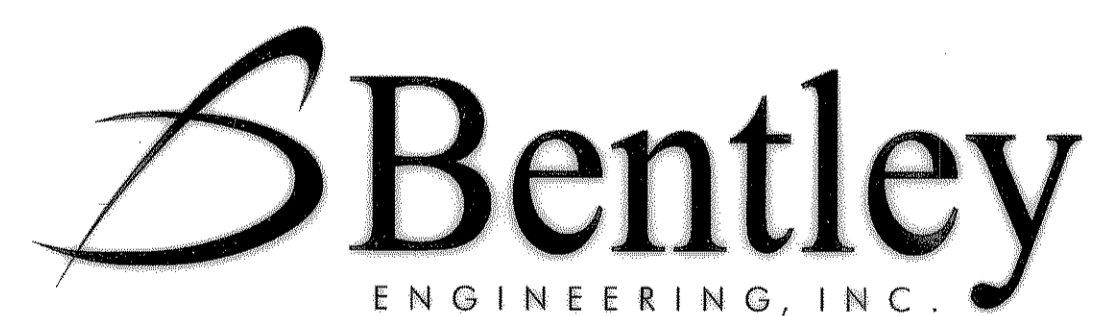

4125 BROADWAY BLVD.
SUITE A250
GARLAND, TEXAS 75043
PH. 972.240.4821
FAX. 972.240.0922

APRIL 2003

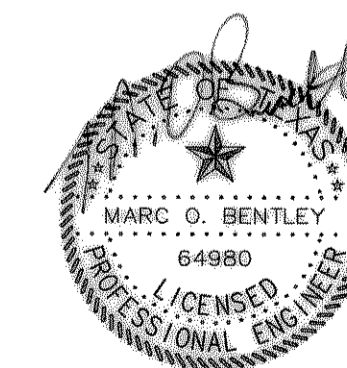

THE SEAL APPEARING ON THIS DOCUMENT WAS AUTHORIZED BY MARC O. BENTLEY, P.E. NO. 64980 ON 05/02/03

RECORD DRAWING

IMPROVEMENTS INDICATED ON THIS PLAN WHERE MADE IN ACCORDANCE WITH THE PROJECT PLANS & SPECIFICATIONS. THE DESIGN ENGINEER IS NOT AWARE OF ANY CHANGES TO THESE PLANS OTHER THAN THOSE PROVIDED ON A CONTRACTORS SET OF MARKUPS.
DATE: JULY 29, 2003