



$R = 970.00'$
 $D = 07^{\circ}56'00''$
 $T = 67.26'$
 $L = 134.31'$

B.R. & R.B. CAMERON

NOTE: SEE SHEET C4 FOR PAVING DETAILS AND NOTES.

RECORD DRAWING

IMPROVEMENTS INDICATED ON THIS PLAN WHERE MADE IN ACCORDANCE WITH THE PROJECT PLANS & SPECIFICATIONS. THE DESIGN ENGINEER IS NOT AWARE OF ANY CHANGES TO THESE PLANS OTHER THAN THOSE PROVIDED ON A CONTRACTORS SET OF MARKUPS.
 DATE: JULY 29, 2003

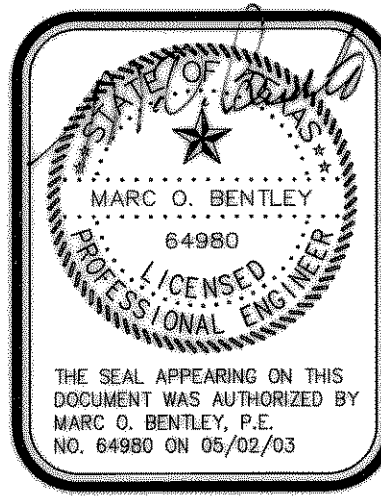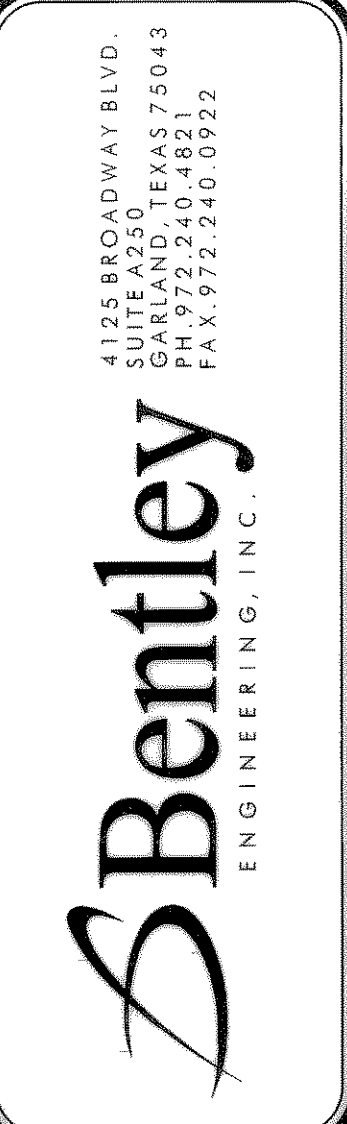

DIMENSION CONTROL
 RCAD PARKING LOT EXPANSION
 CITY OF ROCKWALL, TEXAS

RECORD DRAWING	No.	Date	Revision

Scale: 1"=20'
 File Name: RCADSITE
 Date: APRIL 2003
 Project No.: 22102

Sheet **C1**