


**GRADING PLAN**  
**ROAD PARKING LOT EXPANSION**  
**CITY OF ROCKWALL, TEXAS**

**RECORD DRAWING**

No.	Date	Revision

Scale: 1" = 20'  
 File Name: RCADSITE  
 Date: APRIL 2003  
 Project No.: 22102

Sheet **C2**

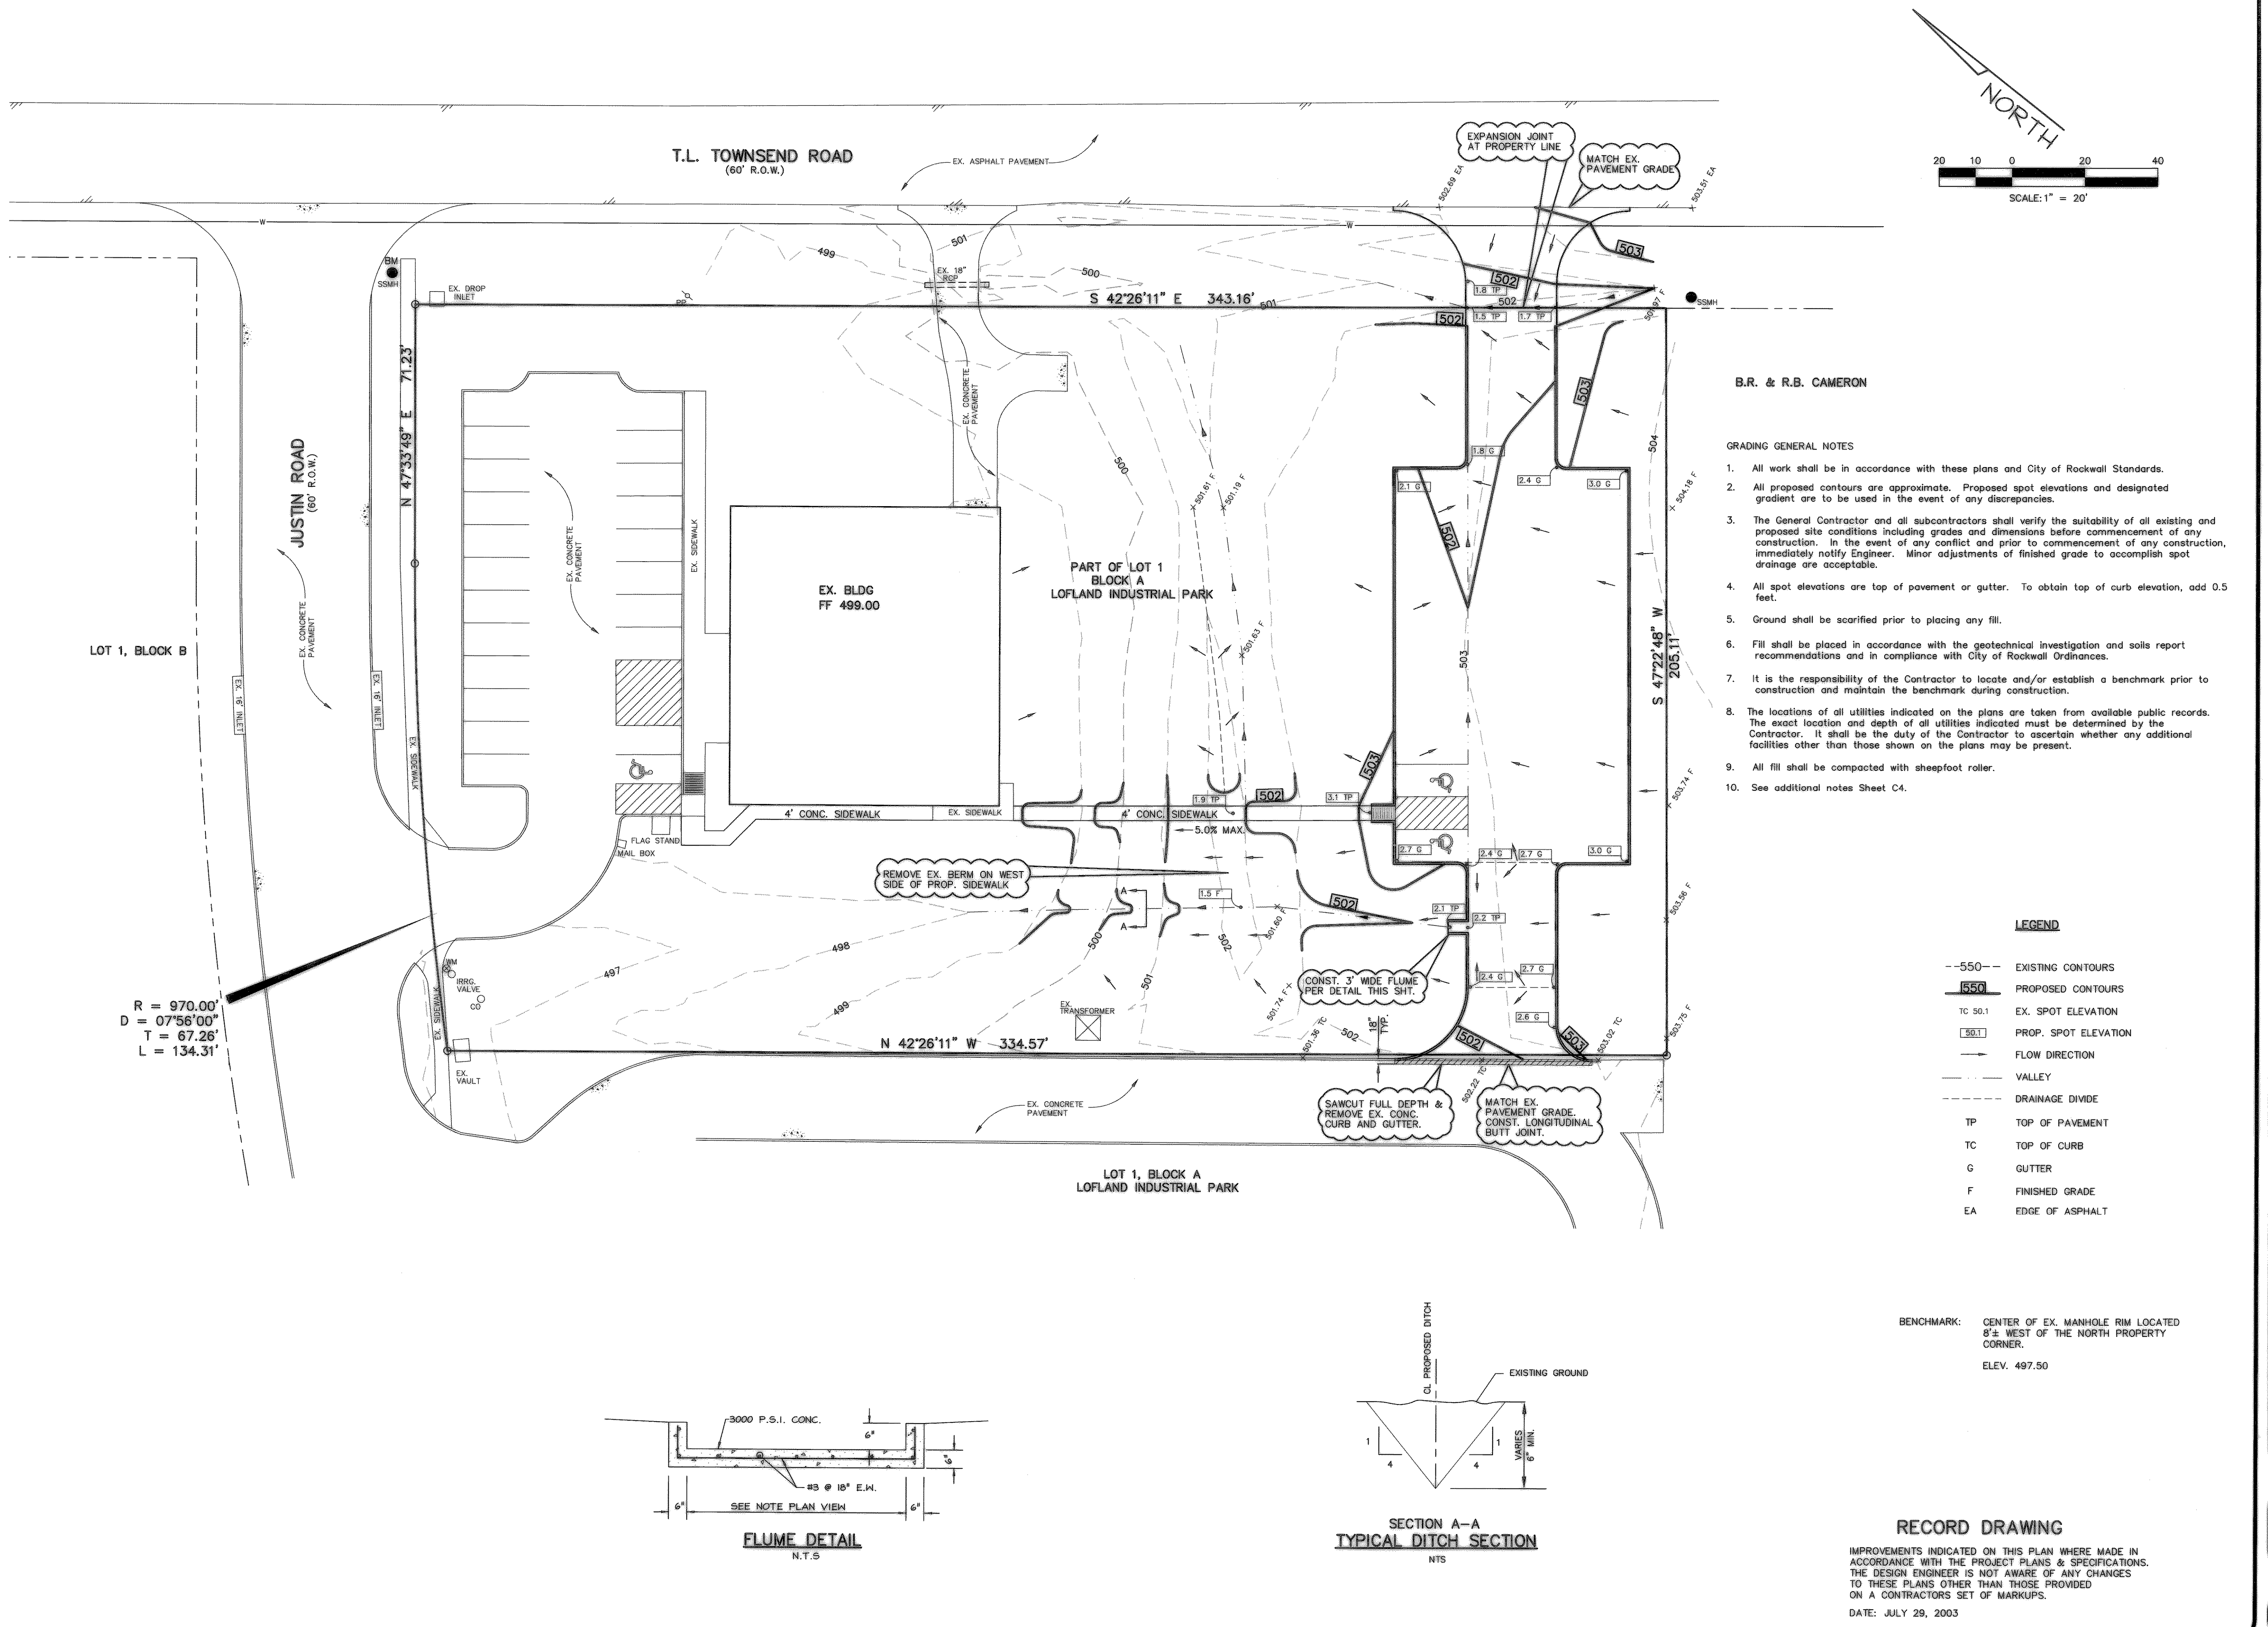

**RECORD DRAWING**

IMPROVEMENTS INDICATED ON THIS PLAN WHERE MADE IN ACCORDANCE WITH THE PROJECT PLANS & SPECIFICATIONS. THE DESIGN ENGINEER IS NOT AWARE OF ANY CHANGES TO THESE PLANS OTHER THAN THOSE PROVIDED ON A CONTRACTORS SET OF MARKUPS.

DATE: JULY 29, 2003