

ENGINEERING SITE PLAN
FOR

**ROCKWALL ASSISTED
LIVING ADDITION**

CITY OF ROCKWALL, ROCKWALL COUNTY, TEXAS

5.868 AC.


JUNE 1998

OWNER:

F.M. 740 ROCKWALL, LTD.
104 LION STREET, SUITE E.
DESOTO, TEXAS 75115
(972) 223-6241

DEVELOPER:

N.T.F. REALTY, INC.
AS ITS GENERAL PARTNER
WILLIAM E. CAMPBELL
PRESIDENT

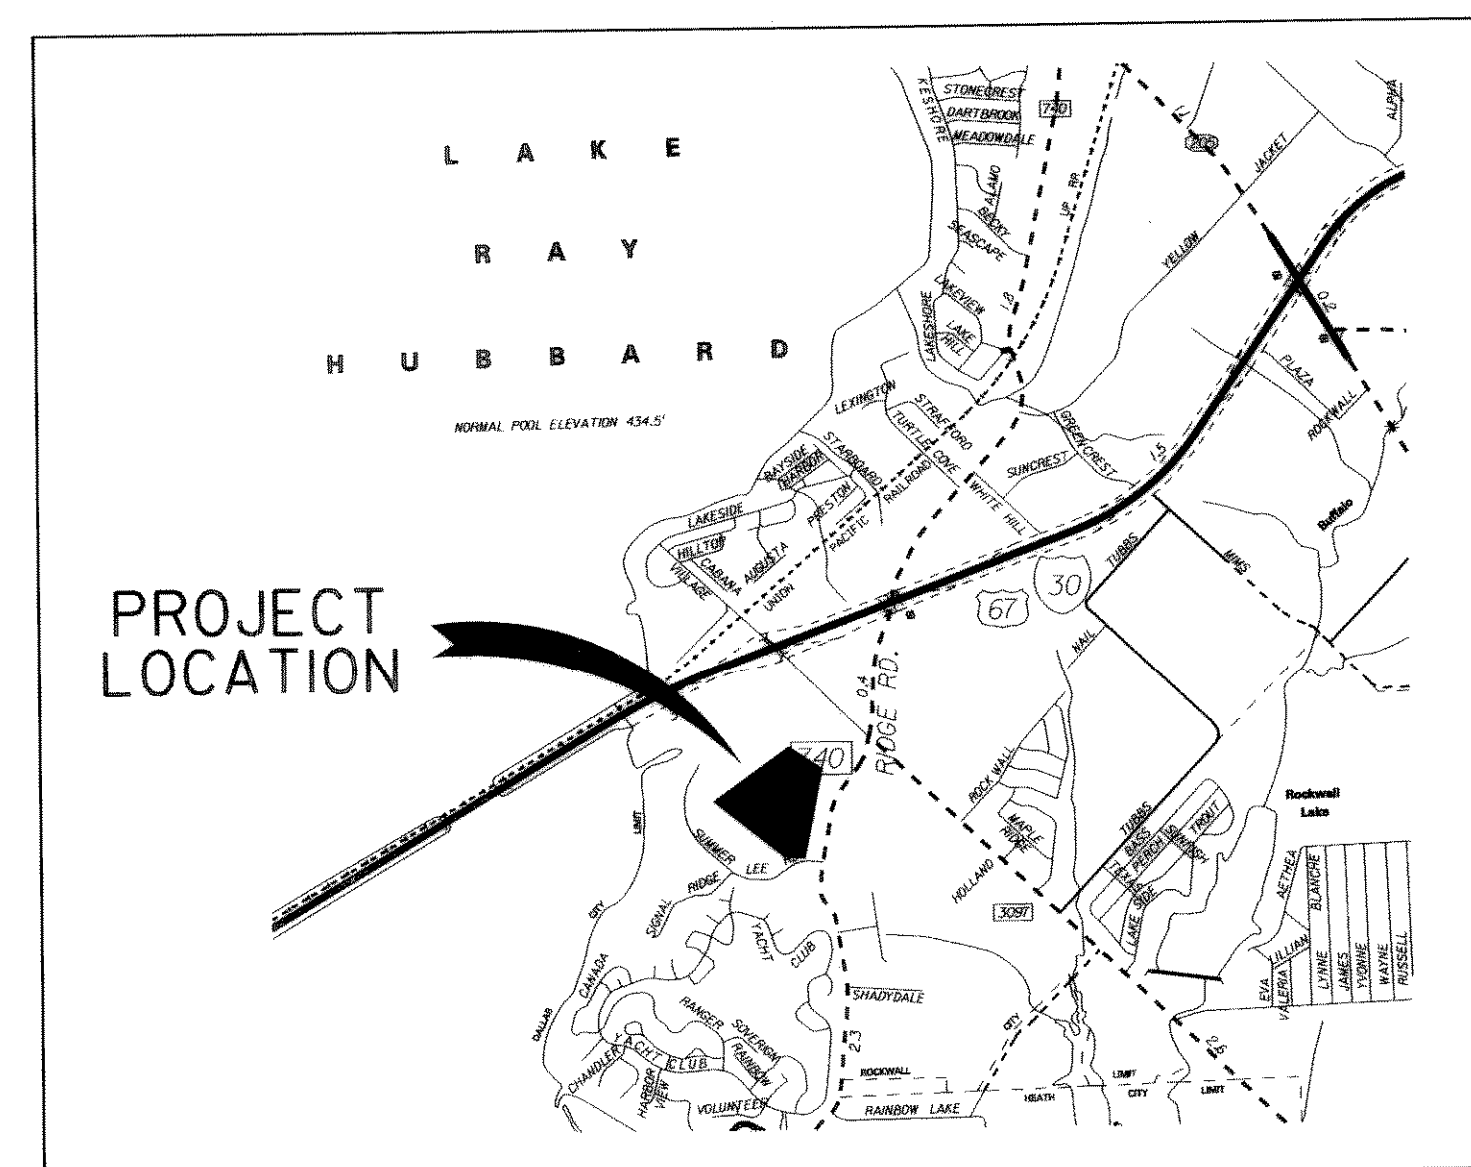

VICINITY MAP
N.T.S.

SHEET INDEX

- COVER SHEET
- FINAL PLAT
- C1. DIMENSION CONTROL
- C2. GRADING PLAN
- C3. DRAINAGE MAP & AREA MAP
- C4. UTILITY PLAN
- C5. SANITARY SEWER & STORM DRAIN PROFILE
- C6. TRAFFIC CONTROL PLAN
- C7. RIDGE ROAD LEFT TURN LANE
- C8. EROSION CONTROL PLAN
- C9. DETAILS


ENGINEER:

Carter :: Burgess

CARTER & BURGESS, INC.
7950 ELMBROOK DRIVE, SUITE 250
DALLAS, TX 75247-4961
(214)638-0145
CONTACT: JAY MARSH

RECORD DRAWINGS

These drawings have been
modified to reflect construction records
provided to the Engineer.

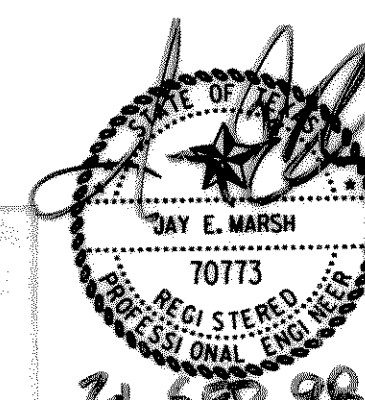

JOB#-UNKNWN PLOTTED Sat Sep 19 08:04:3 1998
USER-CDD
TBL\F\F\PLT-T\BL\NT\B20\L\ANDEVHT.TBL
PRF\F\F\P\B770M\52\C00L\PRF - ROT=0.000000 - SCALE=40.000000

ROCKWALL ASSISTED LIVING ADDITION