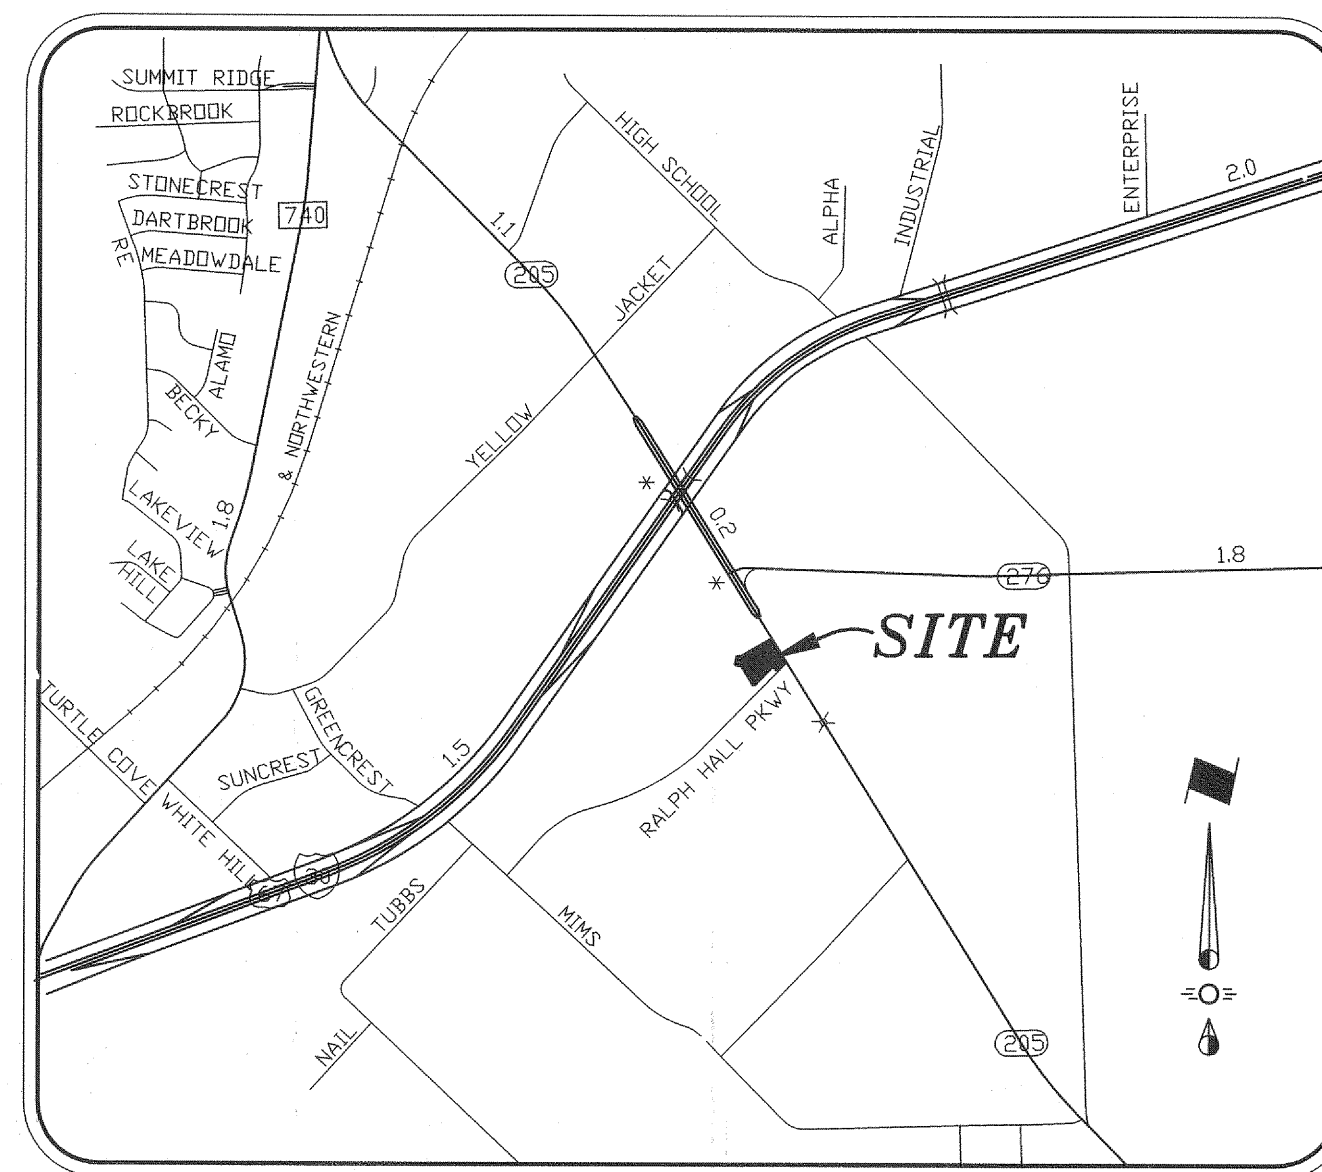


ENGINEERING PLANS

ROCKWALL BUSINESS PARK - LOT 8

ROCKWALL BUSINESS PARK EAST SUBDIVISION

City of Rockwall, Texas



Vicinity Map

NTS
MAPSCO: 300 A

Index Of Drawings

- Cover Sheet
- Recorded Plat
- SP-1 Site Plan
- C 1 Paving Plan
- C 2 Grading Plan
- C 3 Drainage Area Map
- C 4 Utility Plan
- C 5 Erosion Control Plan
- C 6 Site Details
- L-1 Landscape Plan

Prepared For
Matt King - Architect
 1212 Cabernet Drive
 Allen, Texas 75002

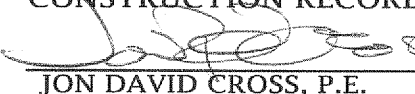
Engineer

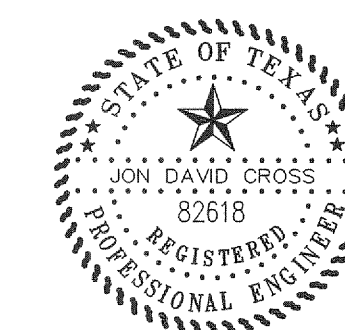
CROSS ENGINEERING CONSULTANTS

131 S. Tennessee St.
972.562.4409

McKinney, Texas 75069
Texas P.E. Firm No. F-5935

AS BUILT

REVISED TO CONFORM TO
CONSTRUCTION RECORDS

 JON DAVID CROSS, P.E.
 12/11/2014
 DATE



ISSUE DATES:	REVISIONS:	DATE	BY
12/20/2013	Revised to Asbuilt conditions	12/8/13	DZ
01/28/2014			

OWNER:
 EPH, LLC.
 6435 S. FM 549
 HEATH, TX. 75032
 Phone (972) 771-2020
 Fax (972) 722-2688
 Contact: Edward Hurst