
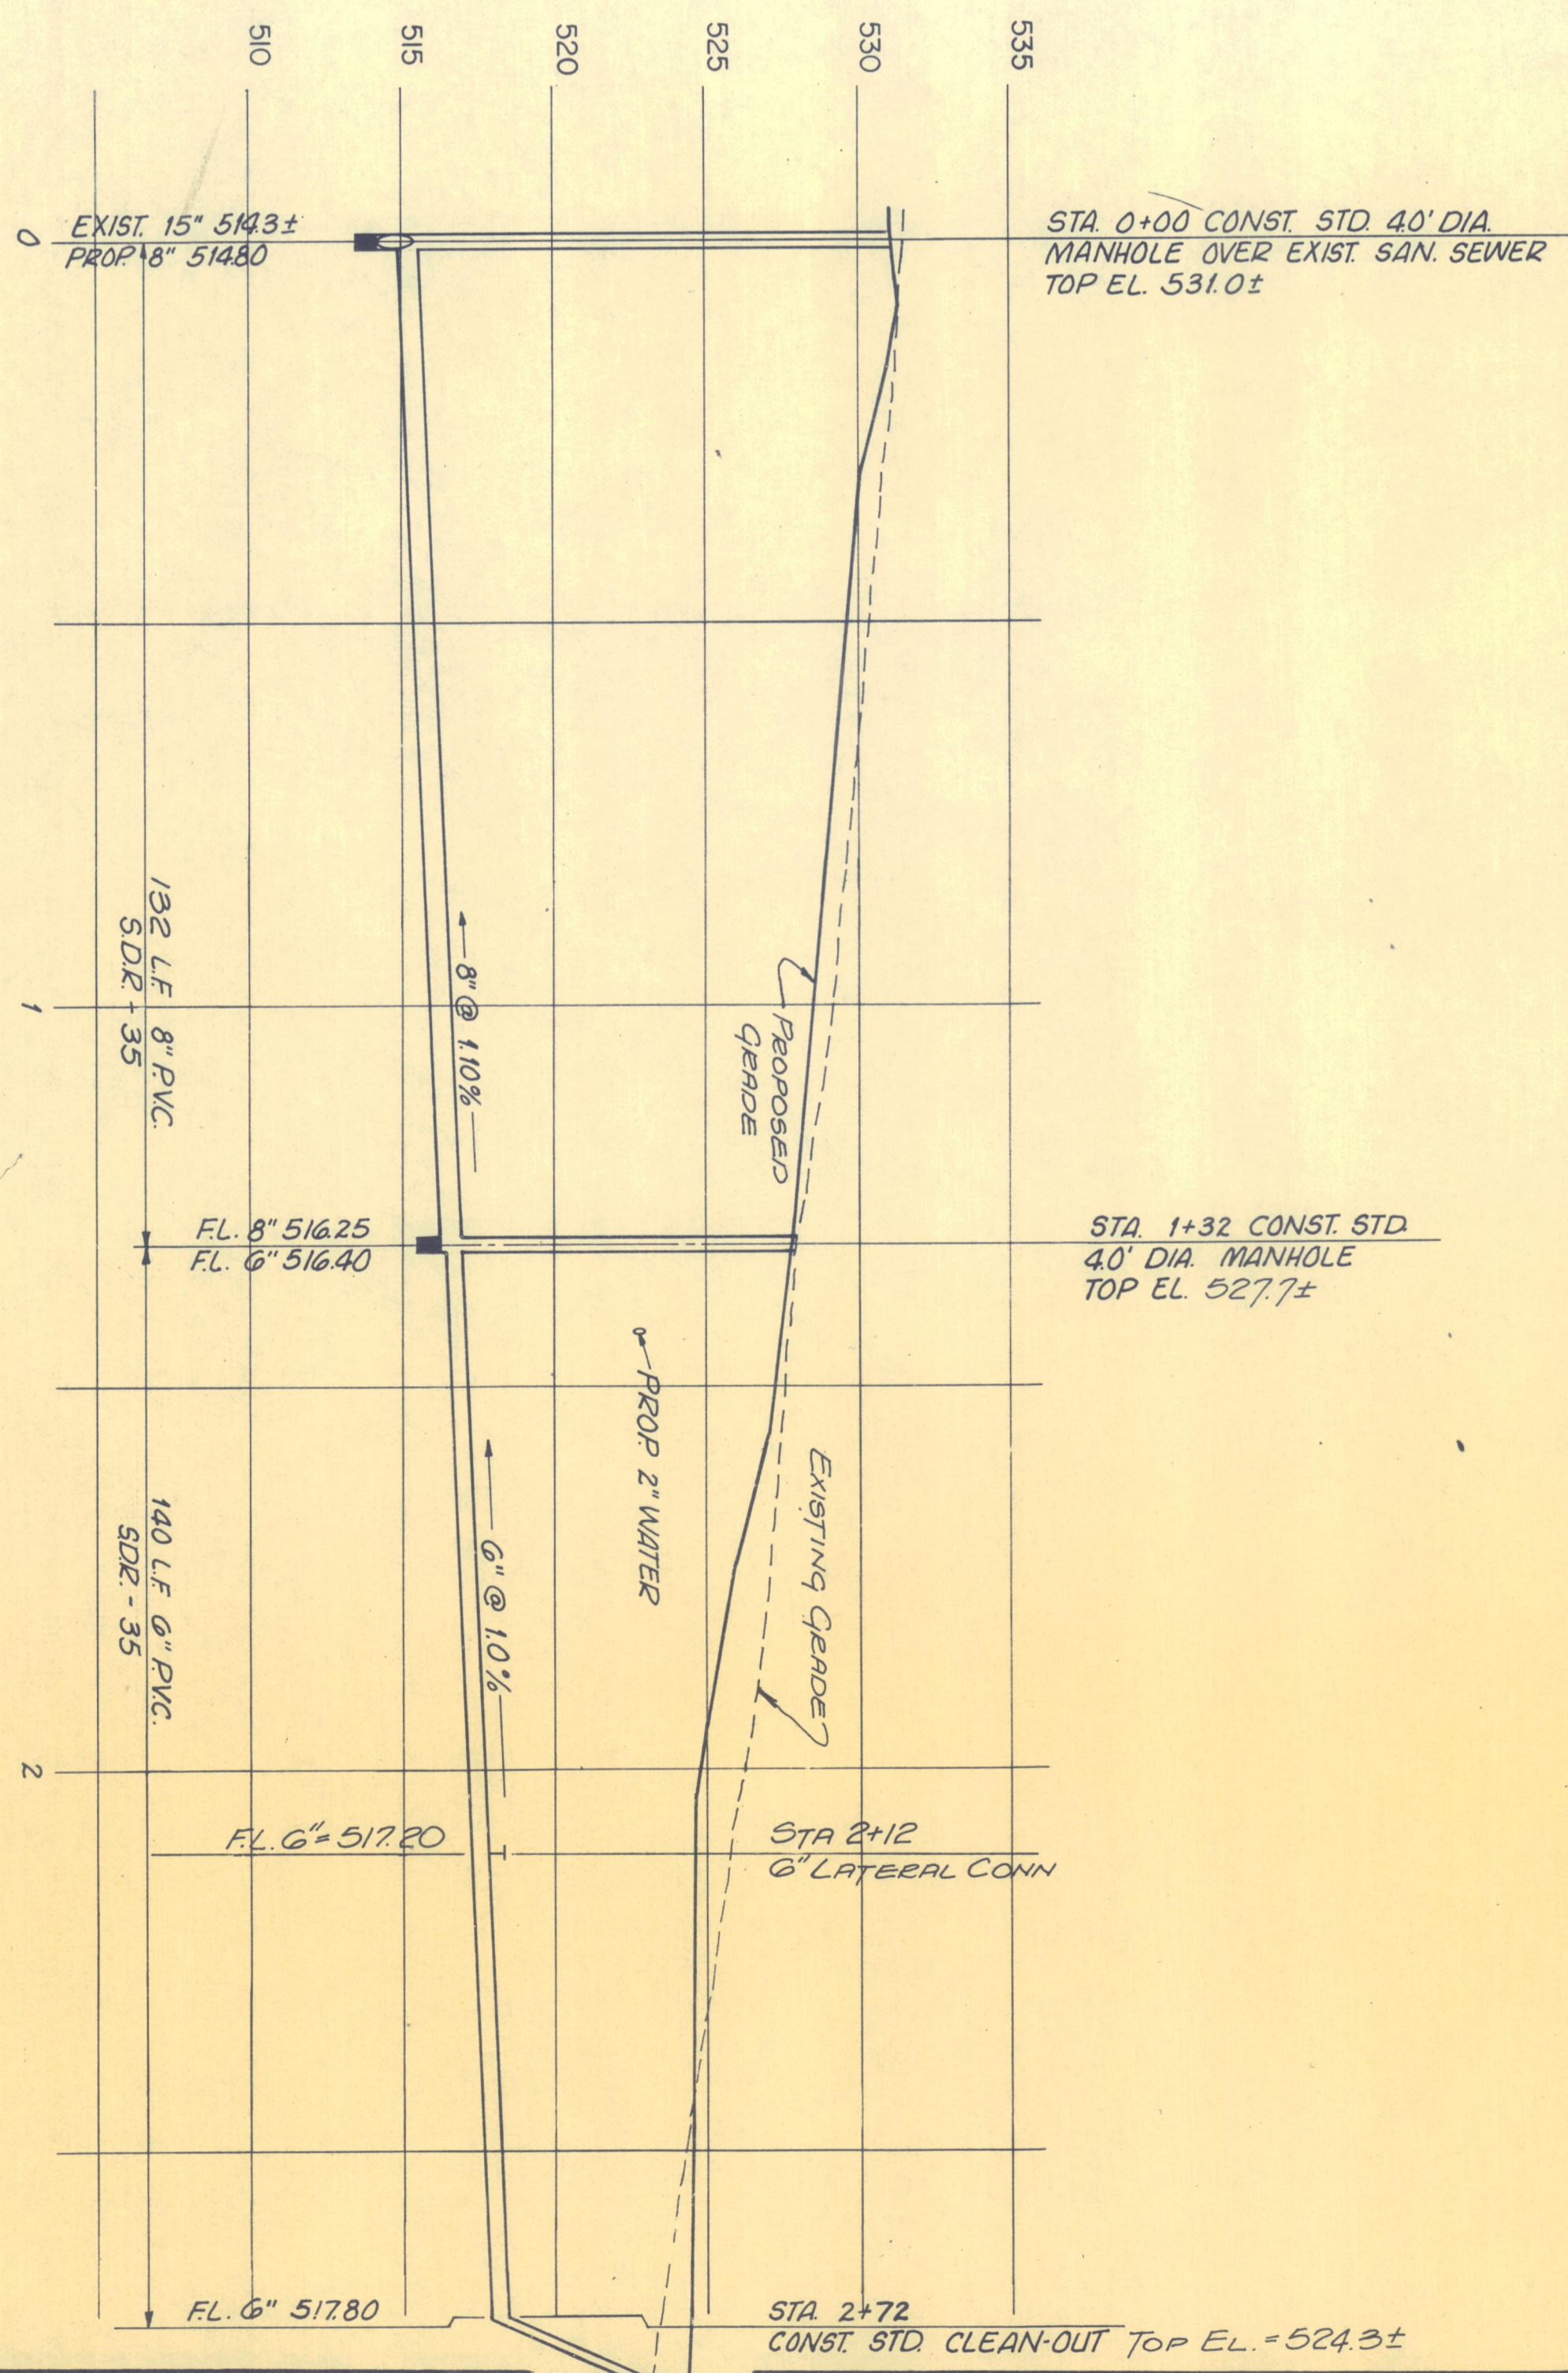


Contractor to verify type and depth of existing utilities prior to construction of retaining wall. Conflicting utilities shall be relocated as necessary.

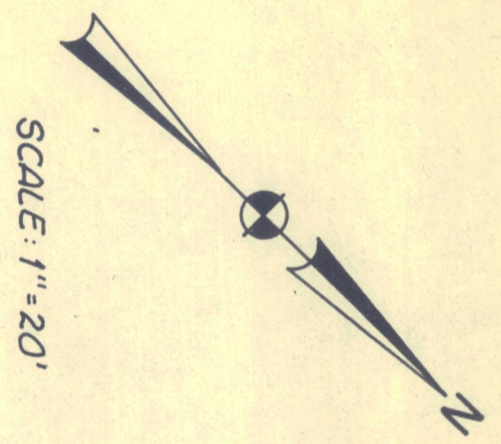

- NOTES:
1. All construction of water and sewer shall conform to the City of Rockwall Standard Specifications and Details for construction. Contractor shall be responsible for obtaining all necessary permits, specifications and details, prior to construction, from the City of Rockwall.
 2. Water pipe shall be class 150, AWWA C-900 - 8" V.C. in accordance with Item 15. of the Standard Specifications.
 3. Sanitary sewer pipe shall be 8" V.C., SDR 35 conforming to ASTM D 3034.
 4. Location of existing utilities is approximate only. Contractor to verify location of existing utilities prior to construction.

BLUM CIVIL
2020 82-452-02

Blum, K. R. 11/23/83

Sheet
of
C3
date: 10-31-83

Job no:
Revisions
REVISED 11/23/83

project : CAR WASH
ROCKWALL BUSINESS PARK EAST ROCKWALL, TEXAS
title : UTILITY PLAN

Haldeman Miller Bregman Hamann 214-526-8444
Architects 3333 Lee Parkway
Planners Suite 500
Interior Designers Dallas, Texas 75219
H M B H