
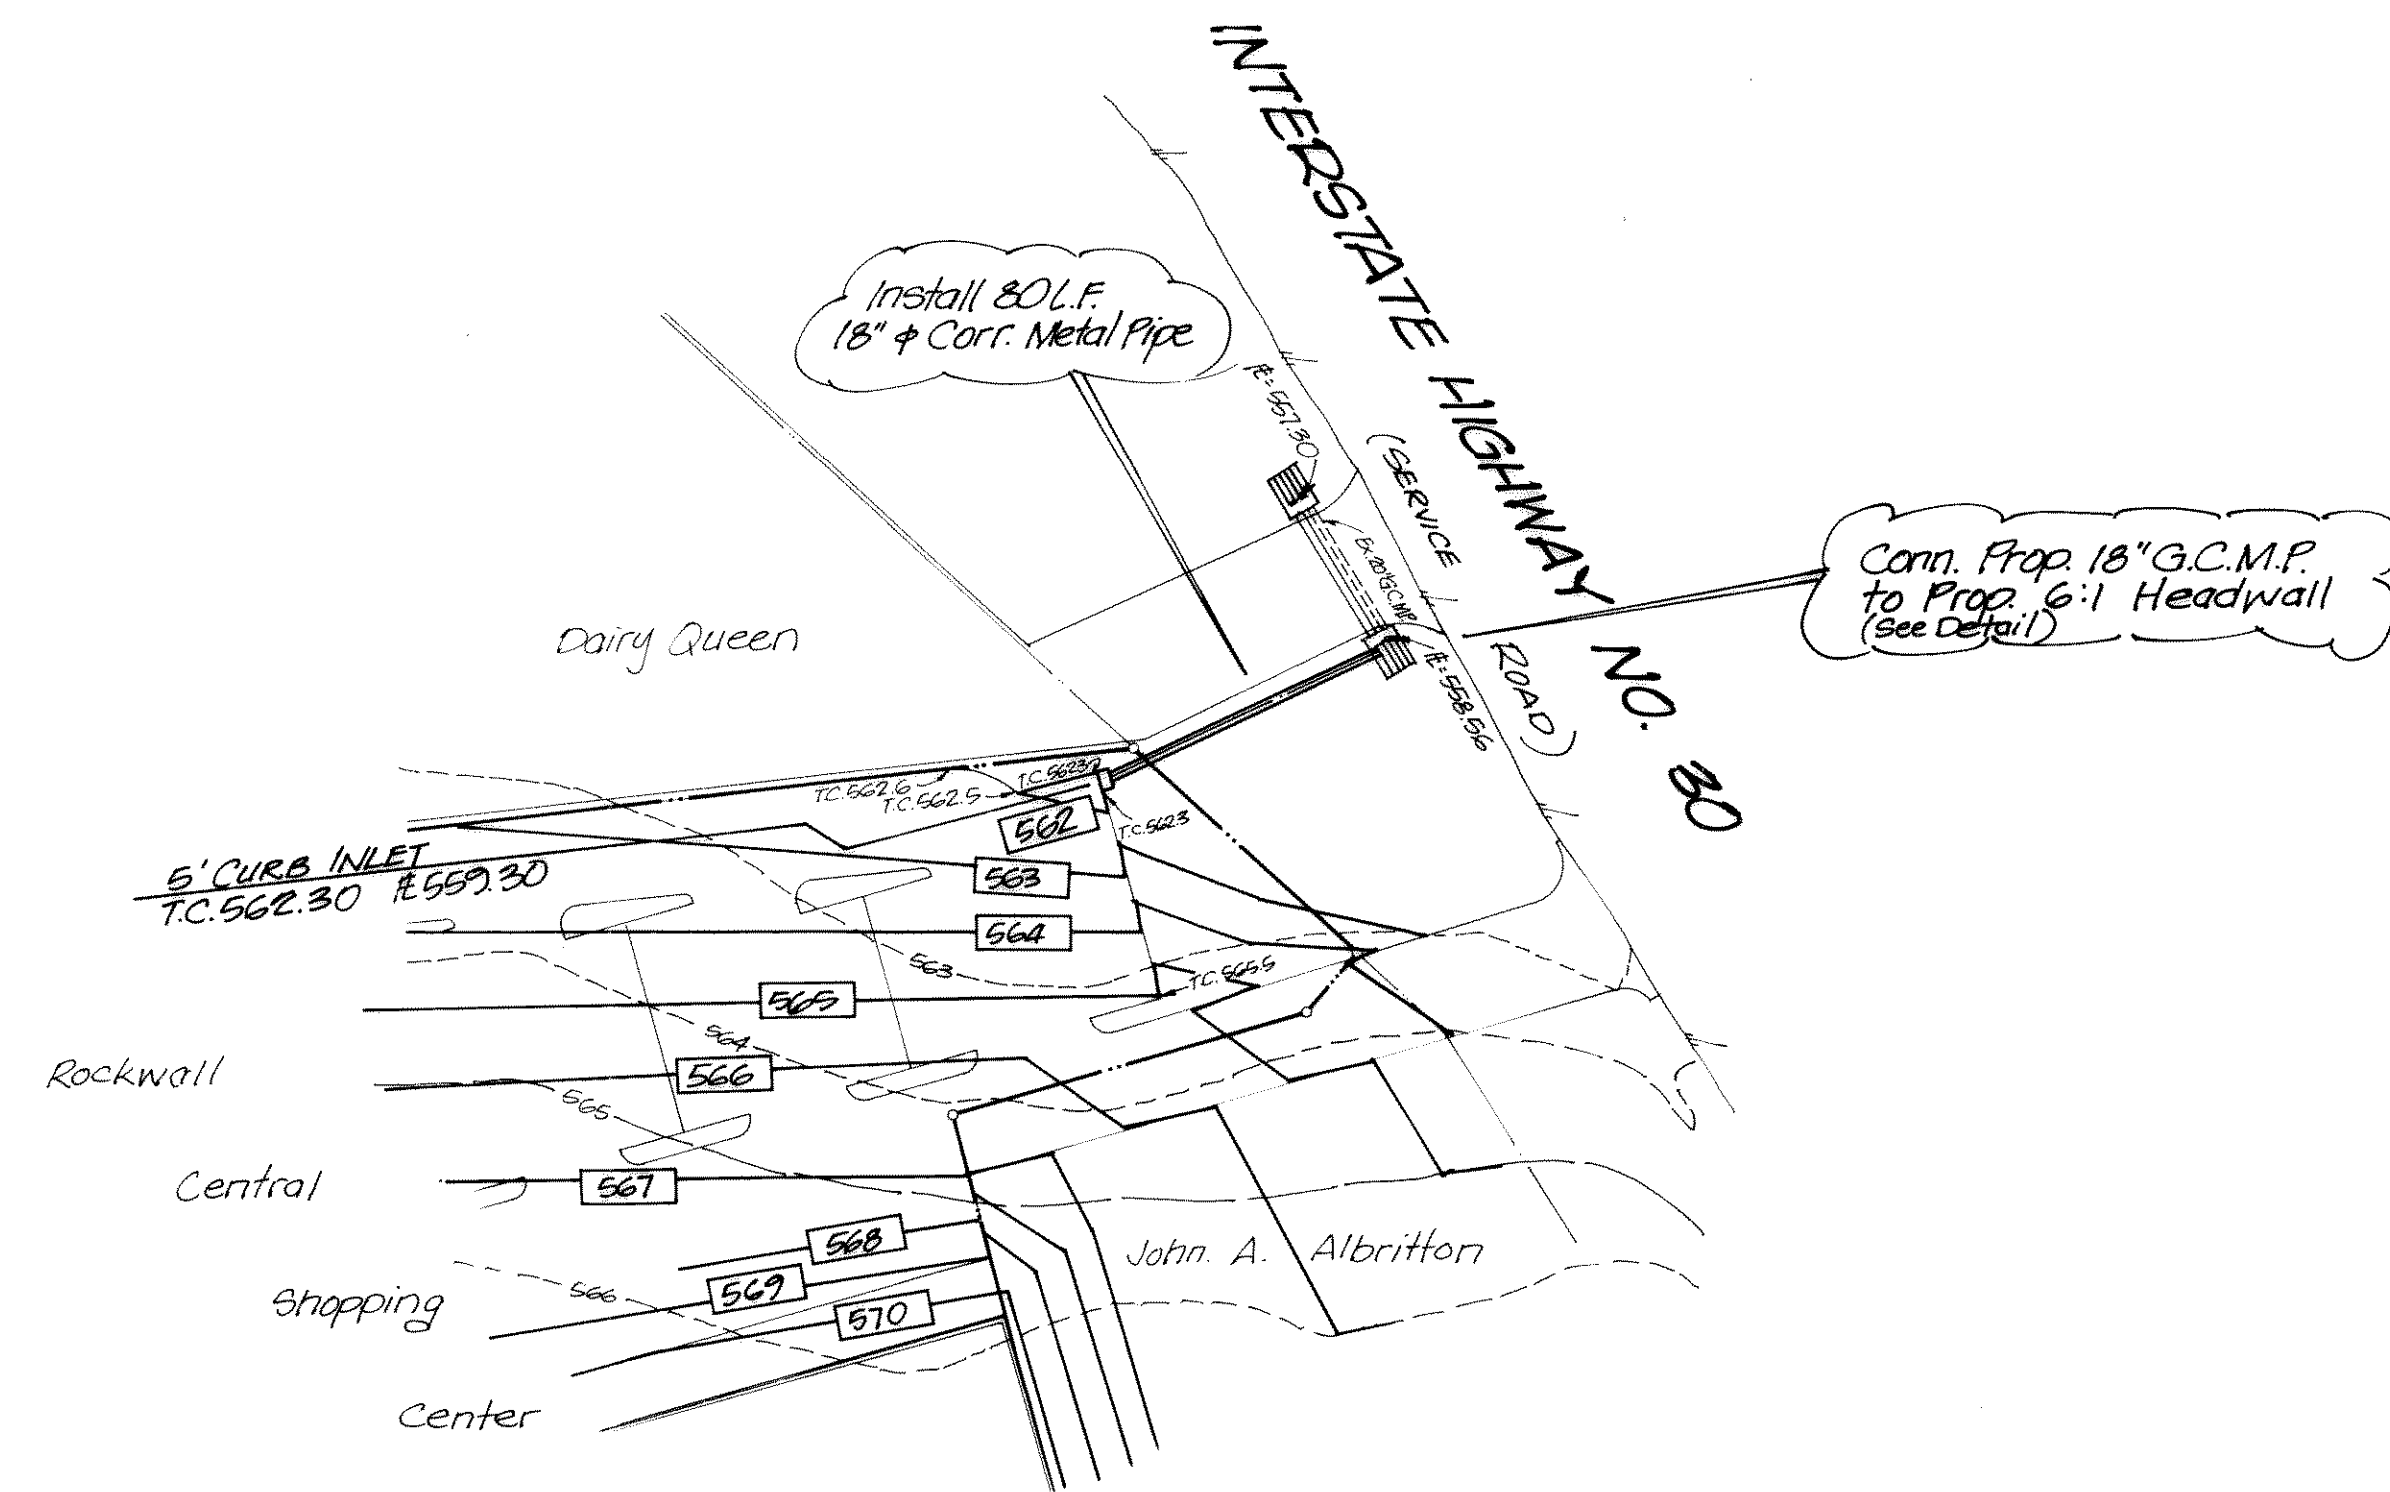


DETAIL

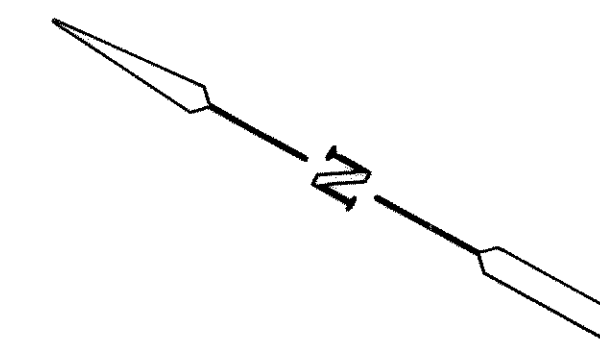

AS BUILT

3A

HAROLD L. EVANS CONSULTING ENGINEER 2331 GUS THOMASSON RD., SUITE 102 DALLAS, TEXAS 75228 PHONE (214) 328-8133			DRAINAGE STRUCTURE REVISION ROCKWALL CENTRAL SHOPPING CENTER CITY OF ROCKWALL ROCKWALL COUNTY, TEXAS		
SCALE	DATE	JOB NO.			
1"=50'	3-13-86	84288			