

SITE IMPROVEMENT PLANS FOR ROCKWALL CENTRE CORNERS

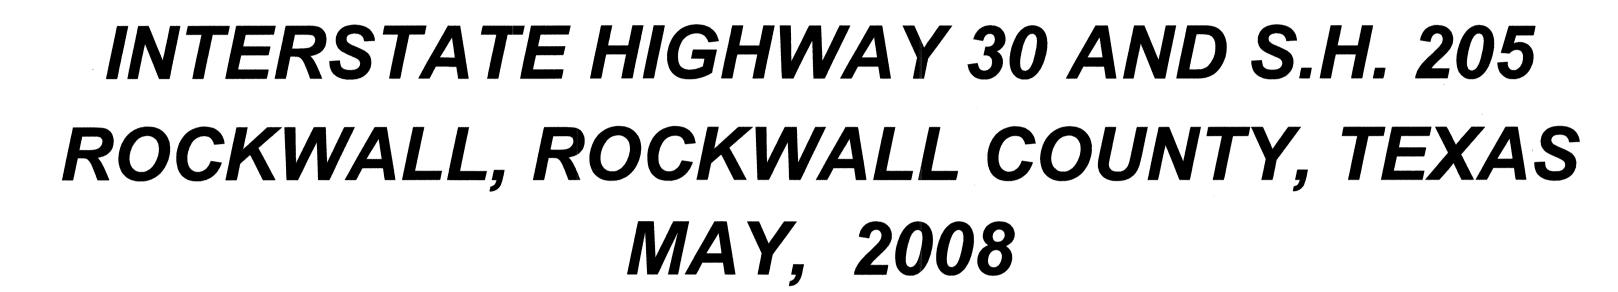

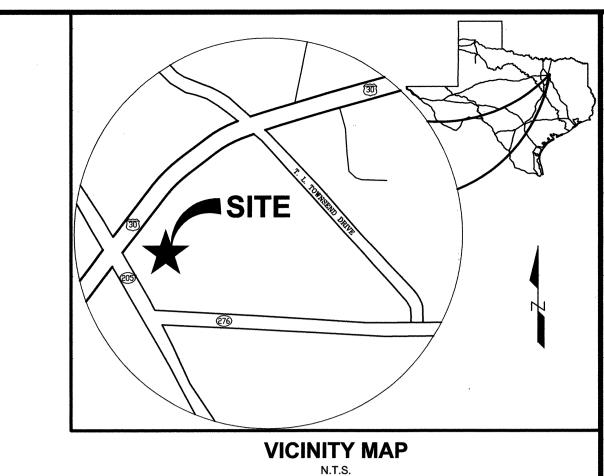

Dallas, Texas 75240 Phone: 972.490.1515 Authorization No. F483

C 2008

Engineers

Construction

		₩	03/02/09	△ 03/05/09 PER RFI	WAS	8	05/04/09	WAS 🛕 05/04/09 PER AS-BUILTS	W
		₩	11/21/08	11/21/08 PER CLIENT REQUEST	WAS	8	01/09/09	WAS 🔝 01/09/09 PER CLIENT REQUEST	W
		∇	10/03/08	10/03/08 PER RFI #1	WAS	8	11/06/08	WAS 🛕 11/06/08 PER RFI	W
		V	80/80/60	🛕 09/08/08 PER RFI #1 AND #2	WAS	Ø	09/23/08	WAS 🛕 09/23/08 PER CO#1 AND RFI #3	W
by:	HWH	V	80/08/90	🛕 06/30/08 PER COSTCO ENGINEERING PLANS WAS	WAS	₩	08/04/08	△ 08/04/08 PER CPH REVIEW	W
	HWH	∇	06/10/08	▲ 06/10/08 PER COSTCO ENGINEERING PLANS WAS		W	06/26/08	1	M
.; ;	WAS	V	05/23/08	05/23/08 PER CITY COMMENTS 5/21/08	WAS	W	90/60/90	⚠ 06/03/08 PER CITY COMMENTS 5/29/08	W
by:	WAS	$ \nabla$	80/90/50	05/06/08 PER COSTCO PLANS	WAS	₩	05/19/08	A 05/19/08 PER COSTCO PLANS / CITY COMMENTA /	189
	N.T.S.	8	01/29/08	▲ 01/29/08 PER CITY COMMENTS 12/06/07	WAS	8	03/07/08	▲ 03/07/08 PER CITY COMMENTS 02/01/08	W
	10/19/2007	$ \nabla$	11/15/07	10/19/2007 🛕 11/15/07 PER CITY COMMENTS 11/05/07	WAS	\blacksquare	12/05/07	▲ 12/05/07 PER CITY COMMENTS 11/26/07	W
	S13217	lacksquare	10/19/07	10/19/07 PER CLIENTS NEW SITE LAYOUT	WAS	$ \nabla$	10/31/07	▲ 10/31/07 PER CITY COMMENTS 10/22/07	%
	COVER	No.	Date	Revision	By	No.	Date	Revision	B

ROCKWALL TERSTATE HIGH PROCKWALL

AUTHORIZED BY WILLIAM A. STUEBER, P.E. 90436 ON 05/04/2009 . ALTERATION OF A SEALED DOCUMENT TO THE RESPONSIBLE ENGINEER IS AN OFFENSE UNDER THE TEXAS ENGINEERING

A. STUEBER

Sheet No.

INDEX OF SHEETS

								11 412 117
		AAAA			<u>A</u> A			
						<u>\$</u>		C-2
						$\triangle A$	<u> </u>	10F2
								20F2
		A	<u> </u>			图 图		C-5
							A	C-6
<u>k</u>	<u>\delta</u>	A	Λ		$\mathbb{A}\mathbb{A}$	A	A A	C-7
L	<u></u>	A	$\stackrel{oldsymbol{\Lambda}}{oldsymbol{\Lambda}}$			A	A A	Z C-8
L	<u> </u>		Δ		\triangle	<u>\$</u>		C-8A
								C-9
			Δ		ΑÆ		A A	C-10
			A	$\triangle \overline{\triangle}$				C-10A
A	A A	<u>∕</u> A	$\Delta \Delta \Lambda$		A A			
A	<u>A</u> A	A						
	<u> </u>	A	213 212 213	\triangle	A	257 247		C-13
<u>A</u>		A	A			A A A		
<u> </u>	•		<u> </u>		<u> </u>			
<u> 22</u>		<u> </u>	٨					
<u> 22</u>	•	A			۸ ۸			C-15A
& & & & & &		A						
<u> 23</u>								
2 2			AA		$\triangle A$	A		C-17A
		A A						∆ C-18
		<u> 1</u>	Δ		$\triangle A$			∆ C-19
							Â	C-20
								C-21
				Λ			A	C-22
			A					C-23
			A					C-24
								-

▲ ▲ L-2

△ △ F-1

COVER SHEET GENERAL NOTES FINAL PLAT FINAL PLAT EROSION CONTROL / SWPPP PLAN EROSION CONTROL / SWPPP DETAILS OVERALL SITE PLAN SITE DIMENSION PLAN SITE DIMENSION PLAN PRE - DRAINAGE AREA MAP **POST - DRAINAGE AREA MAP** DRAINAGE CALCULATIONS OVERALL GRADING PLAN **GRADING PLAN** 9'X5' DRAINAGE BOX CULVERT PLAN AND PROFILE STORM DRAINAGE PLAN STORM DRAINAGE PROFILES STORM DRAINAGE PROFILES & CALCULATIONS **COMPOSITE UTILITY PLAN** COMPOSITE UTILITY PLAN COMPOSITE UTILITY PLAN PUBLIC WATER LINE PROFILES - LINES 'W-1' AND 'W-2' SANITARY SEWER PROFILES STORM DRAINAGE DETAILS STORM DRAINAGE DETAILS STORM DRAINAGE AND PAVEMENT DETAILS **KEYSTONE RETAINING WALL KEYSTONE RETAINING WALL**

EXISTING TREE SURVEY TREE MITIGATION PLAN 100 YEAR FLOOD PLAIN MITIGATION PLAN

BARRICADE AND CONSTRUCTION GENERAL NOTES AND REQUIREMENTS BC(1)-07

TXDOT INDEX OF SHEETS

				(-,
T-2	BARRICADE AND	CONSTRUCTION PROJECT LIMIT STANDARD	BC(2)-07	

BARRICADE AND CONSTRUCTION WORK ZONE SPEED LIMIT STANDARD BARRICADE AND CONSTRUCTION TEMPORARY SIGN NOTES STANDARD

BARRICADE AND CONSTRUCTION TYPICAL SIGN SUPPORT STANDARD

BARRICADE AND CONSTRUCTION PORTABLE CHANGEABLE MESSAGE SIGN (PCMS) STANDARD

BARRICADE AND CONSTRUCTION ARROW PANEL, REFLECTORS, WARNING LIGHTS & ATTENUATOR STANDARD BC(7)-07

T-8 BARRICADE AND CONSTRUCTION CHANNELIZING DEVICES STANDARD BC(8)-07

BARRICADE AND CONSTRUCTION CHANNELIZING DEVICES STANDARD BC(9)-07 T-10 BARRICADE AND CONSTRUCTION CHANNELIZING DEVICES STANDARD BC(10)-07 T-11 BARRICADE AND CONSTRUCTION PAVEMENT MARKINGS STANDARD BC(11)-07

T-12 BARRICADE AND CONSTRUCTION PAVEMENT MARKING PATTERNS STANDARD BC(12)-07

T-13 TRAFFIC CONTROL PLAN TCP(2-6)-98

T-14 TYPICAL STANDARD PAVEMENT MARKINGS PM(1)-03

T-15 POSITION GUIDANCE USING RAISED MARKERS REFLECTORIZED PROFILE MARKINGS

T-16 PAVEMENT MARKINGS FOR TWO-WAY LEFT TURN LANES, DIVIDED HIGHWAYS, AND RURAL LEFT TURN BAYS PM(4)-03

T-17 STANDARD PAVEMENT MARKINGS (WORDS) PM(5)-01

T-18 STANDARD PAVEMENT MARKINGS (ARROWS) PM(6)-01

T-19 WORKSHEET FOR EDGE CONDITION TREATMENT TYPES

T-20 CONTINUOUSLY REINFORCED CONCRETE PAVEMENT CRCP(1)-03

T-21 CONCRETE PAVEMENT DETAILS CPCD-94

T-22 CONCRETE PAVEMENT DETAILS JOINT SEALS JS-94

T-23 TEMPORARY EROSION, SEDIMENT AND WATER POLLUTION CONTROL MEASURES EC(1)-93

T-24 TEMPORARY EROSION, SEDIMENT AND WATER POLLUTION CONTROL MEASURES EC(2)-93

T-25 TEMPORARY EROSION, SEDIMENT AND WATER POLLUTION CONTROL MEASURES EC(3)-93

T-26 FULL DEPTH REPAIR FOR CONCRETE PAVEMENT FDR (CP) - 05

RECORD DRAWING PRACTICE ACT.

TO THE BEST OF OUR KNOWLEDGE CPH ENGINEERS, INC., HEREBY STATES THAT THIS PLAN IS A REPRESENTATION OF THE AS-BUILT CONDITIONS OF THE SUBJECT PROJECT. THE INFORMATION PRESENTED IS BASED ON INFORMATION PROVIDED BY THE CONTRACTOR ALONG WITH DATA PROVIDED BY THE PROJECT LAND SURVEYOR.

THE SIZE OF THIS PLAN MAY HAVE BEEN SLIGHTLY ALTERED BY REPRODUCTION PROCESSES, THIS MUST BE CONSIDERED WHEN SCALING ANY REPRODUCED

OWNER/DEVELOPER

DALLAS, TEXAS 75248

ATTN: TROY BATHMAN

C.P.H. ENGINEERS. INC.

DALLAS, TEXAS 75240

ATTN: WILLIAM A. STUEBER, P.E.

5728 LBJ FREEWAY

16910 DALLAS PKWY, STE 100

ST. IVES REALTY

(972) 235-7888

ENGINEER

SUITE 330

(972) 490-1515

GAS SERVICE

ATMOS ENERGY

(972) 485-6277

1310 STATE HIGHWAY 66

GARLAND. TEXAS 75040

ATTN: DINAH WOOD

ELECTRIC SERVICE

McKINNEY, TEXAS 75069

ATTN: RUSSELL M. LEWIS

400 W. VIRGINIS

(972) 569-6310

TXU ELECTRIC DELIVERY COMPANY

NEW CONSTRUCTION MANAGER

CITY ENGINEER

(972) 771-7746

TXDOT

TXDOT

CITY OF ROCKWALL

ATTN: CHUCK TODD

4777 E. HIGHWAY 80

ATTN: JIM BRUMMETT

(214) 320-4447

MESQUITE TEXAS 75150

TELEPHONE SERVICE

GREENVILLE. TEXAS 75401

ATTN: CAROLYN NAYLOR

2702 WESLEY STREET

(903) 457-2092

385 S. GOLIAD STREET

ROCKWALL, TEXAS 75087