

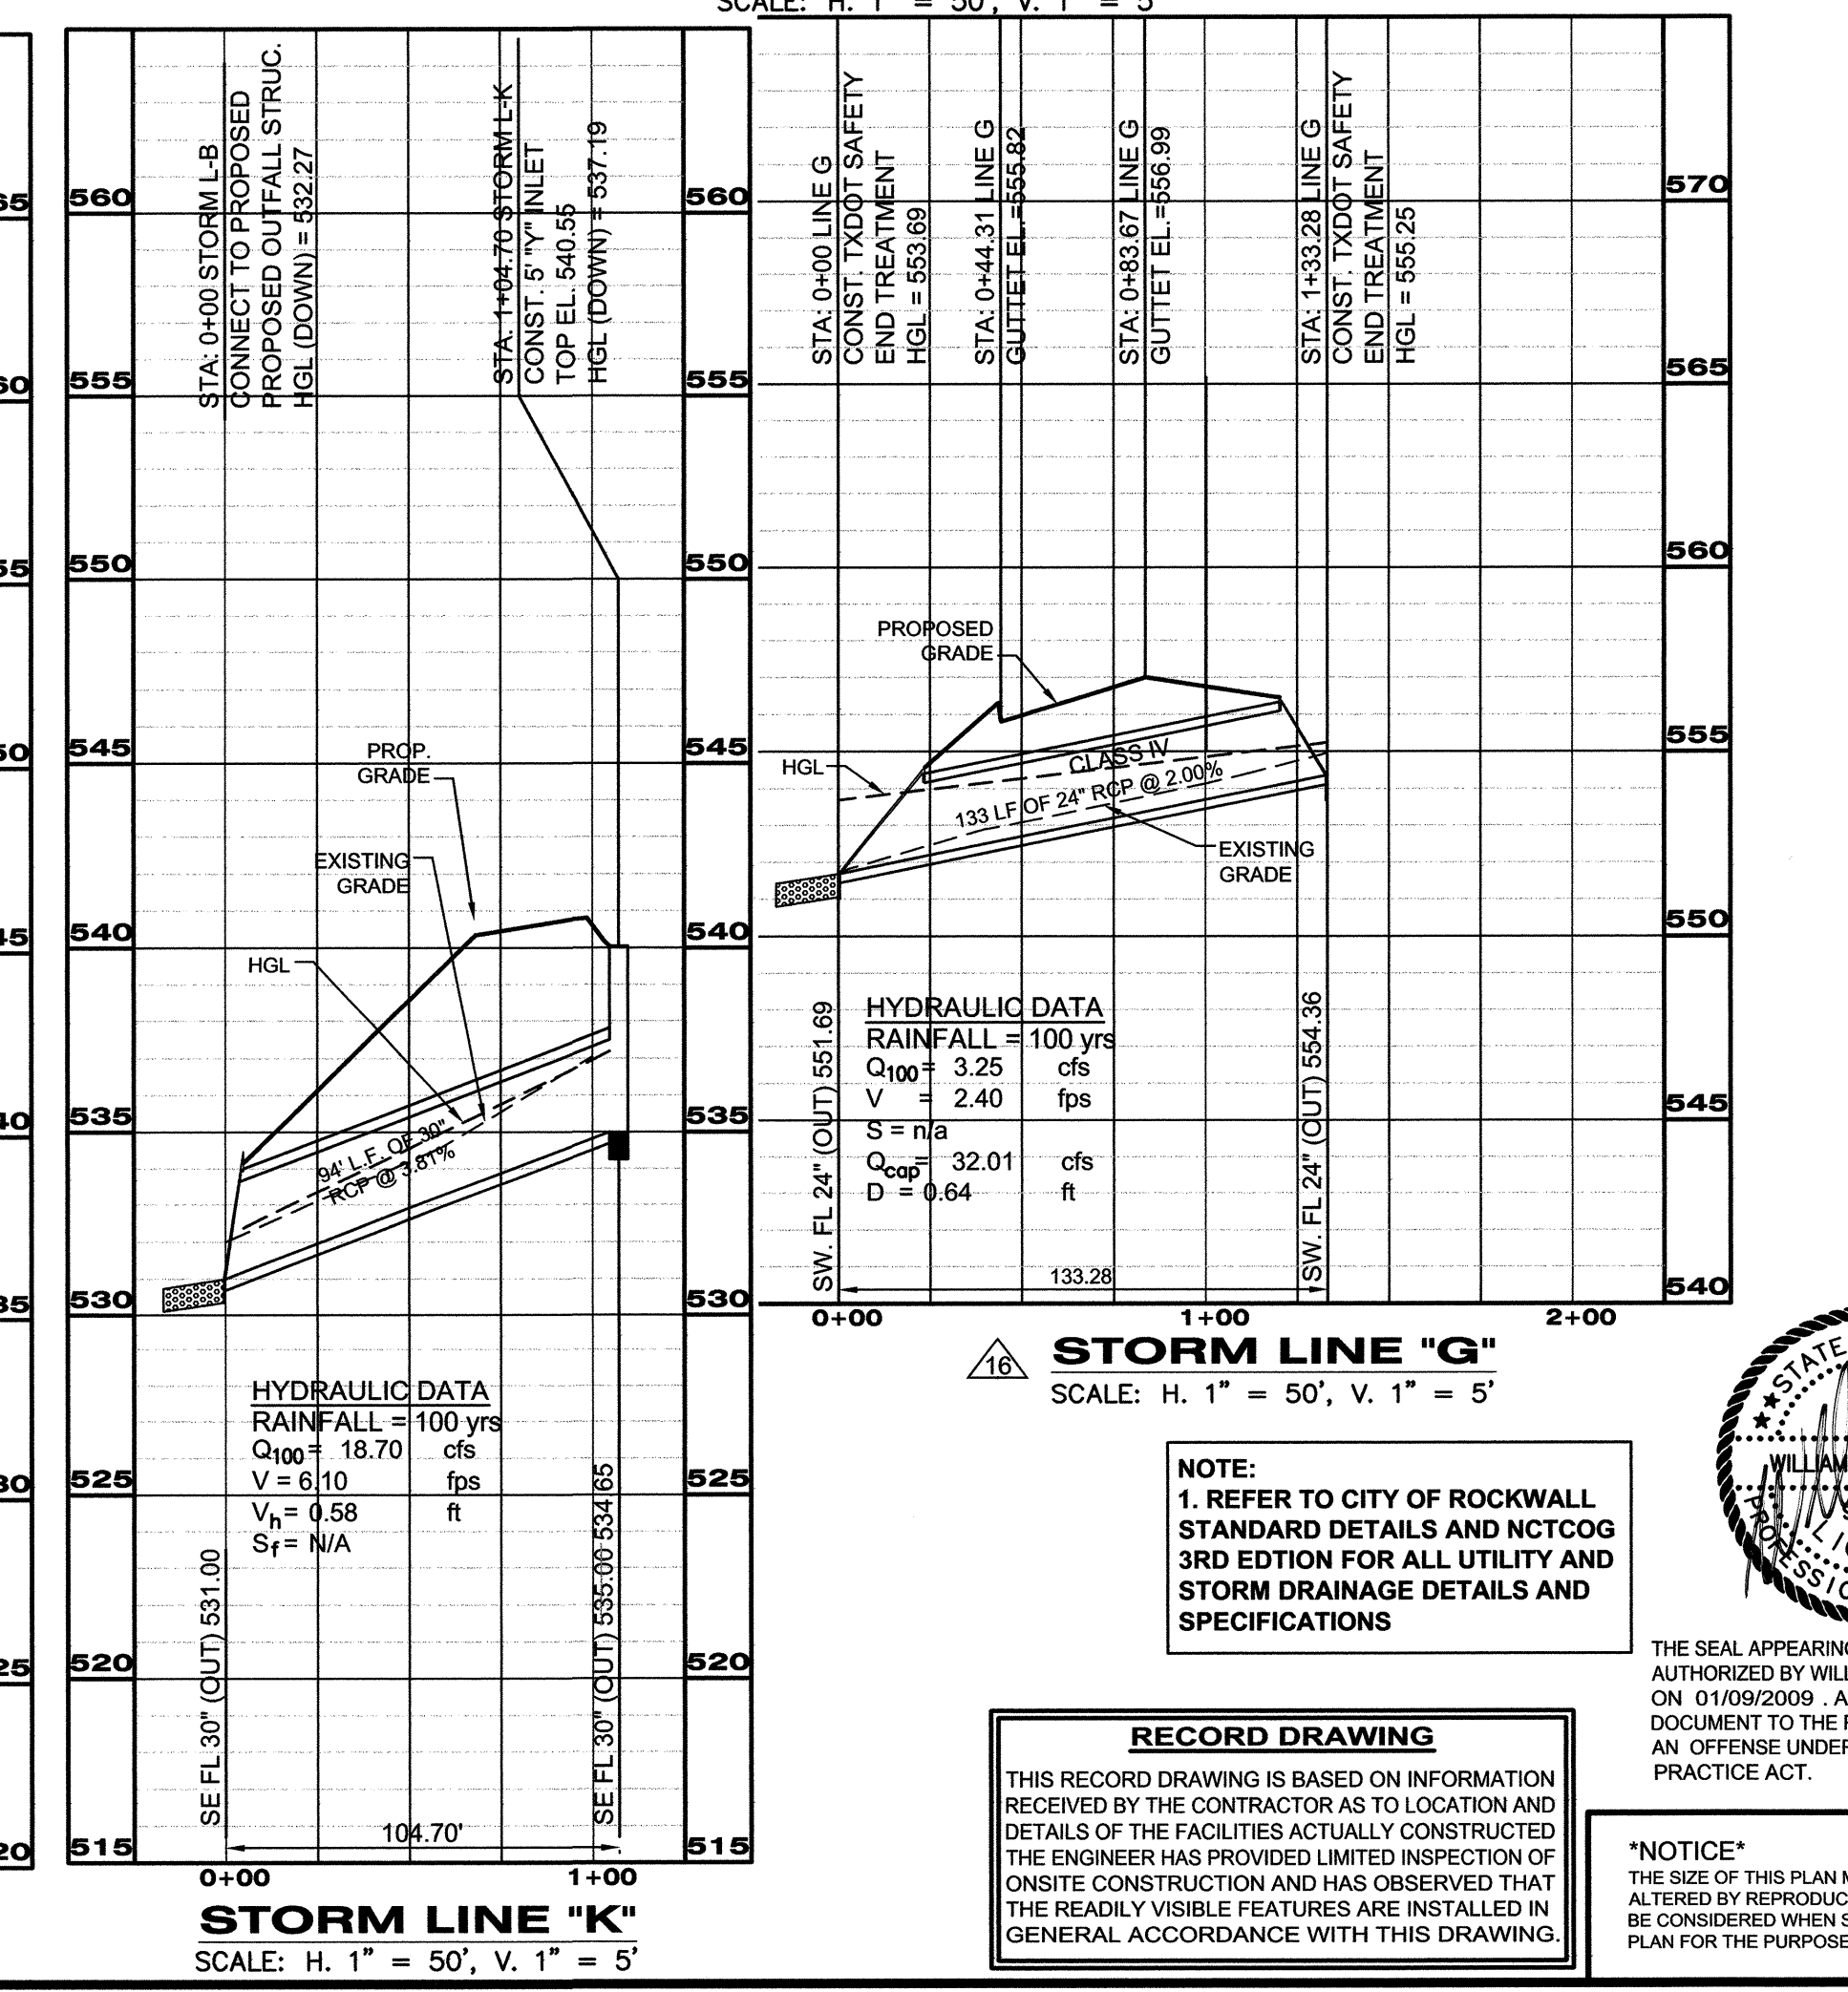
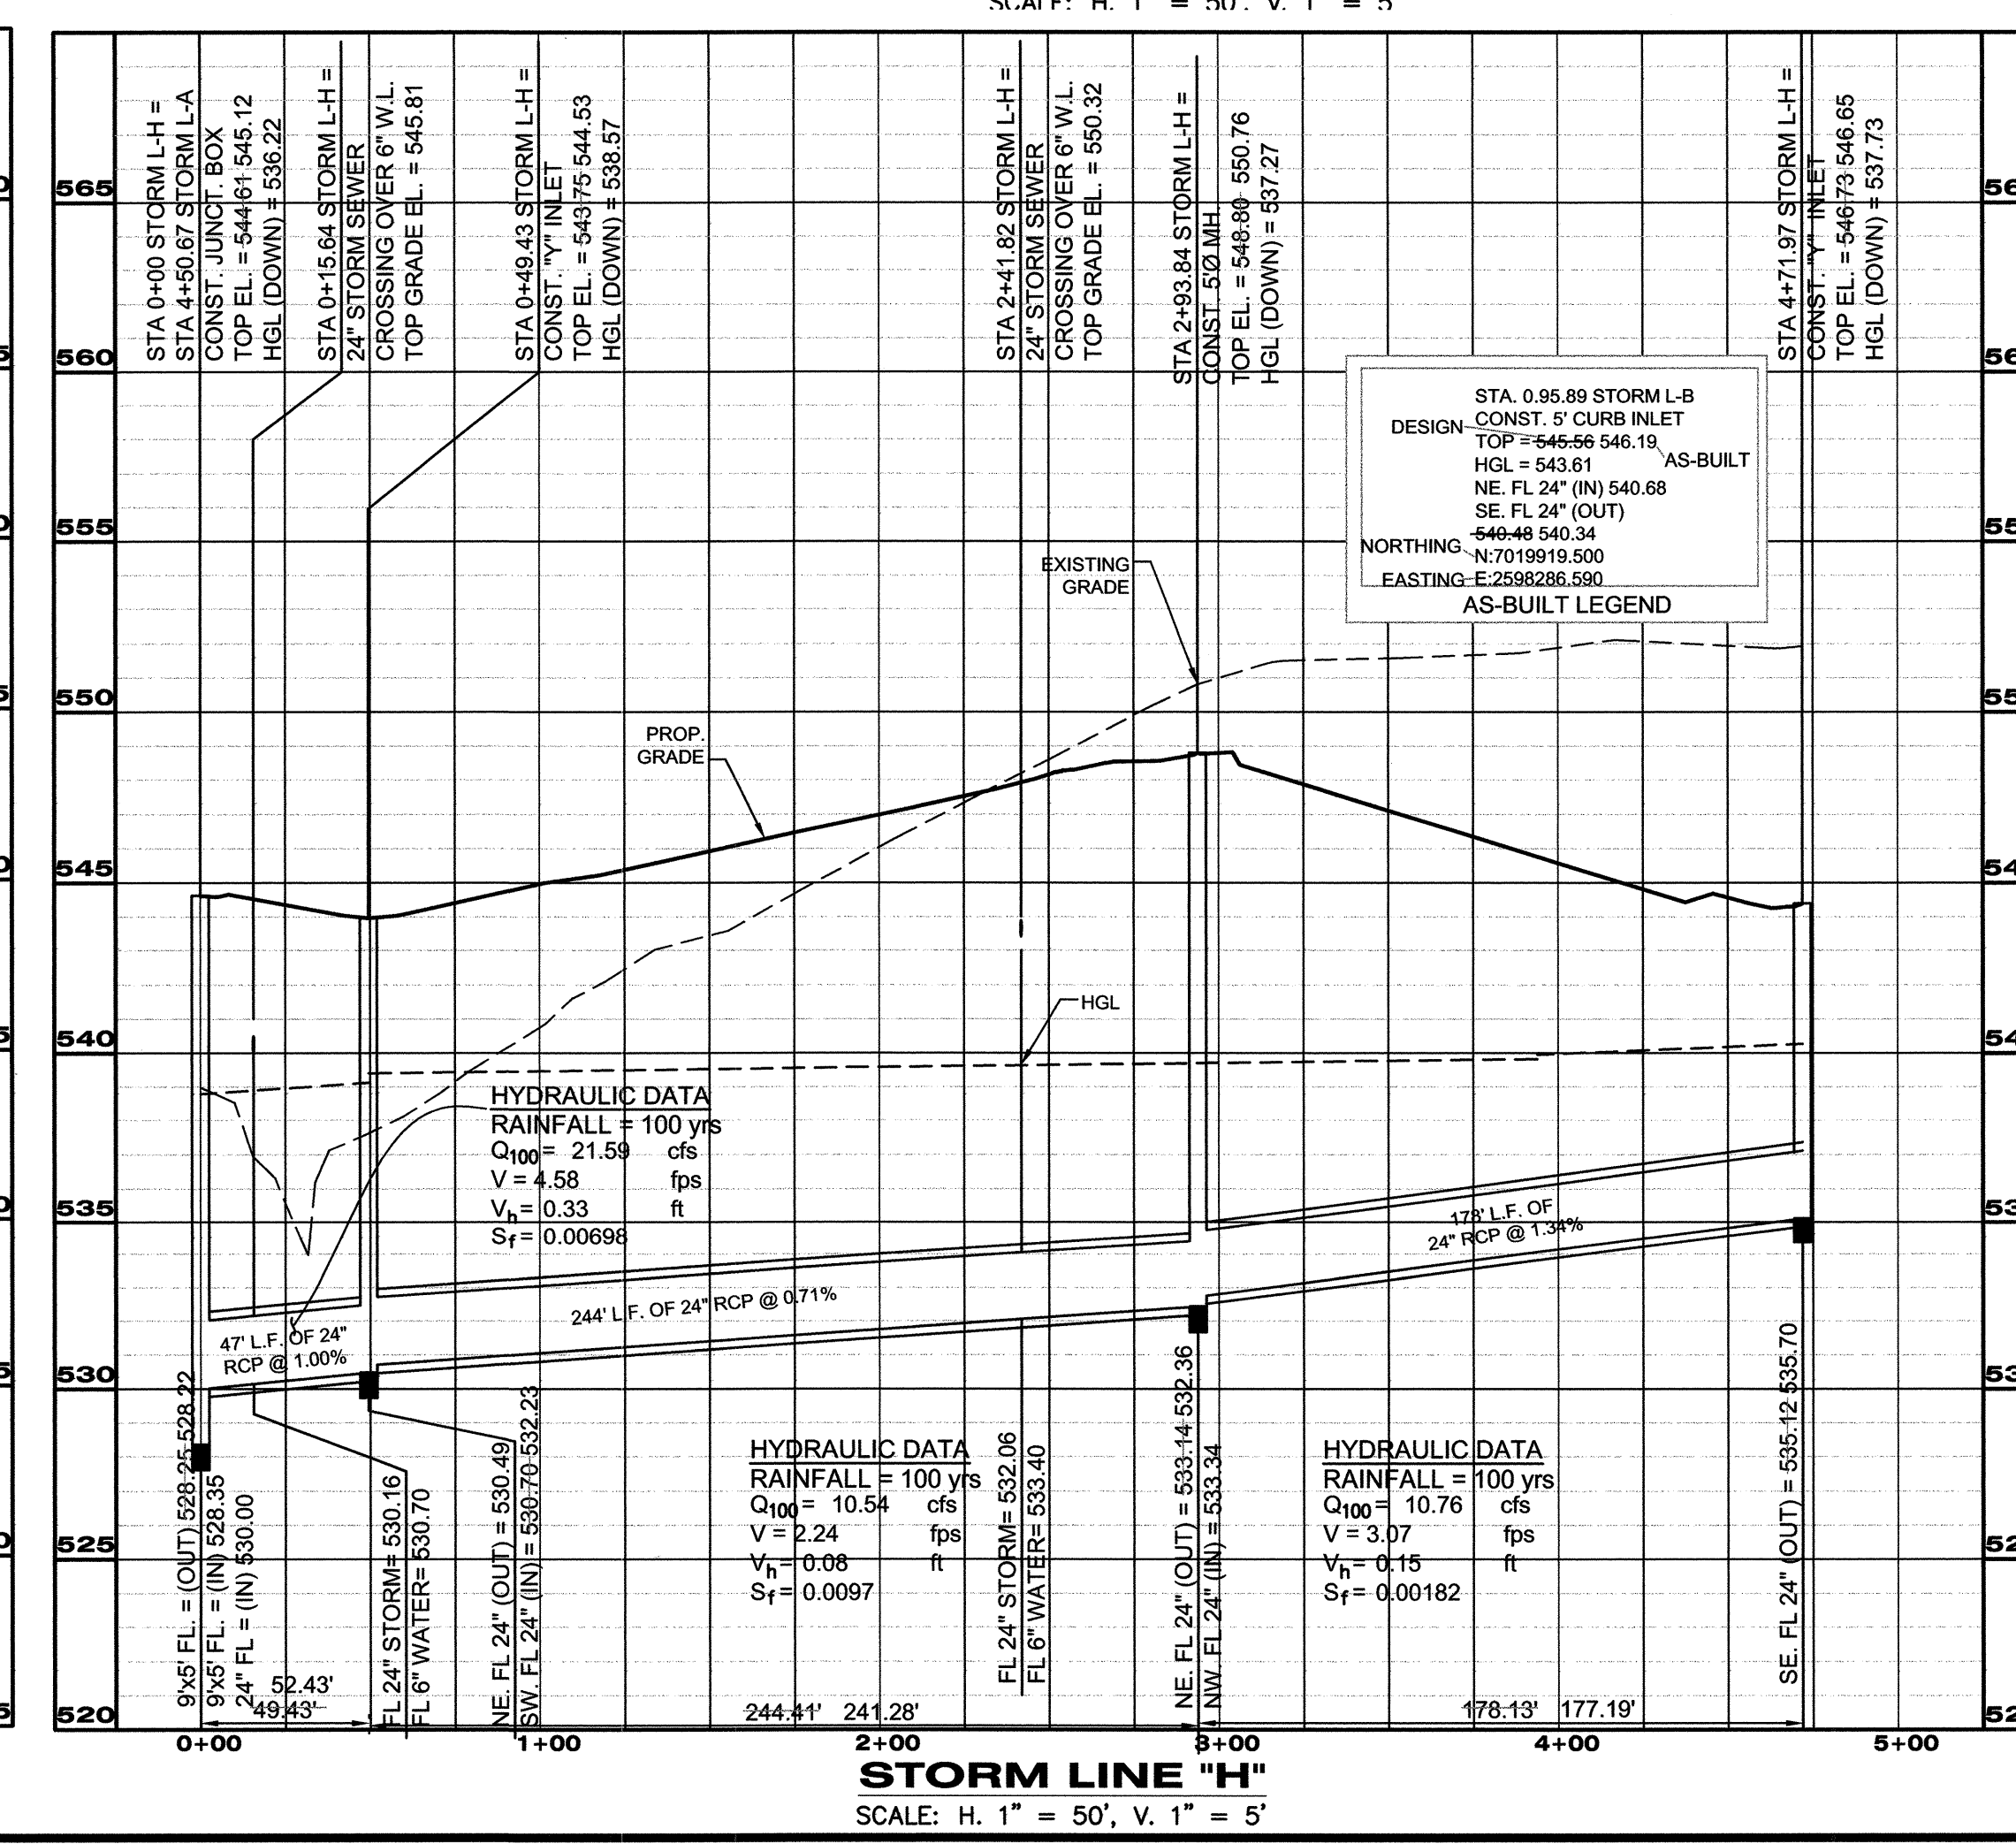
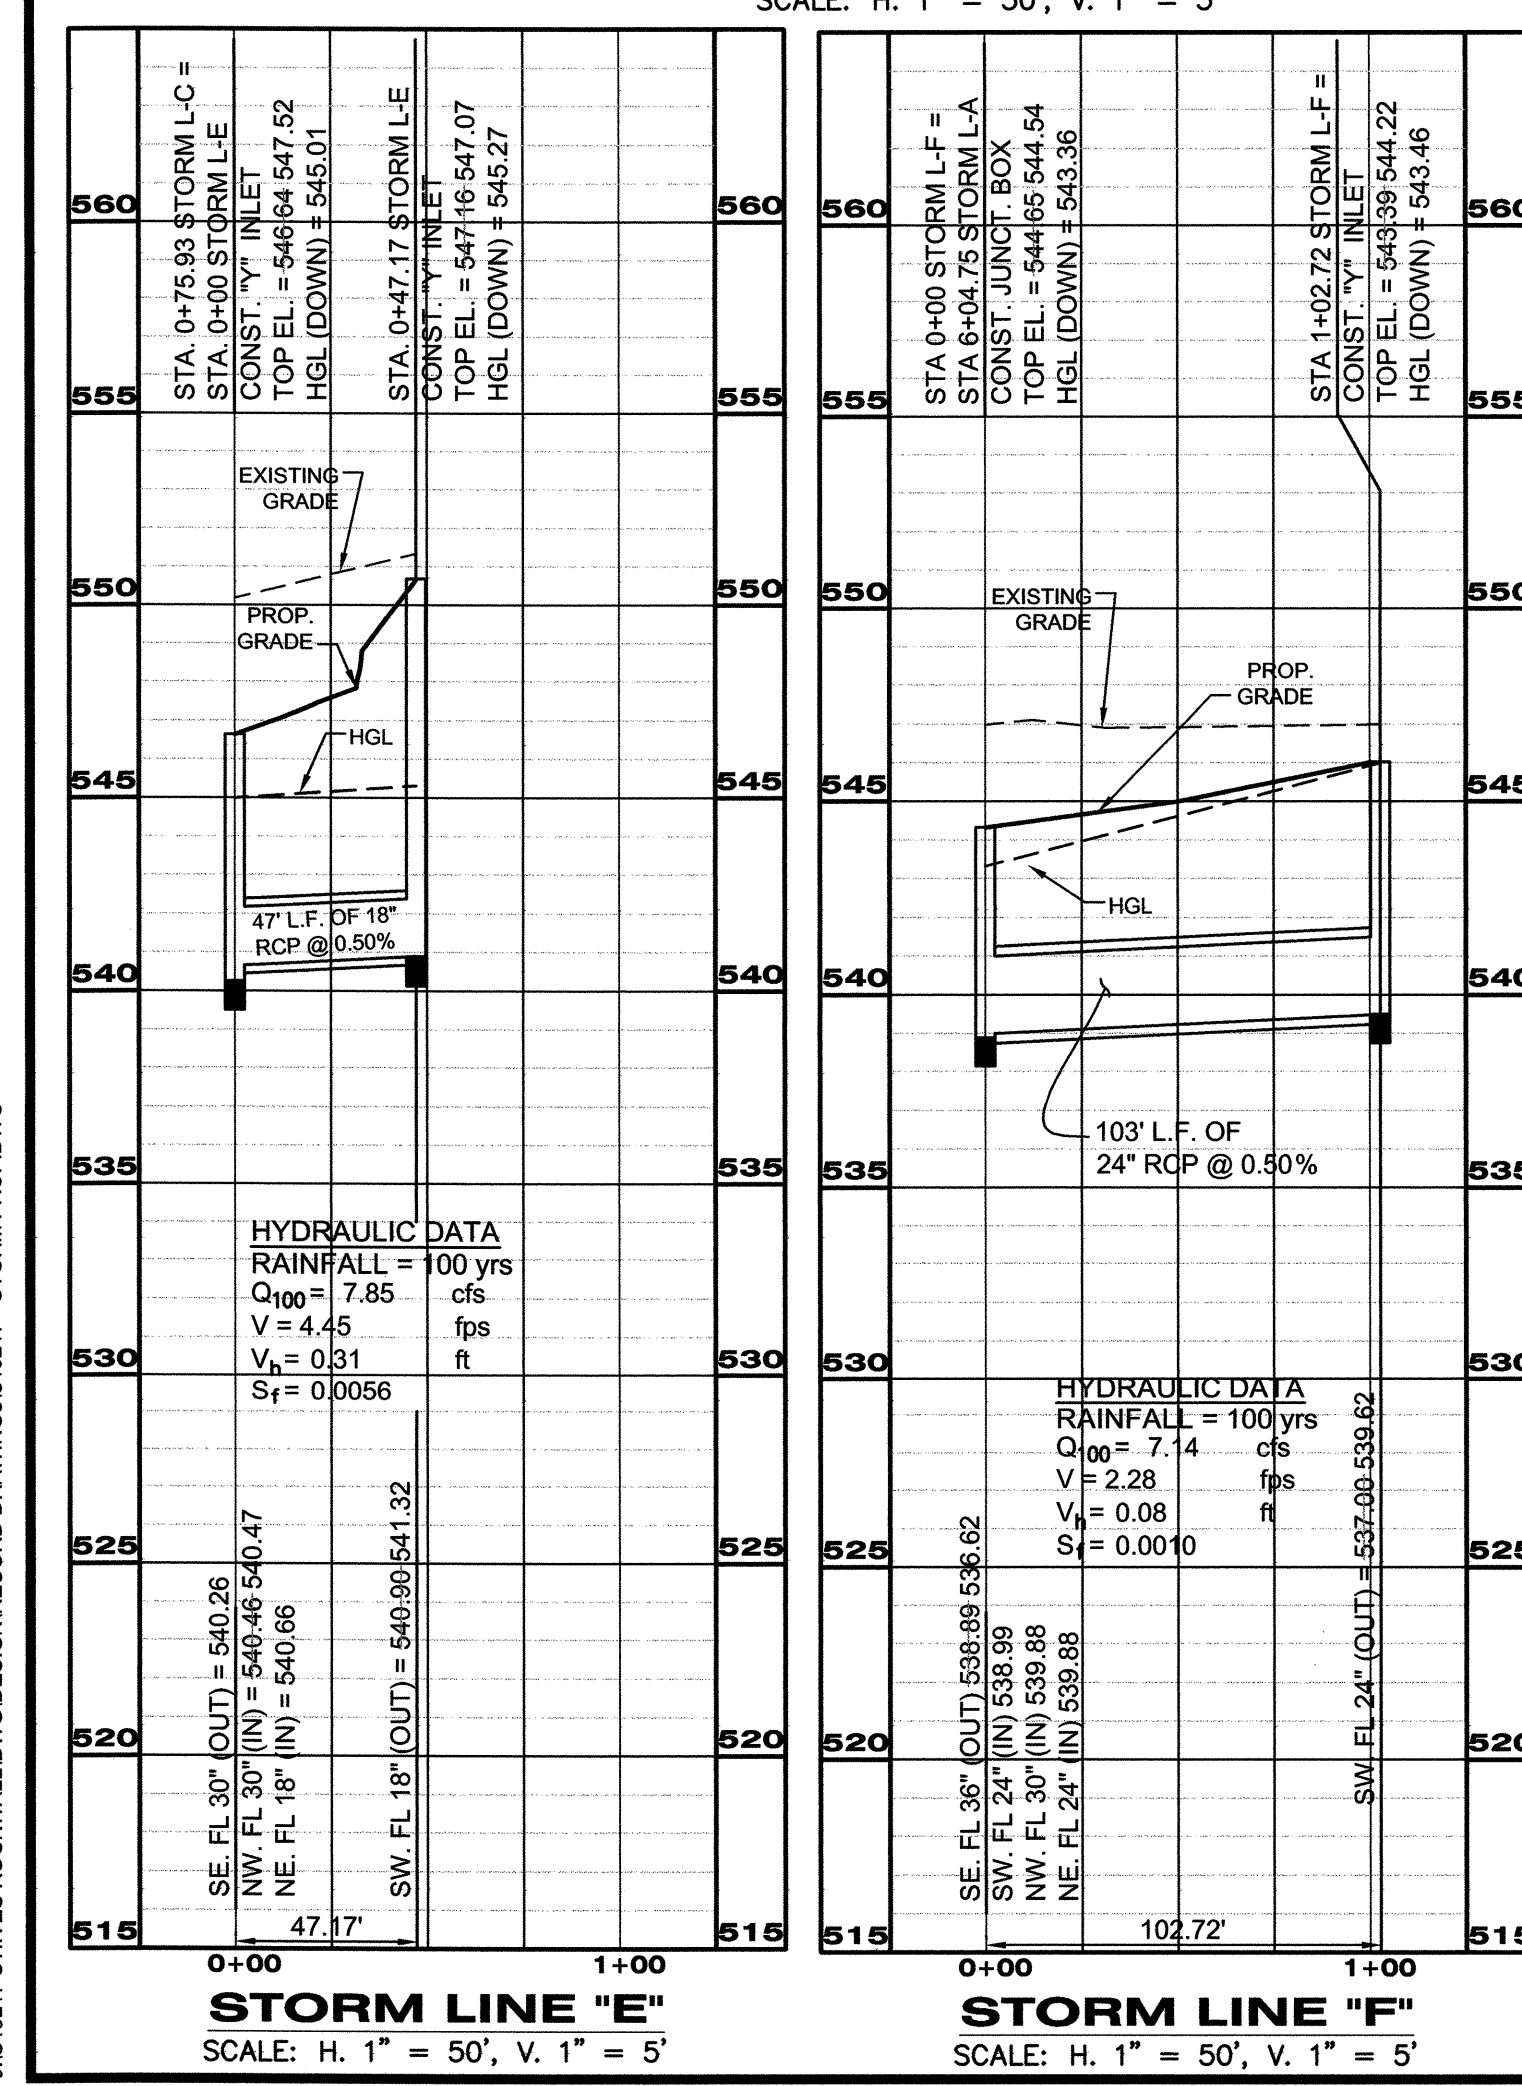


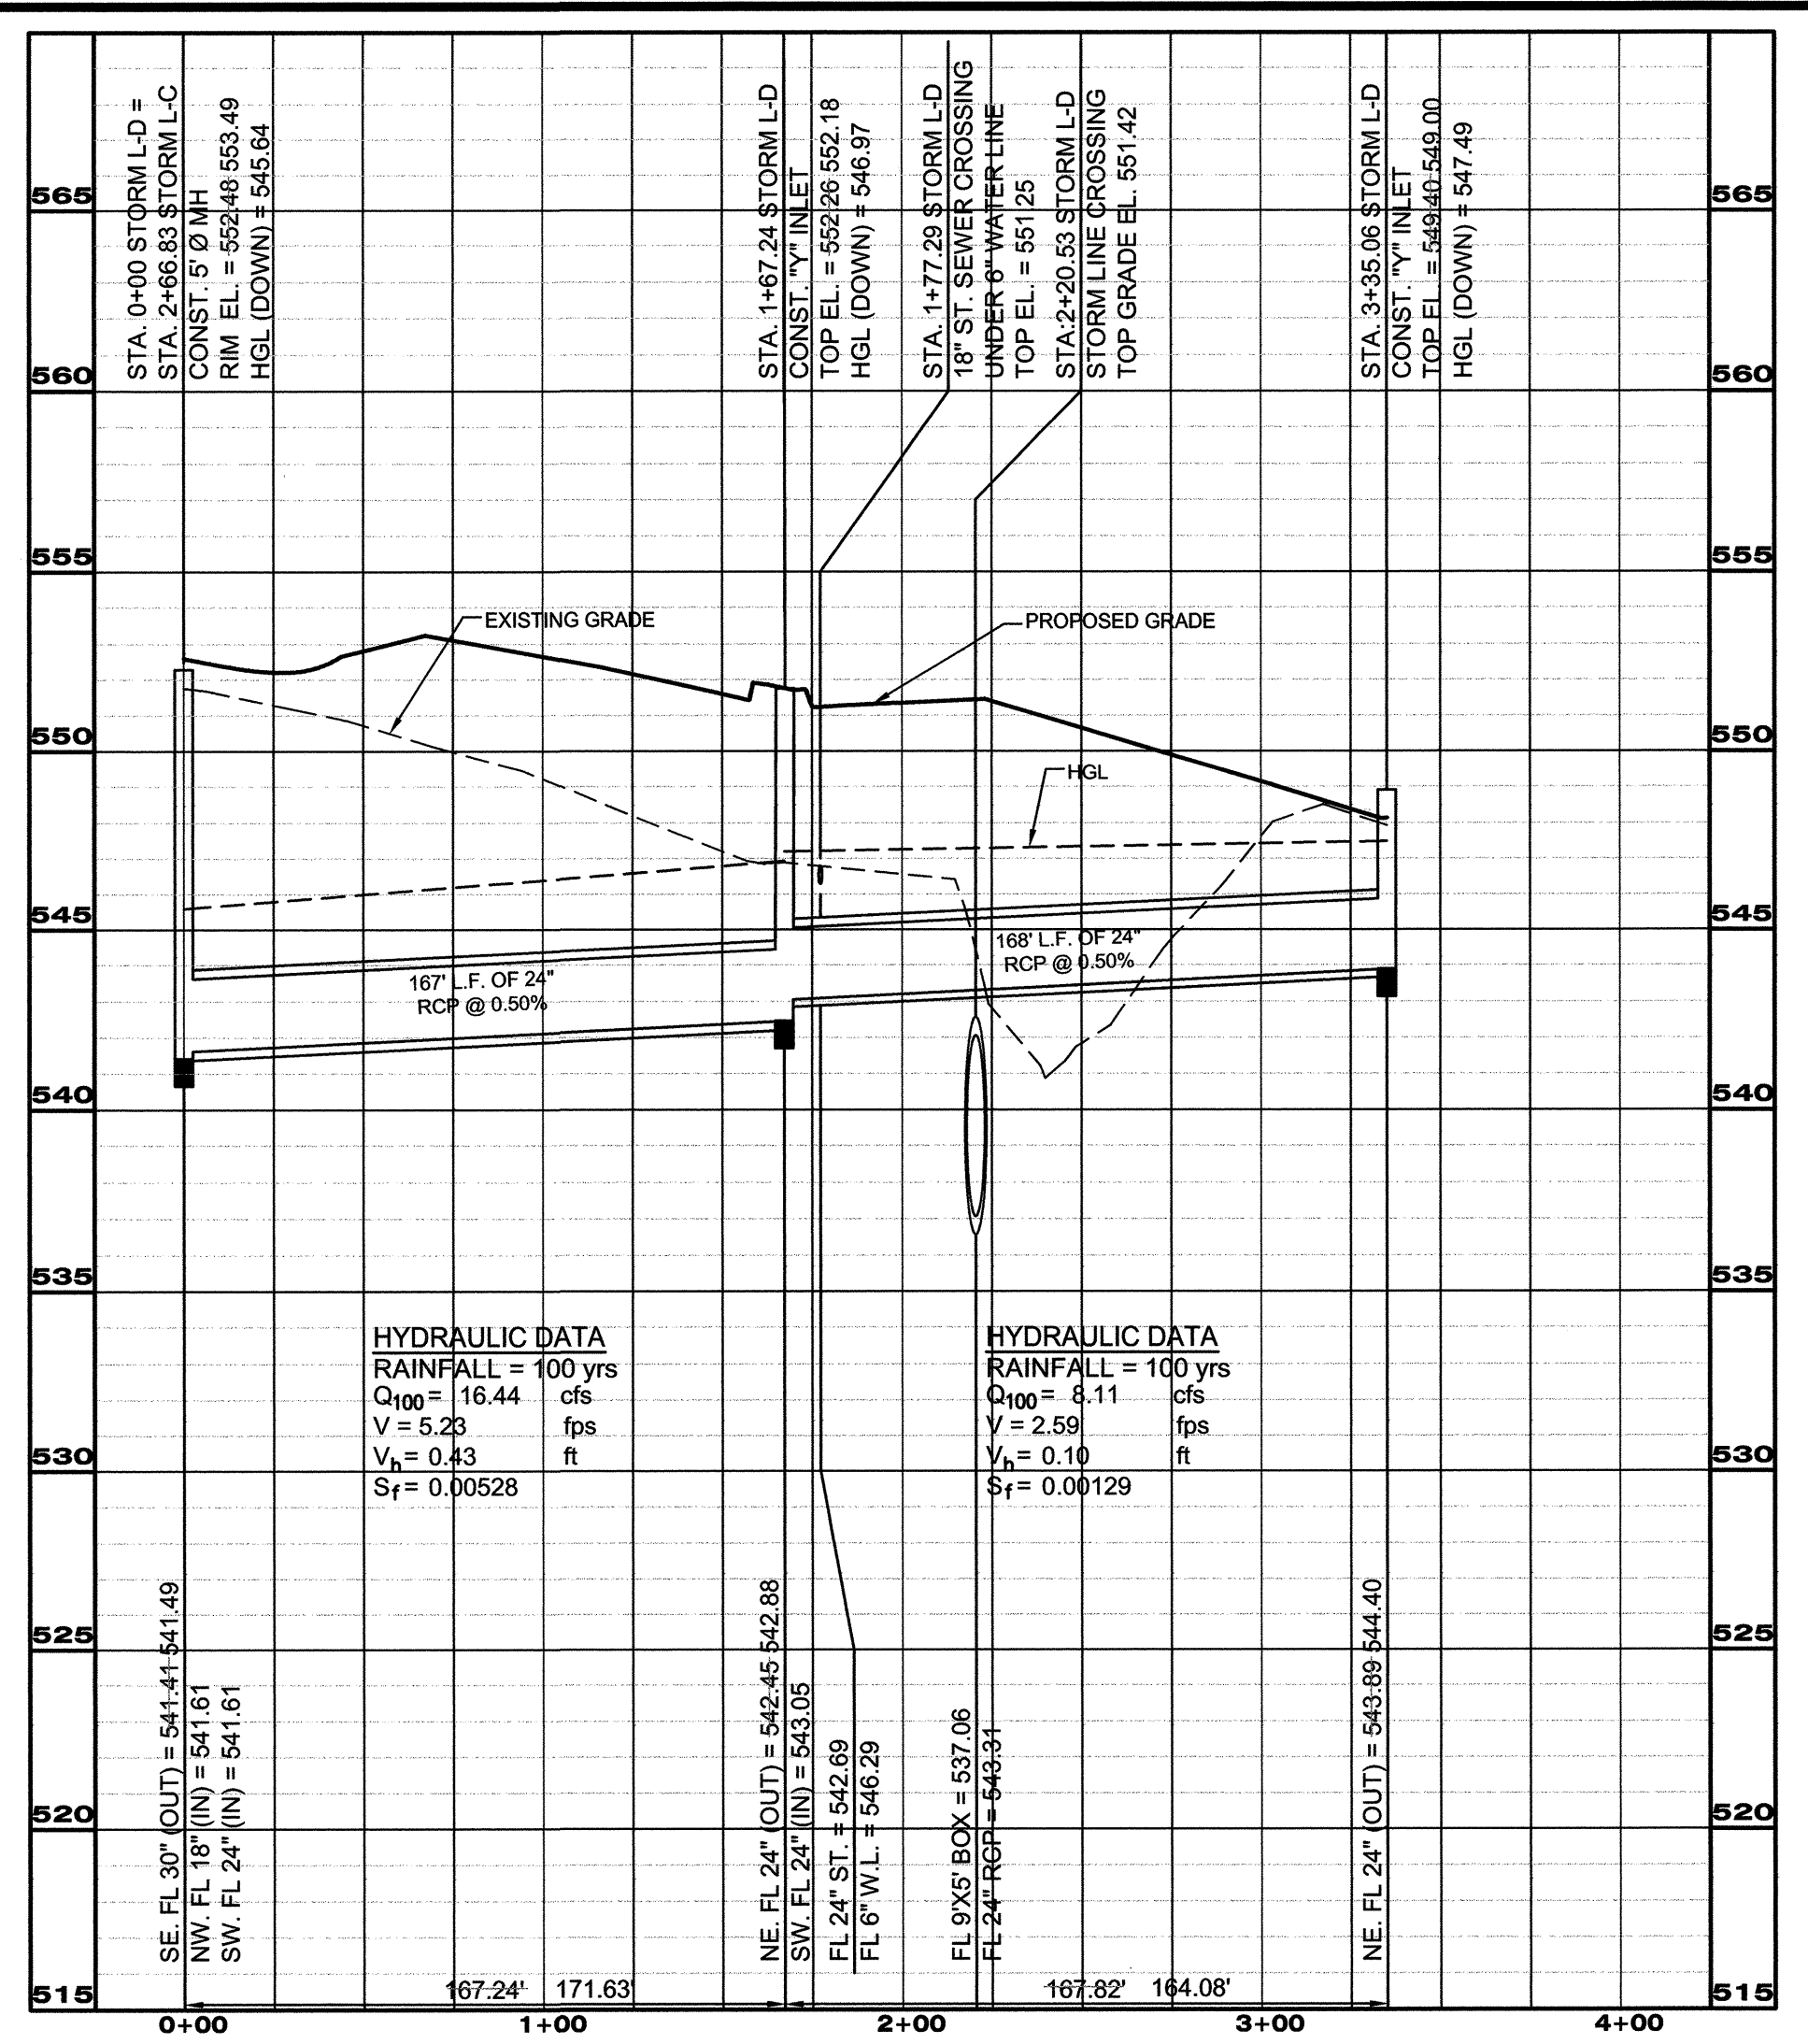

5728 LBJ Freeway
Suite 330
Dallas, Texas 75240
Phone: 972.490.1515
Fax: 972.490.1517


Certificate of
Authorization No. F4830
© 2008

Engineers
Surveyors
Architects
Planners
Landscape Architects
Environmental Scientists
Construction
Management
Design / Build

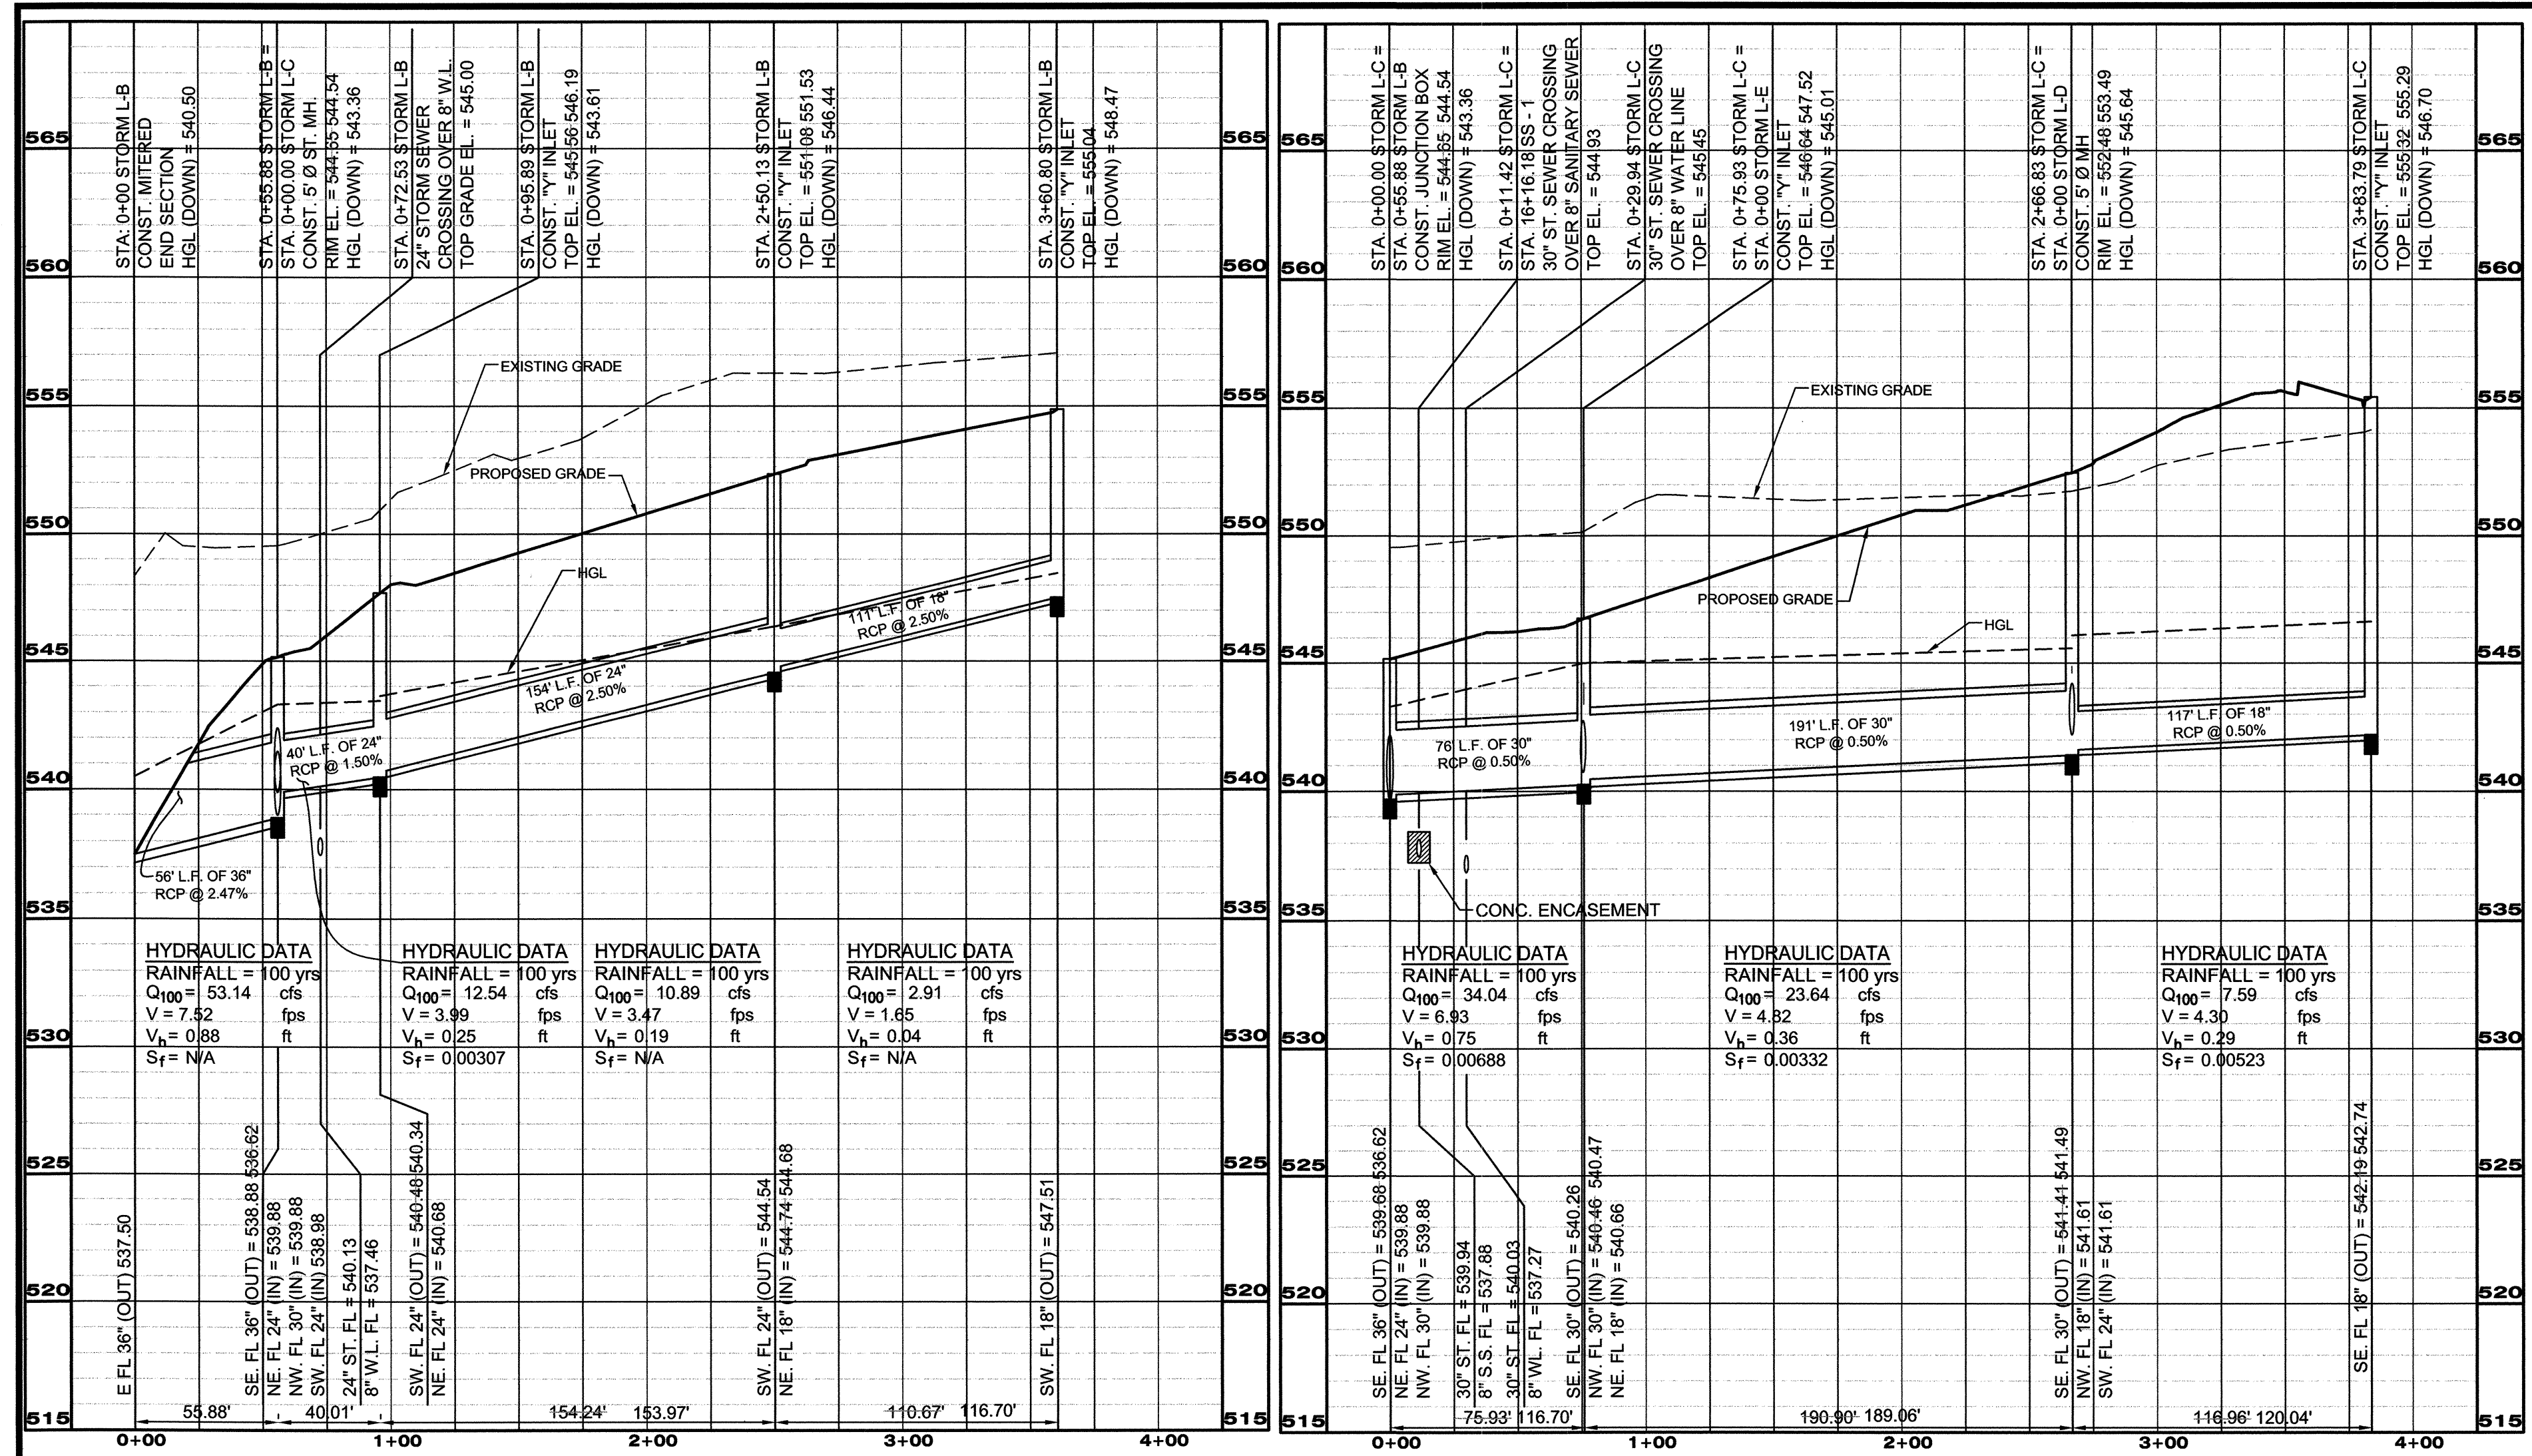

WAS	By	Date	Revision
11/21/08	WAS	04/17/09	By
10/03/08	WAS	01/09/09	Date
09/08/08	WAS	11/06/08	Revision
08/30/08	WAS	09/23/08	PER COR#1 AND RFI #3
06/10/08	WAS	06/26/08	NO CHANGES TO THIS SHEET
05/23/08	WAS	06/03/08	PER CITY COMMENTS 5/29/08
05/06/08	WAS	05/19/08	NO CHANGES TO THIS SHEET
01/29/08	WAS	03/07/08	NO CHANGES TO THIS SHEET
11/15/07	WAS	12/05/07	PER CITY COMMENTS 11/28/07
10/19/2007	WAS	10/31/07	PER CITY COMMENTS 10/22/07
11/15/07	WAS	10/31/07	PER CITY COMMENTS 10/22/07

Designed by:	HMH	Date
Drawn by: <td>AC</td> <td>11/21/08</td>	AC	11/21/08
Checked by: <td>WAS</td> <td>10/03/08</td>	WAS	10/03/08
Approved by: <td>WAS</td> <td>09/08/08</td>	WAS	09/08/08
Scale: <td>H:1" = 50'</td> <td>08/30/08</td>	H:1" = 50'	08/30/08
Date: <td>10/19/2007</td> <td>06/10/08</td>	10/19/2007	06/10/08
Job No.: <td>S13217</td> <td>05/23/08</td>	S13217	05/23/08
File: <td>PROFILES</td> <td>05/06/08</td>	PROFILES	05/06/08

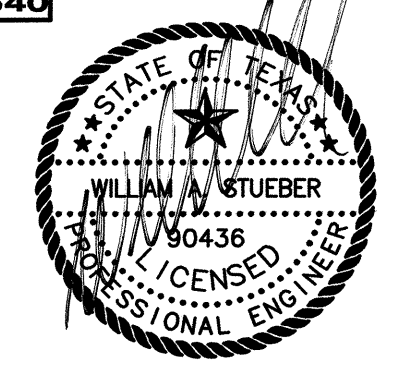

THE SEAL APPEARING ON THIS DOCUMENT WAS AUTHORIZED BY WILLIAM A. STUEBER, P.E. 90436 ON 01/09/2009. ALTERATION OF A SEALED DOCUMENT TO THE RESPONSIBLE ENGINEER IS AN OFFENSE UNDER THE TEXAS ENGINEERING PRACTICE ACT.

STORM DRAINAGE PROFILES
ROCKWALL CENTRE CORNERS
INTERSTATE HIGHWAY 30 AND S.H. 205
CITY OF ROCKWALL, ROCKWALL COUNTY, TEXAS

Sheet No.
C-15

RECORD DRAWING
THIS RECORD DRAWING IS BASED ON INFORMATION RECEIVED BY THE CONTRACTOR AS TO LOCATION AND DETAILS OF THE FACILITIES ACTUALLY CONSTRUCTED. THE ENGINEER HAS PROVIDED LIMITED INSPECTION OF ON-SITE CONSTRUCTION AND HAS OBSERVED THAT THE READILY VISIBLE FEATURES ARE INSTALLED IN GENERAL ACCORDANCE WITH THIS DRAWING.

NOTICE
THE SIZE OF THIS PLAN MAY HAVE BEEN SLIGHTLY ALTERED BY REPRODUCTION PROCESSES. THIS MUST BE CONSIDERED WHEN SCALING ANY REPRODUCED PLAN FOR THE PURPOSE OF COLLECTING DATA.

H:\MCD\2009-10\384M - DRAWING\13217 - STORM PROF.DWG
J:\13217\FILES\ROCKWALL\DWG\DESIGN\REC\DRAWINGS\13217 - STORM PROF.DWG