

**STORM SEWER CALCULATIONS**

PROJECT NAME: **ROCKWALL RETAIL CENTER**

BY: **CPH ENGINEERS INC.**

LINE ID	UPSTREAM STATION	DOWNSTREAM STATION	DISTANCE BETWEEN COLLECTION POINTS (ft)	AREA (Acres)	Runoff Coeff "C"	Incremental "CA"	Accumulated "CA"	Time at Upstream Station (minutes)	Design Storm Frequency (yrs)	Intensity "I" (inches/hr)	Storm Water Runoff "Q" (c.f.s.)	Slope of Hydraulic Gradient "S" (ft/ft)	Selected Storm Sewer Size (ft)	Velocity in Sewer Between Collection Points "V" (ft/s)	Head Loss Coeff. K <sub>f</sub>	Velocity Head Loss at Upstream Station "V <sub>u</sub> " (ft)	Flow Time in Sewer (minutes)	Time at Downstream Station (minutes)	REMARKS	
LINE A	4+50.67	0+00	450.67	-	-	0.00	-	12.4	100	9.4	624.79	0.005	9' X 5'	13.41	1.00	2.79	0.56	13.0		
LINE A	6+04.76	4+50.67	154.09	-	-	0.00	-	11.1	100	9.4	603.20	0.005	9' X 5'	13.41	1.00	2.79	1.30	12.4		
LINE A	9+88.37	6+04.76	383.61	-	-	0.00	-	10.0	100	9.4	603.20	0.0382	9' X 5'	13.41	1.00	2.79	1.10	11.1		
LINE B	0+55.88	0+00	55.88	-	-	0.00	5.67	12.4	100	9.4	53.14	0.025	36	7.52	1.00	0.88	0.12	12.5		
LINE B	0+95.89	0+55.88	40.00	10	0.21	0.90	0.19	1.32	11.8	100	9.5	12.54	0.015	24	3.99	0.50	0.25	0.60	12.4	
LINE B	2+50.13	0+95.89	154.24	9	0.93	0.90	0.84	1.13	11.1	100	9.6	10.89	0.025	24	3.47	0.50	0.19	0.74	11.8	
LINE B	3+60.80	2+50.13	110.67	8	0.33	0.90	0.30	0.30	10.0	100	9.8	2.91	0.025	18	1.65	1.00	0.04	1.10	11.1	
LINE C	0+75.93	0+00	75.93	6	0.37	0.90	0.33	0.62	12.3	100	9.4	34.02	0.005	30	6.93	1.50	0.75	0.18	12.5	
LINE C	2+66.83	0+75.93	190.90	-	-	0.00	2.48	11.6	100	9.5	23.64	0.005	30	4.82	1.25	0.36	0.66	12.3		
LINE C	3+83.79	2+66.83	116.96	7	0.86	0.90	0.77	0.77	10.0	100	9.8	7.59	0.005	18	4.30	1.00	0.29	0.45	11.6	
LINE D	1+67.24	0+00	167.24	5	0.98	0.90	0.88	1.71	11.1	100	9.6	16.44	0.005	24	5.23	0.70	0.42	0.53	11.6	
LINE D	3+35.06	1+67.24	167.82	4	0.92	0.90	0.83	1.00	10.0	100	9.8	2.59	0.005	24	2.59	1.00	0.10	1.08	11.1	
LINE E	0+47.17	0+00	47.17	11	0.89	0.90	0.80	0.80	10.0	100	9.8	7.85	0.005	18	4.45	1.00	0.31	0.18	10.2	
LINE F	1+02.70	0+00	102.70	12	0.81	0.90	0.73	0.73	10.0	100	9.8	7.14	0.005	24	2.28	1.00	0.08	0.75	10.8	
LINE G	1+33.28	0+00	133.28	OS-2	0.41	0.90	0.37	0.37	10.0	100	9.8	3.62	0.028	24	2.40	1.00	0.09	0.93	10.9	
LINE H	0+48.43	0+00	48.43	2	1.32	0.90	1.19	2.29	10.0	100	9.3	21.59	0.01	24	4.58	0.50	0.33	0.18	10.2	
LINE H	2+93.84	0+48.43	244.41	-	-	0.00	1.10	12.3	100	9.6	10.54	0.0071	24	2.24	1.00	0.08	1.82	14.1		
LINE H	4+71.97	2+93.84	178.13	3	1.22	0.90	1.10	1.10	11.0	100	9.8	10.76	0.0134	24	3.07	1.00	0.15	1.30	12.3	
LINE K	1+04.70	0+00	104.70	1	2.12	0.90	1.19	1.19	10.0	100	9.8	18.70	0.0381	30	6.10	1.00	0.58	1.00	11.0	
LINE J	1+50.00	0+00	150.00	-	-	-	-	-	10.0	100	0.0	32.70	0.0033	36	4.63	1.00	0.33	0.54	10.5	DETENTION OUTFALL

\*HYDRAULIC DATA WAS OBTAINED FROM HYDROFLOW MODEL BY CPH ENGINEERS, INC. PLUS THE PIPE TRAVEL TIME.

**INLET DESIGN CALCULATIONS**

PROJECT NAME: **ROCKWALL RETAIL CENTER**




BY: **CPH ENGINEERS INC.**

LINE NAME: **LINES B, C, D, E, F, H, AND J**



DATE: **MAY 20**

DRA. AREA	Location	Design Storm Frequency (yrs)	Time of Conc. (mins.)	Intensity I (in./hr.)	Runoff Coeff. "C"	Area (ac.)	"Q" (c.f.s.)	Carry-Over From Upstream Inlet (c.f.s.)	Total Gutter Flow (c.f.s.)	Gutter Capacity (c.f.s.)	Gutter Slope (ft./100 ft.)	Crown Type	SELECTED INLET Length "L" Feet	Type	Carry-Over To Downstream Inlet (c.f.s.)	INLET WIDTH "W"
AREA 1	STA. 1+05 L-K	100	10	9.8	0.9	1.5	13.23	-	-	-	-	-	4'x4'	"Y" INLET	-	4'
AREA 2	STA. 0+49 L-H	100	10	9.8	0.9	1.32	11.64	-	-	-	-	-	5'	CURB	-	3'
AREA 3	STA. 4+72 L-H	100	10	9.8	0.9	1.22	10.76	-	-	-	-	-	10'	*	-	3'
AREA 4	STA. 1+67 L-D	100	10	9.8	0.9	0.92	8.11	-	-	-	-	-	5'	*	-	3'
AREA 5	STA. 3+35 L-D	100	10	9.8	0.9	0.98	8.64	-	-	-	-	-	5'	*	-	3'
AREA 6	STA. 0+76 L-C	100	10	9.8	0.9	0.37	3.26	-	-	-	-	-	5'	*	-	4'
AREA 7	STA. 3+84 L-C	100	10	9.8	0.9	0.86	7.59	-	-	-	-	-	5'	*	-	3'
AREA 8	STA. 3+61 L-B	100	10	9.8	0.9	0.33	2.91	-	-	-	-	-	5'	CURB	-	3'
AREA 9	STA. 2+50 L-B	100	10	9.8	0.9	0.93	8.20	-	-	-	-	-	5'	CURB	-	3'
AREA 10	STA. 0+95 L-B	100	10	9.8	0.9	0.21	1.85	-	-	-	-	-	5'	CURB	-	3'
AREA 11	STA. 0+47 L-E	100	10	9.8	0.9	0.89	7.85	-	-	-	-	-	5'	*	-	3'
AREA 12	STA. 1+03 L-F	100	10	9.8	0.9	0.81	7.14	-	-	-	-	-	5'	CURB	-	3'


\*TOP OF INLETS SHALL BE CONSTRUCTED AS STANDARD "Y" INLET. UPON ULTIMATE SITE DEVELOPMENT, TOP OF INLET AND APRONS SHALL BE REMOVED AND CAST INTO STANDARD CURB INLETS (SEE INLET DETAIL THIS SHEET).

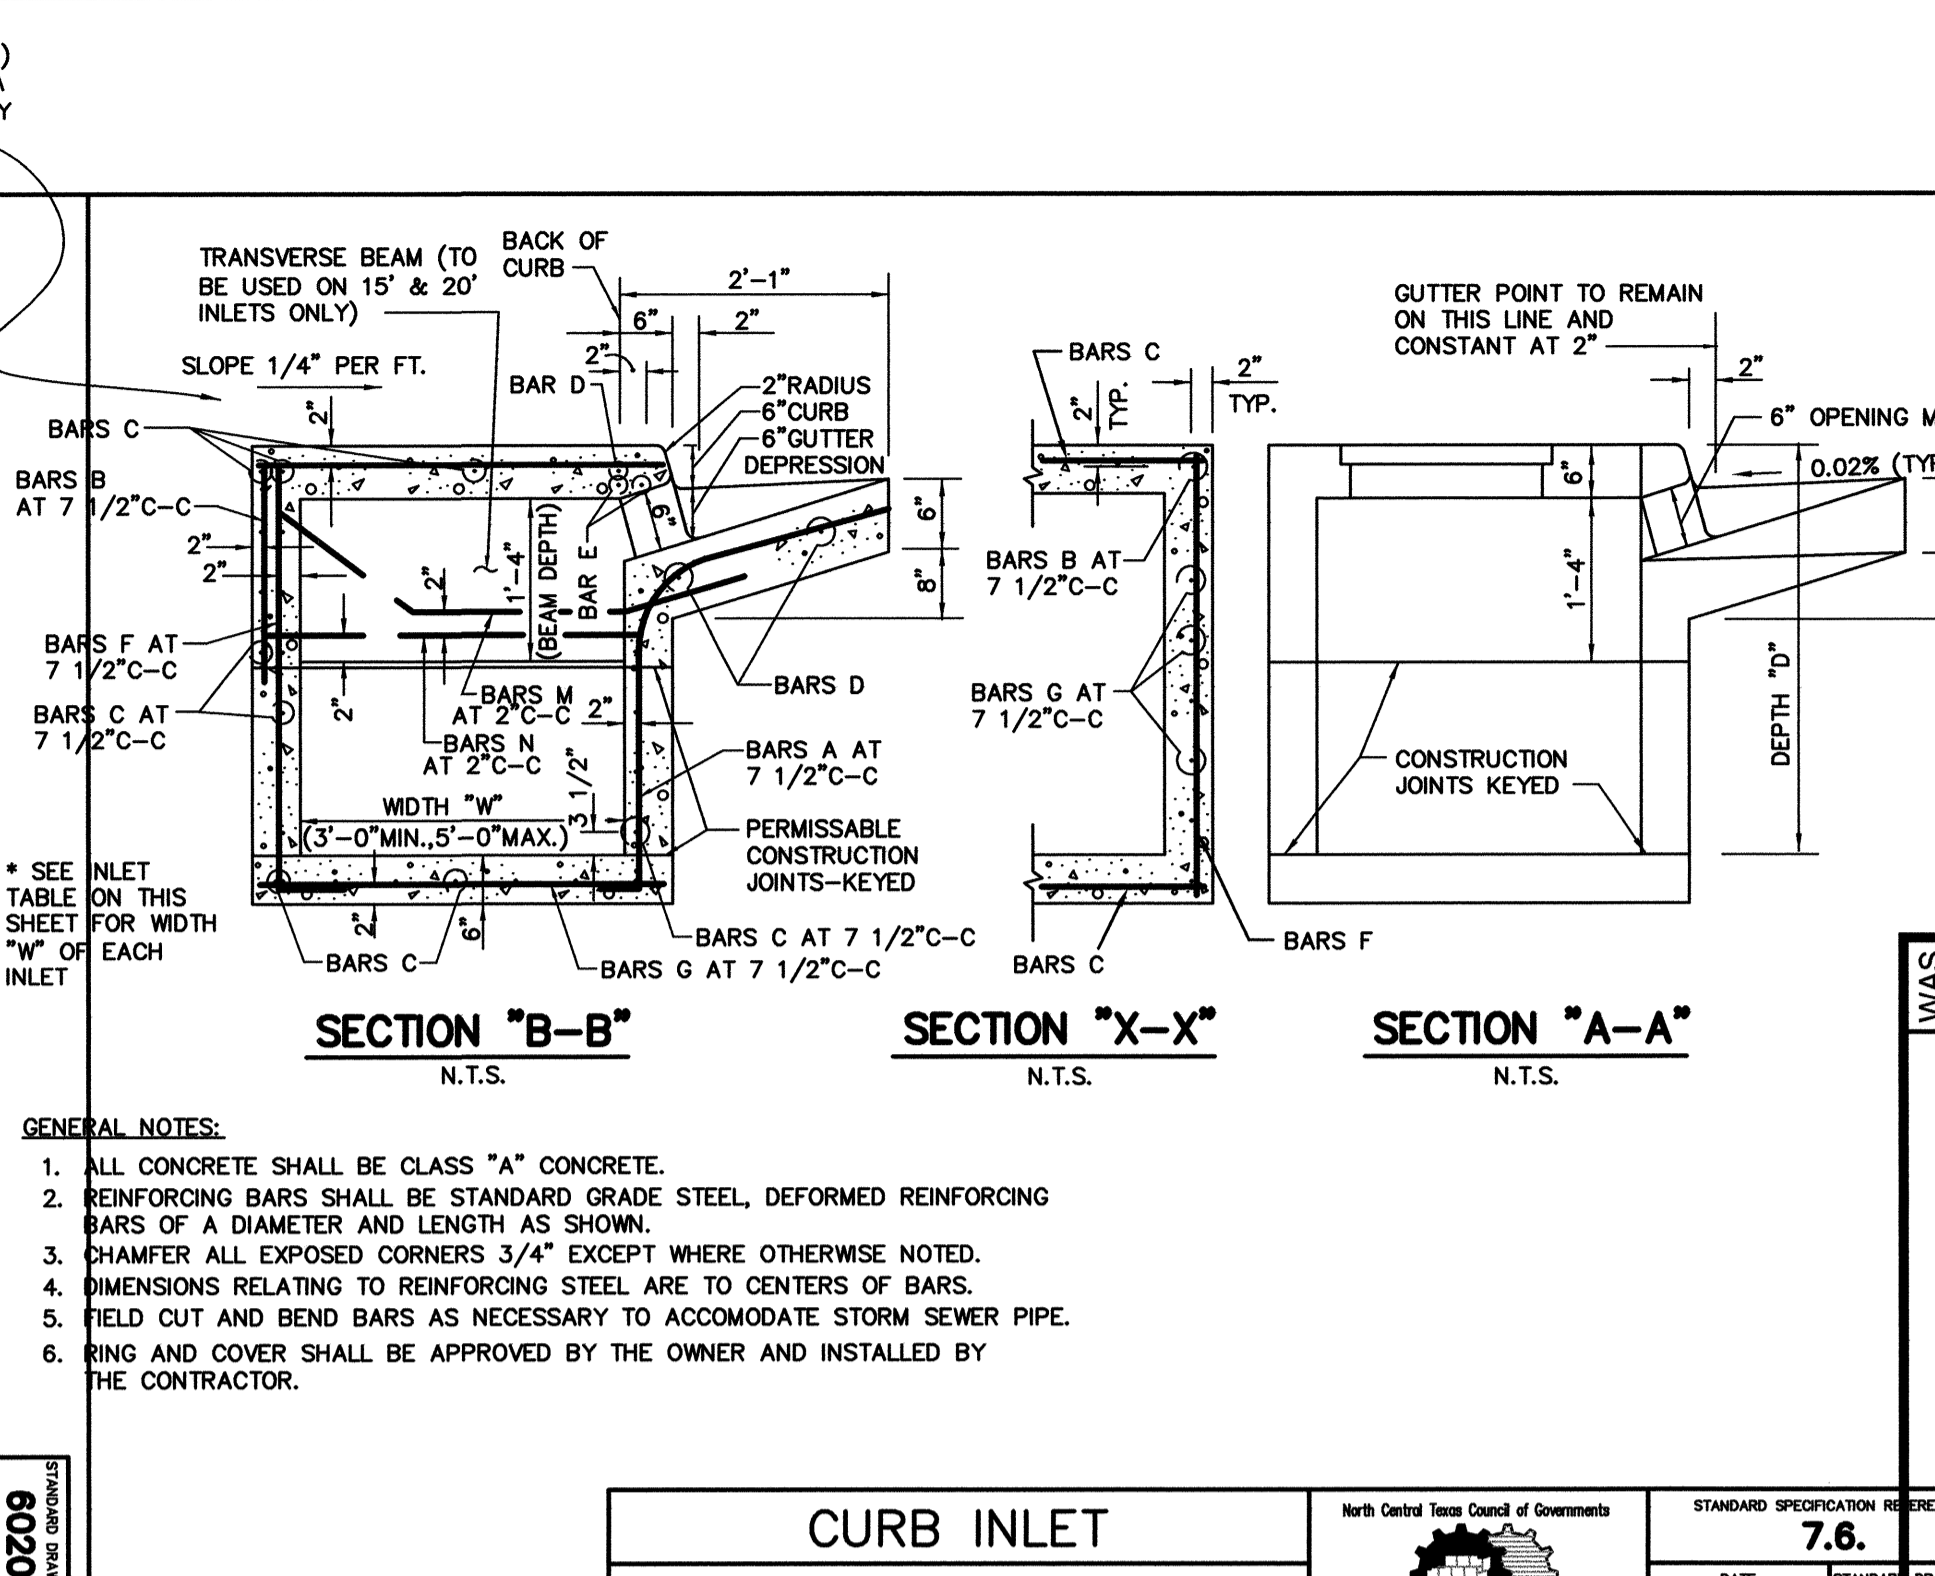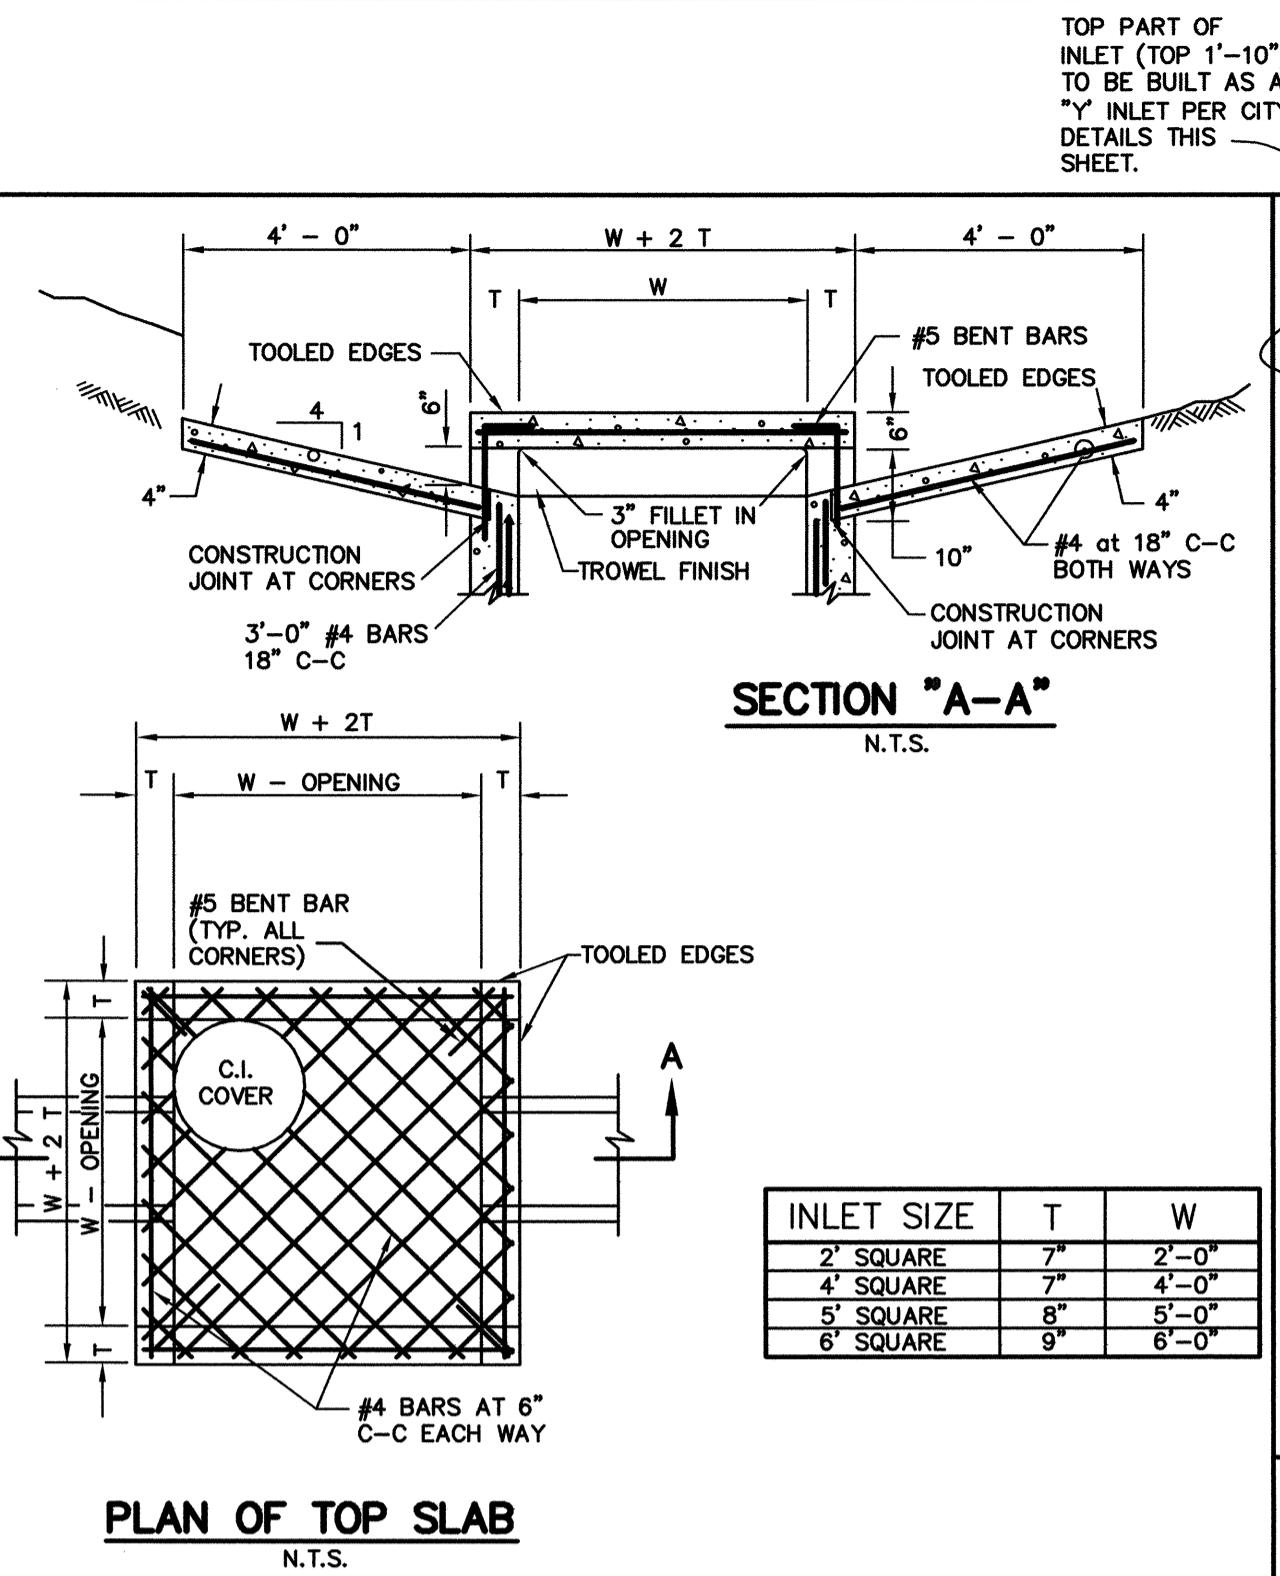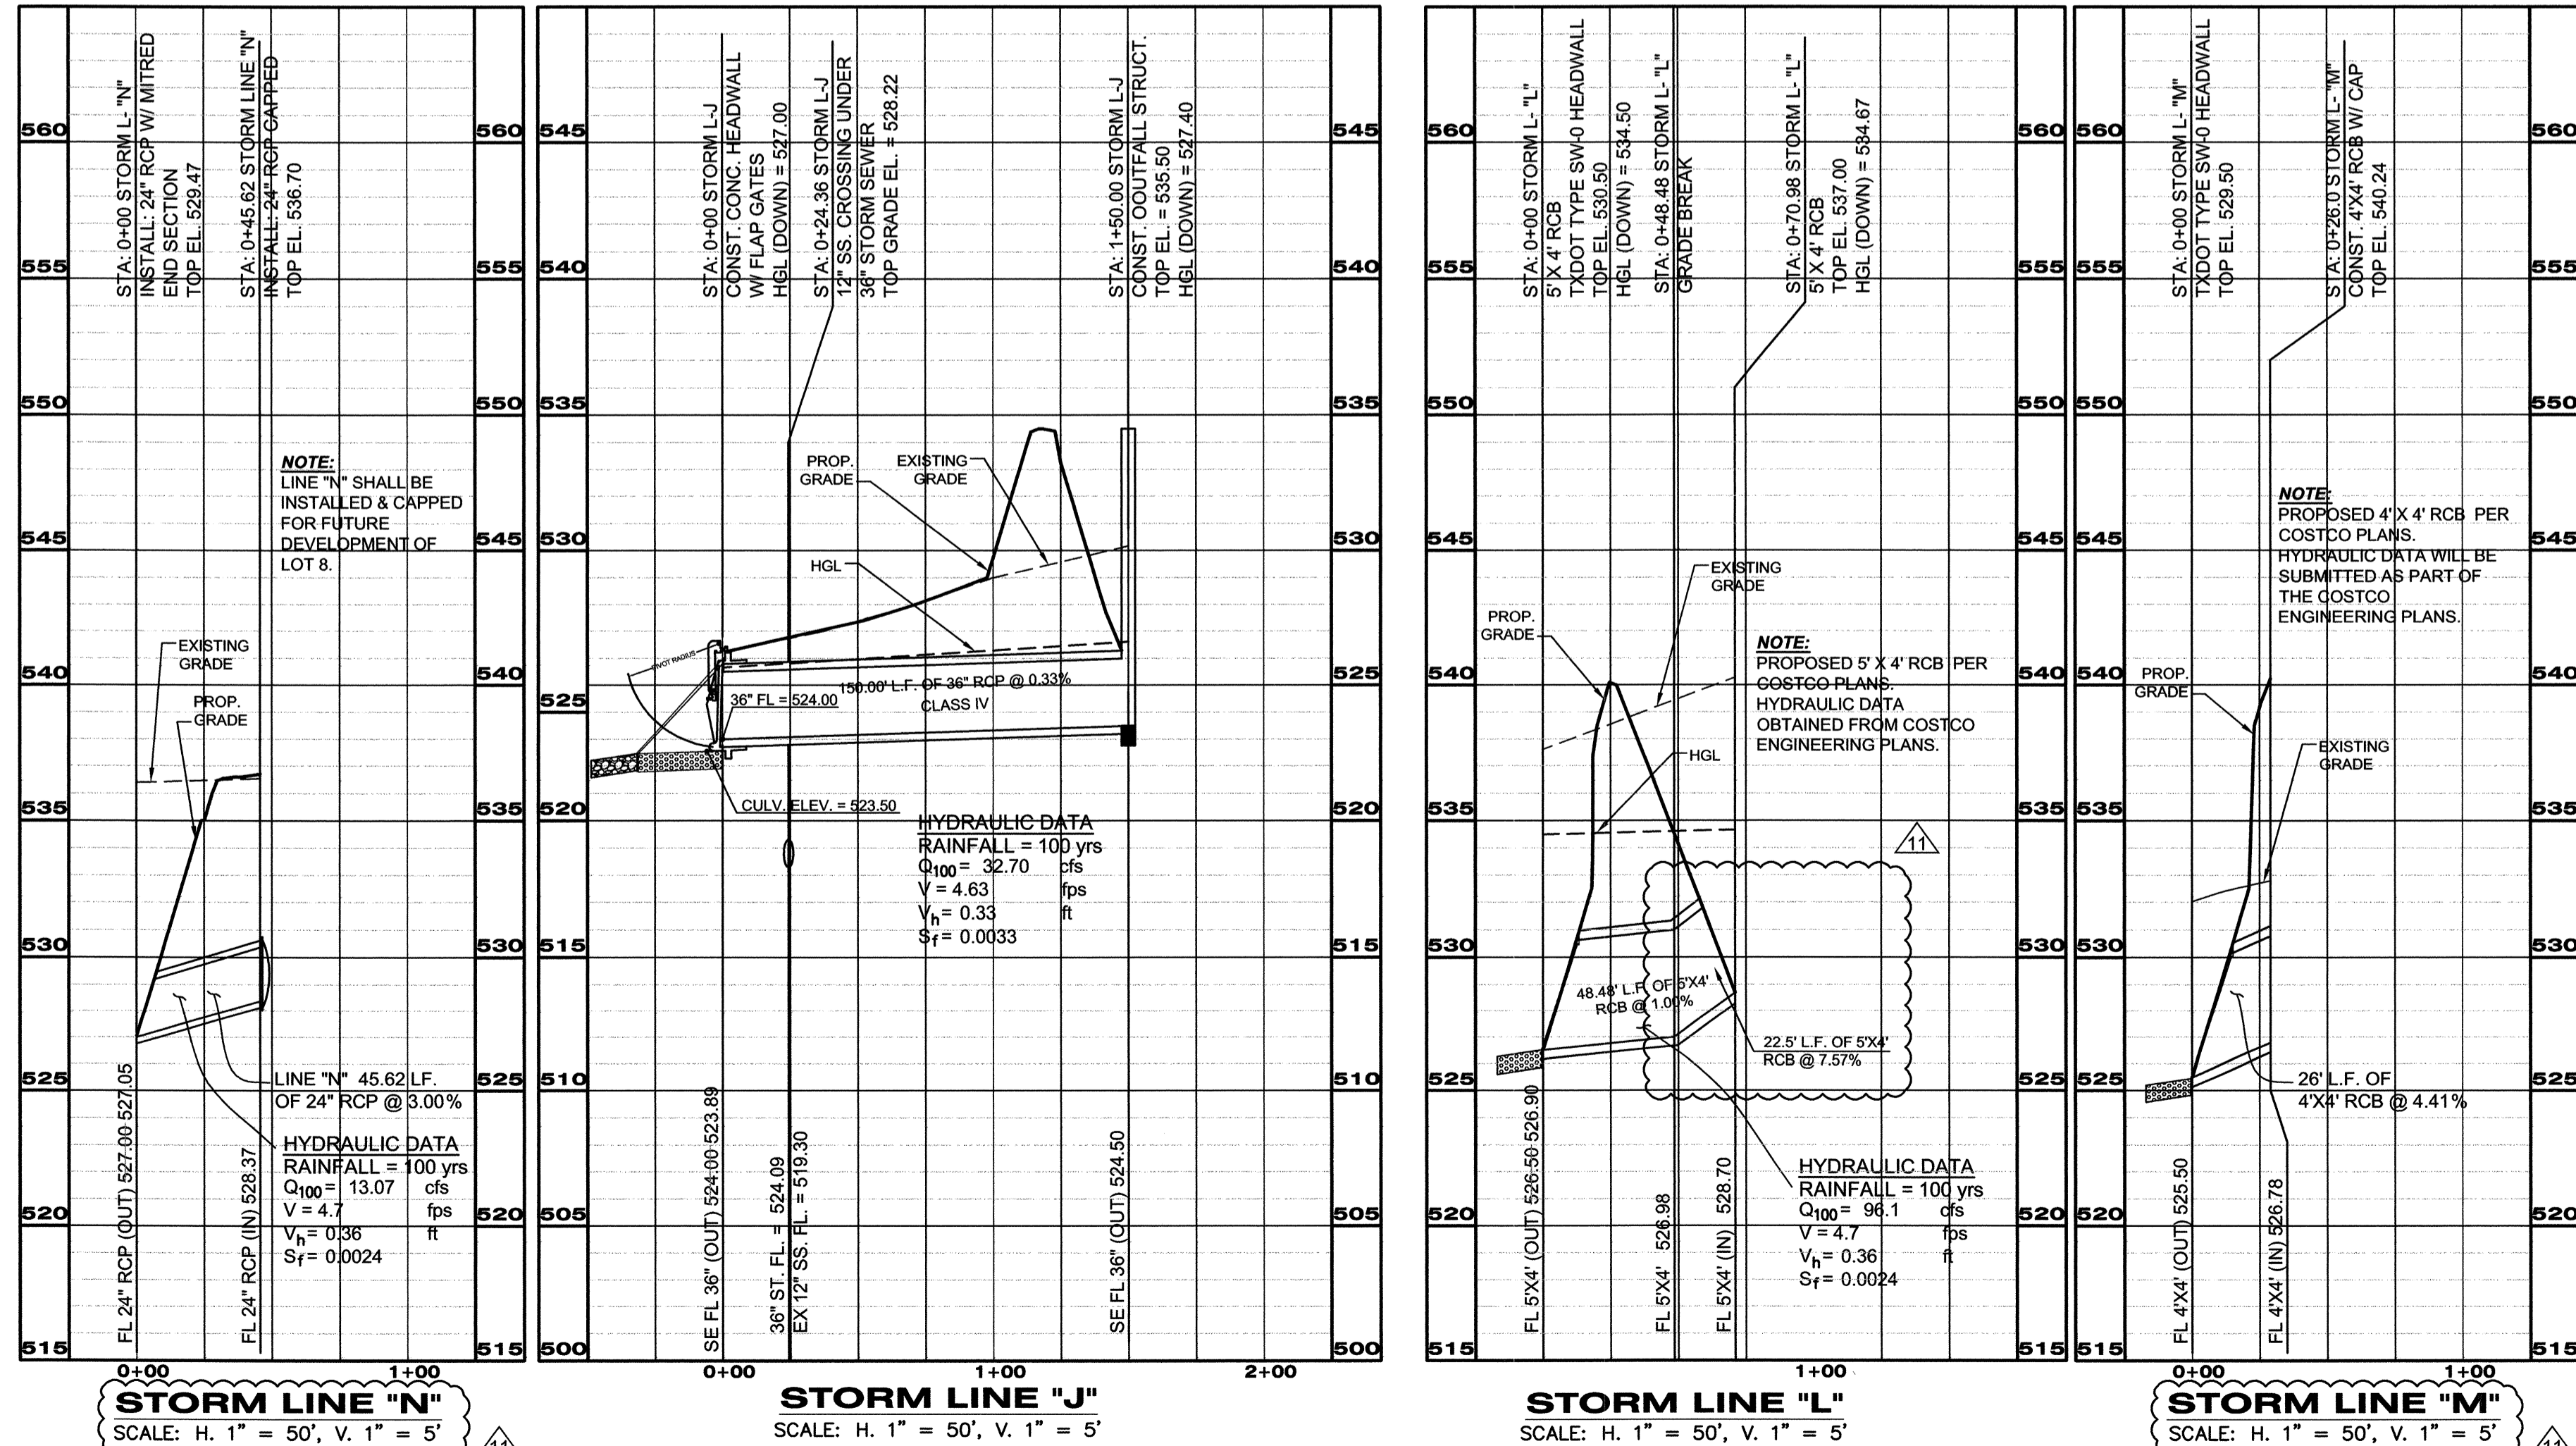

- GENERAL NOTES:**
- ALL CONCRETE SHALL BE CLASS "A" CONCRETE.
  - REINFORCING BARS SHALL BE STANDARD GRADE STEEL, DEFORMED REINFORCING BARS OF A DIAMETER AND LENGTH AS SHOWN.
  - CHAMFER ALL EXPOSED CORNERS 3/4" EXCEPT WHERE OTHERWISE NOTED.
  - DIMENSIONS RELATING TO REINFORCING STEEL ARE TO CENTERS OF BARS.
  - FIELD CUT AND BEND BARS AS NECESSARY TO ACCOMMODATE STORM SEWER PIPE.
  - RING AND COVER SHALL BE APPROVED BY THE OWNER AND INSTALLED BY THE CONTRACTOR.

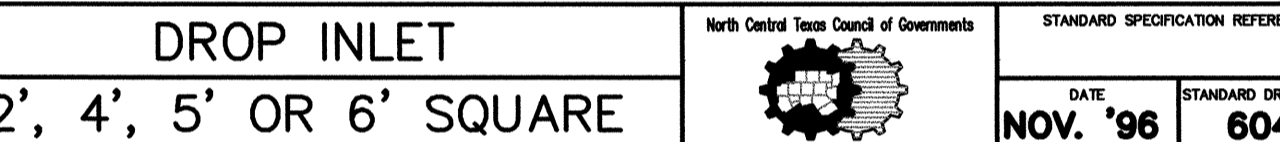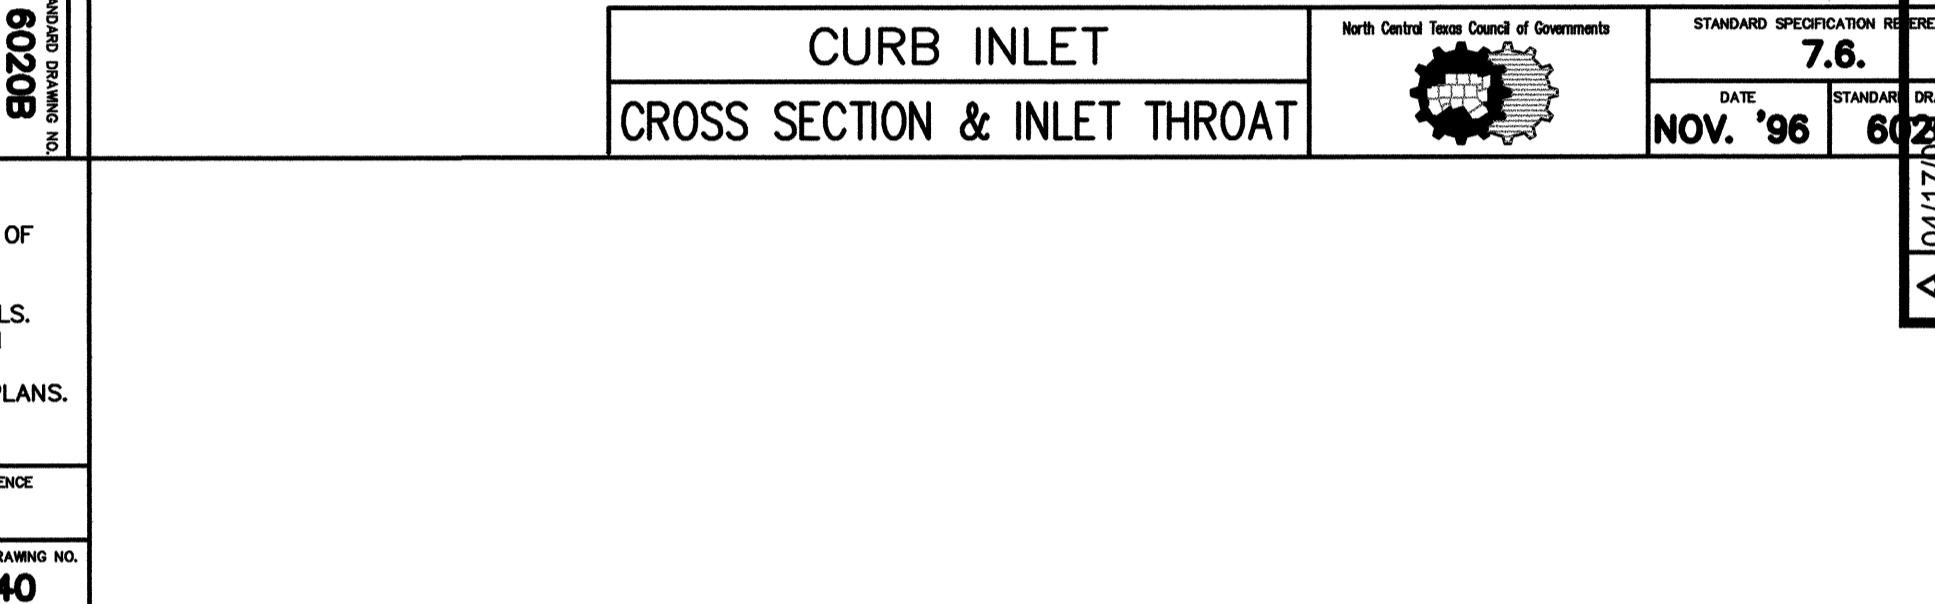

- NOTES:**
- MATERIAL AND WORKMANSHIP SHALL CONFORM WITH THE REQUIREMENTS OF NCTCOG STANDARD SPECIFICATIONS FOR STANDARD CONCRETE MANHOLES, MINIMUM CLASS "A" CONCRETE.
  - LAYERS OF REINFORCING STEEL NEAREST THE INTERIOR AND EXTERIOR SURFACES SHALL HAVE A COVER OF 2" TO THE CENTER OF BARS, UNLESS OTHERWISE NOTED.
  - FOR DETAILS OF REINFORCING OF LOWER PORTIONS OF INLET SEE APPROPRIATE SQUARE MANHOLE DETAILS.
  - DEPTH OF DROP INLET FROM FINISHED GRADE TO FLOW LINE OF INLET IS VARIABLE. APPROXIMATE DEPTH WILL BE SHOWN ON PLANS AT LOCATION OF INLET.
  - ALL STANDARD DROP INLETS SHALL HAVE ONE OPENING ON EACH SIDE UNLESS OTHERWISE SHOWN ON PLANS.
  - DECK MAY BE REINFORCED SAME AS 4' SQUARE MANHOLE.

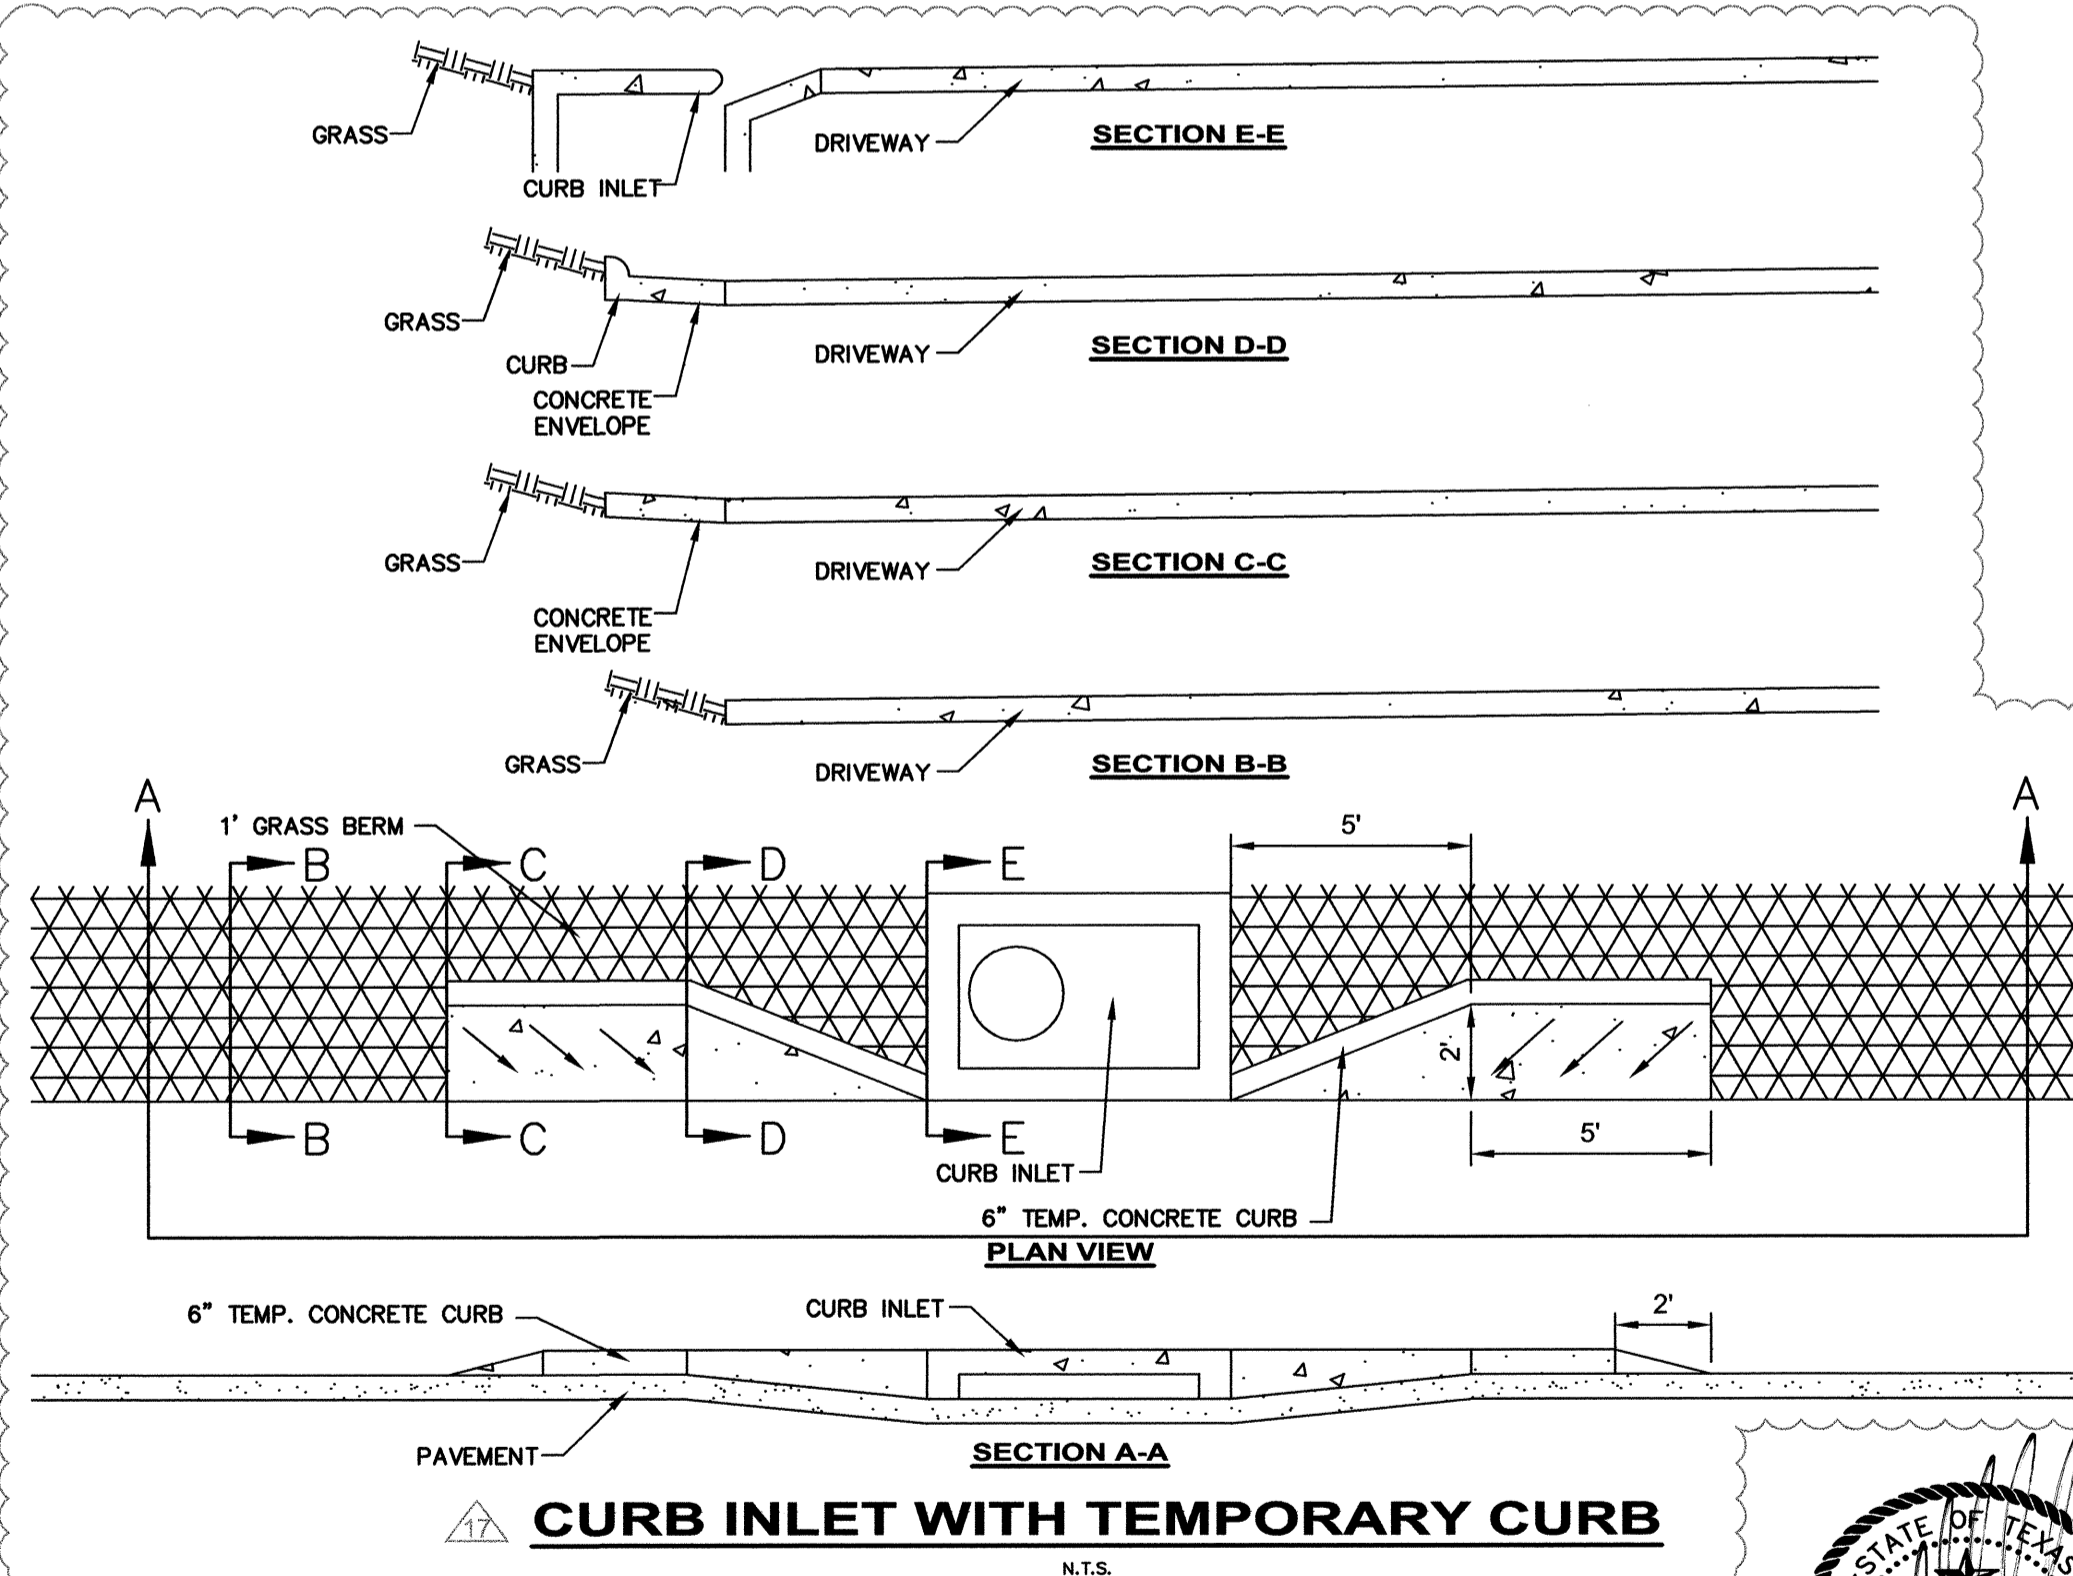

**RECORD DRAWING**

THIS RECORD DRAWING IS BASED ON INFORMATION RECEIVED BY THE CONTRACTOR AS TO LOCATION AND DETAILS OF THE FACILITIES ACTUALLY CONSTRUCTED. THE ENGINEER HAS PROVIDED LIMITED INSPECTION OF ON-SITE CONSTRUCTION AND HAS OBSERVED THAT THE READILY VISIBLE FEATURES ARE INSTALLED IN GENERAL ACCORDANCE WITH THIS DRAWING.

**NOTICE:**  
THE SIZE OF THIS PLAN MAY HAVE BEEN SLIGHTLY ALTERED BY REPRODUCTION PROCESSES. THIS MUST BE CONSIDERED WHEN SCALING ANY REPRODUCED PLAN FOR THE PURPOSE OF COLLECTING DATA.

DESIGN: STA. 0.95.89 STORM L-B CONST. 5" CURB INLET  
TOP = 545.59/546.19  
HGL = 543.61  
NE. FL 24" (IN) 540.68  
SE. FL 24" (OUT) 540.49/540.34  
N: 7019919.500  
E: 2598286.500

NORTHING: AS-BUILT  
EASTING: AS-BUILT

AS-BUILT LEGEND

DATE	BY	REVISION
04/17/08	WAS	NO CHANGES TO THIS SHEET
01/09/08	WAS	NO CHANGES TO THIS SHEET
11/06/08	WAS	PER COR#1 AND REF #3
09/08/08	WAS	NO CHANGES TO THIS SHEET
08/30/08	WAS	NO CHANGES TO THIS SHEET
06/10/08	WAS	PER COSTCO ENGINEERING PLANS
05/23/08	WAS	PER CITY COMMENTS 5/29/08
05/06/08	WAS	PER COSTCO PLANS
05/06/08	WAS	PER COSTCO COMMENTS
01/29/08	WAS	PER CITY COMMENTS 12/06/07
11/15/07	WAS	PER CITY COMMENTS 11/05/07
10/19/07	WAS	PER CLIENTS NEW SITE LAYOUT
10/19/07	WAS	PER CITY COMMENTS 10/22/07

**cph**

5728 LBJ Freeway  
Suite 330  
Dallas, Texas 75240  
Phone: 972.490.1515  
Fax: 972.490.1517

Certificate of Authorization No. F4830  
© 2008

Engineers  
Surveyors  
Architects  
Planners  
Landscape Architects  
Environmental Scientists  
Construction Management  
Design/Build

**STORM DRAINAGE PROFILES & CALCULATIONS**

**ROCKWALL CENTRE CORNERS**

INTERSTATE HIGHWAY 30 AND S.H. 205  
CITY OF ROCKWALL, ROCKWALL COUNTY, TEXAS

Sheet No. **C-15A**