

GENERAL NOTES:

- All work shall be done in accordance with the North Central Texas Council of Governments (NCTCOG 3rd Edition) Standard Specifications for Public Works Construction (Applicable Edition) and City of Rockwall Standards and Specifications.
- The location, elevation, and size of existing utilities shown on the plans as obtained from the City of Rockwall and utility company records, are considered approximate. The engineer does not certify that all utilities are shown. The Contractor shall verify exact locations, sizes, and depths of existing utilities before beginning construction (including ordering of pre-cast manholes and concrete pipe if applicable.)
- The Contractor shall contact Texas Safety System (800-DIG-TESS: 800-344-8377) and city of Rockwall (972-771-7730) and other utility companies 48 hours prior to locating existing utilities and or construction activities.
- The Contractor shall preserve, protect and support all existing utilities at all times during construction. Any damage to utilities resulting from the contractor's operation shall be restored at his expense.
- Saw cut, remove and replace pavements, sidewalks, curbs and gutters to conform with City of Rockwall Public Works Pavement Cuts and Repair Standards Details.,
- All disturbed pavement markings including, but not limited to, striping, traffic buttons, crosswalks shall be restored to same or improved condition as per City of Rockwall Specifications for Public Works Construction Details and all Addenda Thereto.
- The Contractor shall provide for the diversion of pedestrians and vehicles during the progress of work in a manner satisfactory to the on-site City of Rockwall inspector and in accordance with the City of Rockwall Traffic Barricade Details.
- The existing topography, public water, sanitary sewer, and storm sewer utility lines and appurtenances shown on these plans are based on survey provided by H.D. Fetty Land Surveying Company.
- The contractor shall be responsible for determining the depth and location of existing underground utilities prior to trenching or excavation and is required to take any precautionary measures to protect all lines shown and/or any other underground utilities not of record or not shown on the plans. Contractor is responsible for contacting all the franchise utility companies, city utility departments and DIGTESS for locates prior to construction.
- The contractor shall maintain daily contact with the city inspector during construction of improvements. No public sanitary sewer, water or storm sewer pipe shall be covered without approval of the city inspector. No subgrade material, stabilization or paving shall be applied without approval of the city inspector. The inspector may at any time cause any construction, installation, maintenance of improvements to cease when, in his judgment the City's Standard Construction Details have been violated and may require reconstruction or other work as may be necessary to correct the violation.
- Construction plans without the City of Rockwall "Signature" stamp are not valid for construction and shall be removed from the construction site.
- The contractor is responsible for obtaining all applicable city permits.
- Erosion control and storm water management measures must be in place and comply with applicable city, state and federal regulations. Erosion and sedimentation control measures and practices shall be maintained at all times during construction, additional measures and practices shall be installed if deemed necessary by the city inspector.
- All excavations within the right of the way shall be filled and compacted within twenty-four (24) hours of completion of work and no excavation shall remain open for longer than 72 hours.
- The contractor shall be responsible for providing "As-Builts", and/or "Record Drawings" to the Engineer of Record / Firm defining the location of improvements and any changes to the City approved drawings constructed in conjunction with the project including but not limited to public and private paving, grading, drainage, and utilities and appurtenances. Prior to final acceptance by the City, the Engineer of Record / FIRM shall provide the city inspector with a reproducible set of "As-Builts" and / or "Record Drawings" on 24" x 36" sheets and a digital copy of all files on compact disk (CD) in a City approved AutoCAD (.dwg) format of all drawings bearing the City's "Release for Construction" stamp.


CIVIL CONSTRUCTION PLANS

FOR

ROCKWALL COMMONS, PHASE-2

KEITH WHEELER, VOL. 1145, PG. 285
AN ADDITION TO THE CITY OF ROCKWALL, ROCKWALL COUNTY, TEXAS

ASBUILT

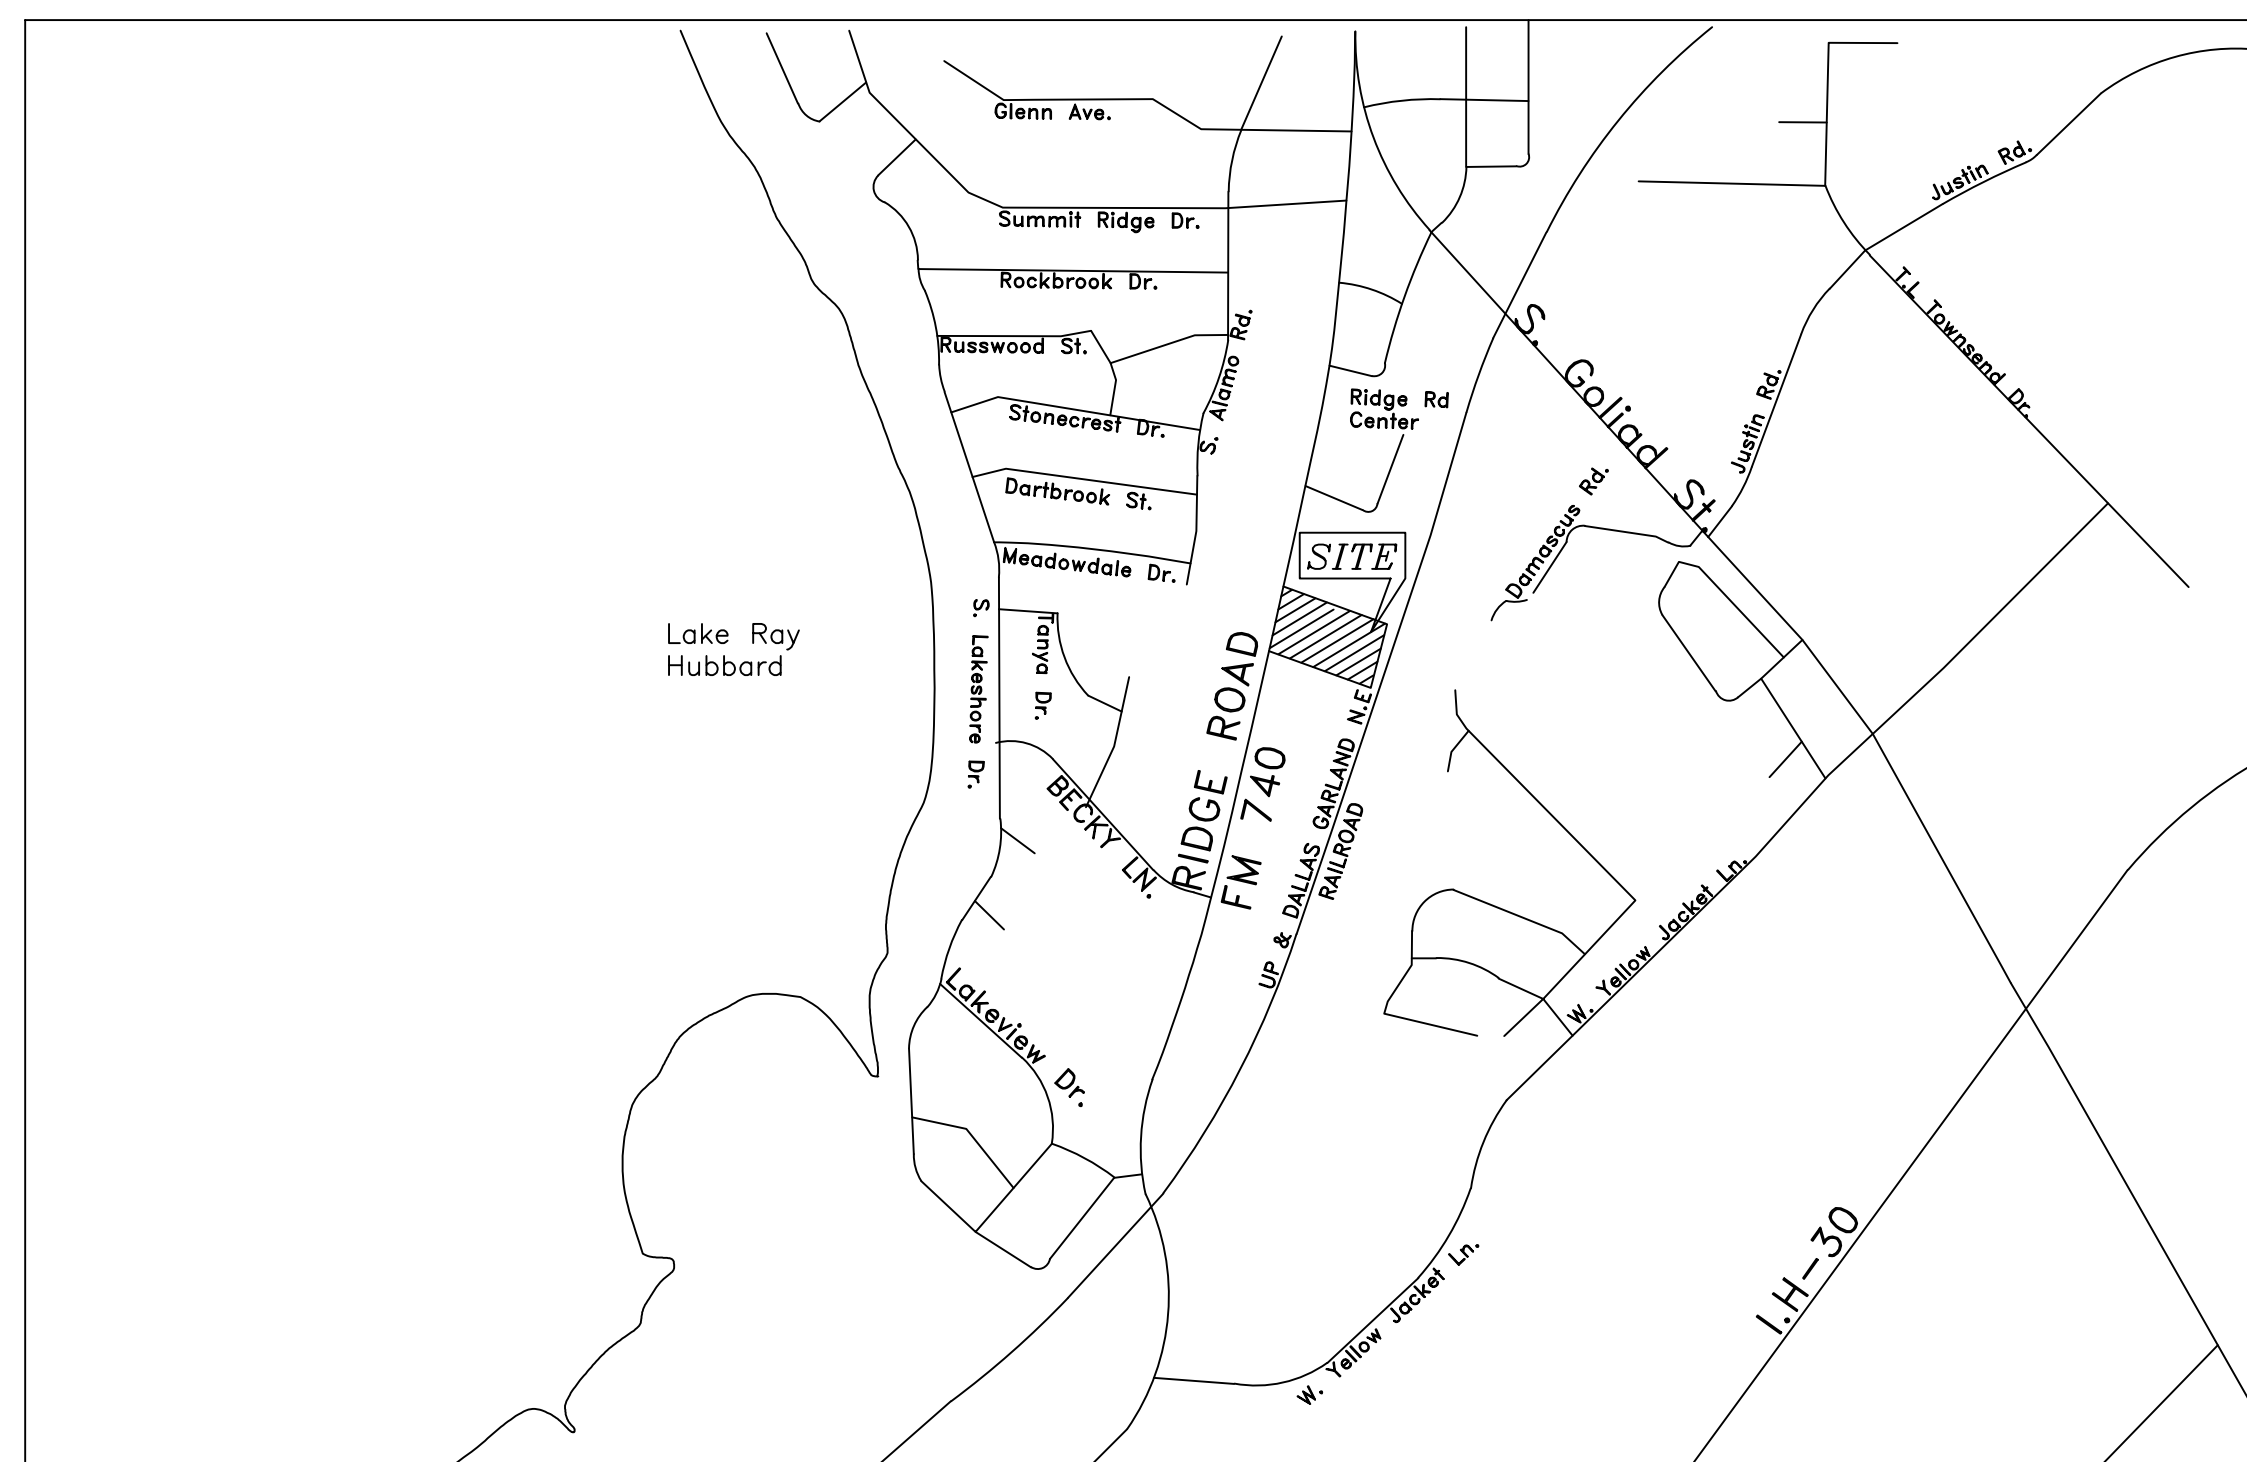

VICINITY MAP
MAPSCO: 20C-Y
NOT TO SCALE

INDEX OF SHEETS


SHEET NO.	TITLE
1	COVER SHEET.
2	FINAL PLAT (SHEET 1 OF 2).
3	FINAL PLAT (SHEET 2 OF 2).
4	SITE PLAN.
5	GRADING & PAVING NOTES.
6	GRADING & PAVING PLAN.
7	WATER LINE PLAN.
8	SANITARY SEWER LINES PLAN & PROFILES.
9	STORM SEWER PLAN.
10	STORM SEWER PROFILES (1 of 2).
11	STORM SEWER PROFILES (2 of 2).
12	DRAINAGE AREA MAP (PRE-DEVELOPMENT).
13	DRAINAGE AREA MAP (POST-DEVELOPMENT).
14	UNDERGROUND STORMWATER DETENTION COMPUTATIONS.
15	EROSION CONTROL PLAN.
16	EROSION CONTROL DETAILS.
17	LANDSCAPE PLAN.
18	CONCRETE RETAINING WALL DETAILS.
19	CONCRETE RETAINING WALL MISCELLANEOUS DETAILS.
20	60" HDPE PIPE DETAILS.

RECORD DRAWING


This Drawing Has Been Modified to Reflect Construction Records Provided To the Engineer.

5-31-2019

OWNER/ DEVELOPER: T ROCKWALL PHASE 2, LLC
16600 DALLAS PARKWAY, SUITE #300
DALLAS, TEXAS 75248
OWNER'S CONTACT: MUSHTAK KHATRI
E.MAIL: mkhatri@tabanigroup.com
TEL. (469) 726-3106

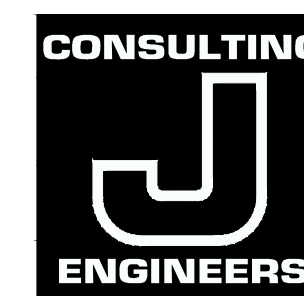

PLANS PREPARED BY:
JAHVANI CONSULTING ENGINEERS, INC.
2121 N. Josey Lane, Suite #100
Carrollton, Texas 75006
Tel. # (214) 718-9469
E.Mail jahvani@hotmail.com

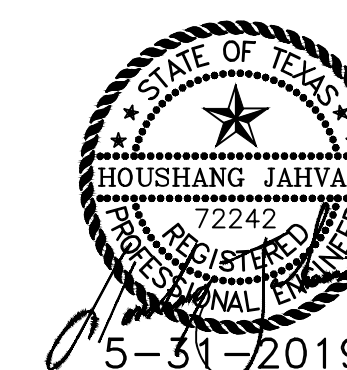

FLOOD PLAN NOTE:


ACCORDING TO FEMA FLOOD INSURANCE RATE MAP, COMMUNITY PANEL NUMBER 48397C0040L DATED SEP. 26, 2008, THIS PROPERTY LIES IN ZONE "X". THIS PROPERTY DOES NOT APPEAR TO LIE WITHIN A 100-YEAR FLOOD PLAIN.

BENCHMARK


THE ON SITE BENCHMARK IS A TEX.DOT DISK MARKER FOUND AT THE NORTHWEST CORNER OF SITE.
(ELEVATION = 559.30)

ROCKWALL COMMONS, PHASE-2
JAHVANI CONSULTING ENGINEERS, INC.

Eastridge Center
Cab A, Sl 263
CAMERON LAND HOLDINGS, LLC
Volume 6489, Page 230

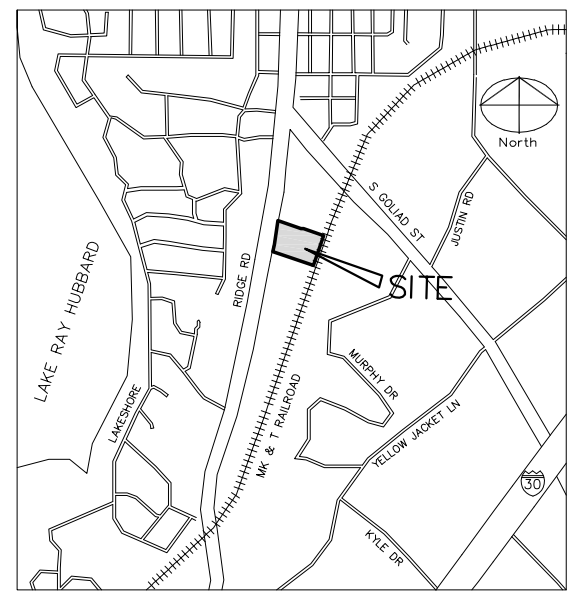

VICINITY MAP
nts

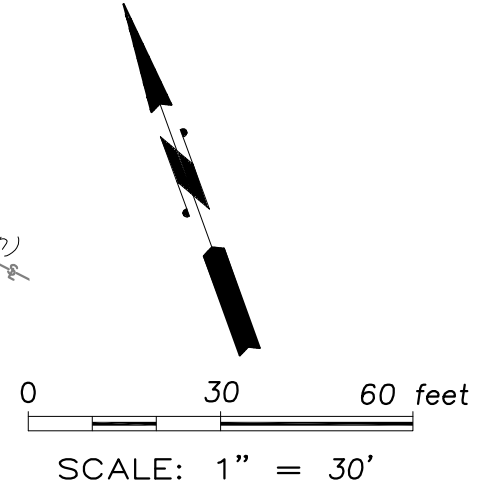

6893925.89' NORTH
2654125.72' EAST

ASBUILT

6893585.64' NORTH
2653615.64' EAST

Lot 6, Block A
Replat of Rockwall Commons
165,635 square feet
3.802 acres

T ROCKWALL PHASE 2, LLC
Inst. No. 2016000022646

LOT 5, BLOCK A
ROCKWALL COMMONS
Inst. No. 20140000017541

LOT 2, BLOCK A
REPLAT OF ROCKWALL COMMONS
Cabinet H, Slide 135
ROCKWALL COMMONS, LLC
Document No. 20140000018577

LOT 4, BLOCK A
REPLAT OF ROCKWALL COMMONS
Cabinet H, Slide 135
T ROCKWALL APARTMENTS TX, LLC
Volume 7271, Page 105

Final Plat
Rockwall Commons
Lot 6, Block A
Being a Replat of
Lot 5, Block A, Rockwall Commons
1 Lot, 3.802 Acres
in the B.J.T. Lewis Survey, Abstract No. 255
and the D. Atkins Survey, Abstract No. 1
City of Rockwall, Rockwall County, Texas
Case No. P2017-028

OWNER
T Rockwall Phase 2, LLC
16600 Dallas Parkway, Suite 300
Dallas, Texas 75248
(469) 726-3100

SURVEYOR
PIBURN & CARSON, LLC
801 E. Campbell Road, Suite 575
Richardson, Texas 75081
(214) 328-3500

PROPOSED EASEMENT
LINE & CURVE TABLE

LINE	BEARING	DISTANCE
L3	N 71°17'00" W	15.38'
L4	N 18°43'00" E	38.25'
L5	S 71°17'00" E	10.00'
L6	S 18°43'00" W	10.00'
L7	N 71°17'00" W	10.00'
L8	N 18°43'00" E	10.00'

EASEMENT TO BE ABANDONED
LINE & CURVE TABLE

LINE	BEARING	DISTANCE
L1	N 71°16'30" W	14.28'
L2	N 18°43'00" E	53.04'

CURVE	DELTA	CHORD BEARING	RADIUS	ARC LENGTH	CD. LENGTH
C3	36°35'43"	N 01°08'17" W	25.04'	15.99'	15.72'
C4	37°45'50"	S 00°09'55" E	25.00'	16.48'	16.18'
C5	31°27'20"	S 03°19'10" E	49.00'	26.90'	26.56'
C6	33°02'39"	S 04°06'49" E	25.00'	14.42'	14.22'

CURVE	DELTA	CHORD BEARING	RADIUS	ARC LENGTH	CD. LENGTH
C1	37°45'50"	S 00°09'55" E	49.00'	32.30'	31.71'
C2	55°45'32"	S 08°49'56" W	25.00'	24.33'	23.38'

NOTES:
brass mon = 3" TxDOT brass monument found for corner
cirf = 1/2" iron rod with orange plastic cap stamped
"P&C 100871" found for corner
irf = iron rod found for corner

The property owner is responsible for the maintaining, repairing, and replacing of all drainage and detention systems

No portion of the subject property lies within any area of 100-year flood according to FEMA's Flood Insurance Rate Map No. 48397C0040L, dated September 26, 2008. Property is in Zone X (unshaded).
City Monuments:

- COR-3 Aluminum disk stamped "City of Rockwall Survey Monument" on grass median in the CL of Summit Ridge Drive N=7023593.689 E=2594175.756
- COR-11 Brass Disk stamped "City of Rockwall Survey Monument" on the northeast side of Mims Road at teh southerly end of concrete headwall at the intersection of the northeast line of Mims Road with teh southeast line of I-30. N=7016792.505, E=2595405.639

BASIS OF BEARINGS:
Bearings are based upon the most northerly northeasterly line (South 71°26'08" East) of Lot 5, Block A as shown on plat of ROCKWALL COMMONS ADDITION, as recorded in Document No. 20140000017541 Plat Records, Rockwall County, Texas.

Copyright 2017 PIBURN & CARSON, LLC. All Rights Reserved. This drawing is the property of PIBURN & CARSON, LLC. Any modification or use of this drawing without the express written authorization of PIBURN & CARSON, LLC is prohibited. This drawing is only valid with a wet ink signature.

OWNER'S CERTIFICATE

STATE OF TEXAS §
COUNTY OF ROCKWALL §

WHEREAS T Rockwall Phase 2, LLC, being the owner of a tract of land in the County of Rockwall, State of Texas, said tract being described as follows:

BEING a 3.802 acre tract of land situated in the D. Atkins Survey, Abstract No. 1 and the B. J. T. Lewis Survey, Abstract No. 255, and being all of Lot 5, Block A, Rockwall Commons, an addition to the City of Rockwall as recorded in Instrument Number 201400000017541 Official Public Records, Rockwall County, Texas (O.P.R.R.C.T.), same being a tract of land described in deed to T Rockwall Phase 2, LLC recorded in Instrument Number 201600000022646 O.P.R.R.C.T., all being more particularly described as follows:

BEGINNING at a 1/2 inch iron rod found for corner in the southeasterly line of Ridge Road (FM 740) (a variable width public right-of-way), said rod also being the north corner of Lot 2, Block A of ROCKWALL COMMONS, an addition to the City of Rockwall as recorded in Cabinet H, Slide 135 Plat Records, Rockwall County, Texas;

THENCE North 12°32'48" East, along said southeasterly line of Ridge Road for a distance of 77.99 feet to a 3 inch TxDOT brass monument found for corner;

THENCE North 07°59'24" East, continuing along said southeasterly line of Ridge Road for a distance of 114.43 feet to a 1/2 inch iron rod with orange cap stamped "P&C 100871" found for corner;

THENCE North 12°20'00" East, continuing along said southeasterly line of Ridge Road for a distance of 150.68 feet to a 3 inch TxDOT brass monument found for corner, said monument being the west corner of Eastridge Center, an addition to the City of Rockwall as recorded in Cabinet A, Slide 263 Plat Records, Rockwall County, Texas;

THENCE South 71°26'08" East, departing said southeasterly line of Ridge Road and traveling along the southwesterly line of said Eastridge Center for a distance of 278.31 feet to a 3/8 inch iron rod found for corner;

THENCE South 71°14'00" East, continuing along said Eastridge Center for a distance of 231.77 feet to a 1/2 inch iron rod with orange cap stamped "P&C 100871" found for corner, said rod being the south corner of said Eastridge Center, said rod also being in the northwesterly line of the UP & Dallas Northeast Railroad (a 100 foot right-of-way);

THENCE South 18°59'52" West, along said northwesterly line of the UP & Dallas Northeast Railroad for a distance of 340.25 feet to a 1/2 inch iron rod found for corner, said rod being the east corner of Lot 4, Block A of aforementioned ROCKWALL COMMONS;

THENCE North 71°17'00" West, departing said northwesterly line of the UP & Dallas Northeast Railroad, traveling along the northeasterly line of said Lot 4 and continuing along the northeasterly line of aforementioned Lot 2 for a total distance of 461.98 feet to the POINT OF BEGINNING and containing 3.802 acres, or 165,635 square feet of land, more or less.

We the undersigned owners of the land shown on this plat, and designated herein as LOT 5A, BLOCK A, ROCKWALL COMMONS, an addition to the City of Rockwall, Texas, and whose name is subscribed hereto, hereby dedicate to the use of the public forever all streets, alleys, parks, water courses, drains, easements and public places thereon shown on the purpose and consideration therein expressed. We further certify that all other parties who have a mortgage or lien interest in the LOT 5A, BLOCK A, ROCKWALL COMMONS, addition have been notified and signed this plat.

We understand and do hereby reserve the easement strips shown on this plat for the purposes stated and for the mutual use and accommodation of all utilities desiring to use or using same. We also understand the following;

- 1. No buildings shall be constructed or placed upon, over, or across the utility easements as described herein.
2. Any public utility shall have the right to remove and keep removed all or part of any buildings, fences, trees, shrubs, or other growths or improvements which in any way endanger or interfere with construction, maintenance or efficiency of their respective system on any of these easement strips; and any public utility shall at all times have the right of ingress or egress to, from and upon the said easement strips for purpose of construction, reconstruction, inspecting, patrolling, maintaining, and either adding to or removing all or part of their respective system without the necessity of, at any time, procuring the permission of anyone.
3. The City of Rockwall will not be responsible for any claims of any nature resulting from or occasioned by the establishment of grade of streets in the subdivision.
4. The developer and subdivision engineer shall bear total responsibility for storm drain improvements.
5. The developer shall be responsible for the necessary facilities to provide drainage patterns and drainage controls such that properties within the drainage area are not adversely affected by storm drainage from the development.
6. No house dwelling unit, or other structure shall be constructed on any lot in this addition by the owner or any other person until the developer and/or owner has complied with all requirements of the Subdivision Regulations of the City of Rockwall regarding improvements with respect to the entire block on the street or streets on which property abuts, including the actual installation of streets with the required base and paving, curb and gutter, water and sewer, drainage structures, storm structures, storm sewers, and alleys, all according to the specifications of the City of Rockwall; or

Until an escrow deposit, sufficient to pay for the cost of such improvements, as determined by the city's engineer and/or city administrator, computed on a private commercial rate basis, has been made with the city secretary, accompanied by an agreement signed by the developer and/or owner, authorizing the city to make such improvements at prevailing private commercial rates, or have the same made by a contractor and pay for the same out of the escrow deposit, should the developer and/or owner fail or refuse to install the required improvements within the time stated in such written agreement, but in no case shall the City be obligated to make such improvements itself. Such deposit may be used by the owner and/or developer as progress payments as the work progresses in making such improvements by making certified requisitions to the city secretary, supported by evidence of work done; or

Until the developer and/or owner files a corporate surety bond with the city secretary in a sum equal to the cost of such improvements for the designated area, guaranteeing the installation thereof within the time stated in the bond, which time shall be fixed by the city council of the City of Rockwall.

We further acknowledge that the dedications and/or exaction's made herein are proportional to the impact of the Subdivision upon the public services required in order that the development will comport with the present and future growth needs of the City; We, our successors and assigns hereby waive any claim, damage, or cause of action that We may have as a result of the dedication of exactions made herein.

Owner

STATE OF TEXAS §
COUNTY OF DALLAS §

Before me, the undersigned authority, on this day personally appeared _____, known to me to be the person whose name is subscribed to the foregoing instrument and acknowledged to me that he/she executed the same for the purpose and consideration therein stated.

Given upon my hand and seal of office, this _____ day of _____, 2017.

Notary Public in and for the the State of Texas


My Commission Expires:

Signature of Party with Mortgage or Lien Interest

SURVEYOR'S CERTIFICATION

NOW, THEREFORE KNOW ALL MEN BY THESE PRESENTS:

That I, John R. Piburn, Jr., do hereby certify that I prepared this plat from an actual and accurate survey of the land, and that the corner monuments shown thereon were properly placed under my personal supervision.

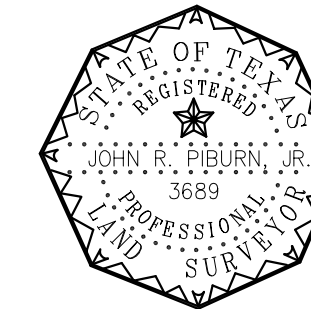

John R. Piburn, Jr.
Registered Public Surveyor No. 3689

RECOMMENDED FOR FINAL APPROVAL

Planning and Zoning Commission Date

APPROVED

I hereby certify that the above and foregoing plat of an addition to the City of Rockwall, Texas, was approved by the City Council of the City of Rockwall on the _____ day of _____, 2017.

This approval shall be invalid unless the approved plat for such addition is recorded in the office of the County Clerk of Rockwall County, Texas, within one hundred eight (180) days from said date of final approval.

WITNESS OUR HANDS, this _____ day of _____, 2017.

Mayor, City of Rockwall City Secretary City Engineer

Final Plat
Rockwall Commons
Lot 6, Block A
Being a Replat of
Lot 5, Block A, Rockwall Commons
1 Lot, 3.802 Acres
in the B.J.T. Lewis Survey, Abstract No. 255
and the D. Atkins Survey, Abstract No. 1
City of Rockwall, Rockwall County, Texas
Case No. P2017-028

OWNER: T Rockwall Phase 2, LLC, 16600 Dallas Parkway, Suite 300, Dallas, Texas 75248, (469) 726-3100
SURVEYOR: PIBURN & CARSON, LLC, 801 E. Campbell Road, Suite 575, Richardson, Texas 75081, (214) 328-3500

ASBUILT

NOTES:

1. NO CONSTRUCTION WORK TO BE DONE INSIDE THE RAIL ROAD RIGHT OF WAY WITHOUT LETTER OF PERMISSION FROM RAIL ROAD AUTHORITIES.
2. METAL SELF-LATCHING GATE SHALL BE USED ON THE DUMPSTER
3. FIRE LANE TO BE 6' MIN, 3600 PSI, 6.5 SACK.

SITE TABULATION:

APARTMENT BUILDING - 5 STORY OVER ONE LEVEL GARAGE

AVERAGE AREA = 1,059 S.F./ UNIT
 ONE (1) BEDROOMS = 36,423 S.F. = 25% (49 UNITS)
 TWO (2) BEDROOMS = 73,676 S.F. = 50% (67 UNITS)
 THREE (3) BEDROOMS = 38,105 S.F. = 25% (24 UNITS)

TOTAL APARTMENTS: 148,204 S.F., 140 UNITS


RETAIL BUILDING = 12,000 S.F.

TOTAL PARKING SPACES REQUIRED = 284

1 BEDROOMS = 49 X 1.5 = 73.5
 2 BEDROOMS = 67 X 2 = 134
 3 BEDROOMS = 24 X 2.5 = 60
 RETAIL = 12000 S.F. X 4/1000 = 48
 10% MIXED USE REDUCTION = -32

TOTAL PARKING SPACES PROVIDED = 288
 139 SPACES - GARAGE
 149 SPACES - OUTDOOR


HANDICAP PARKING SPACES REQUIRES = 8
 HANDICAP PARKING SPACES PROVIDED = 9

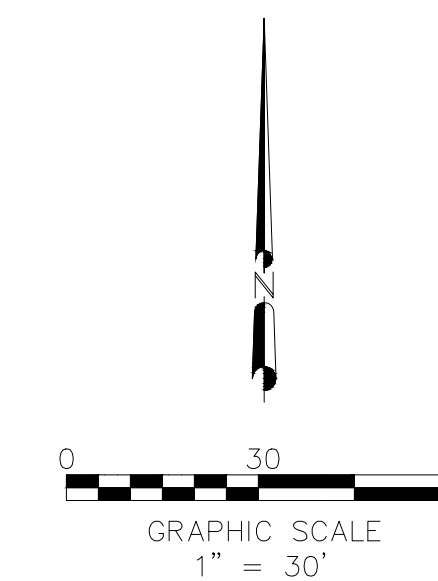

ASBUILT

RECORD DRAWING


This Drawing Has Been Modified to Reflect Construction Records Provided To the Engineer.
 5-31-2019

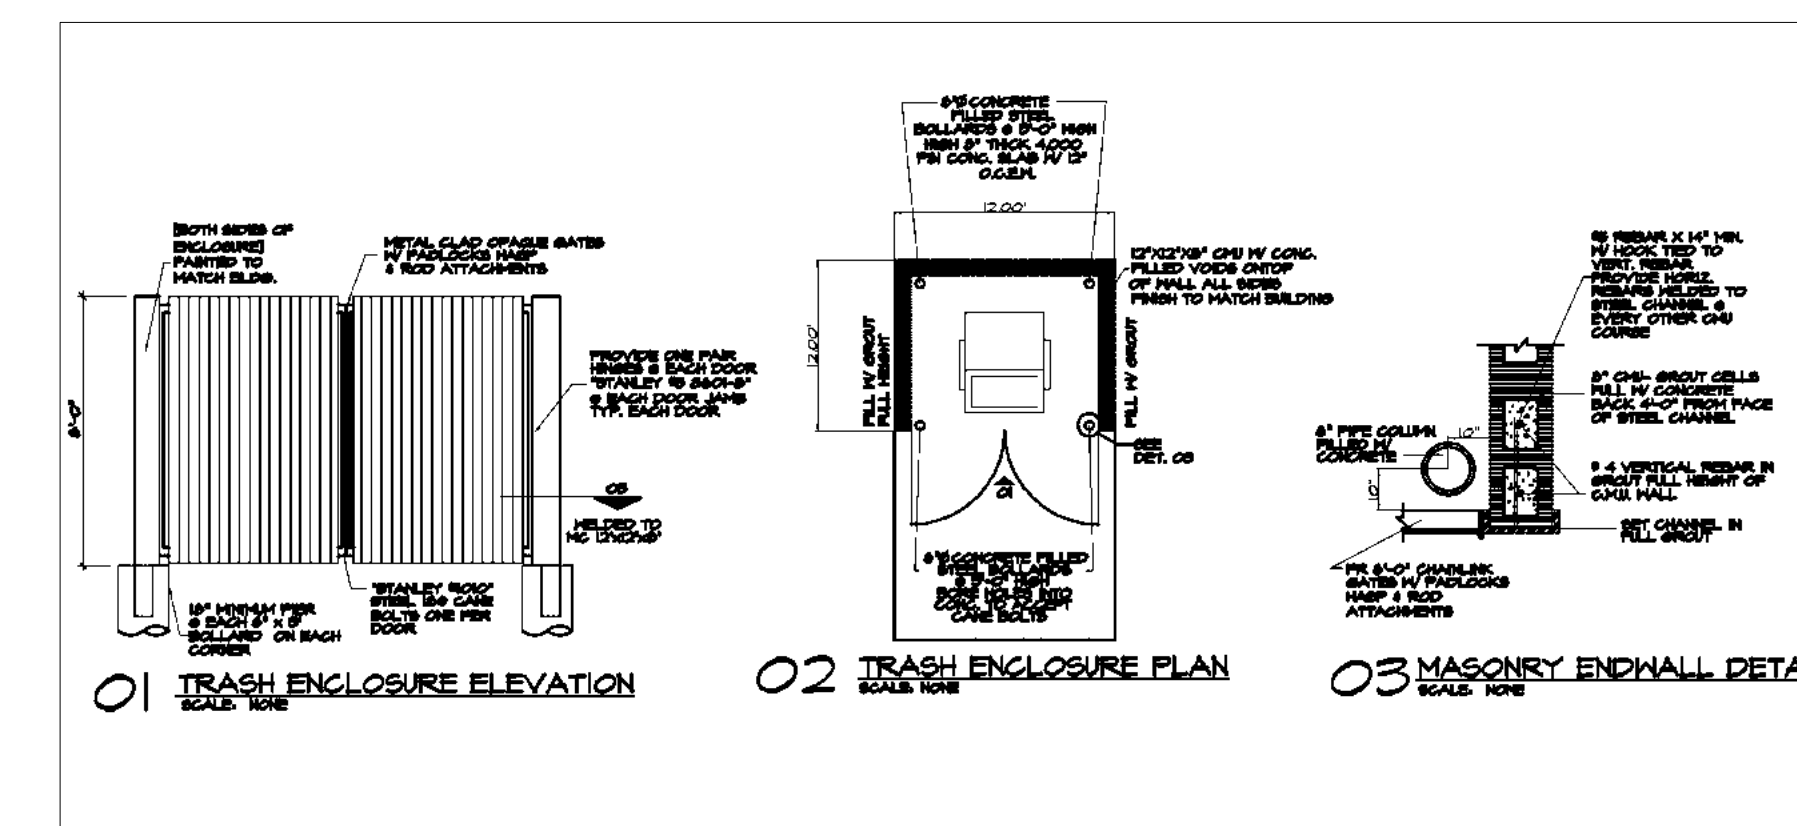

DUMPSTER DETAIL (NTS)

LEGEND:

FC-FC = FACE OF THE CURB TO FACE OF THE CURB
 BC-BC = BACK OF THE CURB TO BACK OF THE CURB

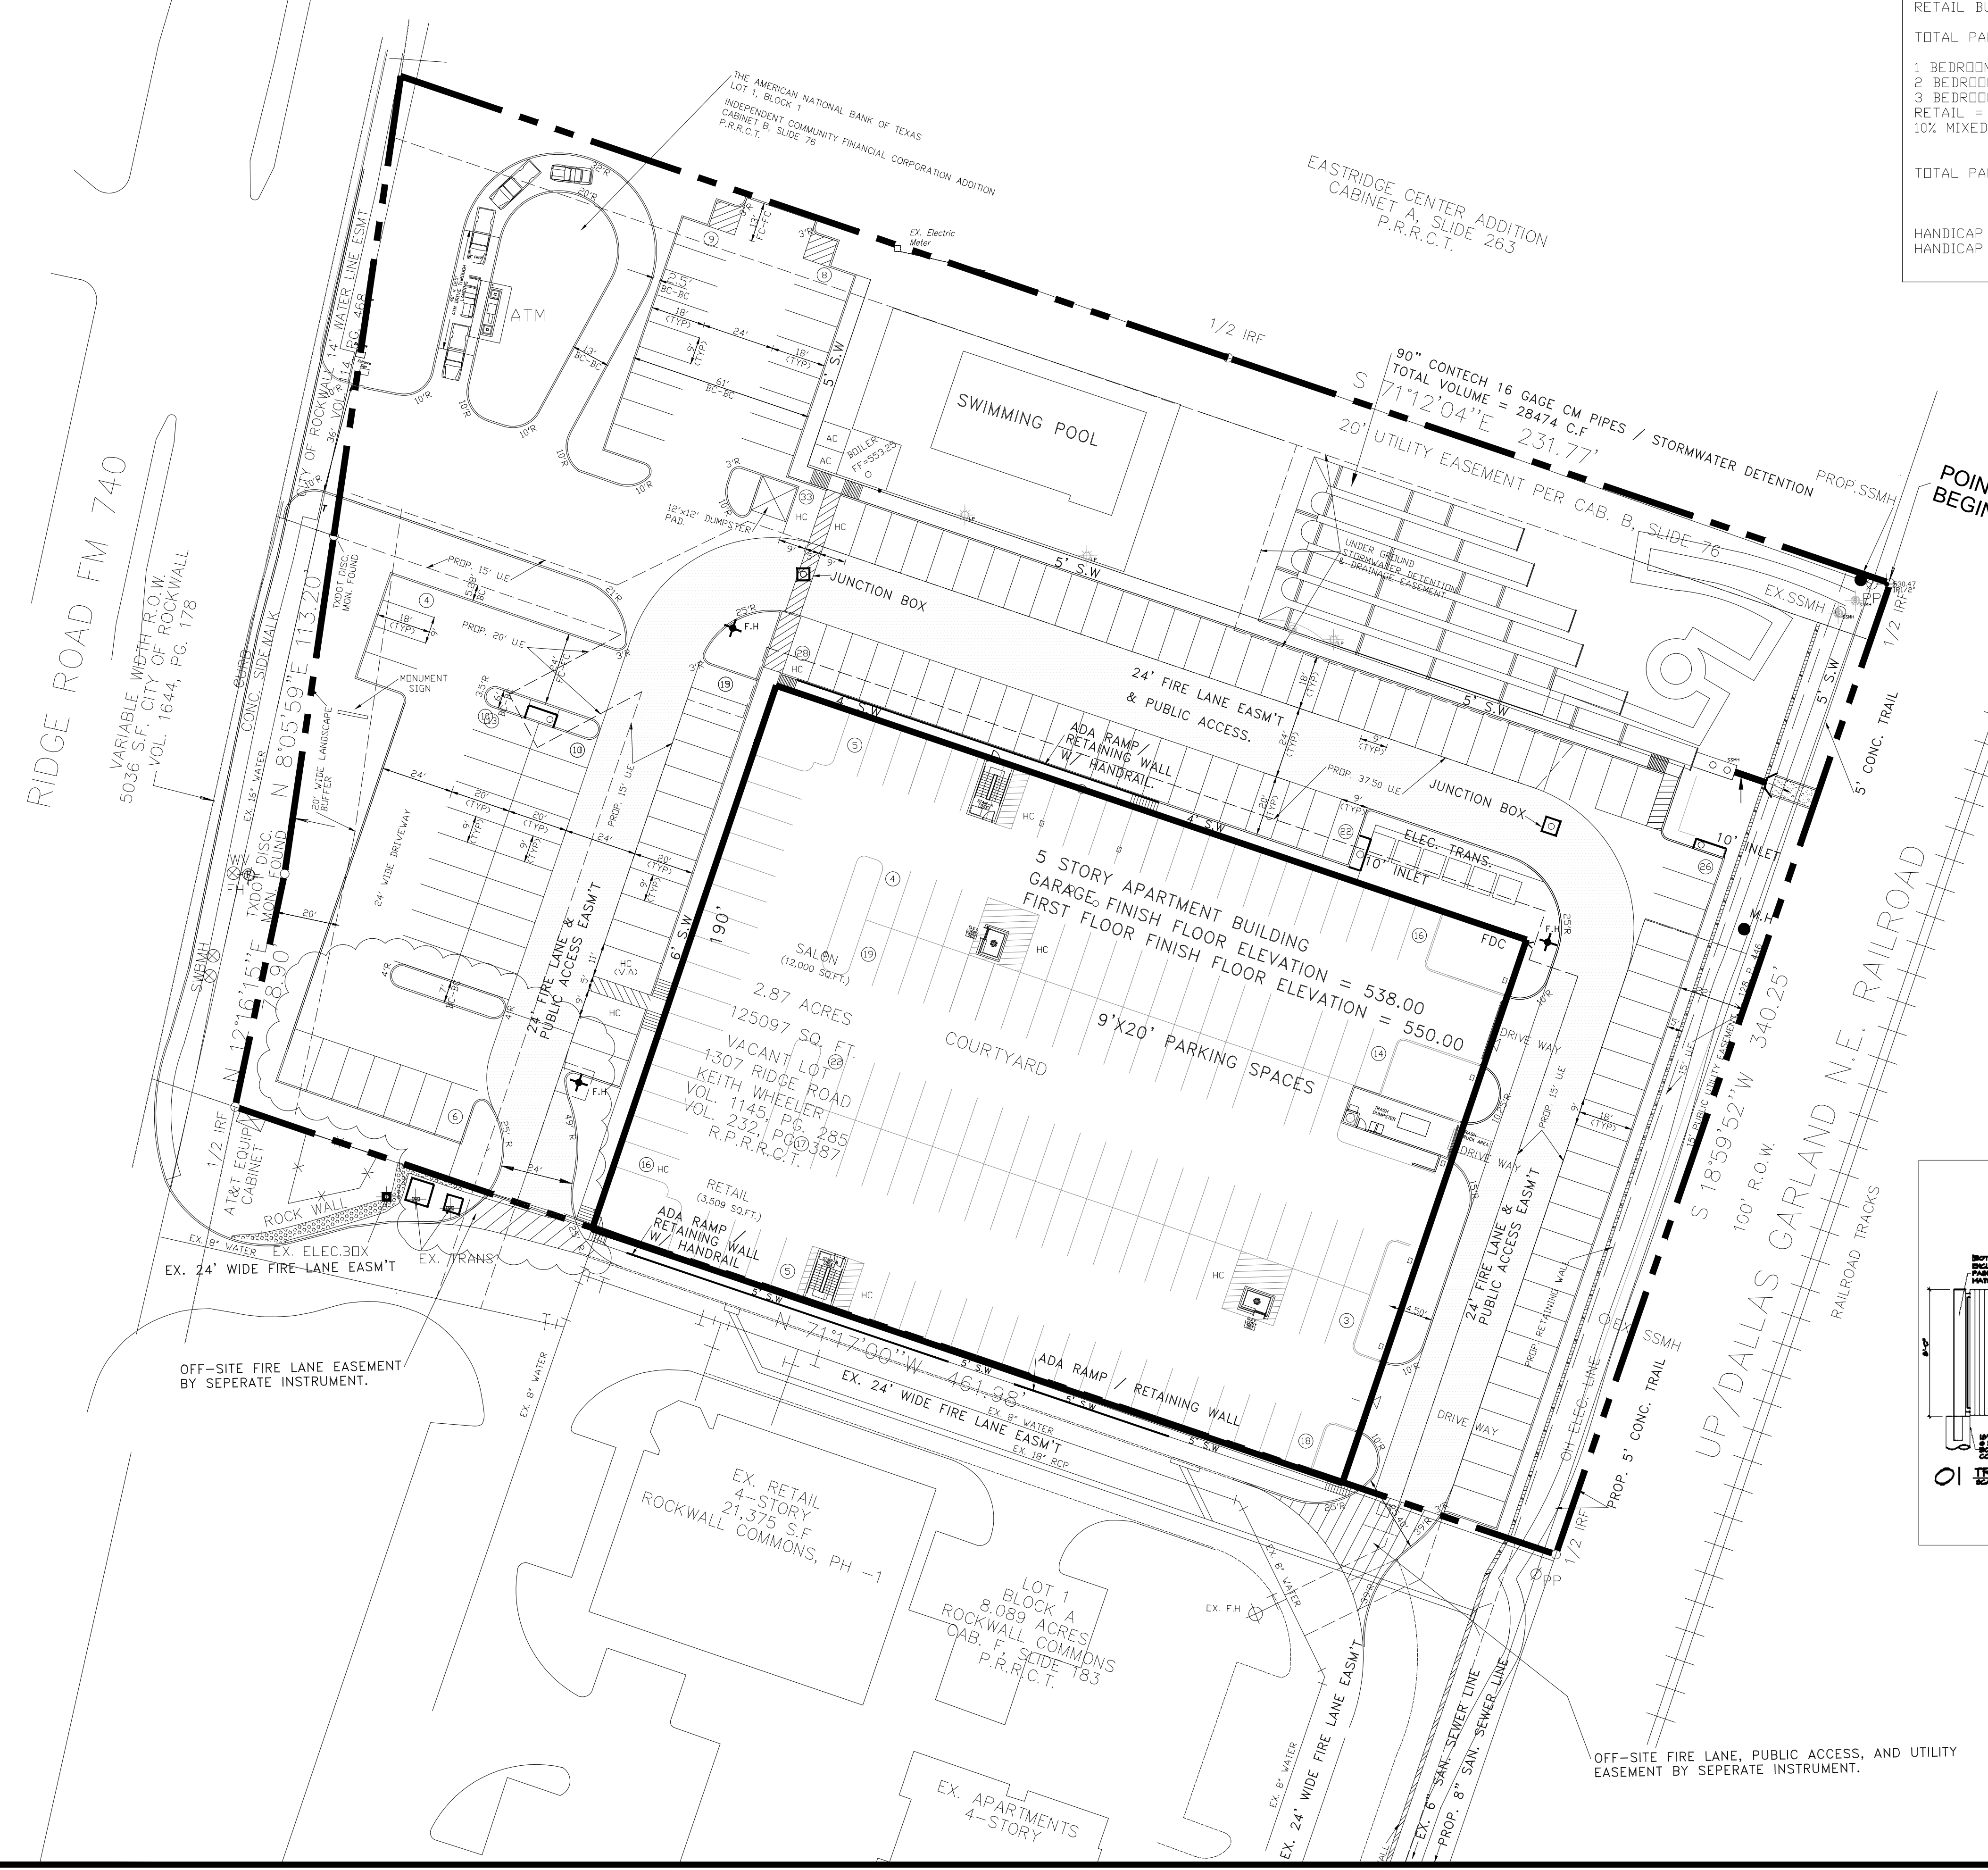

Rockwall Commons, Phase-2
 1301 Ridge Road
 Rockwall, Texas

JAHVANI CONSULTING ENGINEERS, INC.
 TBPE REGISTRATION NO. F-10198

CONSULTING ENGINEERS
 2121 N. JOSEY LANE, #100
 CARROLLTON, TEXAS 75006
 TEL: (214) 718-9469
 jahvani@hotmail.com

REVISIONS	DATE
SOUTHWEST ACCESS CONFIGURATION, NUMBER OF PARKING SPACES, AND LOCATION OF F.H 3-8-2017.	



DWG. TITLE: SITE PLAN

PROJECT #: DRAWN BY: HJ SCALE: 1" = 30' FILE NO:

DATE 5-31-2019

4 OF 20 SHEET NUMBER

MJR Engineering
 New Construction • Engineering • Environmental Services
 7953 PINKERTON COURT
 PLANO, TEXAS 75025
 PH: (469) 544-8150 FAX: (972) 767-3003
 EMAIL: mkmalhotra@gmail.com
 FIRM # - 9928

GRADING NOTES:

2. EROSION CONTROL WILL BE REQUIRED DURING ALL PHASES OF CONSTRUCTION. EROSION CONTROL MEASURES PER CITY OF ROCKWALL, TEXAS, STANDARD REQUIREMENTS.
3. SUBGRADE PREPARATION: SURFACE VEGETATION AND ANY FOREIGN MATERIALS SHOULD BE STRIPPED AND REMOVED PRIOR TO CONSTRUCTION OF THE BUILDING PAD AND PAVEMENTS. IS ESTIMATED THAT THIS MAY CONSIST OF STRIPPING BETWEEN 3 TO 6 INCHES OF EXISTING SOILS AT THE SITE.
4. DRAINAGE: THE UPPER PORTION OF UTILITY EXCAVATIONS SHOULD BE BACKFILLED WITH PROPERLY COMPACTED CLAYEY SOILS TO MINIMIZE INFILTRATION OF SURFACE WATER. A CLAY "PLUG" SHOULD BE PROVIDED ON THE EXTERIOR OF THE BUILDING TO PREVENT WATER FROM GAINING ACCESS TO THE SUBGRADE BENEATH THE STRUCTURE. ALL GRADES MUST BE ADJUSTED TO PROVIDE POSITIVE DRAINAGE AWAY FROM THE STRUCTURE WHERE PAVING ABUTS THE STRUCTURE, CARE SHOULD BE TAKEN THAT THE JOINT IS PROPERLY SEALED AND MAINTAINED. ROOF DRAINS SHOULD DISCHARGE ON PAVEMENT OR BE EXTENDED AWAY FROM THE STRUCTURE IDEALLY.
5. WASTE CUT ON UNUSED PORTION OF LOT. LEAVE SMOOTH IN MOWABLE CONDITION.
6. CUT PAD AS REQUIRED FOR 2.0' OF SELECT FILL MATERIAL. CONSTRUCTION PAD SHOULD EXTEND AT LEAST 5 FEET OUTSIDE THE PERIMETER BEAMS.
7. THE EXPOSED SUBGRADE SHOULD BE SCARIFIED TO A MINIMUM DEPTH OF EIGHT INCHES, THE MOISTURE ADDED OR ALLOWED TO DRY AND RE-COMPACTED TO NOT LESS THAN 95 PERCENT STANDARD PROCTOR (ASTM D698). THE MOISTURE CONTENT AT THE TIME OF COMPACTION SHOULD WITHIN +2% OF THE OPTIMUM PROCTOR VALUE.
8. IN ALL FILL SECTIONS, THE FILL AND SUBGRADE SHOULD BE COMPACTED. THE FILL AND SUBGRADE SHOULD BE COMPACTED TO A MINIMUM DENSITY OF NINETY-FIVE (95) PERCENT OF ASTM D-698 TO LIMIT SETTLEMENT. ANY CLAY FILL MATERIALS BELOW PAVEMENTS OR FLATWORK SHOULD NOT BE COMPACTED OVER ONE HUNDRED (100) PERCENT DENSITY. FILLS SHOULD BE COMPACTED IN MAXIMUM 8-INCH ALL FILL TO BE COMPACTED USING A SHEEP'S FOOT ROLLER.
9. SELECT FILL: THE MATERIAL USED AS SELECT FILL CONSIST OF A NON ACTIVE SANDY CLAY OR CLAYEY SAND, HAVING A LIQUID LIMIT OF 40 OR LESS AND PLASTICITY INDEX (P.I.) VARYING FROM 4 TO 15 A MINIMUM OF 15 TO 45 PERCENT OF THE SOIL SHOULD PASS THE NO. 200 SIEVE. THE MATERIAL SHOULD BE SPREAD IN LOOSE HORIZONTAL LIFTS, LESS THAN 9 INCHES THICK, AND BE UNIFORMLY COMPACTED TO A MINIMUM OF 95 PERCENT OF THE MAXIMUM STANDARD PROCTOR DENSITY BETWEEN -3 TO +3 PERCENTAGE POINTS OF IT'S OPTIMUM MOISTURE CONTENT AS DETERMINED BY ASTM D-698. IT IS RECOMMENDED THE SELECT FILL PLACEMENT BEGIN IMMEDIATELY AFTER THE SUBGRADE HAS BEEN PREPARED.
10. PERFORM FIELD DENSITY TESTS TO VERIFY COMPACTION AT A FREQUENCY OF ONE TEST PER ONE FOOT OF FILL FOR EVERY 2000 SQ. FT. OF COMPACTED AREA.
11. MAINTAIN THE MOISTURE CONTENT OF BOTH FILL AND NATURAL SOIL UNTIL IT IS PERMANENTLY SEALED WITH THE FLOOR SLAB OR PAVEMENT.
12. SAND SHOULD NOT BE USED AS A LEVELING COURSE UNDER FLOOR SLAB AND PAVEMENT, SINCE IT PROVIDES READY PATH FOR MOISTURE TO GET IN.
13. POSITIVE DRAINAGE MUST BE PROVIDED AWAY FROM THE STRUCTURE TO PREVENT THE PONDING OF WATER IN THE SELECT FILL.
14. CARE MUST BE TAKEN THAT BACKFILL AGAINST THE EXTERIOR FACE OF GRADE BEAMS IS PROPERLY COMPACTED ON-SITE CLAY. THE SELECT FILL SHOULD NOT EXTEND OUTSIDE THE LIMITS OF THE STRUCTURE.
15. THE NEED TO LIME STABILIZE WILL BE DETERMINED BY TESTING FOLLOWING SUBGRADE EXCAVATION. DEPENDING ON SOIL TYPE AND WEATHER CONDITION TO BE DETERMINED BY G.C. OWNER AND OWNER'S ENGINEER, A COPY OF GEOTECH REPORT MUST BE SUBMITTED TO THE CITY..

PAVING NOTES

1. ALL CONSTRUCTION SHALL CONFORM TO CITY AND NCTCOG 3RD EDITION STANDARDS AND SPECIFICATIONS. CONTRACTOR IS RESPONSIBLE FOR OBTAINING A CURRENT COPY OF THE CITY STANDARD DETAILS AND SPECIFICATIONS.
2. CONTRACTOR MUST MATCH GRADE AT PROPERTY LINE AND NOT OBSTRUCT EXISTING DRAINAGE PATTERNS PRESENTLY DIRECTED ONTO THE PROPERTY.
3. ALL DIMENSIONS SHOWN ARE TO FACE OF CURB UNLESS OTHERWISE NOTED.
4. ALL CURB SHALL BE INTEGRAL WITH CONCRETE PAVEMENT. ALL JOINTS SHALL CONTINUE THROUGH CURB.
5. REINFORCEMENT SHALL NOT BE CONTINUOUS THROUGH EXPANSION JOINTS.
6. CONTRACTOR SHALL SAW-CUT EXISTING PAVEMENT AND CURBS TO PROVIDE A SMOOTH CONNECTION AND INSURE POSITIVE DRAINAGE. ALL SAWCUTS OF EXISTING PAVEMENT SHALL BE FULL DEPTH OF PAVEMENT.
7. CONTRACTOR SHALL COORDINATE INSTALLATION OF ALL SIGNS, PAVEMENT MARKINGS AND OTHER TRAFFIC CONTROL DEVICES WITH OTHER CONTRACTORS ON SITE.
8. DRIVEWAY CONSTRUCTION MUST BE COMPLETED WITHIN 72 HOURS AFTER CURB CUT HAS BEGUN.
9. ALL CONSTRUCTION SHALL ADHERE TO RECOMMENDATIONS IN THE GEOTECHNICAL REPORT ISSUED FOR THIS SITE.
10. PAVEMENT SHALL BE 6-INCH THICK CONCRETE PAVEMENT.
11. CONCRETE STRENGTH SHALL BE A MINIMUM OF 3600 psi AT 28 DAYS (MIN 6.5 SACK MIX.
12. PAVEMENT REINFORCEMENT SHALL BE NO. 3 BARS AT 18" O.C.E.W.
13. CONTRACTION JOINTS SHALL BE SPACED ACCORDING TO CITY OF ROCKWALL REQUIREMENTS.
14. IT SHALL BE THE RESPONSIBILITY OF THE CONTRACTOR TO PROTECT ALL PUBLIC UTILITIES IN THE CONSTRUCTION OF THIS PROJECT. ALL MANHOLES, CLEANOUTS, VALVE BOXES, FIRE HYDRANTS, etc. MUST BE ADJUSTED TO PROPER LINE AND GRADE BY THE CONTRACTOR PRIOR TO AND AFTER THE PLACING OF PERMANENT PAVING.
15. PRIOR TO CONSTRUCTION, THE CONTRACTOR SHALL VERIFY THE LOCATION OF VALVES, MANHOLES, FIRE HYDRANTS, GAS/TELEPHONE/ELECTRICAL LINES THAT ARE AFFECTED BY THE CONSTRUCTION.
16. SAW CUTTING SHALL BE DONE WITHIN 8 HOURS OF POUR OR AS SOON AS CONCRETE CAN SUPPORT WEIGHT AND CAN PROVIDE A NEAT CUT WHICH IS TRUE IN ALIGNMENT.
17. RADIAL JOINTS SHALL BE NO SHORTER THAN 1.5 FEET.
18. CONTRACTOR SHALL USE A THICKENED EDGE EXPANSION JOINT AROUND THE PERIMETER OF ANY BLOCKOUT IN THE CONCRETE PAVING.
19. ALL CONSTRUCTION JOINTS SHALL BE SAWN, CLEANED OF DEBRIS, BLOWN DRY AND IMMEDIATELY SEALED PER N.C.T.C.O.G. SPECIFICATIONS.
20. ANCHOR JOINTS ARE REQUIRED AT ALL CONNECTIONS TO EXISTING PAVEMENT.
21. SUBGRADES OF PAVING AREAS SHALL BE MAINTAINED IN A MOIST CONDITION UNTIL THE PAVEMENT/CONCRETE IS PLACED.
22. THE CONTRACTOR SHALL PROVIDE AS-BUILT PLANS TO THE ENGINEER SO THAT THE ENGINEERING PLANS MAY BE REVISED TO REFLECT AS-BUILT CONDITIONS.
23. TRAFFIC BARRICADES WILL BE REQUIRED AT ALL PROPOSED DRIVE CONNECTIONS AND CONSTRUCTION IN PUBLIC RIGHT-OF-WAY. BARRICADES AND TRAFFIC CONTROL SHALL ADHERE TO THE APPLICABLE INSTALLATION.
24. WATER MAY NOT BE APPLIED TO THE SURFACE OF CONCRETE PAVING TO IMPROVE THE WORKABILITY.


ASBUILT

MJR Engineering
 New Construction • Engineering • Environmental Services
 7953 PINKERTON COURT
 PLANO, TEXAS 75025
 PH: (469) 544-8150 FAX: (972) 767-3003
 EMAIL: mkamal67@gmail.com
 FIRM # - 9928

Rockwall Commons, Phase-2
 1301 Ridge Road
 Rockwall, Texas

JAHVANI CONSULTING ENGINEERS, INC.
 TBPE REGISTRATION NO. F-10198
 CONSULTING ENGINEERS
 2121 N. JOSEY LANE, #100
 CARROLLTON, TEXAS 75006
 TEL: (214) 718-9469
 jahvani@hotmail.com

REVISIONS	DATE


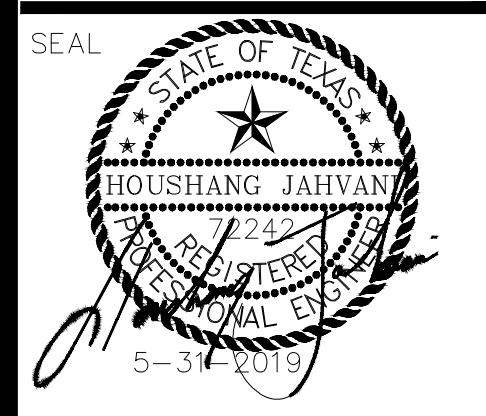


DWG. TITLE:
GRADING & PAVING NOTES

PROJECT #:
DRAWN BY: HJ
SCALE: 1" = 30'
FILE NO:
DATE 5-31-2019

ASBUILT

- NOTES:
1. NO CONSTRUCTION WORK TO BE DONE INSIDE THE RAIL ROAD RIGHT OF WAY WITHOUT LETTER OF PERMISSION FROM RAIL ROAD AUTHORITIES.
 2. FIRE LANE TO BE 6" MIN, 3600 PSI, 6.5 SACK.
 3. FIRE HYDRANT TO BE 5 FEET BEHIND CURB.

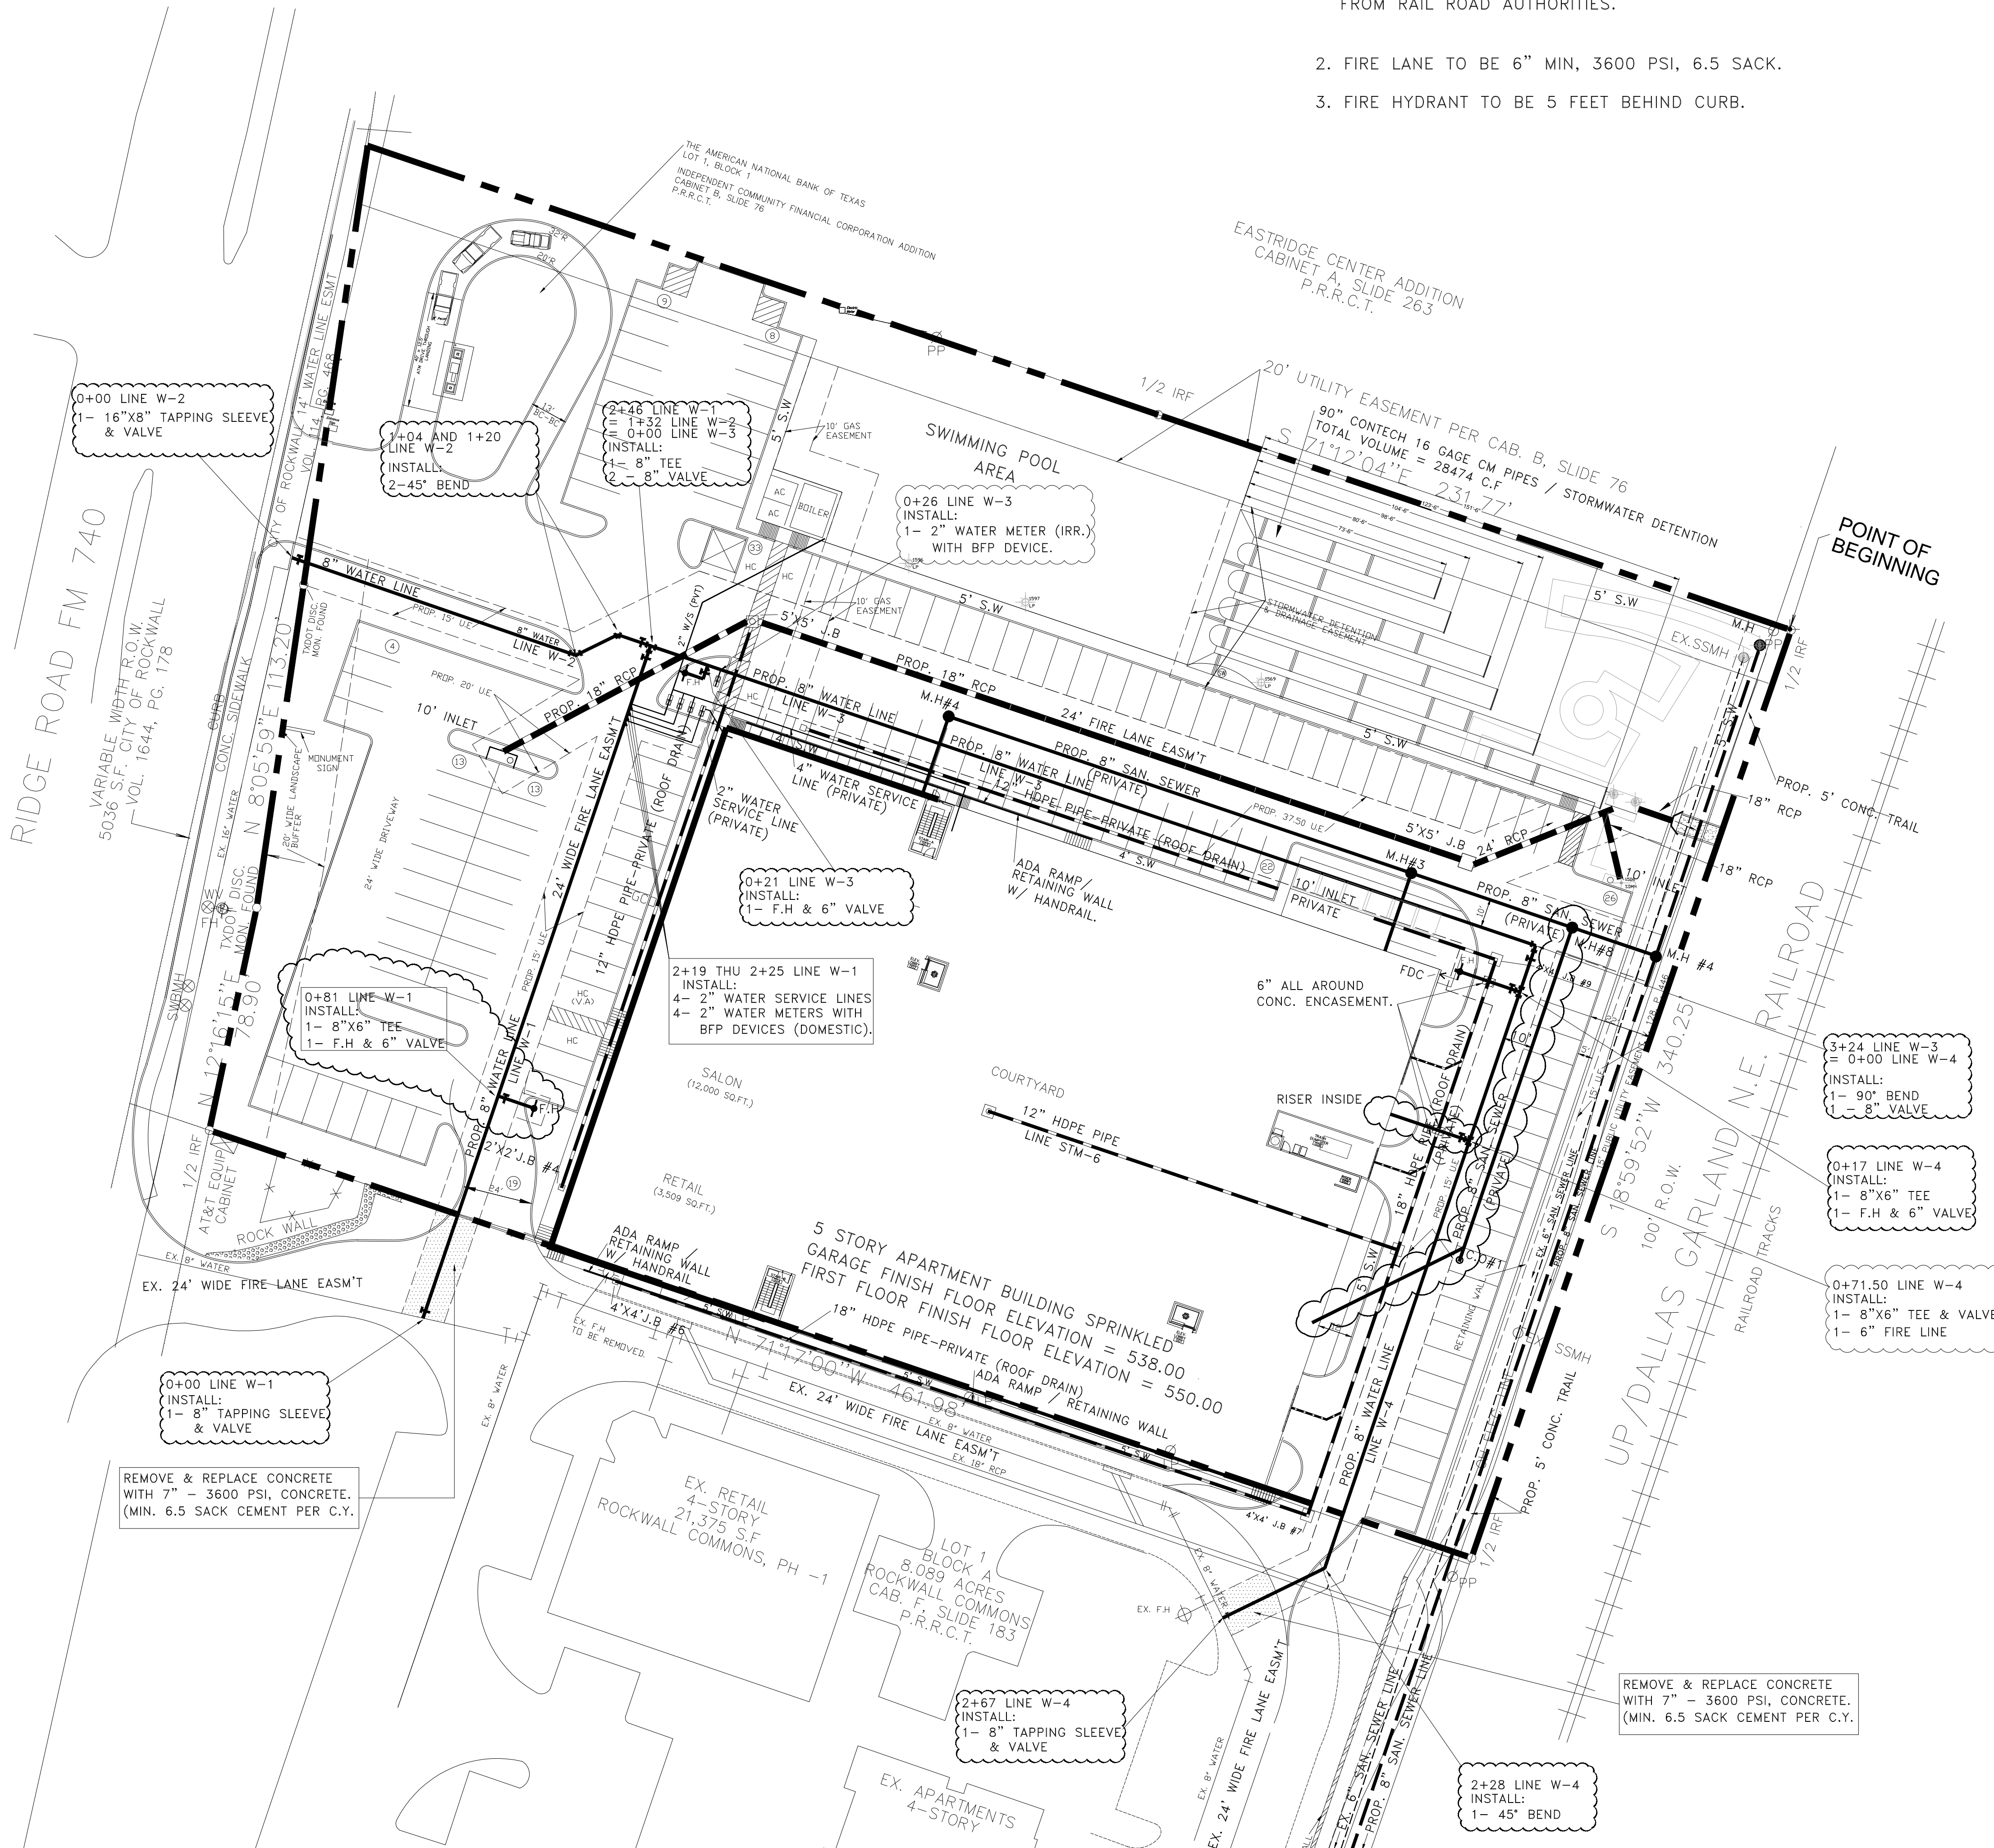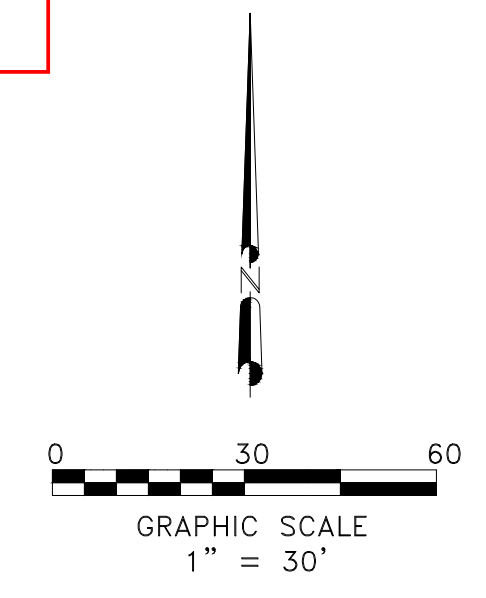

- GENERAL NOTES:
1. ALL WORK SHALL BE IN ACCORDANCE WITH CITY OF ROCKWALL STANDARDS AND SPECIFICATIONS AND NCTG 03RD EDITION.
 2. ENGINEERING DEPARTMENT IS TO BE NOTIFIED 48 HOURS PRIOR TO ANY CONSTRUCTION.
 3. ALL WATER LINES TO HAVE 42 INCH TYPICAL COVER OR AS REQUIRED TO CLEAR OTHER UTILITIES.
 4. 8" WATER MAINS SHALL BE PVC AWWA C900 (DR 14) CLASS 200.
 5. 8" SANITARY SEWER LINE SHALL BE PVC ASTM D2034 (SDR 35).
 6. TRENCH EXCAVATION FOR TRENCHES 5 FEET OR MORE IN DEPTH SHALL BE IN ACCORDANCE WITH ALL PROVISIONS OF PART 1926, SUBPART P-EXCAVATIONS, TRENCHING AND SHORING OF THE OCCUPATIONAL SAFETY AND HEALTH'S STANDARDS AND INTERPRETATIONS. IT SHALL BE THE RESPONSIBILITY OF THE CONTRACTOR TO CONFORM TO THE ABOVE STATED PROVISIONS AND TO SUPPLY TRENCH SAFETY PLANS IF REQUIRED BY THE CITY.
 7. THE LOCATION OF ALL UTILITIES INDICATED ON THE PLANS ARE TAKEN FROM AVAILABLE PUBLIC RECORDS; THE EXACT LOCATION AND DEPTH OF ALL UTILITIES INDICATED MUST BE DETERMINED BY THE CONTRACTOR. IT SHALL BE THE DUTY OF THE CONTRACTOR TO ASCERTAIN WHETHER ANY ADDITIONAL FACILITIES OTHER THAN THOSE SHOWN ON THE PLANS MAY BE PRESENT.
 8. IT SHALL BE THE RESPONSIBILITY OF THE CONTRACTOR TO PROTECT ALL EXISTING UTILITIES IN THE CONSTRUCTION OF THIS PROJECT. ANY UTILITIES DAMAGE DURING THE CONSTRUCTION OF THIS PROJECT SHALL BE REPAIR AT THE CONTRACTOR'S EXPENSE.
 9. ALL SANITARY SEWER MANHOLES SHALL BE PRECAST UNLESS OTHERWISE NOTED. MANHOLES TO BE RIVEN LINED OR APPROVED EQUAL TO BE PRESSURE AND SPARK TESTED.
 10. ALL MANHOLES AND RIMS AND VALVE STACKS TO BE ADJUSTED TO FINAL PAVING GRADE. ALL MANHOLES IN PAVING OR SWALES TO BE SEALED.
 11. CONTRACTOR SHALL STAKE OUT CURB LINE TO ENSURE NO SANITARY SEWER MH OR WATER VALVES FALL ON A CURB. CONTRACTOR SHALL ENSURE NO FIRE HYDRANT OBSTRUCTS ANY PORTION OF A SIDEWALK.
 12. CONTRACTOR SHALL CONSTRUCT A 12"x12" CONCRETE PAD AROUND ALL WATER VALVES LOCATED IN A GRASS AREA.
 13. IRRIGATION METER REQUIRES A REDUCED PRESSURE ZONE BACKFLOW PREVENTION DEVICE (RPZ). SEE LANDSCAPE PLANS.
 14. CONTRACTOR SHALL COMPLETE ALL FILL OPERATIONS PRIOR TO INSTALLING ANY UTILITIES (I.E., WATER, SANITARY, SEWER, STORM, SEWER). AFTER FILL OPERATIONS ARE COMPLETED, CONTRACTOR SHALL EXCAVATE UTILITY TRENCH, INSTALL UTILITIES, COMPACT TRENCH AND ENSURE ALL PUBLIC WORKS INSPECTIONS ARE PROPERLY PERFORMED.
 15. FOR FRANCHISE UTILITY LOCATOR SERVICES, TEXAS ONE CALL AT 1-800-344-8377, OR UTILITY LOCATOR AT 1-800-DIG-TESS.
 16. FOR SOLID WASTE SERVICE INFORMATION AND CONTAINER DELIVERY, PLEASE CONTACT: ALLIED WASTE SERVICES INC., DISTRICT MANAGER, 1450 E. CLEVELAND, HUTCHINS, TEXAS, 75141-9317; TELEPHONE 972-225-4207.
 17. CONTRACTOR SHALL ENSURE THERE ARE NO OBSTRUCTION OR OVERHANGS TO THE SIDEWALKS (I.E., FIRE HYDRANTS, POWER POLES, ETC.).
 18. FIRE LANES, WATER MAINS, AND FIRE HYDRANTS SHALL BE INSTALLED, OPERATIONAL, CONSTRUCTION AND C.O. ISSUED PRIOR TO ANY CONSTRUCTION ABOVE THE FOUNDATION.
 19. ENGINEERING PLANS MUST SHOW THE FIRE DEPARTMENT CONNECTION AND FIRE SPRINKLES LEAD INTO THE FACILITY. FIRE SPRINKLER LINE SHALL BE CLASS 200 AND SHALL BE INSTALLED BY A LICENSED CONTRACTOR. THE CONTRACTOR SHALL TEST AND THE FIRE DEPARTMENT INSPECTOR SHALL INSPECT THE FIRE SPRINKLER LINE INSIDE THE FIRE CLOSET AT THE FLANGE. FIRE LINE LEAD TO BUILDING TO BE INSPECTED BY FIRE DEPARTMENT.
 20. IF THE WATER MAIN IS DEEPER THAN 5 FEET AT THE FIRE HYDRANT CONNECTION, CONTRACTOR SHALL INSTALL GRADE LOCK.
 21. NO METER BOXES ALL ALLOWED IN SIDEWALK OR OTHER PAVING.
 22. ALL DOMESTIC AND IRRIGATION SERVICE REQUIRED DOUBLE CHECK AND BACK FLOW PREVENTION DEVICES.
 23. BLUE EMS DISKS TO BE INSTALLED ON THE WATER LINE AT EVERY CHANGE IN DIRECTION, VALVE, FIRE HYDRANT, AND SERVICES.
 24. GREEN EMS DISKS TO BE INSTALLED ON THE SANITARY SEWER AT EVERY CHANGE IN DIRECTION, MANHOLE, CLEANOUT, AND SERVICES.
 25. ALL PRIVATE SEWER TO BE MAINTAINED BY PROPERTY OWNER.


RECORD DRAWING
 This Drawing Has Been Modified to Reflect
 Construction Records Provided to the Engineer.
 5-31-2019

Rockwall Commons, Phase-2
 1301 Ridge Road
 Rockwall, Texas

JAHVANI CONSULTING ENGINEERS, INC.
 TYPE REGISTRATION NO. F-10188
 2121 N. JOSEY LANE, #100
 CARROLLTON, TEXAS 75006
 TEL. (214) 718-9469
 jahvani@hotmail.com

REVISIONS

1-	REVISED 8" FIRE LINE TO 6" FIRE LINE AND MOVED IT FROM STA. 0+27 TO STA. 0+71.50 LINE W-4 DATE ON 5-31-2017.
2-	ADDED 8" SAN. SEWER LINE SS-3 WITH A M.H. AND CLEANOUT ON 5-31-2017
3-	MOVED F.H FROM STA. 0+45 TO 0+81 LINE W-1 6-15-2017
3-	ADDED GAS LINE EASM'T. 9-20-2017

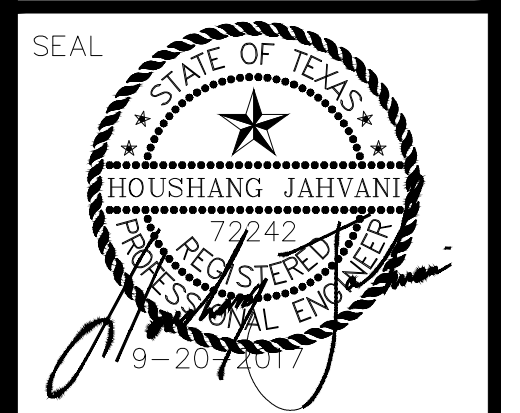

DWG. TITLE:
 WATER LINE PLAN
 DRAWN BY: HJ
 SCALE: 1" = 30'
 FILE NO:
 DATE 9-20-2017

ASBUILT

LOT 1
BLOCK A
8.089 ACRES
ROCKWALL COMMONS
CAB. F. SLIDE 183
P.R.R.C.T.

ROCKWALL COMMONS, PH -1
EX. APARTMENTS
4-STORY

EX. RETAIL
4-STORY
21,375 S.F.

EX. 24' WIDE FIRE LANE EASM'T

EX. 8" WATER

0+89 LINE SS-2
CONSTRUCT 4" M.H. #6
WITH INTERNAL DROP CONN.
TOP = 539.75
F.L. IN = 534.00 (WEST)
F.L. IN = 534.00 (SOUTH)
F.L. OUT = 530.75

2+58 LINE SS-1
CONSTRUCT 4" M.H. #7
TOP = 547.40
F.L. IN (8") = 541.65
F.L. OUT (6") = 541.35

0+00 LINE SS-1
EX. 4" M.H.
TOP = 519.00
F.L. IN = 510.54
F.L. OUT = 510.34




EX. SS M.H. #1
TOP = 519.65
FL = 510.35

0+17 LINE SS-1
CONSTRUCT 4" M.H. #1
TOP = 517.00
F.L. IN = 510.94
F.L. OUT = 510.74

1+32 LINE SS-1
CONSTRUCT 4" M.H. #2
TOP = 519.00
F.L. IN = 511.29
F.L. OUT = 512.09

5+98 LINE SS-1
CONSTRUCT 4" M.H. #3
TOP = 522.00
F.L. IN = 516.15
F.L. OUT = 515.95

11+57 LINE SS-1
CONSTRUCT 4" M.H. #5
TOP = 531.00
F.L. = 521.98

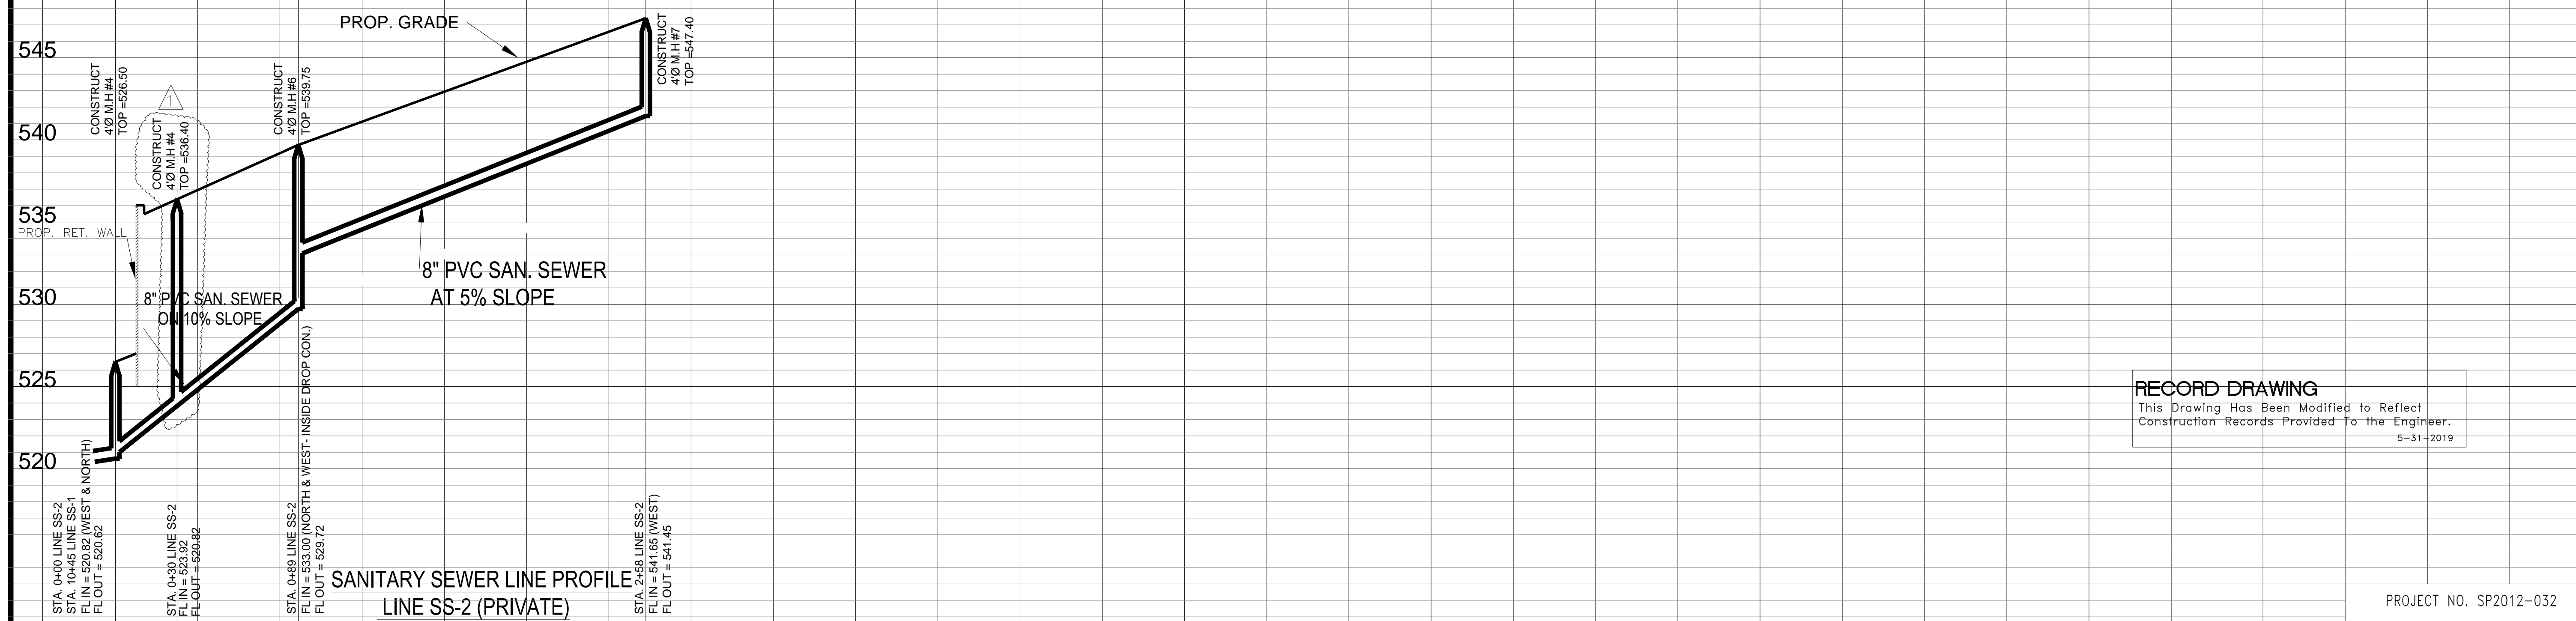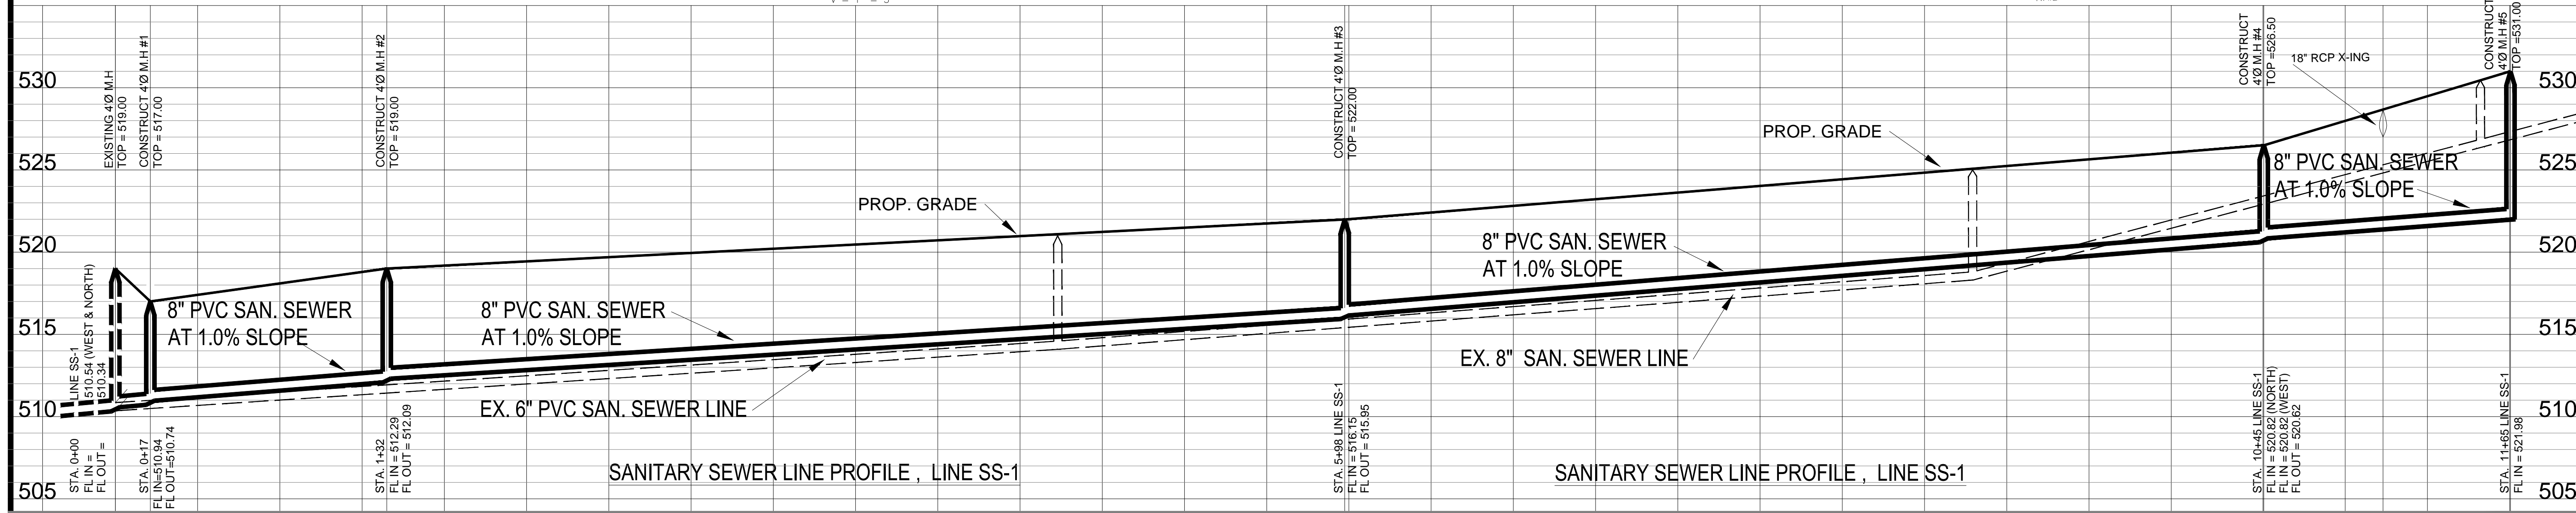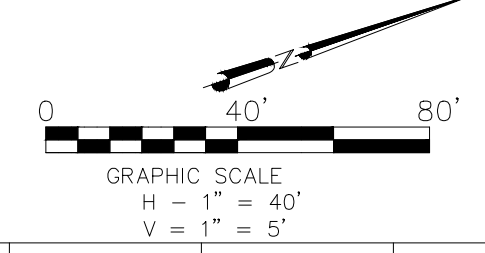

RECORD DRAWING
This Drawing Has Been Modified to Reflect
Construction Records Provided To the Engineer.
5-31-2019


MJR Engineering
New Construction • Engineering • Environmental Services
7953 PINKERTON COURT
PLANO, TEXAS 75025
PH: (469) 544-8150 FAX: (972) 767-3003
EMAIL: mkmalal7@gmail.com
FIRM # F - 9928

Rockwall Commons, Phase-2
1301 Ridge Road
Rockwall, Texas

JAHVANI CONSULTING ENGINEERS, INC.
TBP# REGISTRATION NO. F-10198
CONSULTING ENGINEERS
2121 N. JOSEY LANE, #100
CARROLLTON, TEXAS 75006
TEL: (214) 718-9469
jahvani@hotmail.com

REVISIONS

NO.	DATE	DESCRIPTION
1	5-31-2019	8" SANITARY SEWER WITH M.H. AND C.O. (PRIVATE).

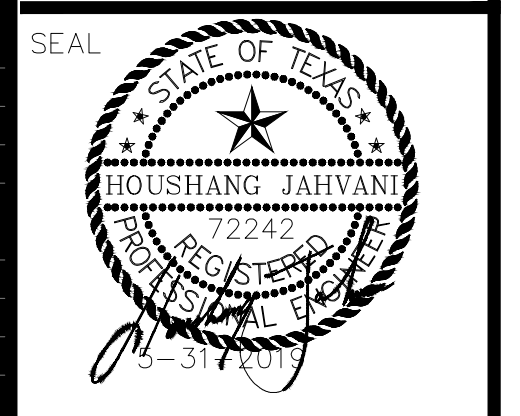

DWG. TITLE:
SANITARY SEWER LINES
PLAN & PROFILES

PROJECT #:
DRAWN BY: HJ
SCALE: H- 1" = 40'
V- 1" = 5'
FILE NO:
DATE 5-31-2019

NOTES:

- NO CONSTRUCTION WORK TO BE DONE INSIDE THE RAIL ROAD RIGHT OF WAY WITHOUT LETTER OF PERMISSION FROM RAIL ROAD AUTHORITIES.
- FIRE LANE TO BE 6' MIN, 3600 PSI, 6.5 SACK.

ON-SITE DRAINAGE AREA DATA

DRAINAGE AREA (D.A.#)	AREA (ACRE)	I _c (MIN)	"c" (N/HR)	I ₁₀₀ (N/HR)	Q ₁₀₀ (CFS)
D.A.#1	0.96	10	0.90	9.80	8.47
D.A.#2	0.57	10	0.90	9.80	5.00
D.A.#3	0.42	10	0.90	9.80	3.70
D.A.#4	0.20	10	0.90	9.80	1.76
D.A.#5	0.08	10	0.90	9.80	0.70
D.A.#6	0.05	10	0.90	9.80	0.44
D.A.#7	0.08	10	0.90	9.80	0.70
D.A.#8	0.05	10	0.90	9.80	0.44
D.A.#9	0.11	10	0.90	9.80	0.97
D.A.#10	0.11	10	0.90	9.80	0.97
D.A.#11	0.14	10	0.90	9.80	1.23
D.A.#12	0.10	10	0.90	9.80	0.88
D.A.#13	0.14	10	0.90	9.80	1.23
D.A.#14	0.10	10	0.90	9.80	0.88
D.A.#15	0.76	10	0.90	9.80	6.70

18" STORM SEWER PIPE DATA

STORM SEWER LINE #	FROM STATION	TO STATION	PIPE LENGTH (ft)	DRAINAGE AREA		Q100 Runoff		BYPASS FROM INLET (CFS)	TOTAL "Q" (CFS)	Pipe Size (inch)	n	Sf	Pipe Slope (ft/ft)	V (in)	V (out)	Comments	
				Incremental (D.A.#)	Total (Area, Acre)	Incr. (cfs)	Total (cfs)										
STM-1	4+00	3+03	97	1	0.96	8.47	8.47	0	8.47	18	0.013	0.0065	0.01	6	6	-	
STM-1	3+03	0+42	261	12	0.10	0.88	9.35	0	9.35	18	0.013	0.0077	0.04	6	6.5	-	
STM-1	0+42	00+04	38	2,452,789	1.63	2.69	14.32	23.67	0	23.67	24	0.013	0.0200	0.01	0	0	-
STM-1	0+04	00+00	4	3	0.42	0.42	3.70	27.37	0	27.37	24	0.013	0.0200	0.01	0	0	-
STM-2	0+43	00+00	43	3	0.42	0.42	3.70	3.70	0	3.70	18	0.013	0.0200	0.01	0	0	-
STM-3	0+29	00+00	29	2,452,789	1.63	2.69	14.32	14.32	0	14.32	18	0.013	0.0200	0.01	0	0	-
STM-4	0+64	00+00	64	-	-	3.65	17.94	11.24	0	11.24	18	0.013	0.0200	0.01	0	0	-


12" HDPE PIPE ROOF DRAIN DATA

STORM SEWER LINE #	FROM STATION	TO STATION	PIPE LENGTH (ft)	DRAINAGE AREA		Q100 Runoff		BYPASS FROM INLET (CFS)	TOTAL "Q" (CFS)	Pipe Size (inch)	n	Sf	Pipe Slope (ft/ft)	V (in)	V (out)	Comments	
				Incremental (D.A.#)	Total (Area, Acre)	Incr. (cfs)	Total (cfs)										
STM-5	2+27	00+00	227	9.13	0.25	2.20	2.20	0	2.20	12	0.013	0.0065	0.01	6	6	-	
STM-6	1+49	00+00	149	4,5,6,7,8	0.46	4.04	4.04	0	4.04	12	0.013	0.0077	0.04	6	6.5	-	
STM-7	4+79	2+27	252	11	0.14	1.23	1.23	0	1.23	12	0.013	0.0077	0.04	6	6.5	-	
STM-7	2+27	1+30	97	10,14	0.21	1.85	3.08	0	3.08	12	0.013	0.0200	0.01	0	0	-	
STM-7	1+30	0+24	106	4,5,6,7,8	0.46	0.81	4.04	7.12	0	7.12	12	0.013	0.0200	0.01	0	0	-
STM-7	0+24	0+00	24	-	-	0.81	0	7.12	0	7.12	12	0.013	0.0200	0.01	0	0	-
STM-8	2+07	0+00	207	12	0.10	0.88	0.88	0	0.88	12	0.013	0.0200	0.01	0	0	-	

NOTE: ALL PRIVATE STORM SEWERS TO BE MAINTAINED BY THE PROPERTY OWNER.

ASBUILT

RECORD DRAWING
This Drawing Has Been Modified to Reflect Construction Records Provided to the Engineer.
5-31-2019

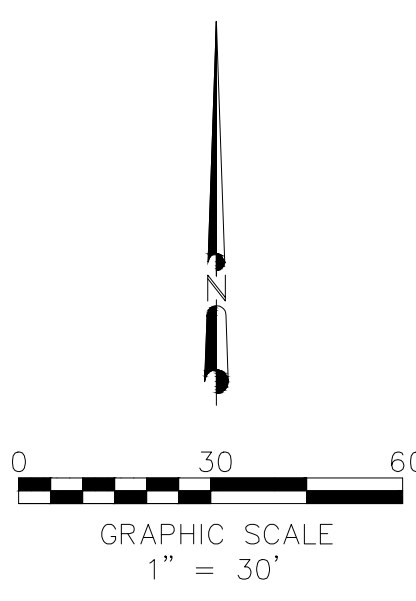


ABBREVIATIONS:
C.B = CATCH BASIN
J.B = JUNCTION BOX
D.S = ROOF DRAIN DOWN SPOT
D.A = DRAINAGE AREA
AC = ACRE

PROJECT NO. SP2012-032

JAHVANI CONSULTING ENGINEERS, INC.
1301 Ridge Road
Rockwall, Texas

JAHVANI CONSULTING ENGINEERS, INC.
TYPE REGISTRATION NO. F-10198
2121 N. JOSEY LANE, #100
CARROLLTON, TEXAS, 75006
TEL: (214) 718-9469
jahvani@hotmail.com


REVISIONS DATE
ADDED 3 TRENCH GRATE INLETS AT GARAGE ENTRANCES 2-15-2015
REVISED 60" HDPE PIPES TO 90" CORRUGATED PIPE BY CONTECH. 1-23-2017
REVISED INLET #2 AND STM-3 LOCATION 3-13-2017

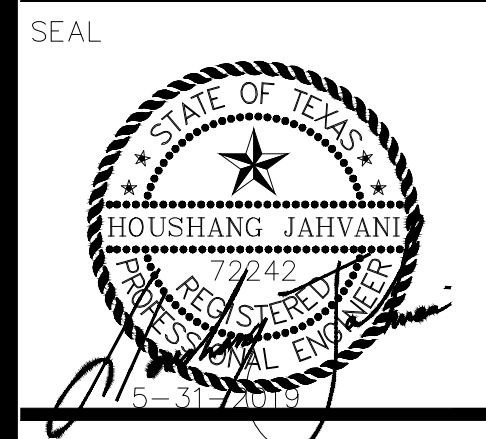

DWG. TITLE:
STORM SEWER PLAN
PROJECT #:
DRAWN BY: HJ
SCALE: 1" = 30'
FILE NO:
DATE 5-31-2019

9 OF 20
SHEET NUMBER

MJR Engineering
New Construction • Engineering • Environmental Services
7953 PINKERTON COURT
PLANO, TEXAS 75025
PH: (469) 544-8150 FAX: (972) 767-3003
EMAIL: mjkmaib7@gmail.com
FIRM # F-9928

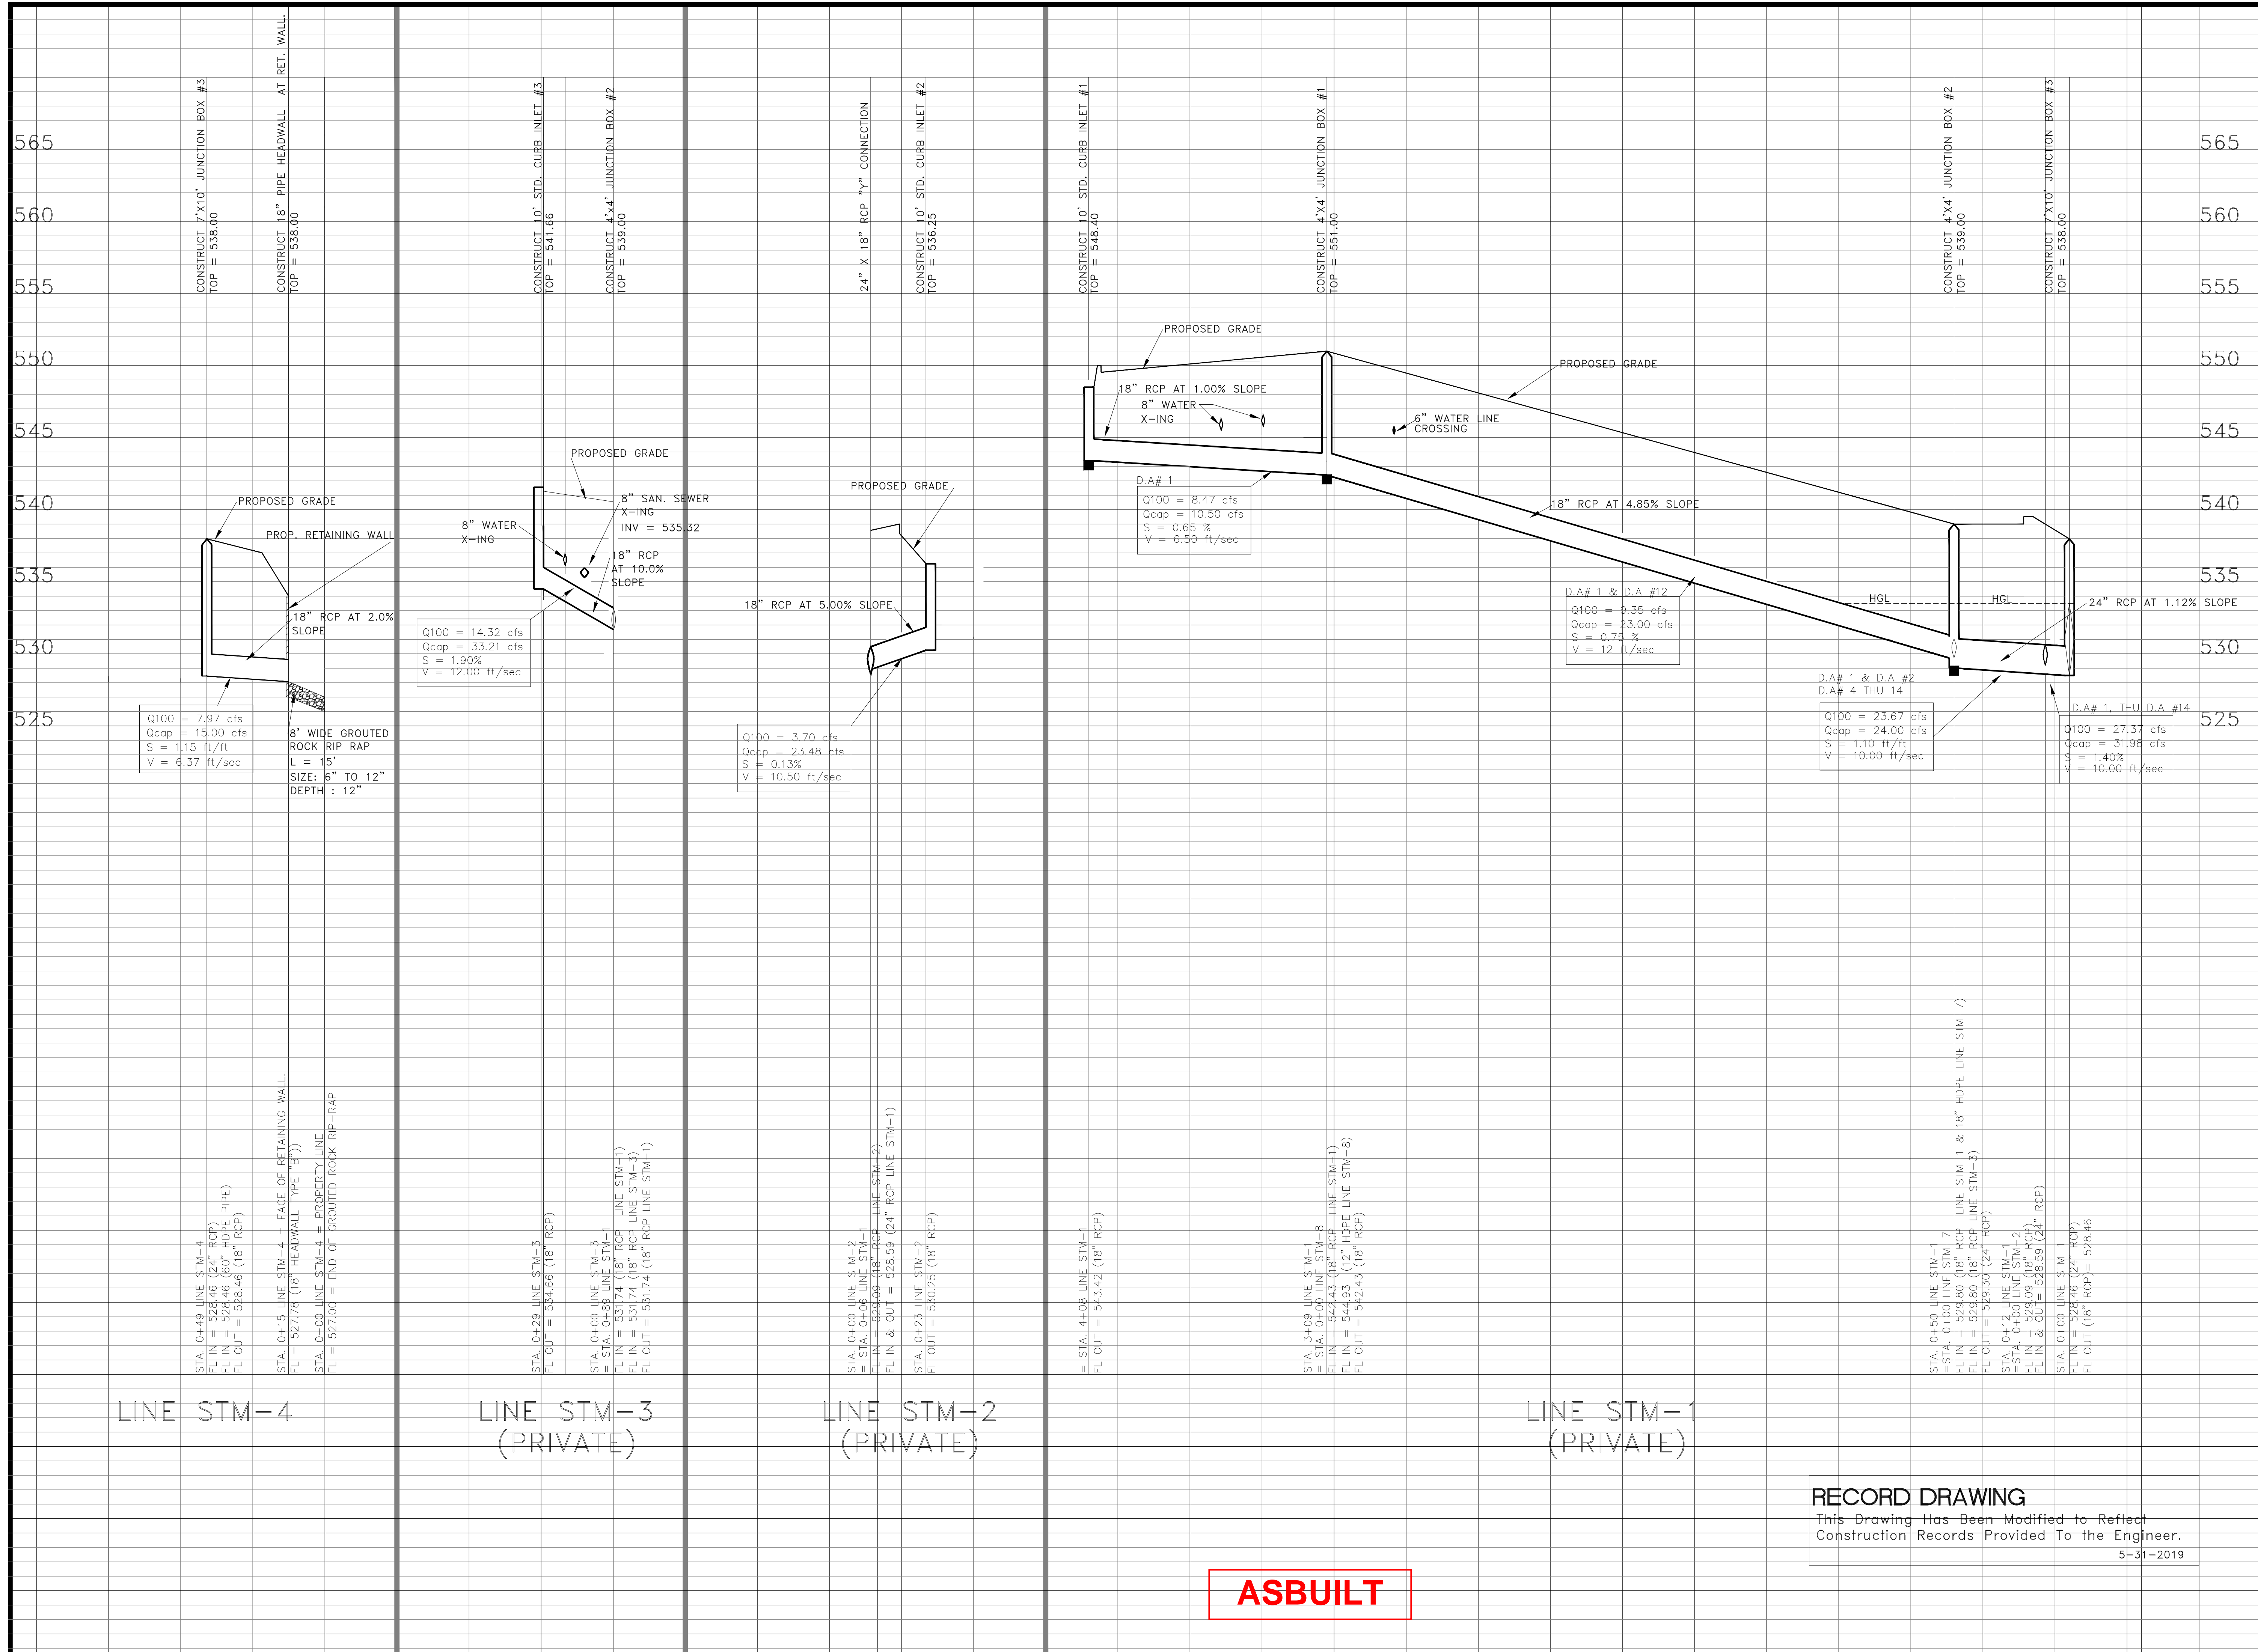

LINE STM-4

LINE STM-3
(PRIVATE)

LINE STM-2
(PRIVATE)

LINE STM-1
(PRIVATE)

RECORD DRAWING
 This Drawing Has Been Modified to Reflect
 Construction Records Provided To The Engineer.
 5-31-2019


ASBUILT

MJR Engineering
 New Construction • Engineering • Environmental Services
 7953 PINKERTON COURT
 PLANO, TEXAS 75025
 PH: (469) 544-8150 FAX: (972) 767-3003
 EMAIL: mkamal67@gmail.com
 FIRM # F - 9928

Rockwall Commons, Phase-2
 1301 Ridge Road
 Rockwall, Texas

JAHVANI CONSULTING ENGINEERS, INC.
 TBPE REGISTRATION NO. F-10198
 CONSULTING ENGINEERS
 2121 N. JOSEY LANE, #100
 CARROLLTON, TEXAS 75006
 TEL. (214) 718-9469
 jahvani@hotmail.com

REVISIONS	DATE
REVISIED LINE STM-3 PROFILE = 3-13-2017	

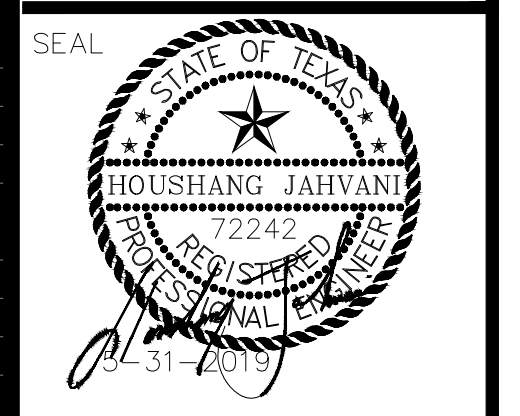



DWG. TITLE:
 STORM SEWER LINE
 PROFILES (1 of 2).

PROJECT #:
 DRAWN BY: HJ
 SCALE: 1" = 30'
 FILE NO:

DATE 5-31-2019

10 OF 20
 SHEET NUMBER

ASBUILT

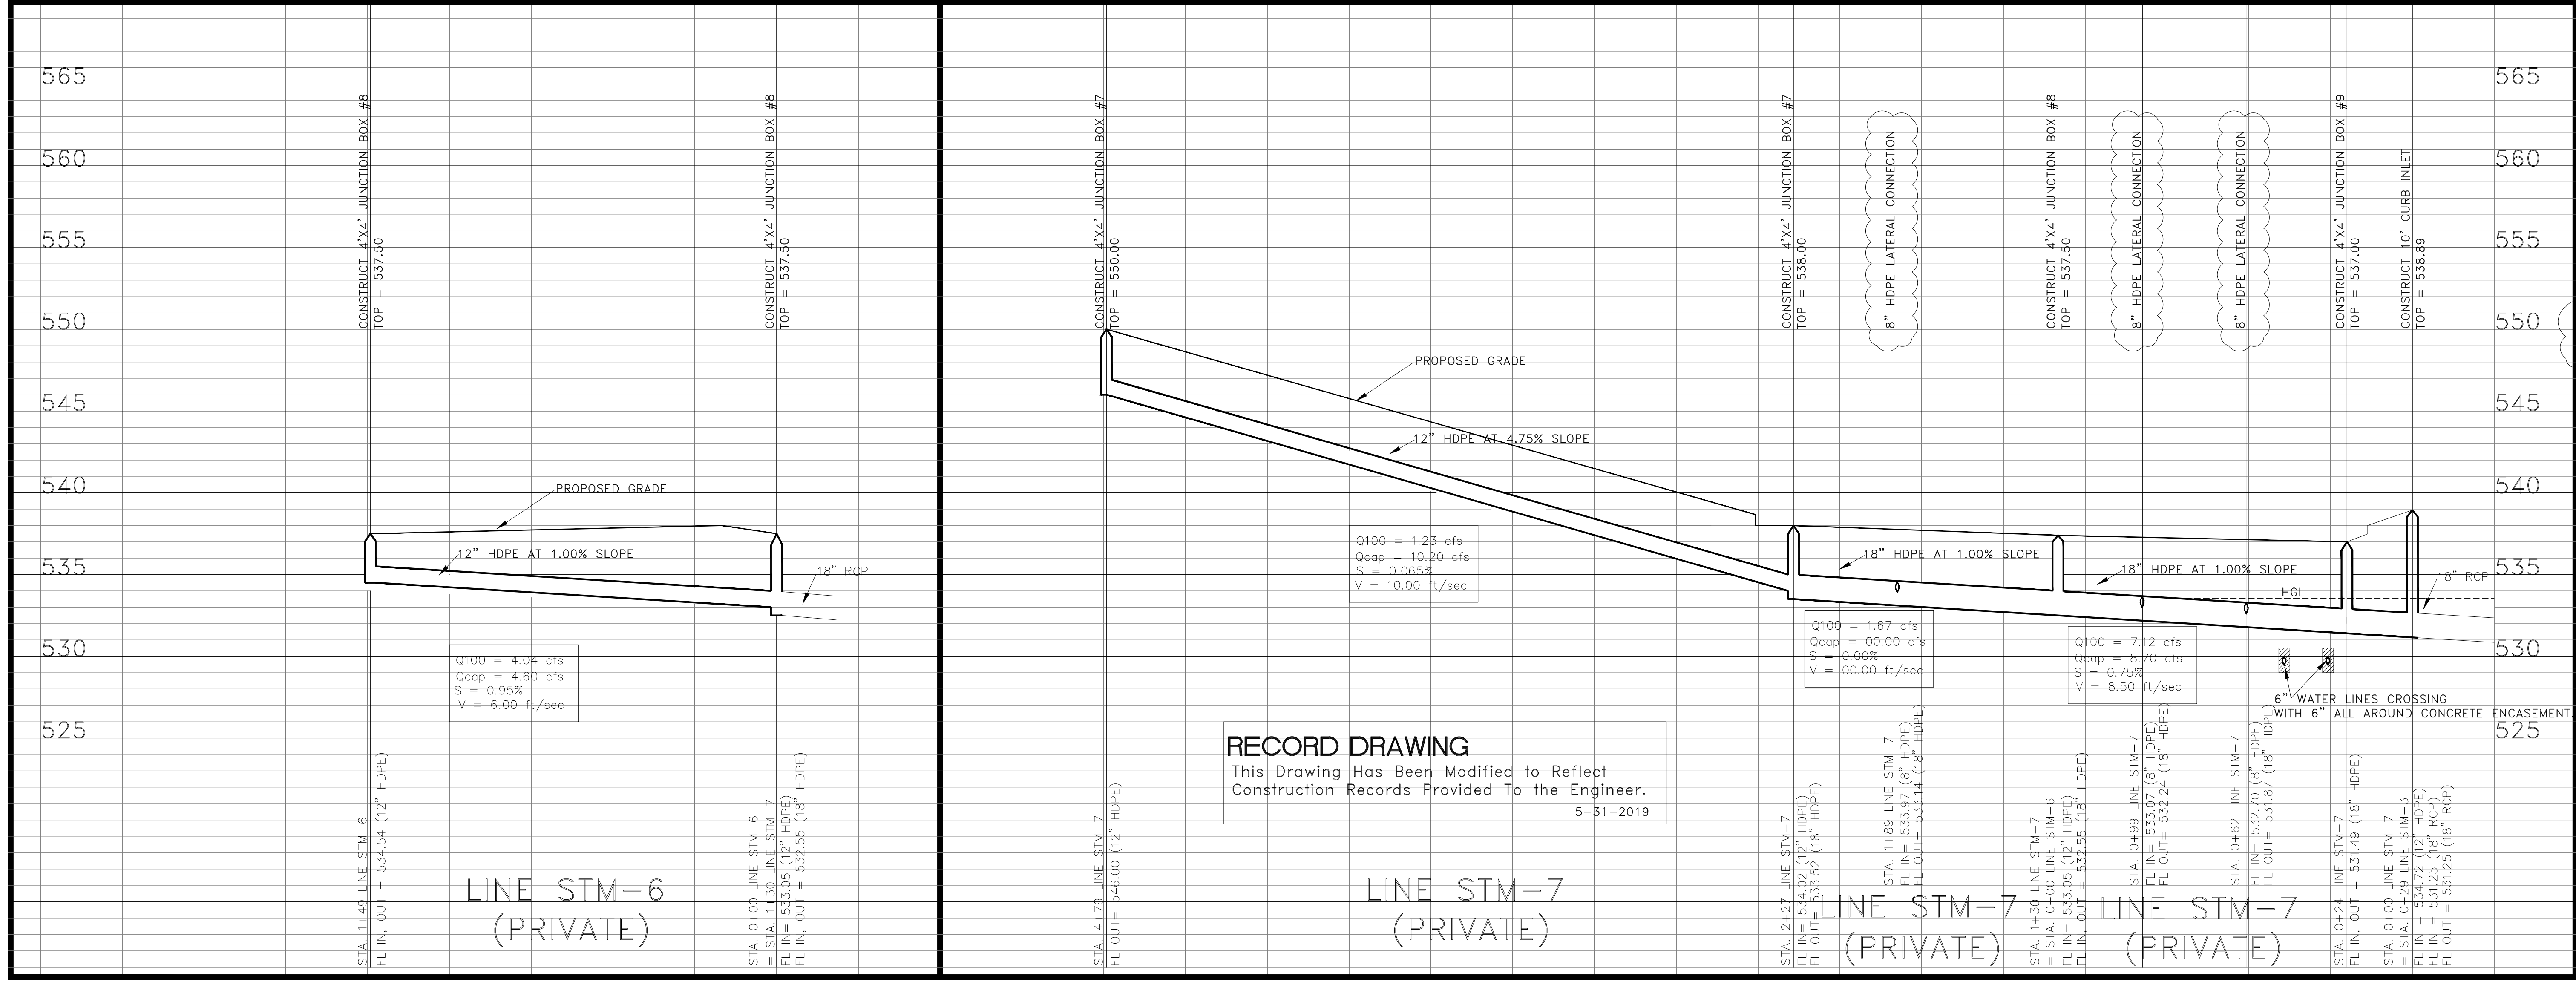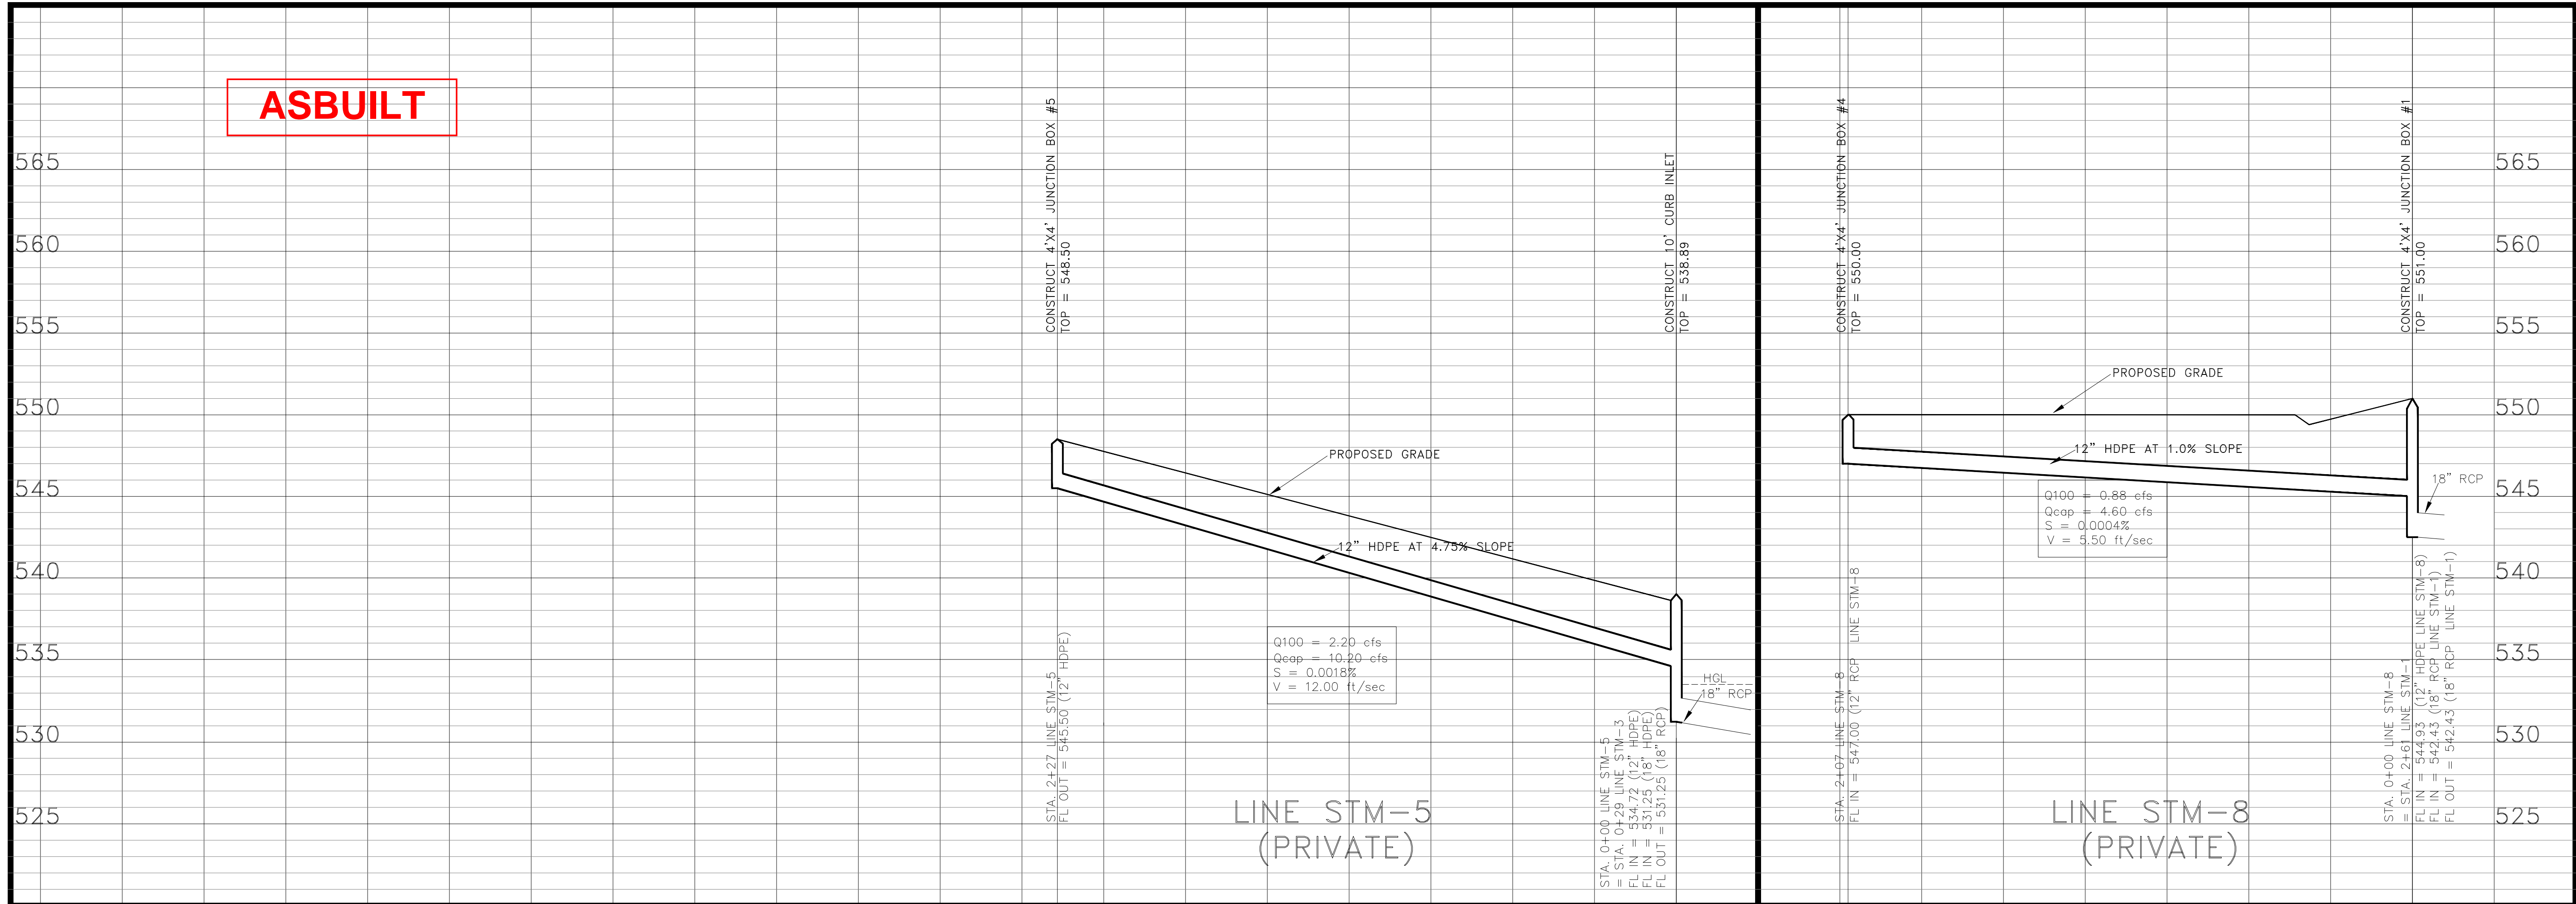


RECORD DRAWING
This Drawing Has Been Modified to Reflect
Construction Records Provided To the Engineer.
5-31-2019

MJR Engineering
New Construction • Engineering • Environmental Services
7953 PINKERTON COURT
PLANO, TEXAS 75025
PH: (469) 544-8150 FAX: (972) 767-3003
EMAIL: mkmalab7@gmail.com
FIRM # F - 9928

Rockwall Commons, Phase-2
1301 Ridge Road
Rockwall, Texas

JAHVANI CONSULTING ENGINEERS, INC.
TBPE REGISTRATION NO. F-10198
CONSULTING ENGINEERS
2121 N. JOSEY LANE, #100
CARROLLTON, TEXAS 75006
TEL. (214) 718-9469
jahvani@hotmail.com

REVISIONS	DATE
ADDED 3 - 6" HDPE PIPE LATERALS TO LINE STM-7	2-15-2015

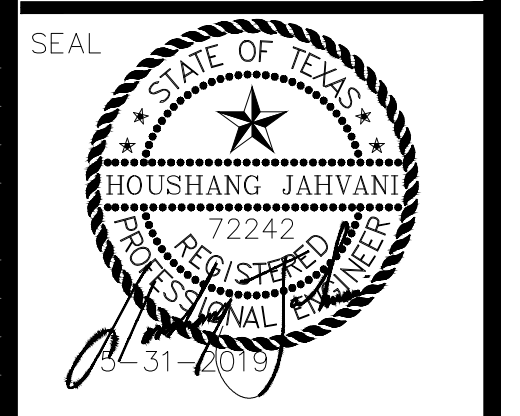

DWG. TITLE:
**STORM SEWER LINE
PROFILES (2 of 2).**

PROJECT #:
DRAWN BY: HJ
SCALE: 1" = 30'
FILE NO:



DATE 5-31-2019

11 OF 20
SHEET NUMBER

PRE-DEVELOPMENT 100 YEAR STORM WATER RUN-OFF TABLE

DRAINAGE AREA No.	AREA (Acre)	Tc (min.)	C	I _s (in/hr)	I ₁₀ (in/hr)	I ₂₅ (in/hr)	I ₁₀₀ (in/hr)	Q ₅ (cfs)	Q ₁₀ (cfs)	Q ₂₅ (cfs)	Q ₁₀₀ (cfs)
1	0.60	10	0.90	6.10	7.10	8.30	9.80	3.29	3.83	4.48	5.29
2	3.23	20	0.35	4.90	5.90	6.60	8.30	5.54	6.67	7.46	9.38

Total Q₁₀₀ = 14.67 cfs (Pre-Developed)
 Total Q₂₅ = 11.94 cfs (Pre-Developed)
 Total Q₁₀ = 10.50 cfs (Pre-Developed)
 Total Q₅ = 8.83 cfs (Pre-Developed)

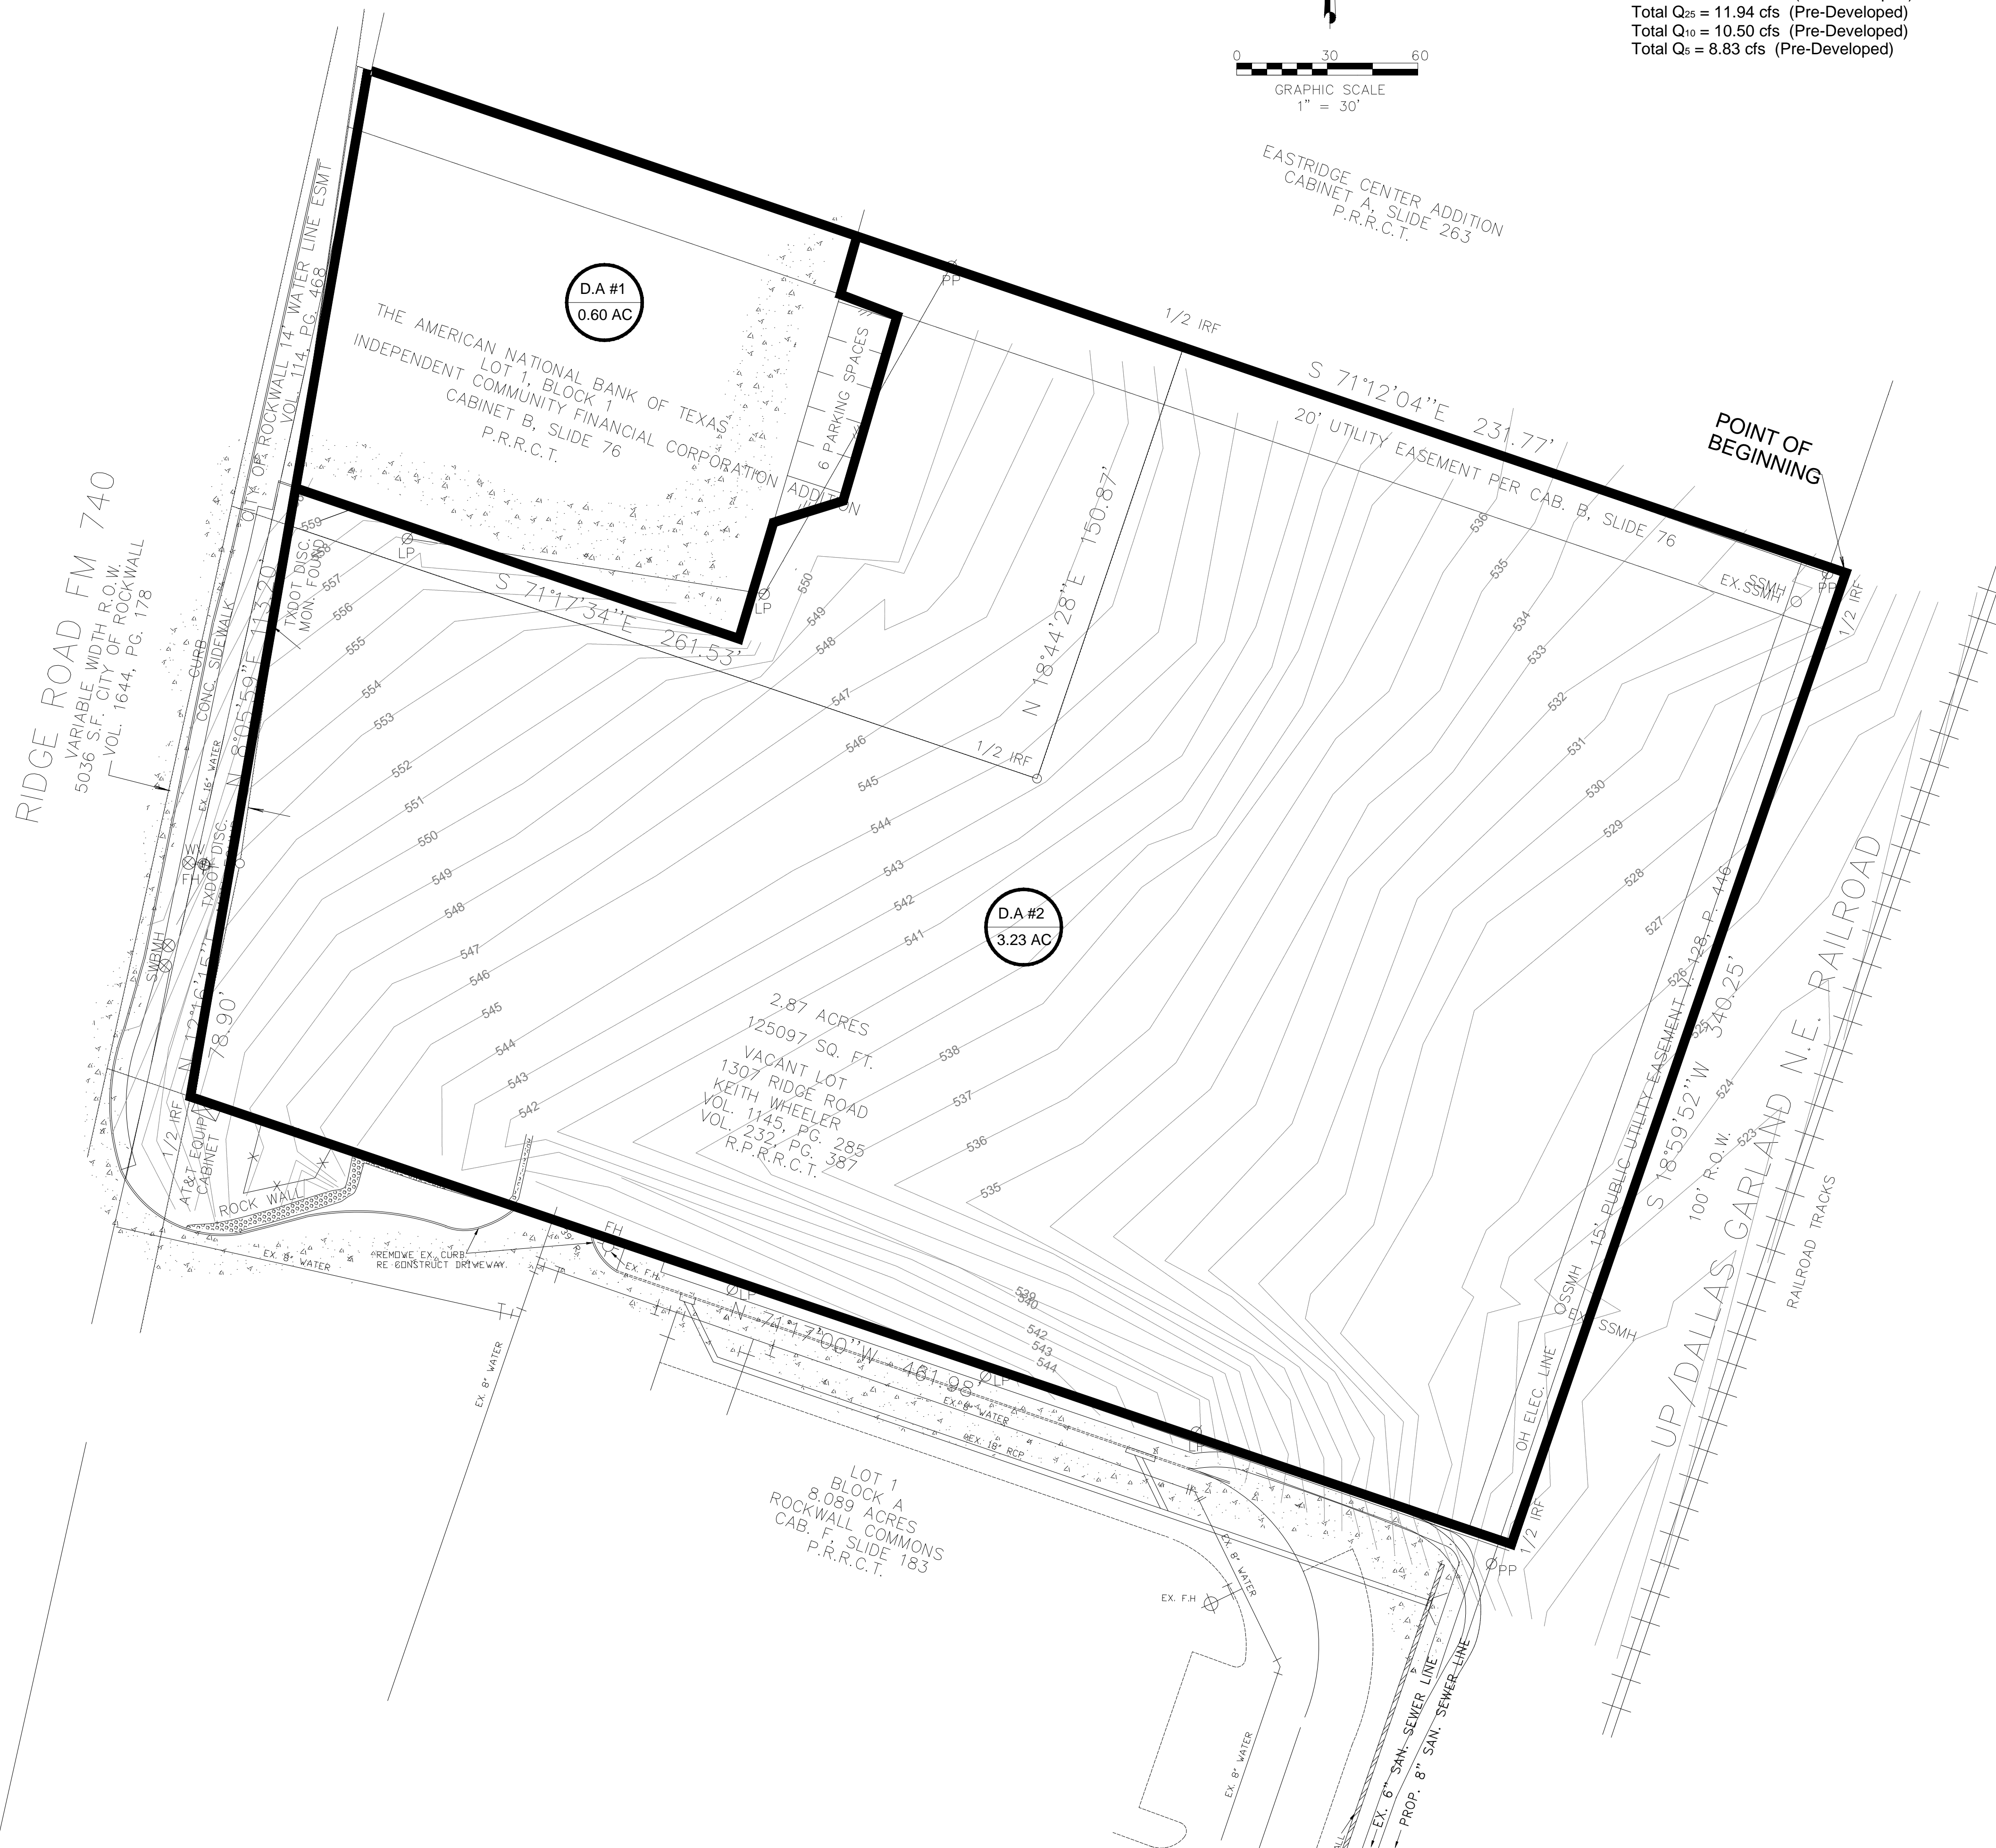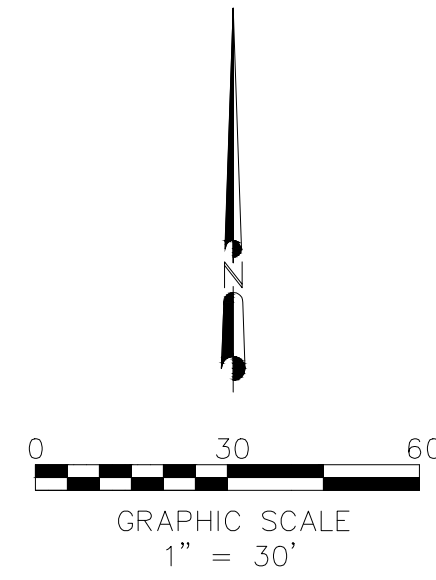

ASBUILT

RECORD DRAWING
 This Drawing Has Been Modified to Reflect
 Construction Records Provided To the Engineer.
 5-31-2019

MJR Engineering
 New Construction • Engineering • Environmental Services
 7953 PINKERTON COURT
 PLANO, TEXAS 75025
 PH: (469) 544-8150 FAX: (972) 767-3003
 EMAIL: mjkamal@mjra.com
 FIRM # - 9928

Rockwall Commons, Phase-2
 1301 Ridge Road
 Rockwall, Texas

JAHVANI CONSULTING ENGINEERS, INC.
 TBPE REGISTRATION NO. F-10198
 CONSULTING ENGINEERS
 2121 N. JOSEY LANE, #100
 CARROLLTON, TEXAS 75006
 TEL: (214) 718-9469
 jahvani@hotmail.com

REVISIONS	DATE



DWG. TITLE:
 PRE-DEVELOPMENT
 DRAINAGE AREA MAP
 PROJECT #:
 DRAWN BY: HJ
 SCALE: 1" = 30'
 FILE NO:
 DATE 5-31-2019

RIDGE ROAD FM 740

VARIABLE WIDTH R.O.W. VOL. 1644, PG. 178

AT&T EQUIPMENT CABINET

EX. 24' WIDE FIRE-LANE EASMT

EX. RETAIL 4-STORY 21,375 S.F. ROCKWALL COMMONS, PH -1

EX. APARTMENTS 4-STORY


LOT 1 BLOCK A 8.089 ACRES ROCKWALL COMMONS CAB. F. SLIDE 183 P.R.R.C.T.

NOTES:

- NO CONSTRUCTION WORK TO BE DONE INSIDE THE RAIL ROAD RIGHT OF WAY WITHOUT LETTER OF PERMISSION FROM RAIL ROAD AUTHORITIES.
- FIRE LANE TO BE 6' MIN, 3600 PSI, 6.5 SACK.

ON-SITE DRAINAGE AREA DATA

DRAINAGE AREA (D.A. #)	AREA (ACRE)	T _c (MIN)	"C"	I ₅ (IN/HR)	I ₁₀ (IN/HR)	I ₂₅ (IN/HR)	I ₁₀₀ (IN/HR)	Q ₅ (CFS)	Q ₁₀ (CFS)	Q ₂₅ (CFS)	Q ₁₀₀ (CFS)
D.A.#1	0.96	10	0.90	6.10	7.10	8.30	9.80	5.27	6.13	7.17	8.47
D.A.#2	0.57	10	0.90	6.10	7.10	8.30	9.80	3.13	3.64	4.25	5.00
D.A.#3	0.42	10	0.90	6.10	7.10	8.30	9.80	2.30	2.68	3.13	3.70
D.A.#4	0.20	10	0.90	6.10	7.10	8.30	9.80	1.10	1.28	1.49	1.76
D.A.#5	0.08	10	0.90	6.10	7.10	8.30	9.80	0.44	0.51	0.60	0.70
D.A.#6	0.05	10	0.90	6.10	7.10	8.30	9.80	0.27	0.32	0.37	0.44
D.A.#7	0.08	10	0.90	6.10	7.10	8.30	9.80	0.44	0.51	0.60	0.70
D.A.#8	0.05	10	0.90	6.10	7.10	8.30	9.80	0.27	0.32	0.37	0.44
D.A.#9	0.11	10	0.90	6.10	7.10	8.30	9.80	0.60	0.70	0.82	0.97
D.A.#10	0.11	10	0.90	6.10	7.10	8.30	9.80	0.60	0.70	0.82	0.97
D.A.#11	0.14	10	0.90	6.10	7.10	8.30	9.80	0.77	0.89	1.04	1.23
D.A.#12	0.10	10	0.90	6.10	7.10	8.30	9.80	0.55	0.64	0.75	0.88
D.A.#13	0.14	10	0.90	6.10	7.10	8.30	9.80	0.77	0.89	1.04	1.23
D.A.#14	0.10	10	0.90	6.10	7.10	8.30	9.80	0.55	0.64	0.75	0.88
D.A.#15	0.76	10	0.90	6.10	7.10	8.30	9.80	4.17	4.85	5.68	6.70

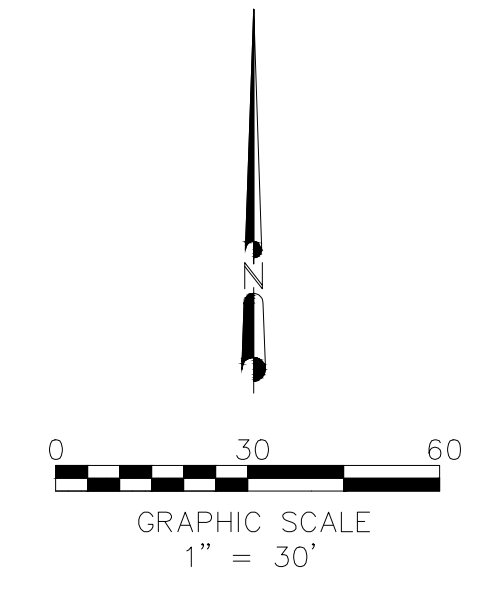


ON-SITE INLET DATA

DRAIN AREA SERVED (D.A. #)	INLET LOCATION	DESIGN FREQ. (YEARS)	TIME "T _c " (MIN)	INTEN. "I" (IN/HR)	DEV. RUNOFF COEFF. "C"	DRAIN AREA (ACRES)	DEV. "Q" (CFS)	BYPASS FROM INLET (CFS)	TOTAL "Q" (CFS)	LENGTH OF INLET (FEET)	OPENING OF INLET (FEET)	CAP. OF INLET (CFS)	BYPASS TO NEXT INLET (CFS)	BYPASS TO INLET NUMBER
1	LOW POINT	100	10	9.80	0.90	0.96	8.47	0	8.47	10	0.5	21	0	-
2	LOW POINT	100	10	9.80	0.90	0.57	5.00	0	5.00	10	0.5	21	0	-
3	LOW POINT	100	10	9.80	0.90	0.42	3.70	0	3.70	10	0.5	21	0	-

12" HDPE PIPE (ROOF DRAIN) DATA

PIPE #	DRAINAGE AREA # SERVED	DESIGN FREQ. (YEARS)	DEV. "Q" (CFS)	TOTAL "Q" (CFS)
STM-5	9,13	100	2.20	2.20
STM-6	4,5,6,7,8	100	3.60	4.04
STM-7	4,5,6,7,8,10,11,14	100	0.88	7.12
STM-8	12	100	1.23	0.88

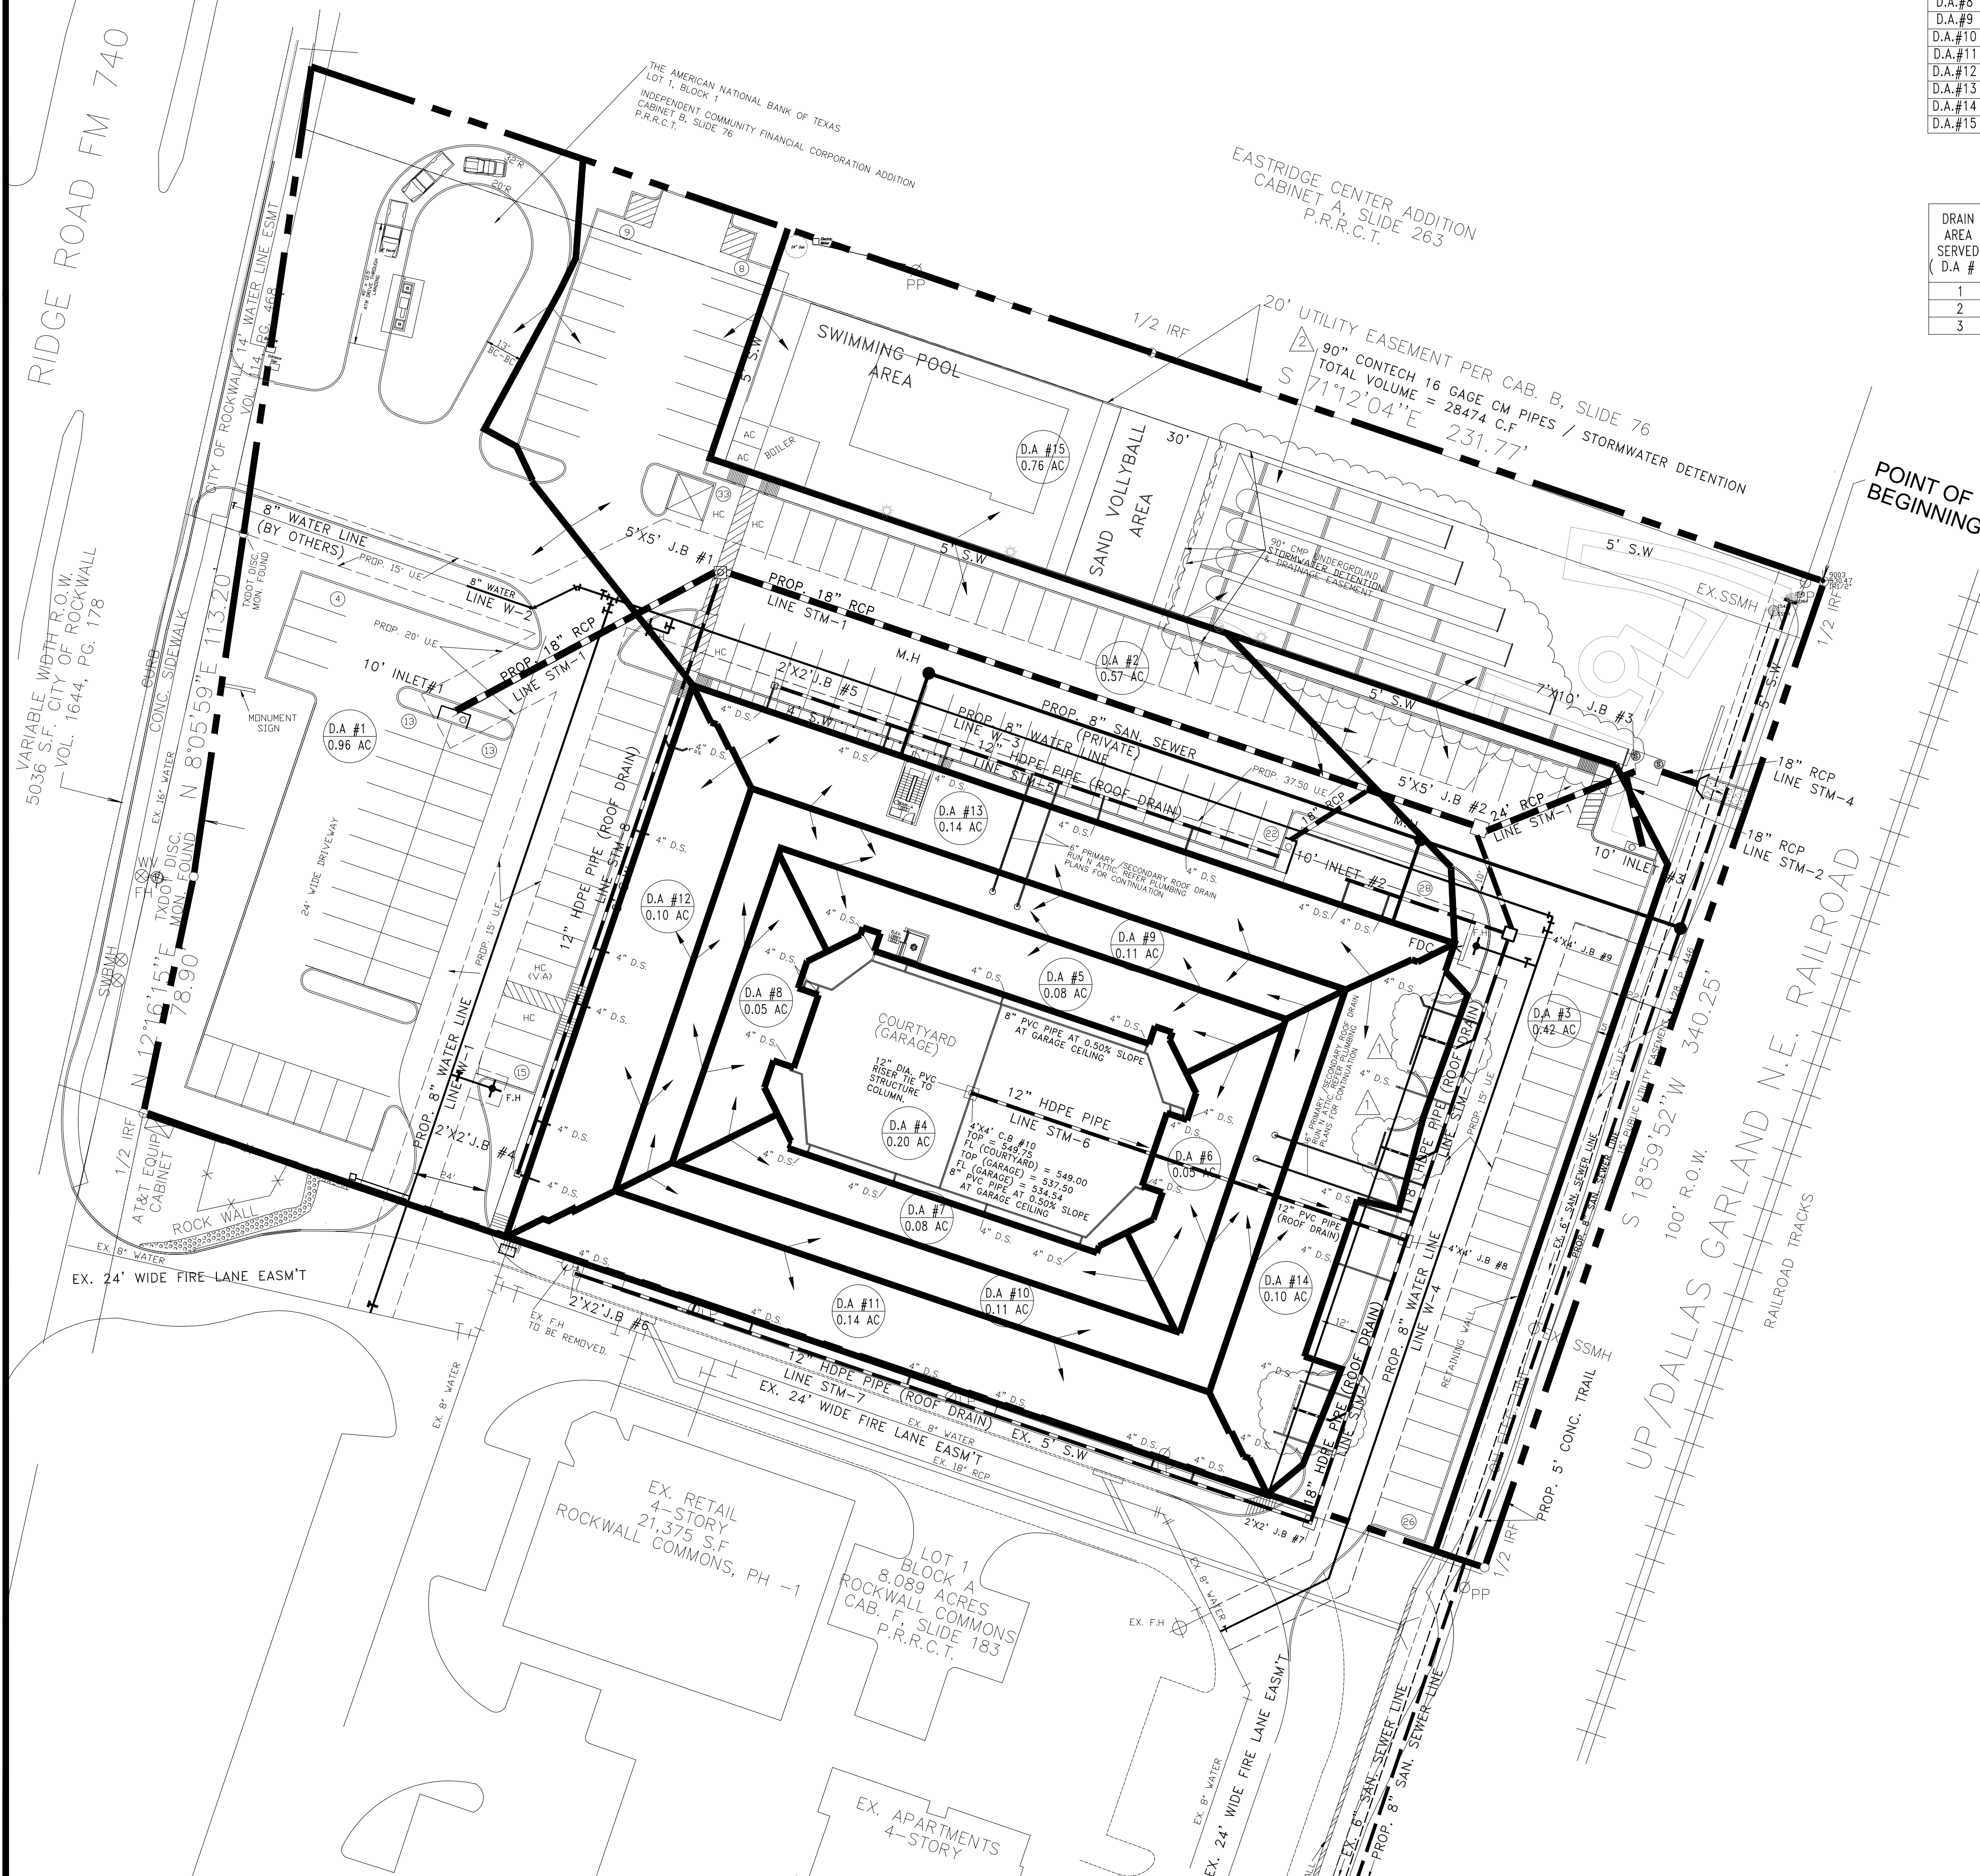

ASBUILT

RECORD DRAWING
This Drawing Has Been Modified to Reflect Construction Records Provided To the Engineer.
5-31-2019

ABBREVIATIONS:
C.B = CATCH BASIN
J.B = JUNCTION BOX
D.S = ROOF DRAIN DOWN SPOT
D.A = DRAINAGE AREA
AC= ACRE


MJR Engineering
New Construction • Engineering • Environmental Services
7953 PINKERTON COURT
PLANO, TEXAS 75025
PH: (469) 544-8150 FAX: (972) 767-3003
EMAIL: mjkamali@gmail.com
FIRM # F - 9928

Rockwall Commons, Phase-2
1301 Ridge Road
Rockwall, Texas

JAHVANI CONSULTING ENGINEERS, INC.
TBP# REGISTRATION NO. F-10198
CONSULTING ENGINEERS
2121 N. JOSEY LANE, #100
CARROLLTON, TEXAS 75006
TEL: (214) 718-9469
jahvani@hotmail.com

REVISIONS

NO.	DATE	DESCRIPTION
1	2-15-2015	ADDED 3 TRENCH GRATE AT GARAGE ENTRANCES.
2	2-15-2015	90" CM PIPE HAS BEEN INSTALLED INSTEAD OF 60" HDPE UNDERGROUND DETENTION PIPE.

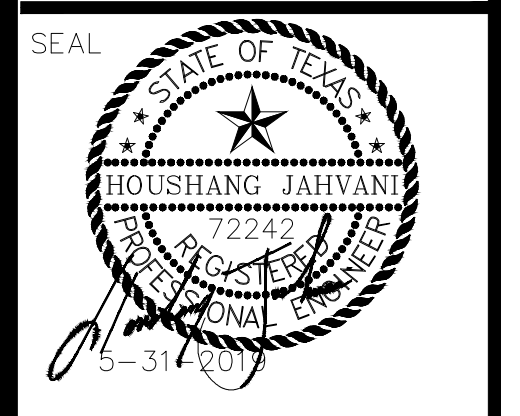

DWG. TITLE: DRAINAGE AREA MAP & COMPUTATIONS. (POST-DEVELOPMENT)

PROJECT #: DRAWN BY: HJ SCALE: 1" = 30' FILE NO:

DATE 5-31-2019

DETENTION BASIN CALCULATIONS.
TOTAL DETENTION REQUIRED-BASED ON 100 YEAR PEAK RUNOFF RATE
DETENTION CALCULATED USING MODIFIED RATIONAL METHOD.

PRE-DEVELOPED AND POST-DEVELOPED 5 YEAR STORM RUN-OFF

PRE-DEVELOPED CONDITION						
DRAINAGE AREA No.	AREA (Acres)	Tc (min.)	C	I _p (in/hr)	Q ₁₀ (cfs)	Q ₂₅ (cfs)
1	0.60	10	0.90	6.10	3.29	
2	3.23	20	0.35	4.90	5.54	

Total Q₁₀₀ = 8.83 cfs (Pre-Developed)

POST-DEVELOPED CONDITION						
DRAINAGE AREA No.	AREA (Acres)	Tc (min.)	C	I _p (in/hr)	Q ₁₀ (cfs)	Q ₂₅ (cfs)
16	0.76	10	0.90	6.10	4.85	

Total Q₁₀₀ Run-Off allowed from site = 8.83 cfs (Pre-Developed) - 4.85 (Post-Developed Bypass) = 3.98 cfs

POST-DEVELOPED CONDITION - ADJUSTED AREA

A1 = D.A #1 pre-developed = 0.60 Acres
A1 = D.A #2 pre-developed = 3.23 Acres
A3 = Bypass Area (D.A #16 post-developed) = 0.76 Acres
A (adjusted) = A1 + A2 - A3 = 0.60 + 3.23 - 0.76 = 3.07 Acres

POST-DEVELOPMENT 5 YEAR STORM - VARIOUS DURATION (COMMERCIAL CONDITION)

5-YEAR STORM

DURATION (MIN.)	YEAR (YR)	INTENSITY (IN./HR.)	C	A (Acres)	Q = C.I.A (cfs)
10	5	6.10	0.90	3.07	16.8543
15	5	5.50	0.90	3.07	15.1965
20	5	4.90	0.90	3.07	13.5387
30	5	4.10	0.90	3.07	11.3263
40	5	3.40	0.90	3.07	9.3942
50	5	2.80	0.90	3.07	7.7364
60	5	2.60	0.90	3.07	7.1838
70	5	2.40	0.90	3.07	6.6312
80	5	2.30	0.90	3.07	6.3549
90	5	2.10	0.90	3.07	5.8023
100	5	1.90	0.90	3.07	5.2497
110	5	1.80	0.90	3.07	4.9734

Maximum Detention Storage is determined by deducting the volume of run-off released during the time of inflow from the total inflow for each storm duration:

10 minute storm	15 minute storm	20 minute storm	30 minute storm	40 minute storm	50 minute storm	60 minute storm	70 minute storm	80 minute storm	90 minute storm	100 minute storm	110 minute storm
Inflow = (10 min)(16.8543 cfs)(60 sec/min) = 10,112.58 C.F. Outflow = (0.50)(20 min)(3.98 cfs)(60sec/min) = 2,388.00 C.F. Storage = Inflow - Outflow = 10,112.58 - 2,388.00 = 7,724.58 Cubic Feet	Inflow = 13,676.85 C.F. Outflow = 2,985.00 C.F. Storage = 10,691.85 Cubic Feet	Inflow = 16,246.44 C.F. Outflow = 3,582.00 C.F. Storage = 12,664.44 Cubic Feet	Inflow = 20,390.94 C.F. Outflow = 4,776.00 C.F. Storage = 15,614.94 Cubic Feet	Inflow = 22,546.08 C.F. Outflow = 5,970.00 C.F. Storage = 16,576.08 Cubic Feet	Inflow = 23,209.20 C.F. Outflow = 7,164.00 C.F. Storage = 16,045.20 Cubic Feet	Inflow = 25,861.68 C.F. Outflow = 8,358.00 C.F. Storage = 17,503.68 Cubic Feet	Inflow = 27,851.04 C.F. Outflow = 9,552.00 C.F. Storage = 18,299.04 Cubic Feet	Inflow = 30,503.52 C.F. Outflow = 10,746.00 C.F. Storage = 19,757.52 Cubic Feet	Inflow = 31,332.42 C.F. Outflow = 11,940.00 C.F. Storage = 19,392.42 Cubic Feet	Inflow = 31,498.20 C.F. Outflow = 13,134.00 C.F. Storage = 18,364.20 Cubic Feet	Inflow = 32,824.44 C.F. Outflow = 14,328.00 C.F. Storage = 18,496.44 Cubic Feet

Required detention storage is 18,496.44 cubic feet at the 100 minute storm duration.

Stormwater Detention Provided = 1448 feet of 60" diameter HDPE pipe = 28,431.41 cubic feet

PRE-DEVELOPMENT DISCHARGE = 8.83 CFS
POST-DEVELOPMENT DISCHARGE FROM DRAINAGE AREA #15 (NOT DETAINED) = 4.17 CFS
TOTAL DISCHARGE ALLOWED FROM STORMWATER DETENTION SYSTEM = 8.83 - 4.17 = 4.66 CFS

V - NOTCH WEIR

$$Q = 2.5 \tan(\theta/2) H^{2.5} = (2.5 \times \tan 3.10)(2.77)^{2.5} = 1.73 \text{ CFS}$$

$\theta = 6.20^\circ, H = 2.77'$
TOTAL WEIR DISCHARGE AT 2.77' DEPTH WATER = 1.73 CFS
TOTAL WEIR DISCHARGE AT 2.77' DEPTH ALLOWED = 4.66 CFS
18" RCP AT 2.0% SLOPE, Q(CAPACITY) = 15.00 CFS

DETENTION BASIN CALCULATIONS.
TOTAL DETENTION REQUIRED-BASED ON 100 YEAR PEAK RUNOFF RATE
DETENTION CALCULATED USING MODIFIED RATIONAL METHOD.

PRE-DEVELOPED AND POST-DEVELOPED 10 YEAR STORM RUN-OFF

PRE-DEVELOPED CONDITION						
DRAINAGE AREA No.	AREA (Acres)	Tc (min.)	C	I _p (in/hr)	Q ₁₀ (cfs)	Q ₂₅ (cfs)
1	0.60	10	0.90	7.10	3.83	
2	3.23	20	0.35	5.90	6.67	

Total Q₁₀₀ = 10.50 cfs (Pre-Developed)

POST-DEVELOPED CONDITION						
DRAINAGE AREA No.	AREA (Acres)	Tc (min.)	C	I _p (in/hr)	Q ₁₀ (cfs)	Q ₂₅ (cfs)
16	0.76	10	0.90	7.10	4.85	

Total Q₁₀₀ Run-Off allowed from site = 10.50 cfs (Pre-Developed) - 4.85 (Post-Developed Bypass) = 5.65 cfs

POST-DEVELOPED CONDITION - ADJUSTED AREA

A1 = D.A #1 pre-developed = 0.60 Acres
A1 = D.A #2 pre-developed = 3.23 Acres
A3 = Bypass Area (D.A #16 post-developed) = 0.76 Acres
A (adjusted) = A1 + A2 - A3 = 0.60 + 3.23 - 0.76 = 3.07 Acres

POST-DEVELOPMENT 25 YEAR STORM - VARIOUS DURATION (COMMERCIAL CONDITION)

10-YEAR STORM

DURATION (MIN.)	YEAR (YR)	INTENSITY (IN./HR.)	C	A (Acres)	Q = C.I.A (cfs)
10	25	7.10	0.90	3.07	19.6173
15	25	6.50	0.90	3.07	17.9595
20	25	5.90	0.90	3.07	16.3017
30	25	4.80	0.90	3.07	13.2624
40	25	4.00	0.90	3.07	11.0520
50	25	3.50	0.90	3.07	9.6705
60	25	3.00	0.90	3.07	8.2890
70	25	2.80	0.90	3.07	7.7364
80	25	2.60	0.90	3.07	7.1838
90	25	2.50	0.90	3.07	6.9075
100	25	2.40	0.90	3.07	6.6312
110	25	2.30	0.90	3.07	6.3549

Maximum Detention Storage is determined by deducting the volume of run-off released during the time of inflow from the total inflow for each storm duration:

10 minute storm	15 minute storm	20 minute storm	30 minute storm	40 minute storm	50 minute storm	60 minute storm	70 minute storm	80 minute storm	90 minute storm	100 minute storm	110 minute storm
Inflow = (10 min)(19.6173 cfs)(60 sec/min) = 11,770.38 C.F. Outflow = (0.50)(20 min)(5.65 cfs)(60sec/min) = 3,390.00 C.F. Storage = Inflow - Outflow = 13,759.74 - 3,390.00 = 8,380.38 Cubic Feet	Inflow = 16,163.55 C.F. Outflow = 4,237.50 C.F. Storage = 11,926.05 Cubic Feet	Inflow = 19,562.04 C.F. Outflow = 5,085.00 C.F. Storage = 14,477.04 Cubic Feet	Inflow = 26,524.80 C.F. Outflow = 8,475.00 C.F. Storage = 18,049.80 Cubic Feet	Inflow = 28,872.32 C.F. Outflow = 9,780.00 C.F. Storage = 19,092.32 Cubic Feet	Inflow = 29,011.50 C.F. Outflow = 10,170.00 C.F. Storage = 18,841.50 Cubic Feet	Inflow = 29,840.40 C.F. Outflow = 11,865.00 C.F. Storage = 17,975.40 Cubic Feet	Inflow = 34,482.24 C.F. Outflow = 15,255.00 C.F. Storage = 19,227.24 Cubic Feet	Inflow = 32,492.88 C.F. Outflow = 13,560.00 C.F. Storage = 18,932.88 Cubic Feet	Inflow = 34,482.24 C.F. Outflow = 15,255.00 C.F. Storage = 19,227.24 Cubic Feet	Inflow = 37,300.50 C.F. Outflow = 16,950.00 C.F. Storage = 20,350.50 Cubic Feet	Inflow = 39,787.20 C.F. Outflow = 18,645.00 C.F. Storage = 21,142.20 Cubic Feet

Required detention storage is 21,602.34 cubic feet at the 100 minute storm duration.

Stormwater Detention Provided = 1448 feet of 60" diameter HDPE pipe = 28,431.41 cubic feet

PRE-DEVELOPMENT DISCHARGE = 10.50 CFS
POST-DEVELOPMENT DISCHARGE FROM DRAINAGE AREA #15 (NOT DETAINED) = 4.85 CFS
TOTAL DISCHARGE ALLOWED FROM STORMWATER DETENTION SYSTEM = 10.50 - 4.85 = 5.65 CFS

V - NOTCH WEIR

$$Q = 2.5 \tan(\theta/2) H^{2.5} = (2.5 \times \tan 3.10)(3.15)^{2.5} = 2.38 \text{ CFS}$$

$\theta = 6.20^\circ, H = 3.15'$
TOTAL WEIR DISCHARGE AT 3.15' DEPTH WATER = 2.38 CFS
TOTAL WEIR DISCHARGE AT 3.15' DEPTH ALLOWED = 5.65 CFS
18" RCP AT 2.0% SLOPE, Q(CAPACITY) = 15.00 CFS

DETENTION BASIN CALCULATIONS.
TOTAL DETENTION REQUIRED-BASED ON 100 YEAR PEAK RUNOFF RATE
DETENTION CALCULATED USING MODIFIED RATIONAL METHOD.

PRE-DEVELOPED AND POST-DEVELOPED 25 YEAR STORM RUN-OFF

PRE-DEVELOPED CONDITION						
DRAINAGE AREA No.	AREA (Acres)	Tc (min.)	C	I _p (in/hr)	Q ₁₀ (cfs)	Q ₂₅ (cfs)
1	0.60	10	0.90	8.3	4.48	
2	3.23	20	0.35	6.6	7.46	

Total Q₂₅ = 11.94 cfs (Pre-Developed)

POST-DEVELOPED CONDITION						
DRAINAGE AREA No.	AREA (Acres)	Tc (min.)	C	I _p (in/hr)	Q ₁₀ (cfs)	Q ₂₅ (cfs)
16	0.76	10	0.90	8.3	5.68	

Total Q₂₅ Run-Off allowed from site = 11.94 cfs (Pre-Developed) - 5.68 (Post-Developed Bypass) = 6.26 cfs

POST-DEVELOPED CONDITION - ADJUSTED AREA

A1 = D.A #1 pre-developed = 0.60 Acres
A1 = D.A #2 pre-developed = 3.23 Acres
A3 = Bypass Area (D.A #16 post-developed) = 0.76 Acres
A (adjusted) = A1 + A2 - A3 = 0.60 + 3.23 - 0.76 = 3.07 Acres

POST-DEVELOPMENT 25 YEAR STORM - VARIOUS DURATION (COMMERCIAL CONDITION)

25-YEAR STORM

DURATION (MIN.)	YEAR (YR)	INTENSITY (IN./HR.)	C	A (Acres)	Q = C.I.A (cfs)
10	25	8.30	0.90	3.07	22.9329
15	25	7.50	0.90	3.07	20.7225
20	25	6.60	0.90	3.07	18.2358
30	25	5.60	0.90	3.07	15.1965
40	25	4.60	0.90	3.07	12.7098
50	25	4.00	0.90	3.07	11.0520
60	25	3.50	0.90	3.07	9.6705
70	25	3.30	0.90	3.07	9.1179
80	25	3.10	0.90	3.07	8.5653
90	25	2.90	0.90	3.07	8.0127
100	25	2.70	0.90	3.07	7.4601
110	25	2.50	0.90	3.07	6.9075

Maximum Detention Storage is determined by deducting the volume of run-off released during the time of inflow from the total inflow for each storm duration:

10 minute storm	15 minute storm	20 minute storm	30 minute storm	40 minute storm	50 minute storm	60 minute storm	70 minute storm	80 minute storm	90 minute storm	100 minute storm	110 minute storm
Inflow = (10 min)(22.9329 cfs)(60 sec/min) = 13,759.74 C.F. Outflow = (0.50)(20 min)(6.26 cfs)(60sec/min) = 3,756.00 C.F. Storage = Inflow - Outflow = 13,759.74 - 3,756.00 = 10,003.74 Cubic Feet	Inflow = 18,650.25 C.F. Outflow = 4,695.00 C.F. Storage = 13,955.25 Cubic Feet	Inflow = 21,882.96 C.F. Outflow = 5,634.00 C.F. Storage = 16,248.96 Cubic Feet	Inflow = 27,353.70 C.F. Outflow = 7,512.00 C.F. Storage = 19,841.70 Cubic Feet	Inflow = 30,503.52 C.F. Outflow = 9,390.00 C.F. Storage = 21,113.52 Cubic Feet	Inflow = 33,156.00 C.F. Outflow = 11,268.00 C.F. Storage = 21,888.00 Cubic Feet	Inflow = 34,813.80 C.F. Outflow = 13,146.00 C.F. Storage = 21,667.80 Cubic Feet	Inflow = 38,295.18 C.F. Outflow = 15,024.00 C.F. Storage = 23,271.18 Cubic Feet	Inflow = 41,113.44 C.F. Outflow = 16,902.00 C.F. Storage = 24,211.44 Cubic Feet	Inflow = 43,268.58 C.F. Outflow = 18,780.00 C.F. Storage = 24,488.58 Cubic Feet	Inflow = 44,760.60 C.F. Outflow = 20,658.00 C.F. Storage = 24,102.60 Cubic Feet	Inflow = 45,589.50 C.F. Outflow = 22,536.00 C.F. Storage = 23,053.50 Cubic Feet

Required detention storage is 24,488.58 cubic feet at the 110 minute storm duration.

Stormwater Detention Provided = 1448 feet of 60" diameter HDPE pipe = 28,431.41 cubic feet

PRE-DEVELOPMENT DISCHARGE = 11.94 CFS
POST-DEVELOPMENT DISCHARGE FROM DRAINAGE AREA #15 (NOT DETAINED) = 5.68 CFS
TOTAL DISCHARGE ALLOWED FROM STORMWATER DETENTION SYSTEM = 11.94 - 5.68 = 6.26 CFS

V - NOTCH WEIR

$$Q = 2.5 \tan(\theta/2) H^{2.5} = (2.5 \times \tan 3.10)(3.59)^{2.5} = 3.30 \text{ CFS}$$

$\theta = 6.20^\circ, H = 3.59'$
TOTAL WEIR DISCHARGE AT 3.59' DEPTH WATER = 3.30 CFS
TOTAL WEIR DISCHARGE AT 3.15' DEPTH ALLOWED = 6.26 CFS
18" RCP AT 2.0% SLOPE, Q(CAPACITY) = 15.00 CFS

DETENTION BASIN CALCULATIONS.
TOTAL DETENTION REQUIRED-BASED ON 100 YEAR PEAK RUNOFF RATE
DETENTION CALCULATED USING MODIFIED RATIONAL METHOD.

PRE-DEVELOPED AND POST-DEVELOPED 100 YEAR STORM RUN-OFF

PRE-DEVELOPED CONDITION						
DRAINAGE AREA No.	AREA (Acres)	Tc (min.)	C	I ₁₀₀ (in/hr)	Q ₁₀₀ (cfs)	Q ₂₅ (cfs)
1	0.60	10	0.90	9.80	5.2920	
2	3.23	20	0.35	8.30	9.3832	

Total Q₁₀₀ = 14.6752 cfs (Pre-Developed)

POST-DEVELOPED CONDITION - BYPASS AREA						
DRAINAGE AREA No.	AREA (Acres)	Tc (min.)	C	I ₁₀₀ (in/hr)	Q ₁₀₀ (cfs)	Q ₂₅ (cfs)
16	0.76	10	0.90	9.80	6.7032	

Total Q₁₀₀ Run-Off allowed from site = 14.6752 cfs (Pre-Developed) - 6.7032 (Post-Developed Bypass) = 7.9720 cfs

POST-DEVELOPED CONDITION - ADJUSTED AREA

A1 = D.A #1 pre-developed = 0.60 Acres
A1 = D.A #2 pre-developed = 3.23 Acres
A3 = Bypass Area (D.A #16 post-developed) = 0.76 Acres
A (adjusted) = A1 + A2 - A3 = 0.60 + 3.23 - 0.76 = 3.07 Acres

POST-DEVELOPMENT 100 YEAR STORM - VARIOUS DURATION (COMMERCIAL CONDITION)

100-YEAR STORM

DURATION (MIN.)	YEAR (YR)	INTENSITY (IN./HR.)	C	A (Acres)	Q = C.I.A (cfs)
10	100	9.80	0.90	3.07	27.0774
15	100	9.00	0.90	3.07	24.8670
20	100	8.30	0.90	3.07	22.9329
30	100	6.80	0.90	3.07	19.0647
40	100	5.80	0.90	3.07	16.0254
50	100	5.00	0.90	3.07	13.8150
60	100	4.50	0.90	3.07	12.4335
70	100	4.00	0.90	3.07	11.0520
80	100	3.70	0.90	3.07	10.2231
90	100	3.50	0.90	3.07	9.6705
100	100	3.40	0.90	3.07	9.3942
110	100	3.20	0.90	3.07	8.8416

Maximum Detention Storage is determined by deducting the volume of run-off released during the time of inflow from the total inflow for each storm duration:


10 minute storm	15 minute storm
-----------------	-----------------

NOTES:

1. NO CONSTRUCTION WORK TO BE DONE INSIDE THE RAIL ROAD RIGHT OF WAY WITHOUT LETTER OF PERMISSION FROM RAIL ROAD AUTHORITIES.
2. FIRE LANE TO BE 6' MIN, 3600 PSI, 6.5 SACK.


EROSION CONTROL PLAN
STANDARD GENERAL NOTES

1. EROSION CONTROL DEVICES AS SHOWN ON THE EROSION CONTROL PLAN FOR THE PROJECT SHALL BE INSTALLED PRIOR TO THE START OF LAND DISTURBING ACTIVITIES ON THE PROJECT.
2. ALL EROSION CONTROL DEVICES ARE TO BE INSTALLED IN ACCORDANCE WITH APPROVED PLANS AND SPECIFICATIONS FOR THE PROJECT. CHANGES ARE TO BE APPROVED BEFORE CONSTRUCTION BY THE DESIGN ENGINEER AND THE CITY OF ROCKWALL ENGINEERING DIVISION.
3. IF THE EROSION CONTROL PLAN AS APPROVED CANNOT CONTROL EROSION AND OFF-SITE SEDIMENTATION FROM THE PROJECT, THE EROSION CONTROL PLAN WILL BE REQUIRED TO BE REVISED AND/OR ADDITIONAL EROSION CONTROL DEVICES WILL BE REQUIRED ON-SITE.
4. IF OFF-SITE SOIL BORROW OR SPOIL SITES ARE USED IN CONJUNCTION WITH THIS PROJECT, THIS INFORMATION SHALL BE DISCLOSED AND SHOWN ON THE EROSION CONTROL PLAN. OFF-SITE BORROW AND SPOIL AREAS ARE CONSIDERED A PART OF THE PROJECT SITE AND THEREFORE SHALL COMPLY WITH THE CITY OF ROCKWALL EROSION CONTROL PLAN REQUIREMENTS. THESE AREAS SHALL BE STABILIZED WITH PERMANENT GROUND COVER PRIOR TO FINAL APPROVAL OF THE PROJECT.
5. 75-80% OF ALL DISTURBED AREA TO HAVE A MINIMUM OF 1 INCH TALL GRASS ESTABLISHED PRIOR TO ENGINEERING ACCEPTANCE IF SITE.

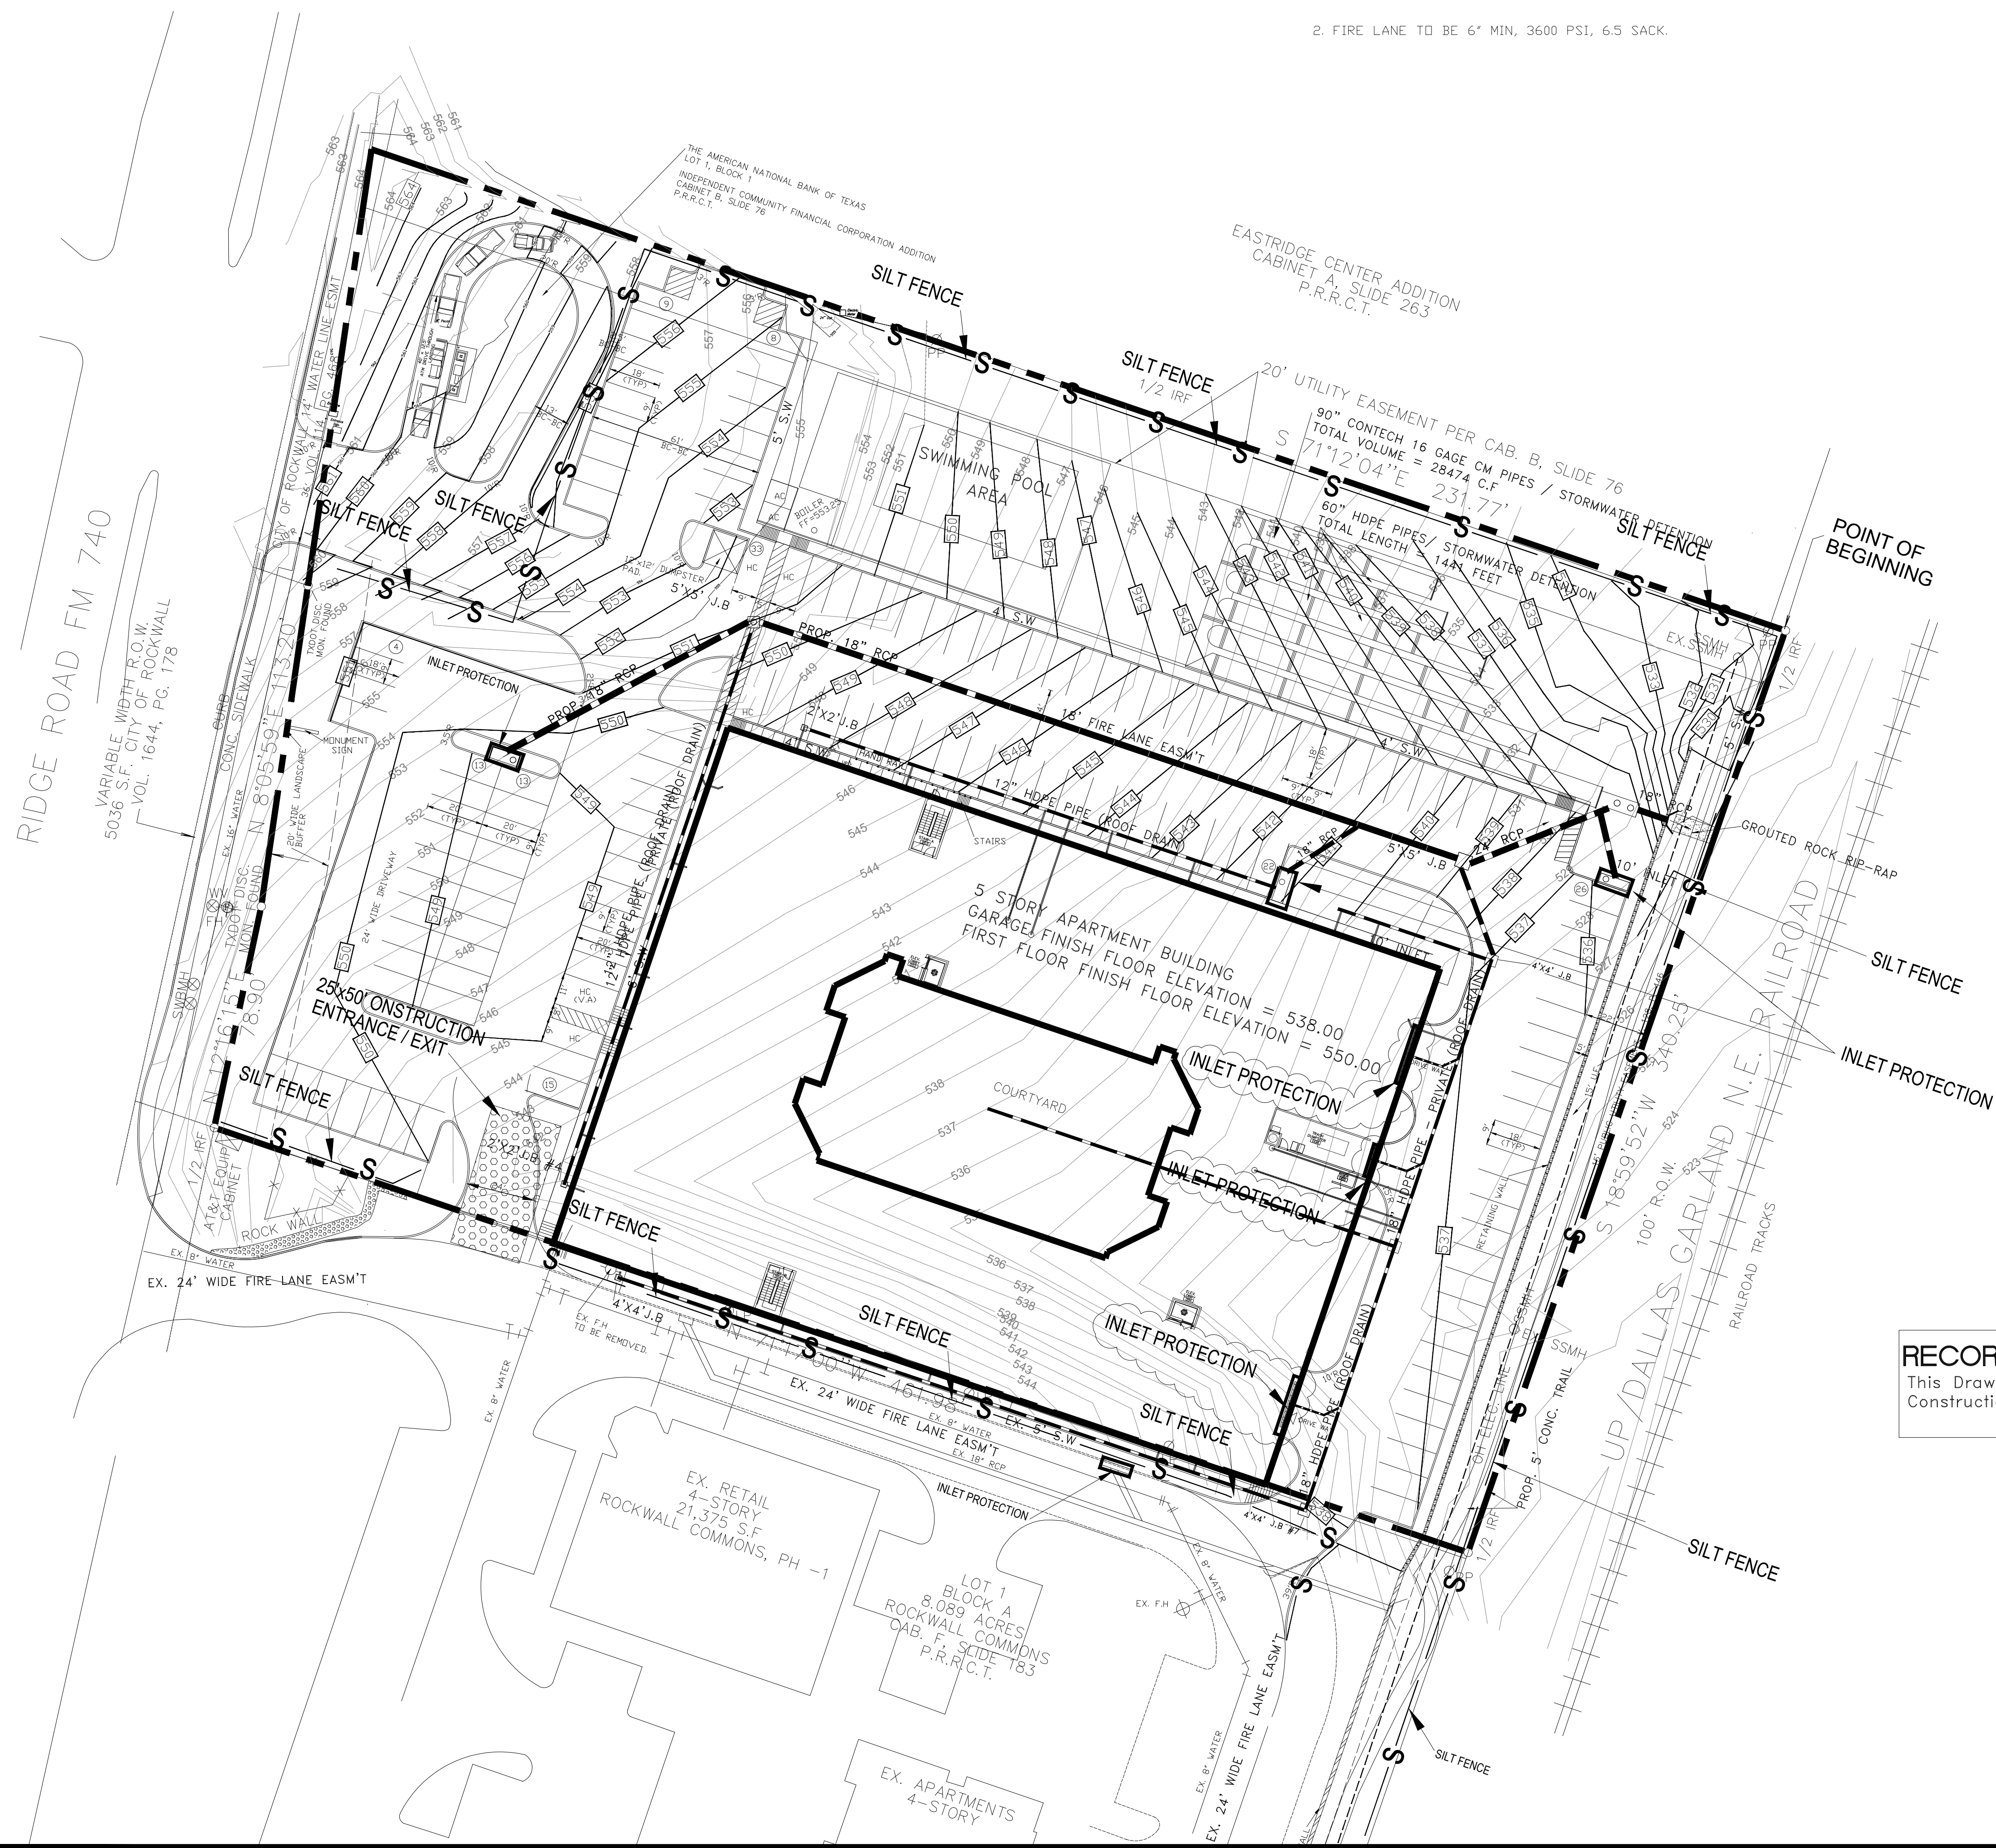

ASBUILT

RECORD DRAWING
This Drawing Has Been Modified to Reflect Construction Records Provided To the Engineer.
5-31-2019

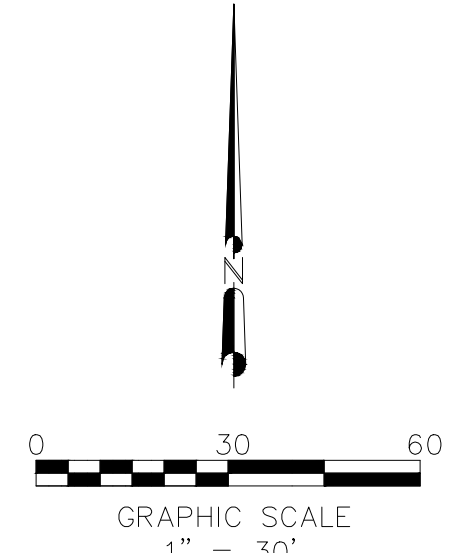


- LEGENDS:
- = CONSTRUCTION ENTRANCE
 - = SILT FENCE
 - = INLET PROTECTION

MJR Engineering
New Construction • Engineering • Environmental Services
7953 PINKERTON COURT
PLANO, TEXAS 75025
PH: (469) 544-8150 FAX: (972) 767-3003
EMAIL: mkmalab7@gmail.com
FIRM # - 9928

Rockwall Commons, Phase-2
1301 Ridge Road
Rockwall, Texas

JAHVANI CONSULTING ENGINEERS, INC.
TBPE REGISTRATION NO. F-10198
CONSULTING ENGINEERS
2121 N. JOSEY LANE, #100
CARROLLTON, TEXAS 75006
TEL: (214) 718-9469
jahvani@hotmail.com

REVISIONS	DATE
ADDED 3 MORE INLET PROTECTIONS.	2-15-2015

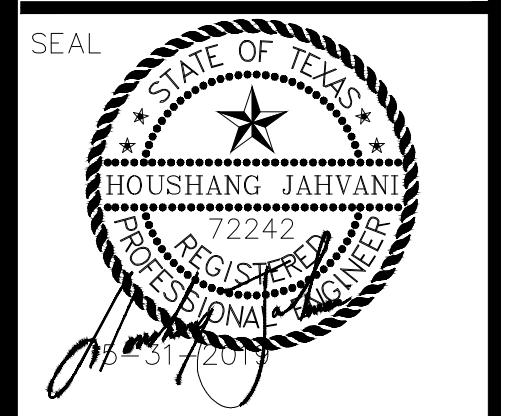

DWG. TITLE:
EROSION CONTROL PLAN

PROJECT #:
DRAWN BY: HJ
SCALE: 1" = 30'
FILE NO:

DATE 5-31-2019

15 OF 20
SHEET NUMBER

Solid Waste Management

DESCRIPTION
Large volumes of solid waste are often generated at construction sites including: packaging, pallets, wood waste, concrete waste, soil, electrical wiring, cuttings, and a variety of other materials. The solid waste management practice lists techniques to minimize the potential of storm water contamination from solid waste through appropriate storage and disposal practices.

PRIMARY USE
These practices should be a part of all construction practices. By limiting the trash and debris on site, storm water quality is improved along with reduced clean up requirements at the completion of the project.

APPLICATIONS
The solid waste management practice for construction sites is based on proper storage and disposal practices by construction workers and supervisors. Key elements of the program are education and modification of improper disposal habits. Cooperation and vigilance is required on the part of supervisors and workers to ensure that the recommendations and procedures are followed. Following are lists describing the targeted materials and recommended procedures:

- Targeted Solid Waste Materials
 - Paper and cardboard containers
 - Plastic packaging
 - Styrofoam packing and forms
 - Insulation materials (non-hazardous)
 - Wood pallets
 - Wood cuttings
 - Pipe and electrical cuttings
 - concrete, brick, and mortar waste
 - Shingle cuttings and waste
 - Roofing
 - Steel (cuttings, nails, rust residue)
 - Gypsum board cuttings and waste
 - Sheathing cuttings and waste
 - Miscellaneous cuttings and waste
 - Food waste
 - Demolition waste

- Storage Procedures**
- Wherever possible, minimize production of solid waste materials.
 - Designate a foreman or supervisor to oversee and enforce proper solid waste procedures.
 - Instruct construction workers in proper solid waste procedures.
 - Segregate potentially hazardous waste from non-hazardous construction site debris.
 - Keep solid waste materials under cover in either a closed dumpster or other enclosed trash container that limits contact with rain and runoff.
 - Store waste materials away from drainage ditches, swales and catch basins.
 - Do not allow trash containers to overflow.
 - Do not allow waste materials to accumulate on the ground.
 - Prohibit littering by workers and visitors.
 - Police area daily for litter and debris.
 - Enforce solid waste handling and storage procedures.

- Disposal Procedures**
- If feasible, segregate recyclable wastes from non-recyclable waste materials and dispose of properly.
 - General construction debris may be hauled to a licensed construction debris landfill (typically less expensive than a sanitary landfill).
 - Use waste facilities approved by local jurisdiction.
 - Runoff which comes into contact with unprotected waste shall be directed into structural dirt treatment such as silt fence to remove debris.

- Education**
- Educate all workers on solid waste storage and disposal procedures.
 - Instruct workers in identification of solid waste and hazardous waste.
 - Have regular meetings to discuss and reinforce disposal procedures (incorporate in regular safety seminars).
 - Clearly mark on all solid waste containers which materials are acceptable.

- Quality Control**
- Foreman and/or construction supervisor shall monitor on-site solid waste storage and disposal procedures.
 - Discipline workers who repeatedly violate procedures.

- Requirements**
- Job-site waste handling and disposal education and awareness program.
 - Commitment by management to implement and enforce Solid Waste Management Program.
 - Compliance by workers.
 - Sufficient and appropriate waste storage containers.
 - Timely removal of stored solid waste materials.
 - Possible modest cost impact for additional waste storage containers.
 - Minimal overall cost impact.

LIMITATIONS
Only addresses non-hazardous solid waste.
One part of a comprehensive construction site management program.

Applications

- Perimeter Control
- Slope Protection
- Sediment Trapping
- Channel Protection
- Temporary Stabilization
- Permanent Stabilization
- Waste Management
- Housekeeping Practices

Targeted Constituents

- Sediment
- Nutrients
- Toxic Materials
- Oil & Grease
- Floatable Materials
- Other Construction Wastes


Implementation Requirements

- Capital Costs
- Maintenance
- Training
- Suitability for Slopes > 5%

Legend

- Significant Impact
- Medium Impact
- Low Impact
- Unknown or Questionable Impact

W-1

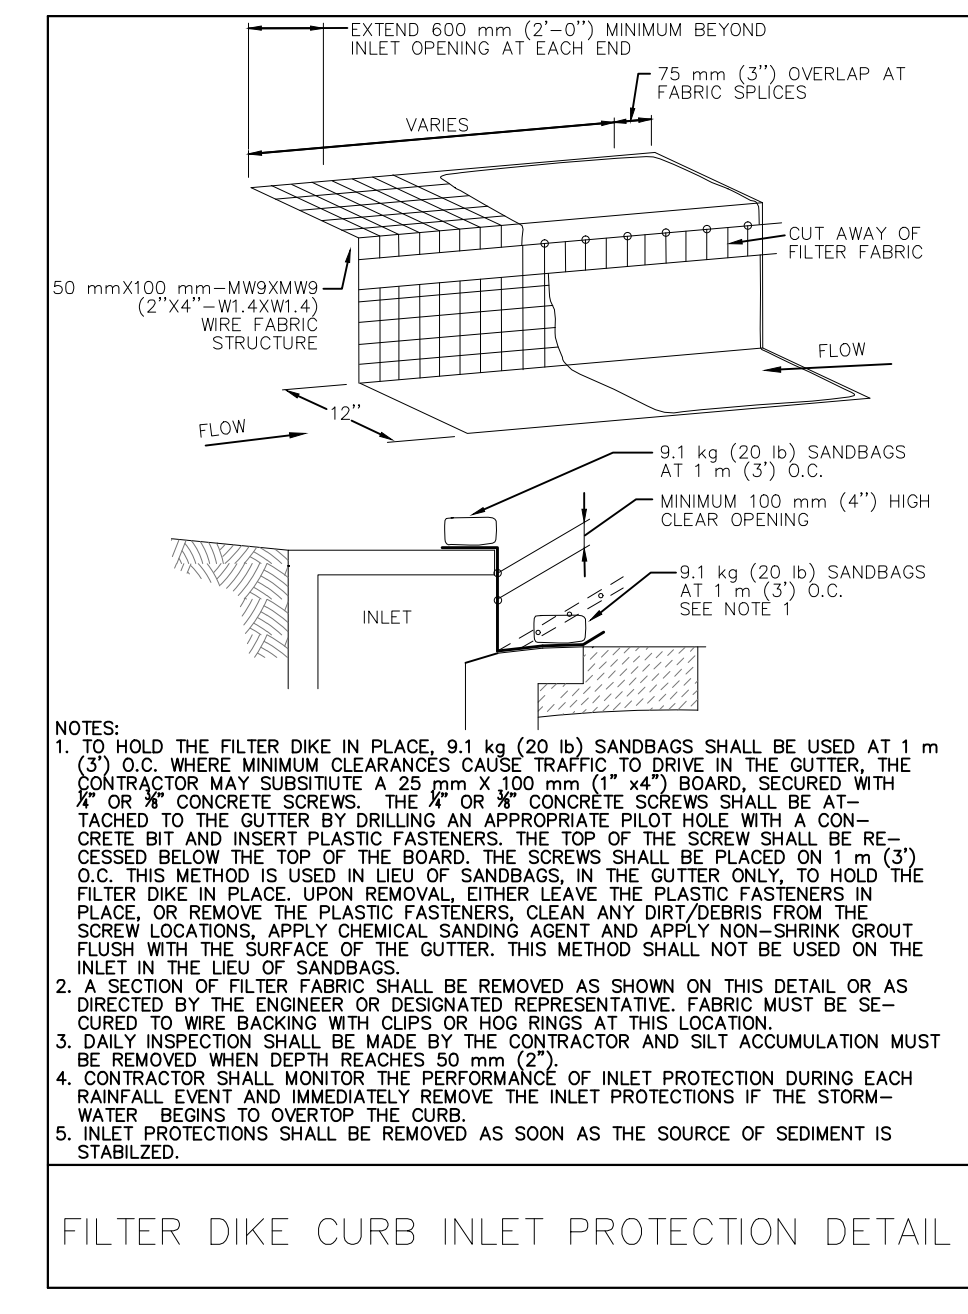

Hazardous Waste Management

DESCRIPTION
The hazardous waste management BMP addresses the problem of storm water polluted with hazardous waste through spills or other forms of contact. The objective of the Management Program is to minimize the potential of stormwater contamination from common construction site hazardous wastes through appropriate recognition, handling, storage and disposal practices.

It is not the intent of this Management Program to supersede or replace normal site assessment and remediation procedures. Significant spills and/or contamination warrant immediate response by trained professionals. Suspected job-site contaminants should be immediately reported to regulatory authorities and protective actions taken. The General Permit requires reporting of significant spills to the National Response Center (NRC) at (800) 424-8802.

PRIMARY USE
These management practices along with applicable OSHA and EPA guidelines should be incorporated at all construction sites which use or generate hazardous wastes. Many wastes such as fuel, oil, grease, fertilizer and pesticide are present at most construction sites.

INSTALLATION, APPLICATION AND DISPOSAL CRITERIA
The hazardous waste management techniques presented here are based on proper recognition, handling, and disposal practices by construction workers and supervisors. Key elements of the management program are education, proper disposal practices, as well as provisions for safe storage and disposal. Following are lists describing the targeted materials and recommended procedures:

- Targeted Solid Waste Materials
 - Paints
 - Solvents
 - Stains
 - Wood preservatives
 - Cutting oils
 - Greases
 - Roofing tar
 - Pesticides
 - Fuels and lube oils
 - Lead based paints (Demolition)

Storage Procedures

- Wherever possible, minimize use of hazardous materials.
- Minimize generation of hazardous wastes on the job-site.
- Segregate potentially hazardous waste from non-hazardous construction site debris.
- Designate a foreman or supervisor to oversee hazardous materials handling procedures.
- Keep liquid or semi-liquid hazardous waste in appropriate containers (closed drums or similar) and under cover.
- Store waste materials away from drainage ditches, swales and catch basins.
- Use containment berms in fueling and maintenance areas and where the potential for spills is high.
- Ensure that adequate hazardous waste storage volume is available.
- Ensure that adequate hazardous waste collection containers are conveniently located.
- Do not allow potentially hazardous waste materials to accumulate on the ground.
- Enforce hazardous waste handling and disposal procedures.
- Clearly mark on all hazardous waste containers which materials are acceptable for the container.

Disposal Procedures

- Regulatory schedule hazardous removal to minimize on-site storage.
- Use only reputable, licensed hazardous waste haulers.

Education

- Instruct workers in identification of hazardous waste.
- Educate workers of potential dangers to humans and the environment from hazardous wastes.
- Instruct workers on safety procedures for common construction site hazardous wastes.
- Educate all workers on hazardous waste storage and disposal procedures.
- Have regular meetings to discuss and reinforce identification, handling and disposal procedures (incorporate in regular safety seminars).
- Establish a continuing education program to indoctrinate new employees.

Quality Assurance

- Foreman and/or construction supervisor shall monitor on-site hazardous waste storage and disposal procedures.
- Educate and if necessary, discipline workers who violate procedures.
- Ensure that the hazardous waste disposal contractor is reputable and licensed.

Requirements

- Job-site hazardous waste handling and disposal education and awareness program.
- Commitment by management to implement hazardous waste management practices.
- Compliance by workers.
- Sufficient and appropriate hazardous waste storage containers.
- Timely removal of stored hazardous waste materials.

Costs

- Possible modest cost impact for additional hazardous storage containers.
- Commitment by management to implement hazardous waste management practices.
- Small cost impact for training and monitoring.
- Potential cost impact for hazardous waste collection and disposal by licensed hauler - actual cost depends on type of material and volume.

LIMITATIONS

This practice is not intended to address site-assessments and pre-existing contamination. Major contamination, large spills and other serious hazardous waste incidents require immediate response from specialists. Demolition activities and potential pre-existing materials, such as asbestos, are not addressed by this program. Site specific information on plans is necessary. Contaminated soils are not addressed. One part of a comprehensive construction site waste management program.

Applications

- Perimeter Control
- Slope Protection
- Sediment Trapping
- Channel Protection
- Temporary Stabilization
- Permanent Stabilization
- Waste Management
- Housekeeping Practices

Targeted Constituents

- Sediment
- Nutrients
- Toxic Materials
- Oil & Grease
- Floatable Materials
- Other Construction Wastes

Implementation Requirements

- Capital Costs
- Maintenance
- Training
- Suitability for Slopes > 5%

Legend

- Significant Impact
- Medium Impact
- Low Impact
- Unknown or Questionable Impact

W-2

Concrete Waste Management

DESCRIPTION
Concrete waste at construction sites comes in two forms; 1) excess fresh concrete mix including truck and equipment washing, and 2) concrete dust and concrete debris resulting from demolition. Both forms have the potential to impact water quality through storm water runoff contact with the waste.

PRIMARY USE
Concrete waste is present at most construction sites. This BMP should be utilized at sites in which concrete waste is present.

APPLICATIONS
A number of water quality parameters can be affected by introduction of concrete - especially fresh concrete. Concrete affects the pH of runoff, causing significant chemical changes in water bodies and harming aquatic life. Suspended solids in the form of both cement and aggregate dust are also generated from both fresh and demolished concrete waste.

Current Unacceptable Waste Concrete Disposal Practices

- Dumping in vacant areas on the job-site.
- Illicit dumping off-site.
- Dumping into ditches or drainage facilities.

Recommended Disposal Practices

- Avoid unacceptable disposal practices listed above.
- Develop pre-determined, safe concrete disposal areas.
- Provide a washout area with a minimum of 6 cubic feet of containment area volume for every 10 cubic yards of concrete poured.
- Never dump waste concrete illicitly or without property owners knowledge and consent.
- Treat runoff from storage areas through the use of structural controls as required.

Education

- Drivers and equipment operators should be instructed on proper disposal and equipment washing practices (see above).
- Supervisors must be made aware of the potential environmental consequences of improperly handled concrete waste.

Enforcement

- The construction site manager or foreman must ensure that employees and pre-mix companies follow proper procedures for concrete disposal and equipment washing.
- Employees violating disposal or equipment cleaning directives must be re-educated or disciplined if necessary.

Demolition Practices

- Monitor weather and wind direction to ensure concrete dust is not entering drainage structures and surface waters. Where appropriate, construct sediment traps or other types of sediment detention devices downstream of demolition activities.

Requirements

- Use pre-determined disposal sites for waste concrete.
- Prohibit dumping waste concrete anywhere but pre-determined areas.
- Assign pre-determined truck and equipment washing areas.
- Educate drivers and operators on proper disposal and equipment cleaning procedures.

Education

- Minimal cost impact for training and monitoring.
- Concrete disposal cost depends on availability and distance to suitable disposal areas.
- Additional costs involved in equipment washing could be significant.

LIMITATIONS

This concrete waste management program is one part of a comprehensive construction site waste management program.

Applications

- Perimeter Control
- Slope Protection
- Sediment Trapping
- Channel Protection
- Temporary Stabilization
- Permanent Stabilization
- Waste Management
- Housekeeping Practices

Targeted Constituents

- Sediment
- Nutrients
- Toxic Materials
- Oil & Grease
- Floatable Materials
- Other Construction Wastes

Implementation Requirements

- Capital Costs
- Maintenance
- Training
- Suitability for Slopes > 5%

Legend


- Significant Impact
- Medium Impact
- Low Impact
- Unknown or Questionable Impact

W-3

ASBUILT

FIGURE 4.3.B
EROSION CONTROL PLAN
STANDARD GENERAL NOTES

- EROSION CONTROL DEVICES AS SHOWN ON THE EROSION CONTROL PLAN FOR THE PROJECT SHALL BE INSTALLED PRIOR TO THE START OF LAND DISTURBING ACTIVITIES ON THE PROJECT.
- ALL EROSION CONTROL DEVICES ARE TO BE INSTALLED IN ACCORDANCE WITH APPROVED PLANS AND SPECIFICATIONS FOR THE PROJECT. CHANGES ARE TO BE APPROVED BEFORE CONSTRUCTION BY THE DESIGN ENGINEER AND THE CITY OF ROCKWALL ENGINEERING DIVISION.
- IF THE EROSION CONTROL PLAN AS APPROVED CANNOT CONTROL EROSION AND OFF-SITE SEDIMENTATION FROM THE PROJECT, THE EROSION CONTROL PLAN WILL BE REQUIRED TO BE REVISED AND/OR ADDITIONAL EROSION CONTROL DEVICES WILL BE REQUIRED ON-SITE.
- IF OFF-SITE SOIL BORROW OR SPOIL SITES ARE USED IN CONJUNCTION WITH THIS PROJECT, THIS INFORMATION SHALL BE DISCLOSED AND SHOWN ON THE EROSION CONTROL PLAN. OFF-SITE BORROW AND SPOIL AREAS ARE CONSIDERED A PART OF THE PROJECT SITE AND THEREFORE SHALL COMPLY WITH THE CITY OF ROCKWALL EROSION CONTROL PLAN REQUIREMENTS. THESE AREAS SHALL BE STABILIZED WITH PERMANENT GROUND COVER PRIOR TO FINAL APPROVAL OF THE PROJECT.

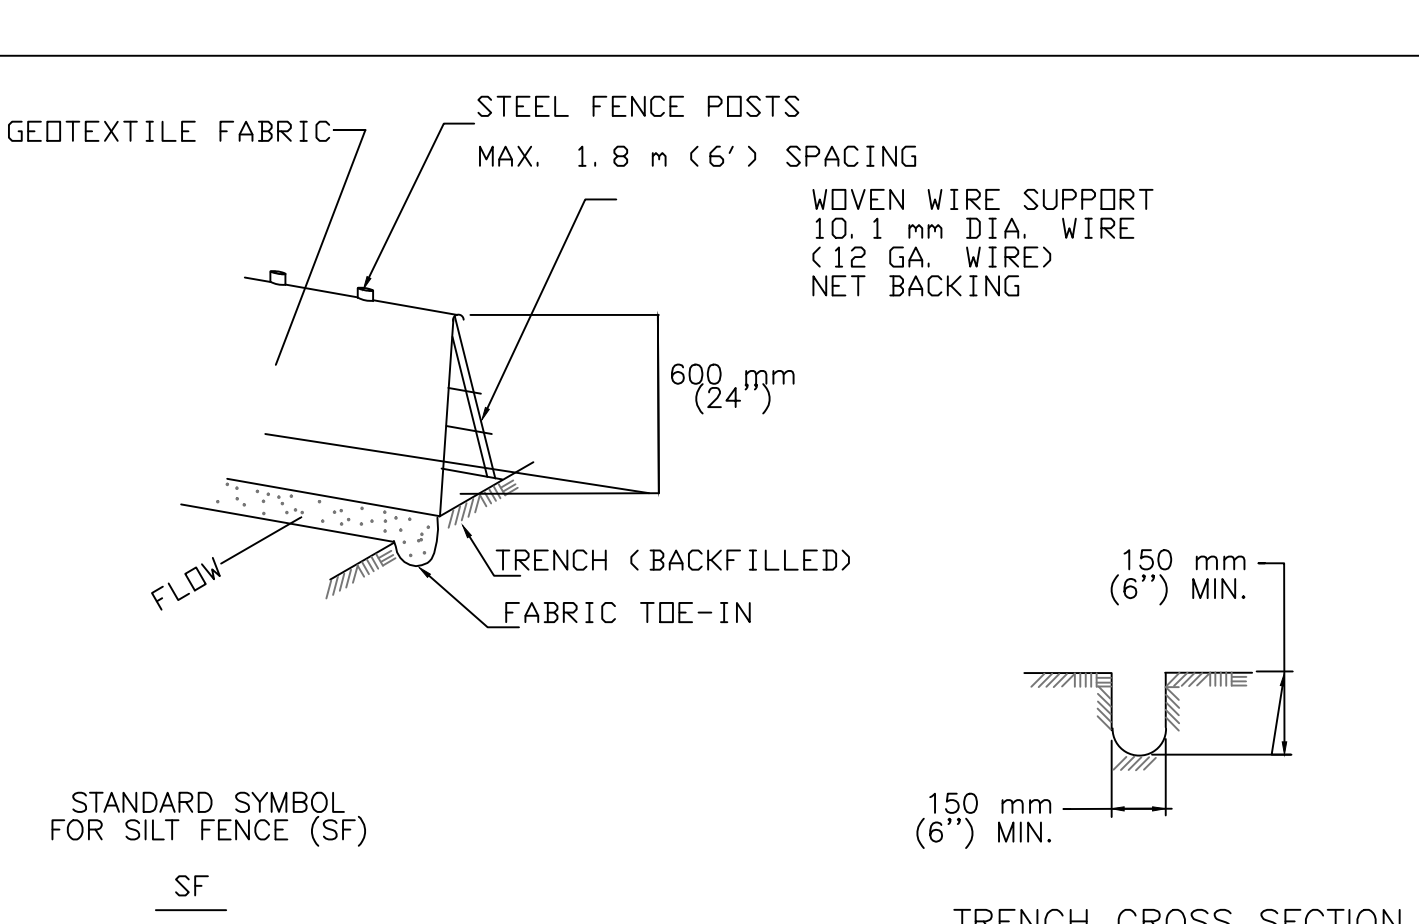

NOTES:

- STEEL POSTS WHICH SUPPORT THE SILT FENCE SHALL BE INSTALLED ON A SLIGHT ANGLE TOWARD THE ANTICIPATED RUNOFF SOURCE. POST MUST BE EMBEDDED A MINIMUM OF 12 INCHES.
- THE TOE OF THE SILT FENCE SHALL BE TRENCHED IN WITH A SPADE OR MECHANICAL TRENCHER, SO THAT THE DOWNSLOPE FACE OF THE TRENCH IS FLAT AND PERPENDICULAR TO THE LINE OF FLOW. WHERE FENCE CAN NOT BE TRENCHED INTO THE SURFACE (E.G. PAVEMENT) THE FABRIC FLAP SHALL BE WEIGHTED DOWN WITH WASHED GRAVEL ON UPHILL SIDE TO PREVENT FLOW UNDER FENCE.
- THE TRENCH MUST BE A MINIMUM OF 150 mm (6 inches) DEEP AND 150 mm (6 inches) WIDE TO ALLOW FOR THE SILT FENCE FABRIC TO BE LAID IN THE GROUND AND BACKFILLED WITH COMPACTED MATERIAL.
- SILT FENCE SHOULD BE SECURELY FASTENED TO EACH STEEL SUPPORT POST OR TO WOVEN WIRE, WHICH IS IN TURN ATTACHED TO THE STEEL FENCE POST.
- INSPECTION SHALL BE MADE WEEKLY OR AFTER EACH RAINFALL EVENT AND REPAIR OR REPLACEMENT SHALL BE MADE PROMPTLY AS NEEDED.
- SILT FENCE SHALL BE REMOVED WHEN THE SITE IS COMPLETELY STABILIZED SO AS NOT TO BLOCK OR IMPEDE STORM FLOW OR DRAINAGE.
- ACCUMULATED SILT SHALL BE REMOVED WHEN IT REACHES A DEPTH OF 150 mm (6 inches). THE SILT SHALL BE DISPOSED OF ON AN APPROVED SITE AND IN SUCH A MANNER THAT WILL NOT CONTRIBUTE TO ADDITIONAL SILTATION.

SILT FENCE DETAILS

RECORD DRAWING

This Drawing Has Been Modified to Reflect Construction Records Provided To the Engineer.


5-31-2019

JMR Engineering
New Construction • Engineering • Environmental Services
7953 PINKERTON COURT
PLANO, TEXAS 75025
PH: (469) 544-8150 FAX: (972) 767-3003
EMAIL: mkmalm167@gmail.com
FIRM # - 9928

Rockwall Commons, Phase-2
1301 Ridge Road
Rockwall, Texas

JAHVANI CONSULTING ENGINEERS, INC.
TBPE REGISTRATION NO. F-10198
CONSULTING ENGINEERS
2121 N. JOSEY LANE, #100
CARROLLTON, TEXAS 75006
TEL: (214) 718-9469
jahvani@hotmail.com

REVISIONS	DATE

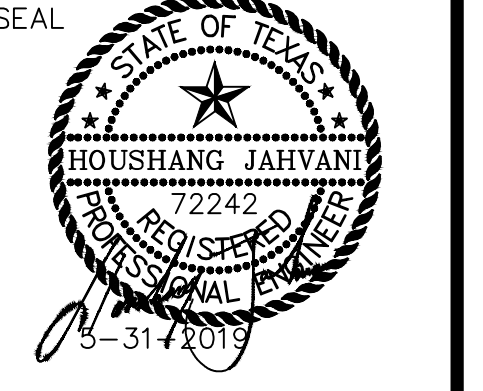

DWG. TITLE:
EROSION CONTROL DETAILS

PROJECT #:
DRAWN BY: HJ
SCALE: 1" = 30'
FILE NO:

DATE 5-31-2019


16 OF 20

SHEET NUMBER

TOTAL AREA OF SITE = 166,755.00 S.F.
 TOTAL AREA OF OPEN SPACE REQUIRED = 20% OF SITE = 33,351.00 S.F.
 TOTAL AREA OF OPEN SPACE PROVIDED = 28.71% OF SITE = 47,870.00 S.F.

TOTAL ON-SITE CALIPER PROTECTED TREES TO BE REMOVED = 204 INCHES
 TOTAL OFF-SITE CALIPER PROTECTED TREES TO BE REMOVED = 174 INCHES
 TOTAL ON-SITE AND OFF-SITE CALIPER PROTECTED TREES TO BE REMOVED = 378 INCHES
 TOTAL CALIPER PROTECTED TREES TO BE PLANTED = 326 INCHES
 TOTAL OFF-SITE CALIPER PROTECTED TREES TO BE PROTECTED = 59 INCHES


TOTAL CALIPER PROTECTED TREES TO BE REMOVED = 378 INCHES
 TOTAL CALIPER PROTECTED TREES TO BE SAVED OR PLANTED = 59 + 326 = 385 INCHES

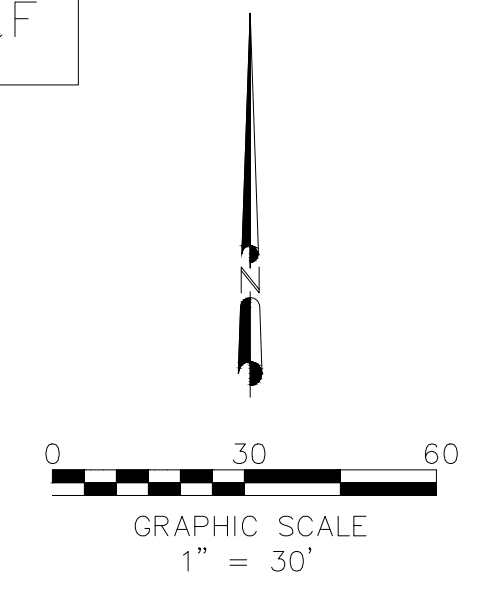

ASBUILT

RECORD DRAWING
 This Drawing Has Been Modified to Reflect
 Construction Records Provided To the Engineer.
 5-31-2019

SHRUBS TO BE PLANTED 4' BEHIND THE CURB.
 (BACK OF THE CURB TO FACE OF THE RETAINING WALL = 7')

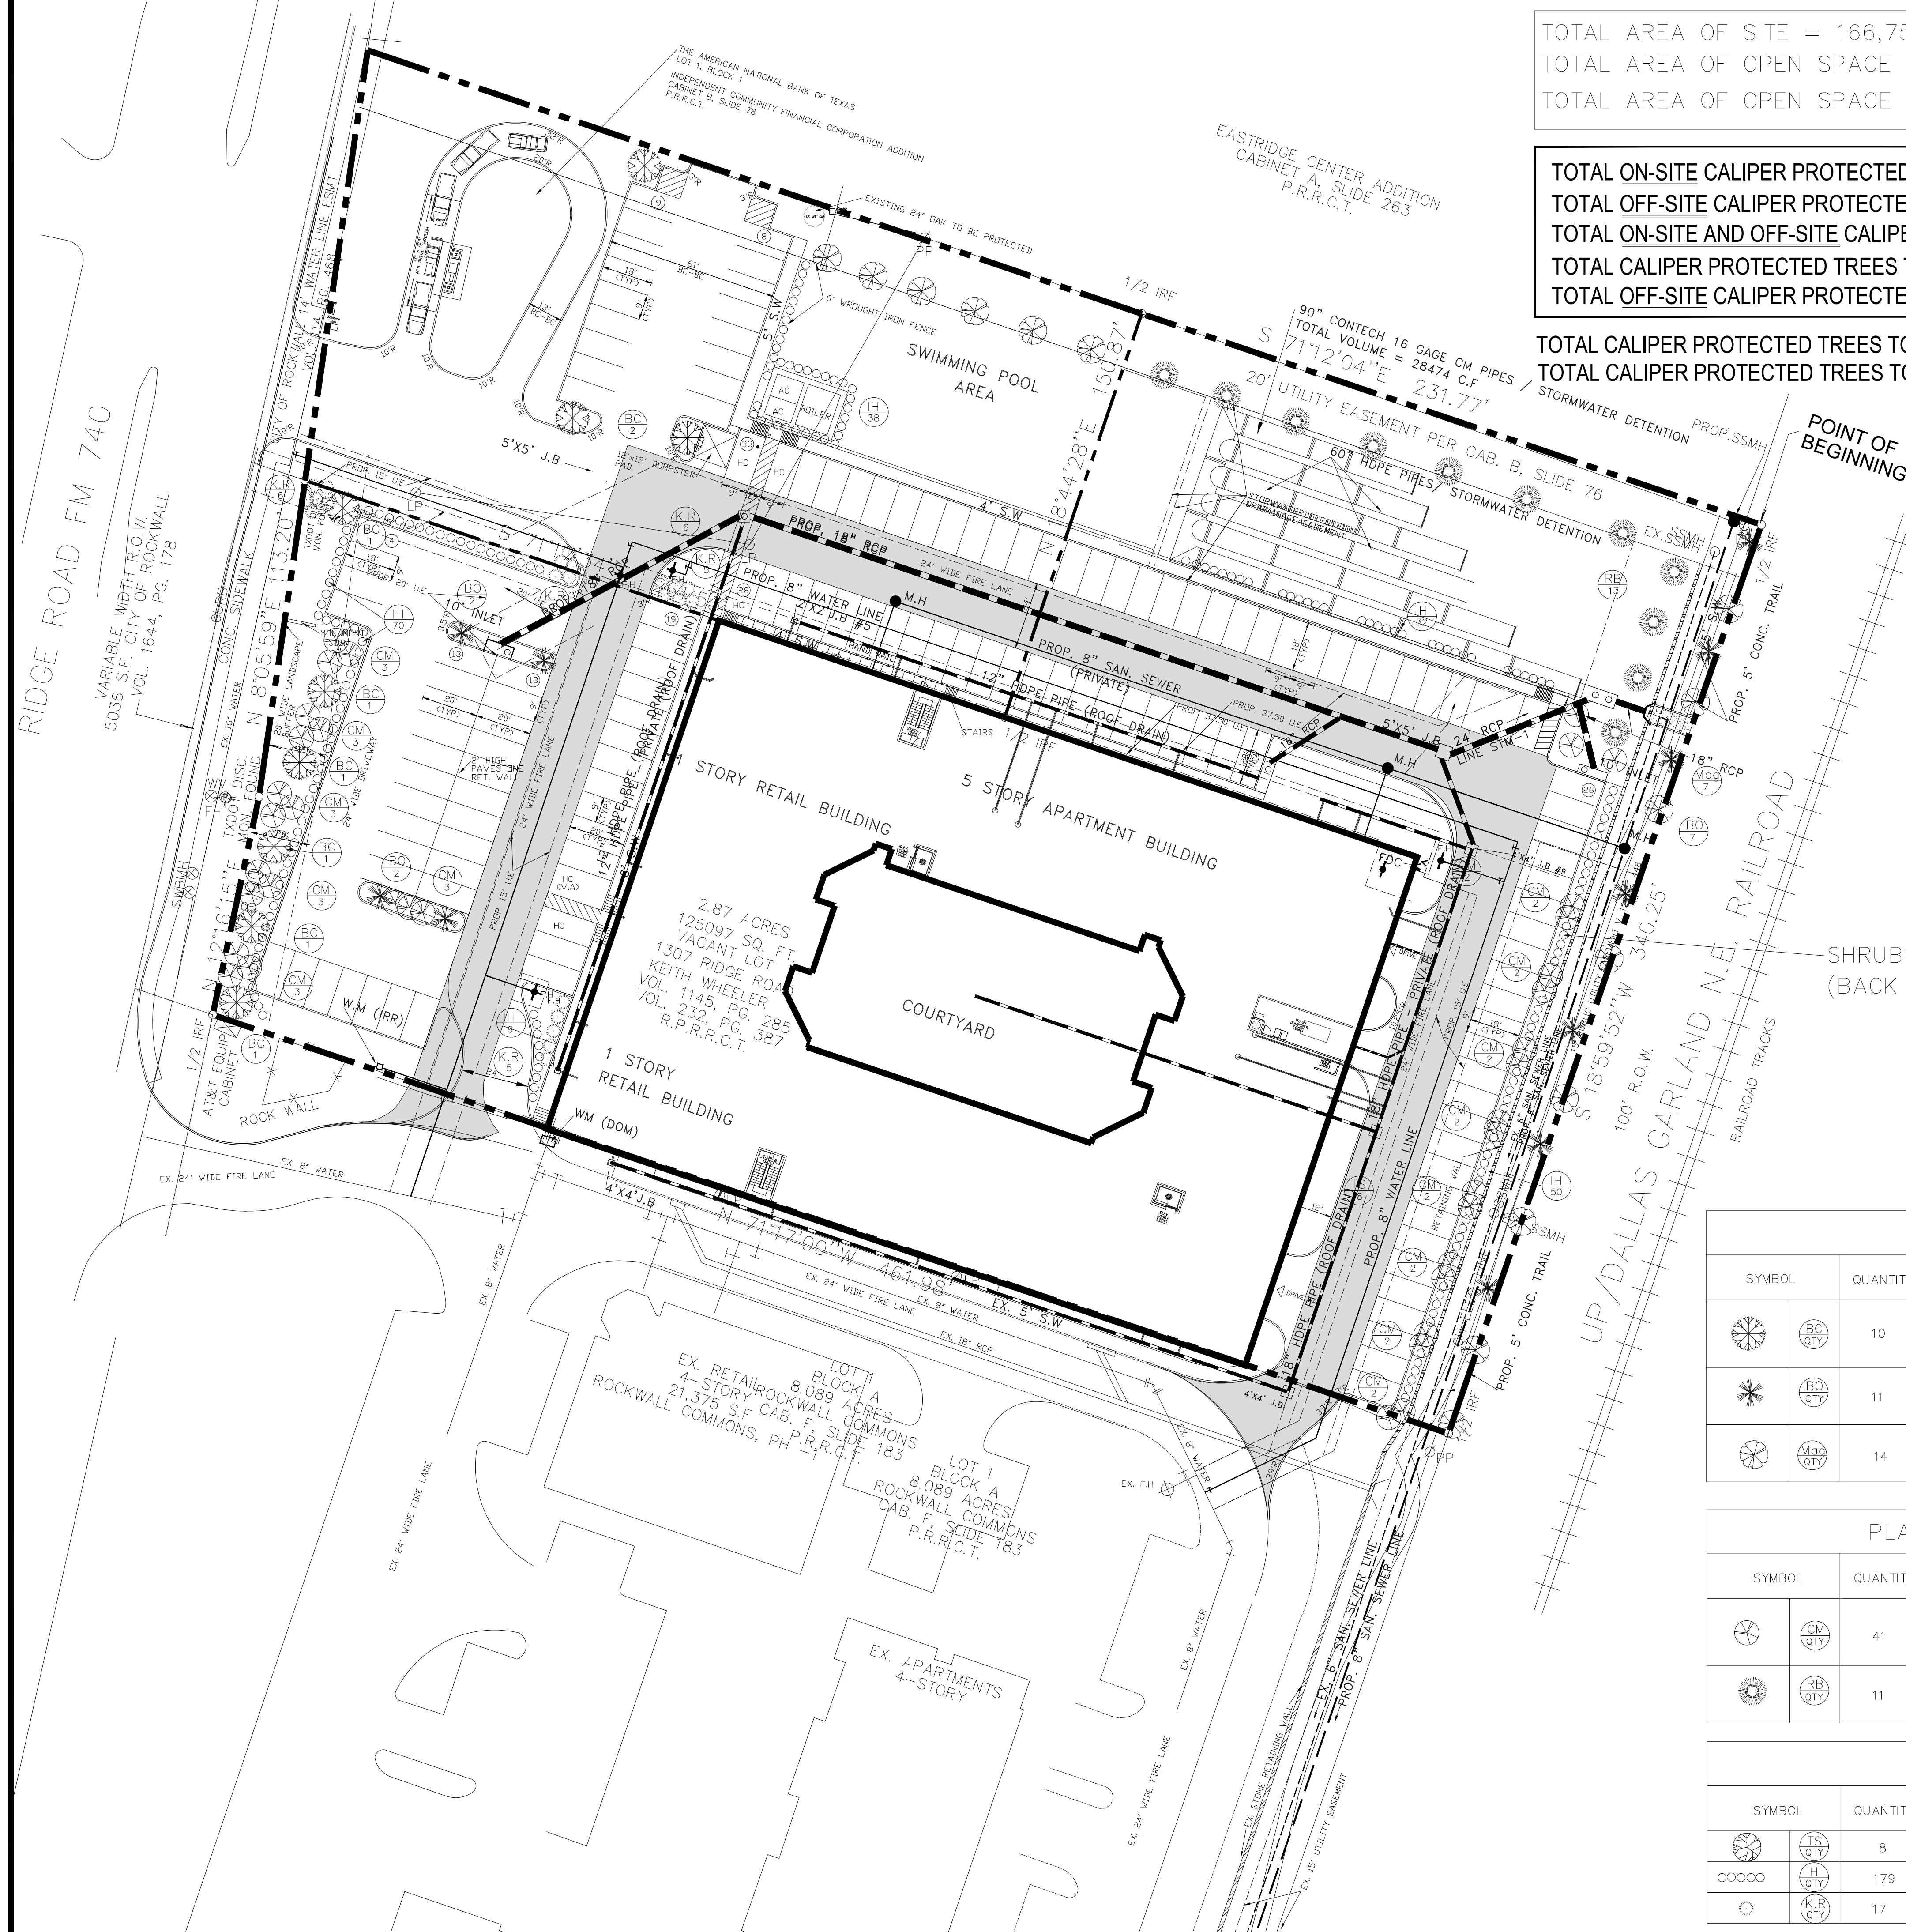

PLANTING SCHEDULE (LARGE TREES)

SYMBOL	QUANTITY	COMMON NAME	BOTANICAL NAME	SIZE/ CAL.	HEIGHT	SPACING
	10	BALD CYPRESS	Taxodium Distichum	4"	10' MIN.	AS-SHOWN' MIN
	11	BUR OAK	Quercus Macrocarpa	4"	10' MIN.	AS-SHOWN' MIN
	14	MAGNOLIA	Grandiflora	4"	8' MIN.	AS-SHOWN' MIN

PLANTING SCHEDULE (SMALL ORNAMENTAL TREES)

SYMBOL	QUANTITY	COMMON NAME	BOTANICAL NAME	SIZE/ CAL.	HEIGHT	SPACING
	41	CRAPE MYRTLE (RED)	Lagerstroemia Indica	4" MULTI-TRUNK	8' MIN.	AS SHOWN
	11	RED BUD	Cercis Canadensis	2"	8' MIN.	AS-SHOWN

PLANTING SCHEDULE (SHRUBS)

SYMBOL	QUANTITY	COMMON NAME	BOTANICAL NAME	SIZE/ CAL.	HEIGHT	SPACING
	8	TEXAS SAGE	Leucophyllum Frutescens	2 GAL.	24"	AS SHOWN
	179	INDIAN HAWTHORN	Raphiolepis Indica	2 GAL.	24"	3' O.C
	17	KNOCK OUT ROSES	-	2 GAL.	24"	3' O.C


JVR Engineering
 New Construction • Engineering • Environmental Services
 7953 PINKERTON COURT
 PLANO, TEXAS 75025
 PH: (469) 544-8150 FAX: (972) 767-3003
 EMAIL: mkamal@jvr.com
 FIRM # F - 9928

Rockwall Commons, Phase-2
 1301 Ridge Road
 Rockwall, Texas

JAHVANI CONSULTING ENGINEERS, INC.
 TBPE REGISTRATION NO. F-10198
 CONSULTING ENGINEERS
 2121 N. JOSEY LANE, #100
 CARROLLTON, TEXAS 75006
 TEL: (214) 718-9469
 jahvani@hotmail.com

REVISIONS

NO.	DATE	DESCRIPTION

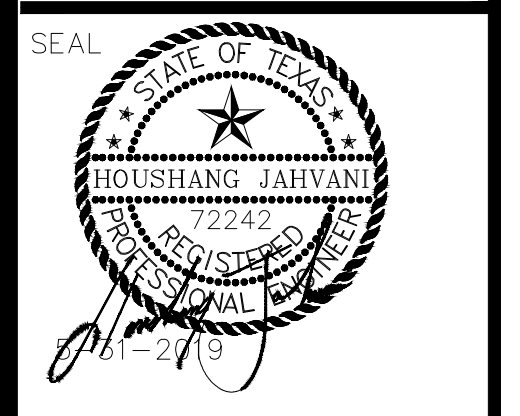


DWG. TITLE:
 LANDSCAPE PLAN

PROJECT #:
 DRAWN BY: HJ
 SCALE: 1" = 30'
 FILE NO:

DATE 5-31-2019


REVISIONS	DATE

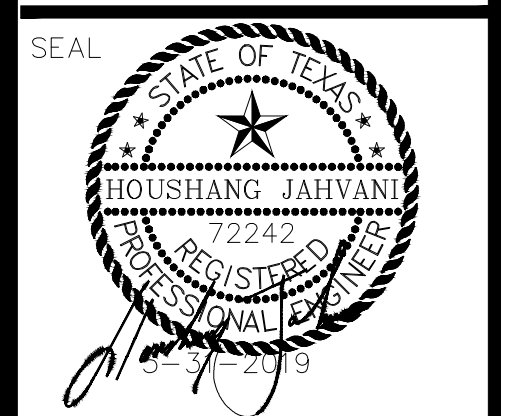

DWG. TITLE:
 CONCRETE RETAINING WALL
 MISCELLANEOUS DETAILS

PROJECT #:
 DRAWN BY: HJ
 SCALE: 1" = 30"
 FILE NO:

DATE 5-31-2019

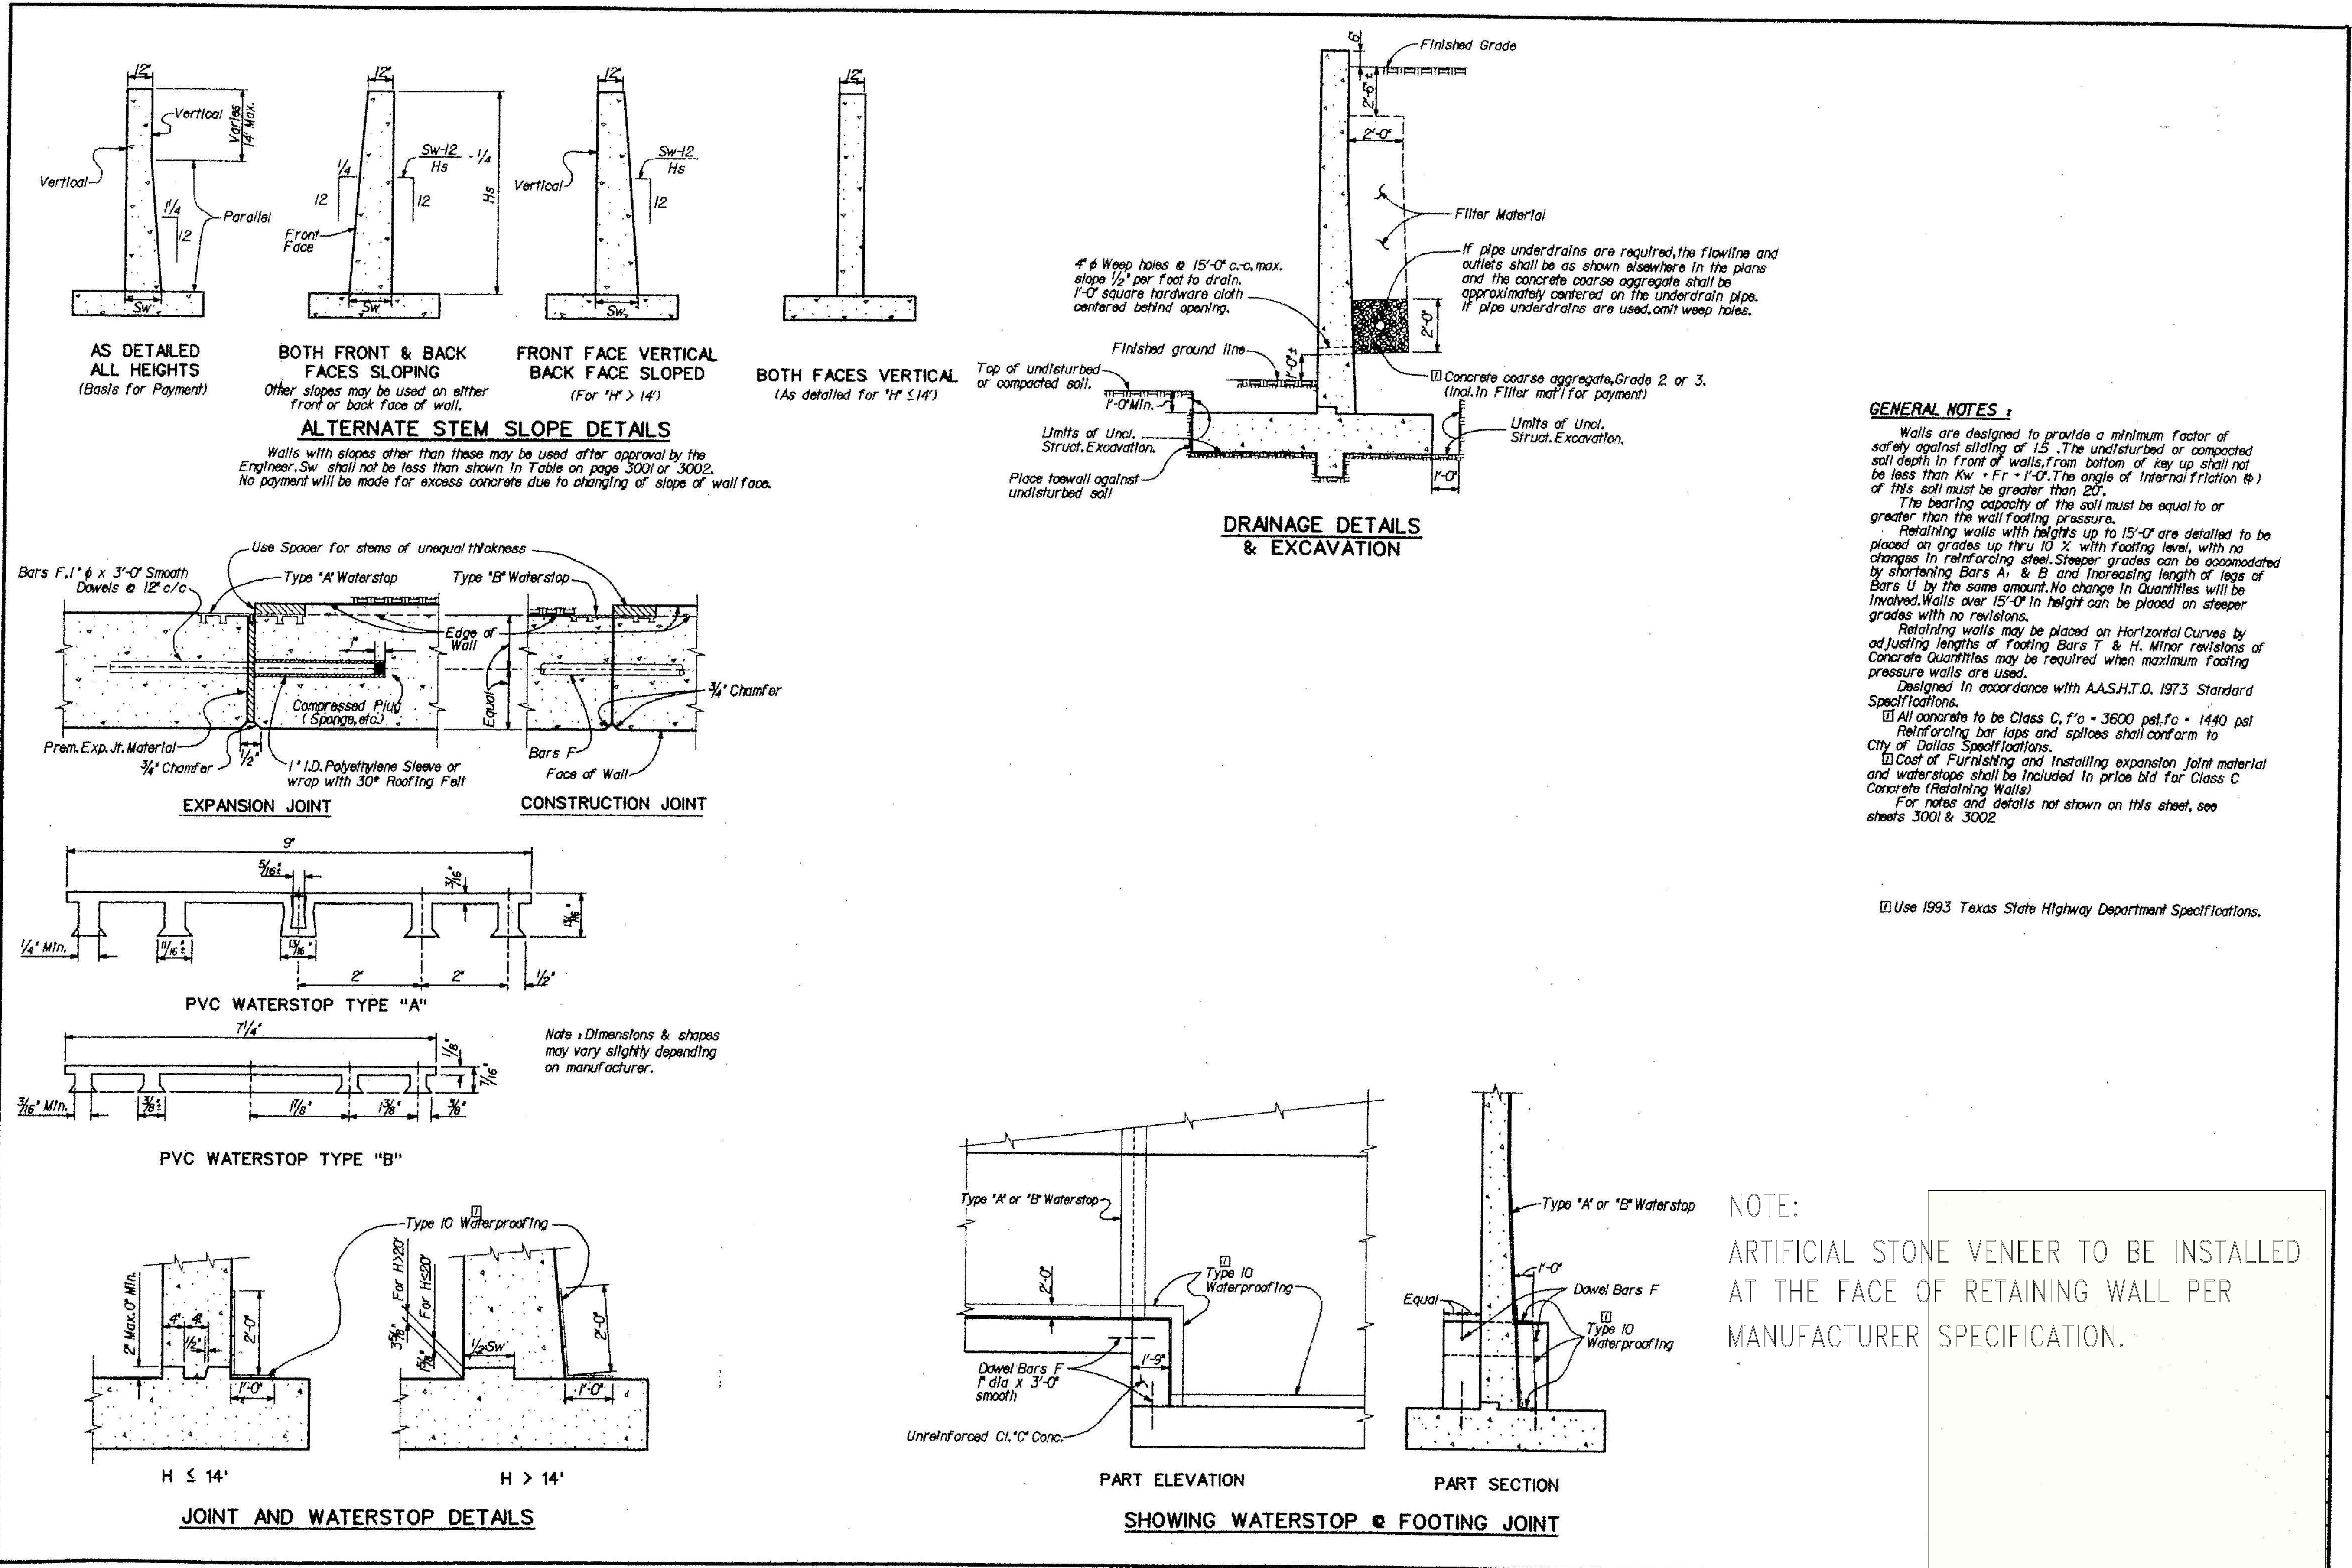

ASBUILT

RECORD DRAWING
 This Drawing Has Been Modified to Reflect Construction Records Provided To the Engineer.
 5-31-2019

