

RECORD DRAWING
 THIS RECORD DRAWING HEREIN REFLECTS TO THE BEST OF THE DESIGN ENGINEER'S KNOWLEDGE, THE APPROXIMATE LOCATION OF THE CONSTRUCTED WORK USING INFORMATION AS PROVIDED BY THE CONTRACTORS AND SURVEYED GRADES.


NOTE
 CONTRACTOR TO ADJUST MANHOLE RIM ELEVATIONS TO FINISHED GRADE.

SCALE
 1" = 40' HORIZ.
 1" = 4' VERT.


BENCHMARKS:		
ROCKWALL MONUMENT R500-1: CONC. MONUMENT IN CENTER MEDIAN OF SUMMIT RIDGE DRIVE, WEST OF RIDGE RD. ELEV: 578.63	1" SET IN MEDIAN NOSE RIDGE ROAD ±193 FEET SOUTH OF SW PROPERTY CORNER. ELEV: 546.15	1" SET ON INLET WEST CURB LINE RIDGE ROAD, ±155 SOUTH OF NW PROPERTY CORNER ELEV: 553.07

No.	Date	Revisions	App.

**Kimley-Horn
and Associates, Inc.**
 9300 Wade Boulevard,
Frisco, Texas 75035
 Suite 320
 Tel. No. (972) 335-3950
 Fax No. (972) 335-3779

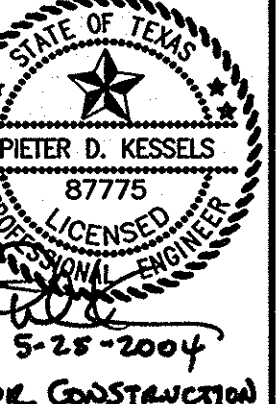

**STORM SEWER PROFILES ROCKWALL COMMONS
MIXED USE TRACT
CITY OF ROCKWALL, TEXAS**

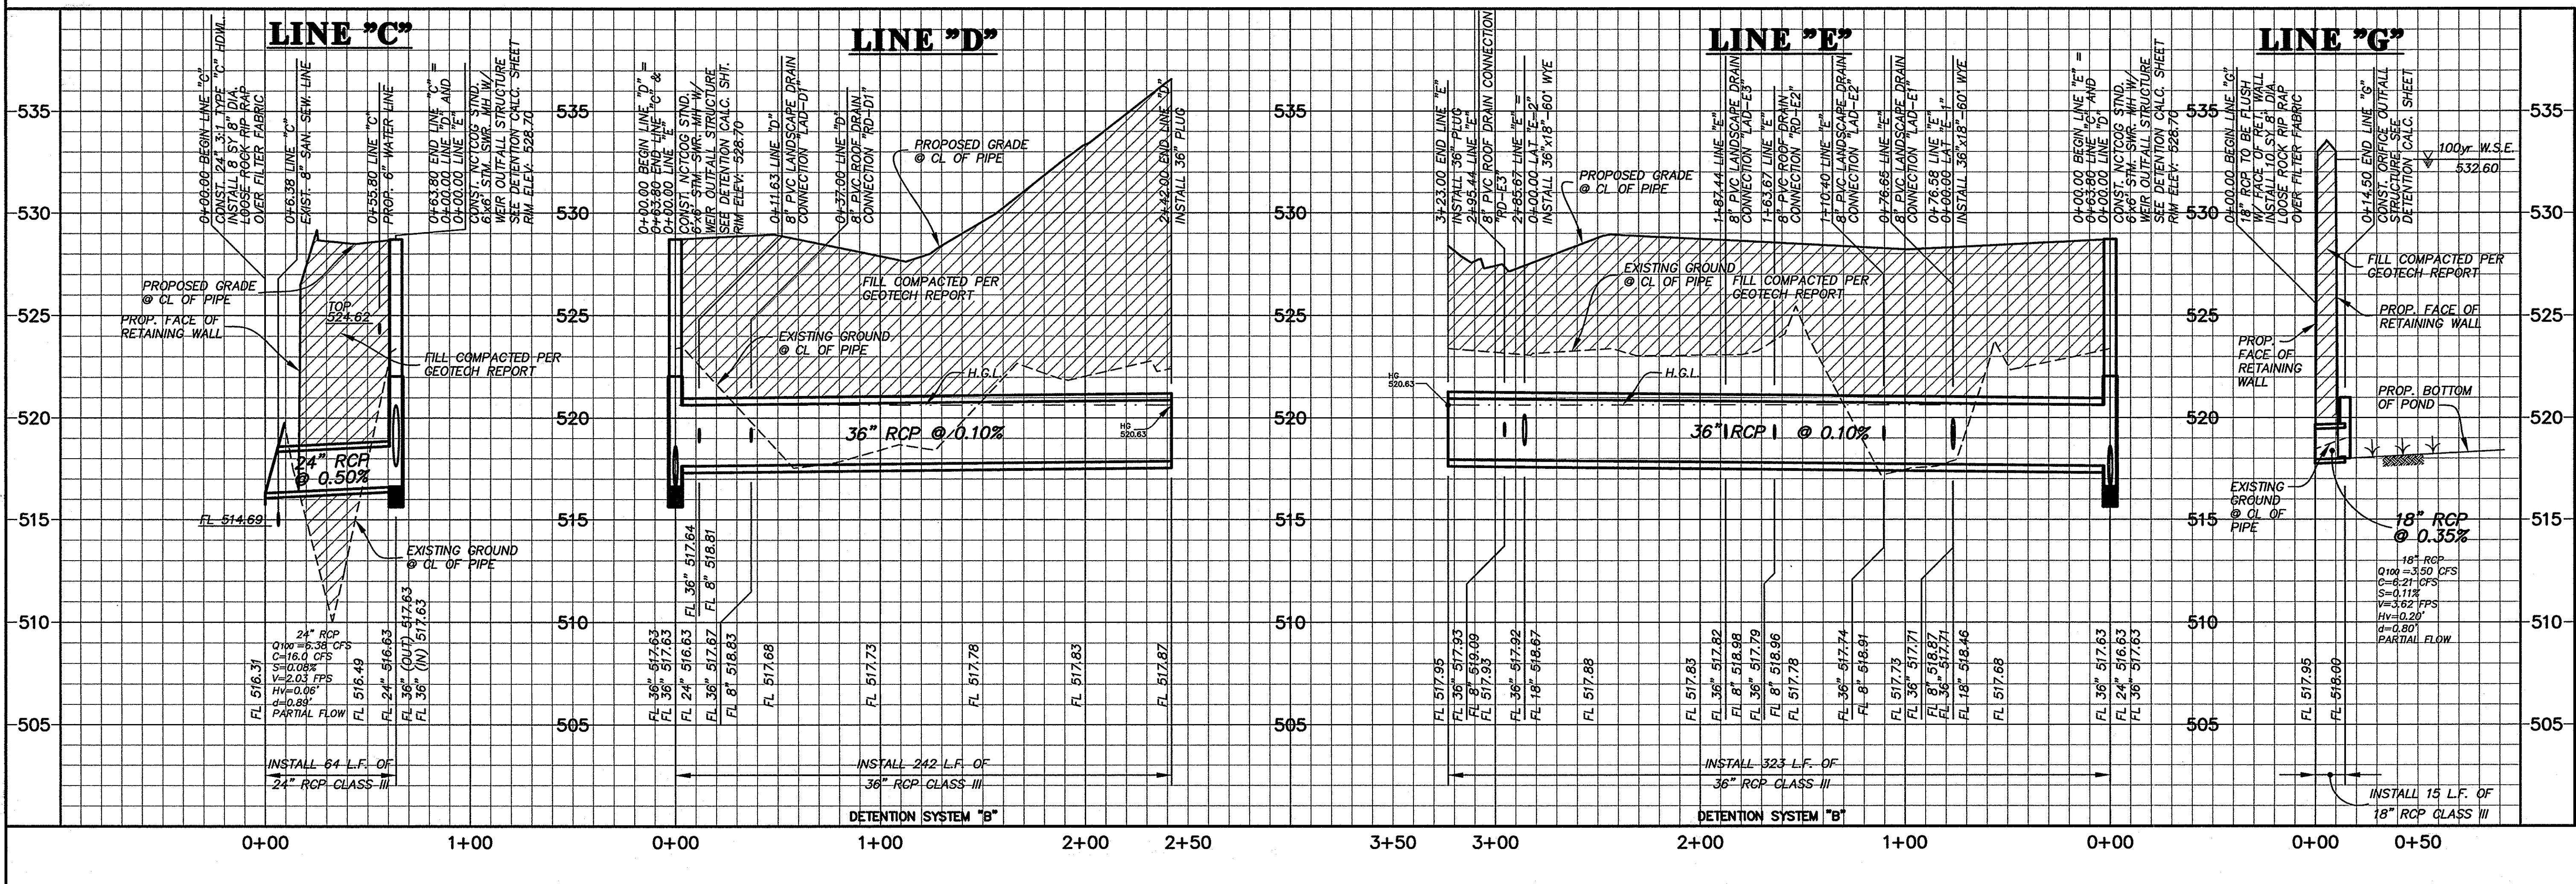

Scale: AS SHOWN
 Designed by: J.G.W.
 Drawn by: B.B.P.
 Checked by: P.D.K.
 Date: 05/25/04
 Project No. 067051007

SHEET
 C-10
 OF 24

DATE PLOTTED: 05/25/04 10:51:00 AM
 PLOTTER: HP DesignJet 5000 Series
 PLOT: C:\Projects\067051007\067051007.dwg
 PLOT SCALE: 1"=40'