


SCALE
 1" = 40' HORIZ
 1" = 4' VERT

RECORD DRAWING
 THIS RECORD DRAWING HEREIN REFLECTS TO THE BEST OF THE DESIGN ENGINEER'S KNOWLEDGE THE APPROXIMATE LOCATION OF THE CONSTRUCTED WORK, USING INFORMATION AS PROVIDED BY THE CONTRACTORS AND SURVEYED GRADES.

BENCHMARKS:
 ROCKWALL MONUMENT R500-1: CONC. MONUMENT IN CENTER MEDIAN OF SUMMIT RIDGE DRIVE, WEST OF RIDGE RD. ELEV: 578.63
 "T" SET IN MEDIAN NOSE RIDGE ROAD 453 FEET SOUTH OF SW PROPERTY CORNER. ELEV: 546.15
 "T" SET ON INLET WEST CURB LINE RIDGE ROAD, 315 FEET SOUTH OF NW PROPERTY CORNER. ELEV: 553.07

No.	Date	Revisions	App.

Kimley-Horn and Associates, Inc.
 8300 West Bellwood
 Frisco, Texas 75035
 Tel. No. (972) 355-3889
 Fax No. (972) 355-3779
 Suite 320

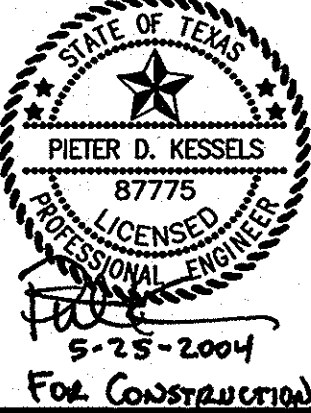

ROCKWALL COMMONS MIXED USE TRACT
CITY OF ROCKWALL, TEXAS

SANITARY SEWER PROFILE

Scale: AS SHOWN
 Designed by: P.D.K.
 Drawn by: B.B.P.
 Checked by: P.D.K.
 Date: 05/25/04
 Project No. 067051007

** CONTRACTOR TO ADJUST MH RIM ELEVATIONS TO FINISH GRADE