


**RECORD DRAWING**  
THIS RECORD DRAWING HEREIN REFLECTS TO THE BEST OF THE DESIGN ENGINEER'S KNOWLEDGE, THE APPROXIMATE LOCATION OF THE CONSTRUCTED WORK, USING INFORMATION AS PROVIDED BY THE CONTRACTORS AND SURVEYED GRADES.

- NOTES:**
1. REFERENCE CITY OF ROCKWALL STANDARD DRAWINGS FOR ALL OTHER APPLICABLE DETAILS.
  2. REFERENCE CITY OF ROCKWALL AMENDMENTS TO THE NCTCOG STANDARD DRAWINGS (AS CLOUDED ON THE MODIFIED NCTCOG STANDARD DRAWINGS SHOWN ON THIS PAGE).

No.	Date	Revisions	App.

**Kimley-Horn and Associates, Inc.**  
Tel. No. (972) 335-9950  
Fax No. (972) 335-9779  
9300 Wade Boulevard, Suite 320  
Frisco, Texas 75035

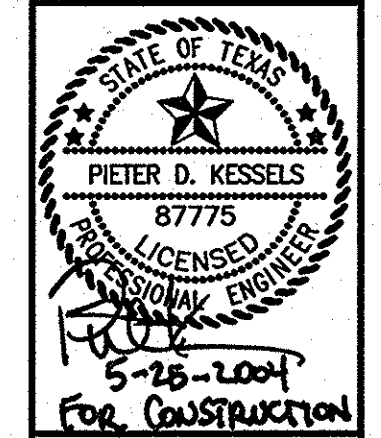

**ROCKWALL COMMONS  
MIXED USE TRACT  
CITY OF ROCKWALL, TEXAS**

**EROSION CONTROL  
DETAILS**

Scale:  
Designed by:  
Drawn by:  
Checked by: P.D.K.  
Date: 05/25/04  
Project No. 067051007

SHEET  
C-18  
OF 24

C:\P\051007-Record Common\05-CD-Erosion-1.dwg 05/24/2004 10:43