




(MODIFIED TO REFLECT CITY AMENDMENTS TO NCTCOG DETAIL)

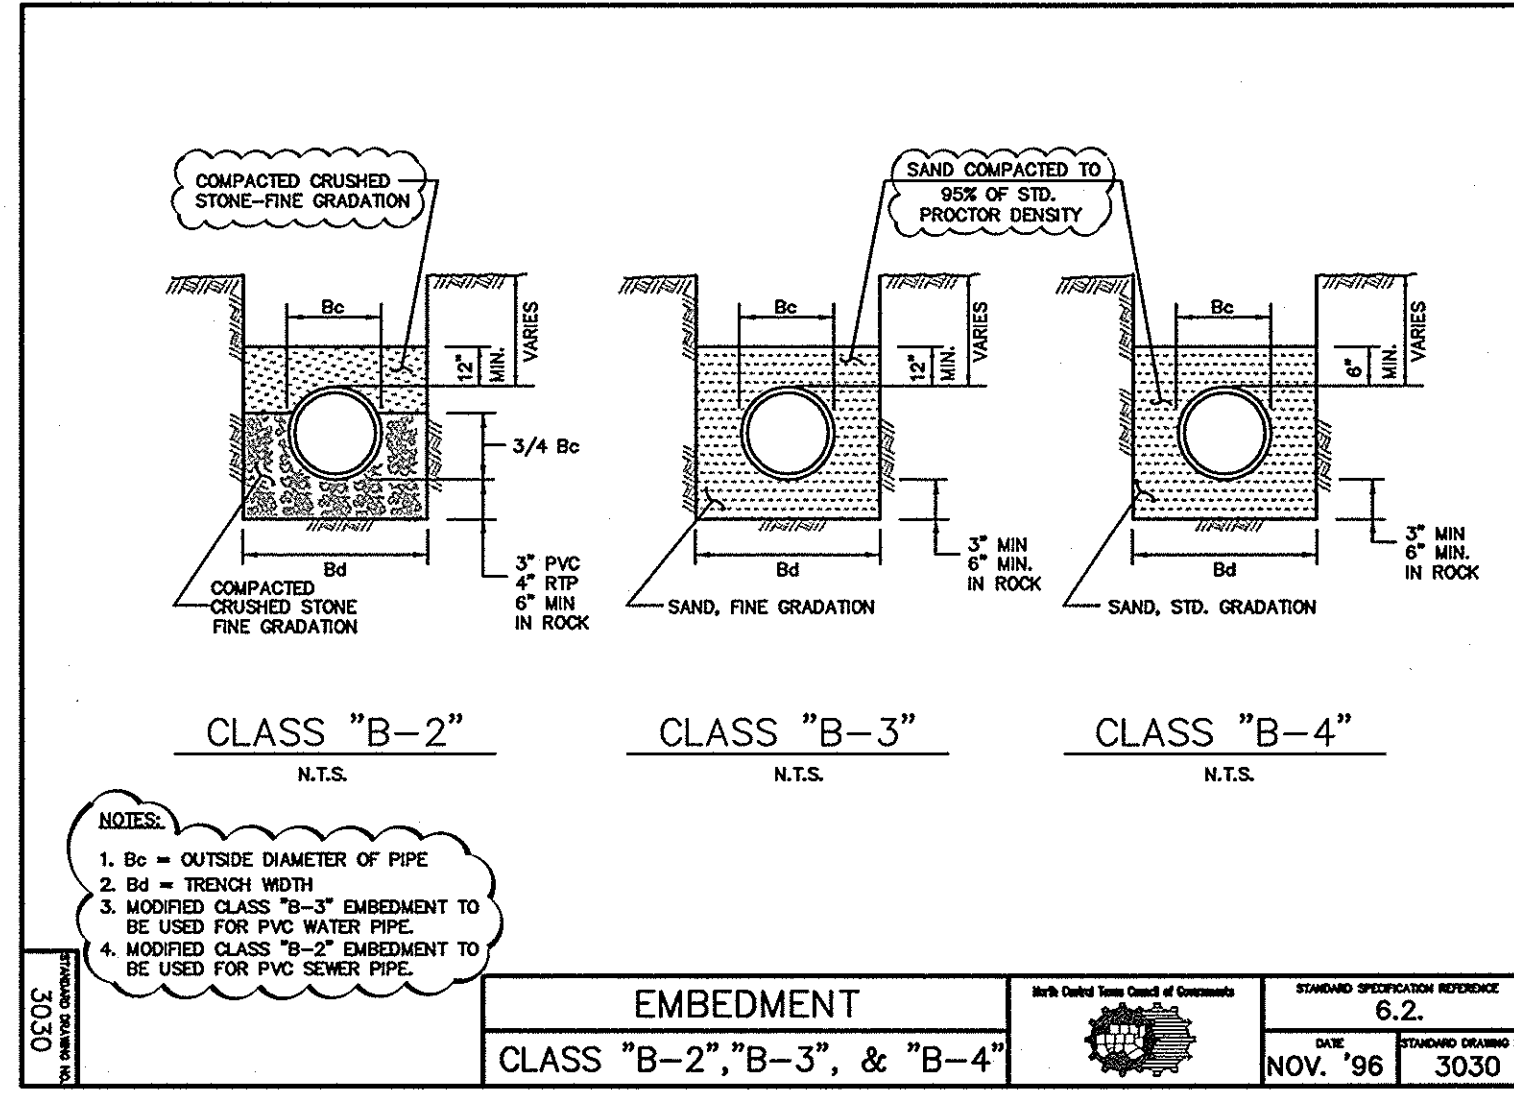


(MODIFIED TO REFLECT CITY AMENDMENTS TO NCTCOG DETAIL)

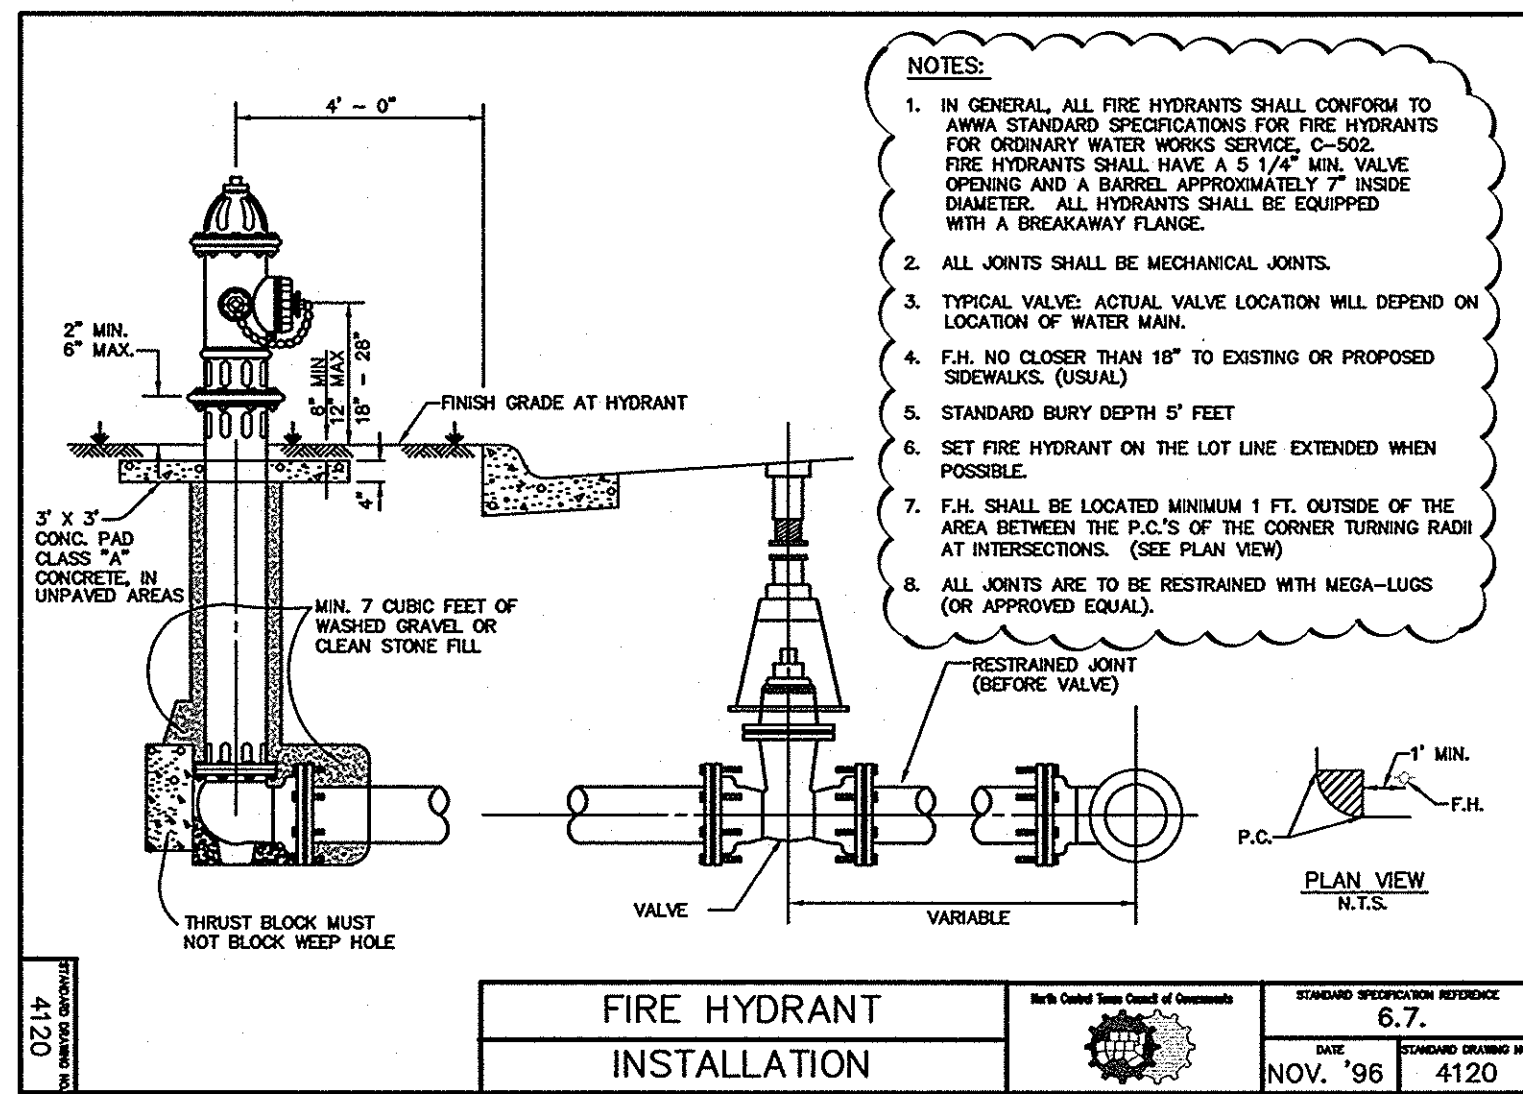


(MODIFIED TO REFLECT CITY AMENDMENTS TO NCTCOG DETAIL)

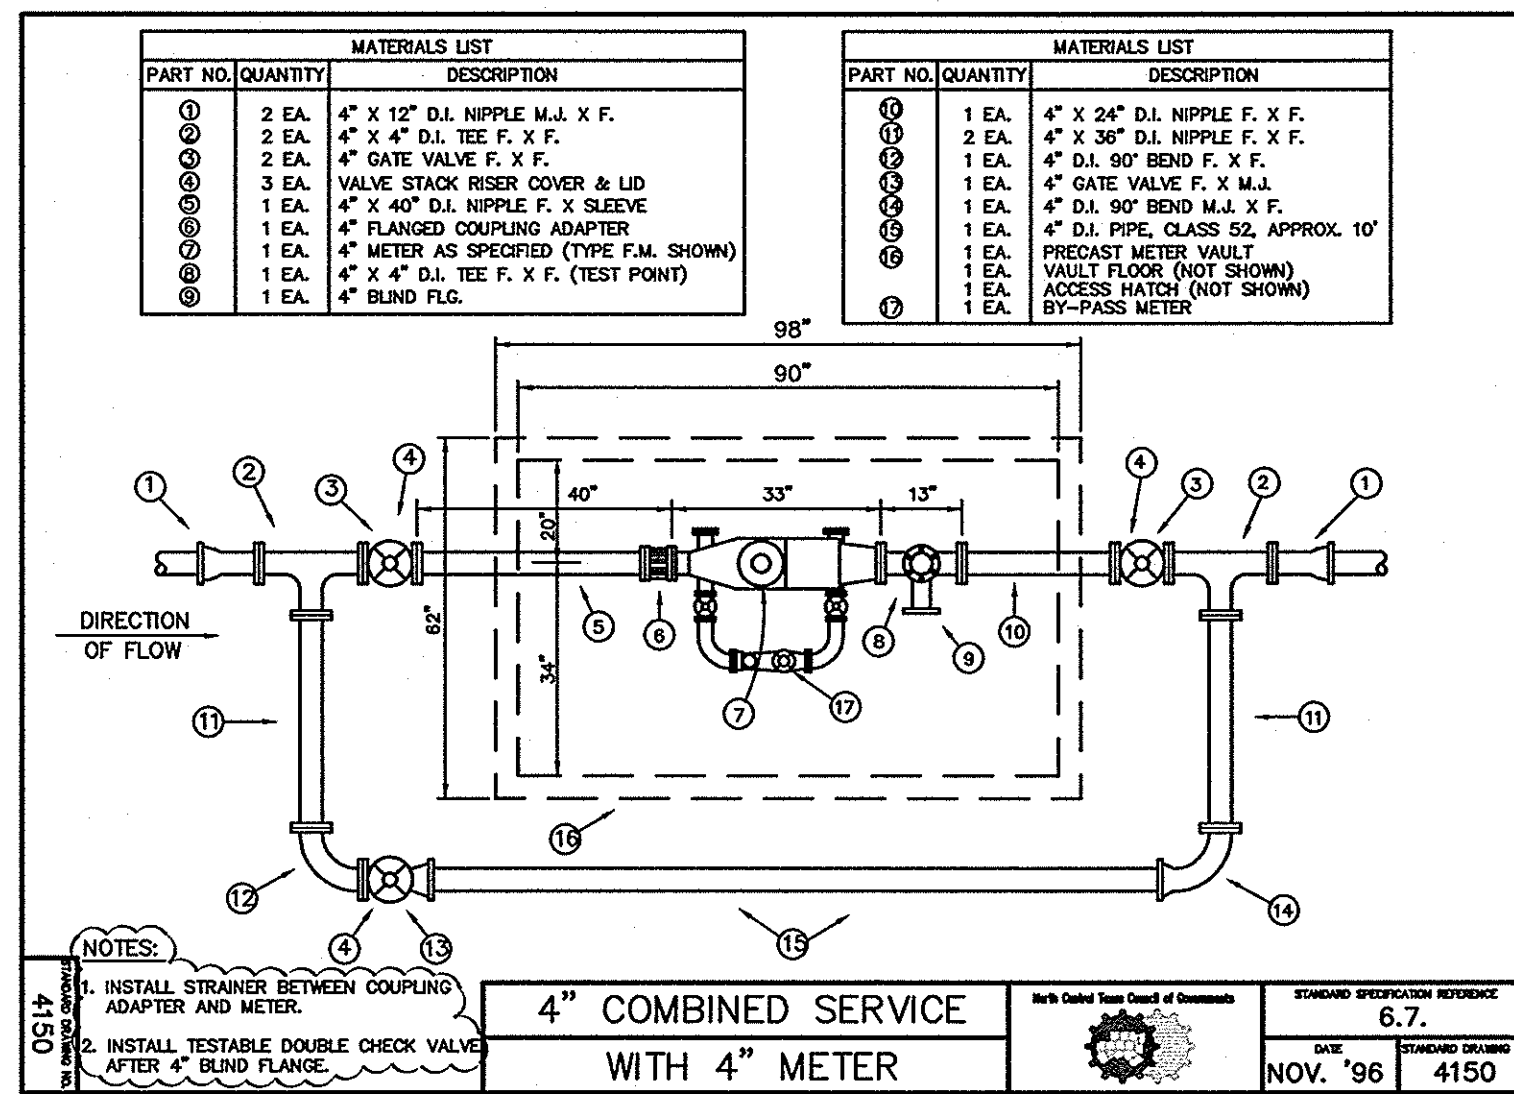

(MODIFIED TO REFLECT CITY AMENDMENTS TO NCTCOG DETAIL)

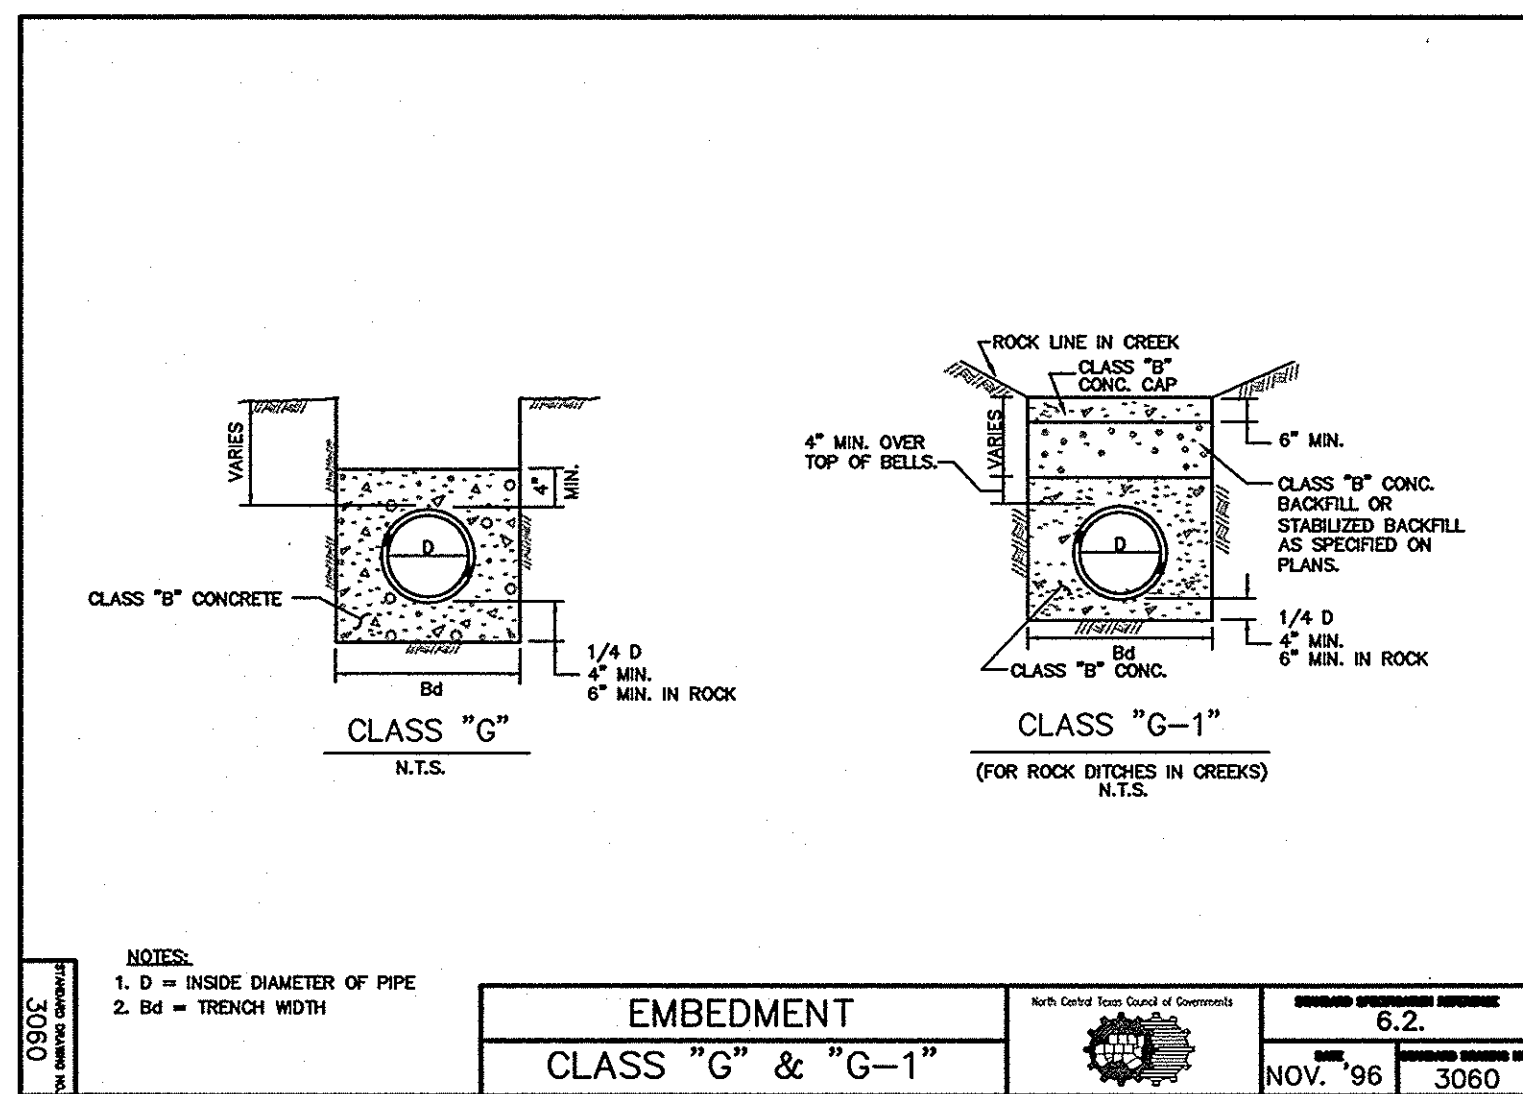


(MODIFIED TO REFLECT CITY AMENDMENTS TO NCTCOG DETAIL)

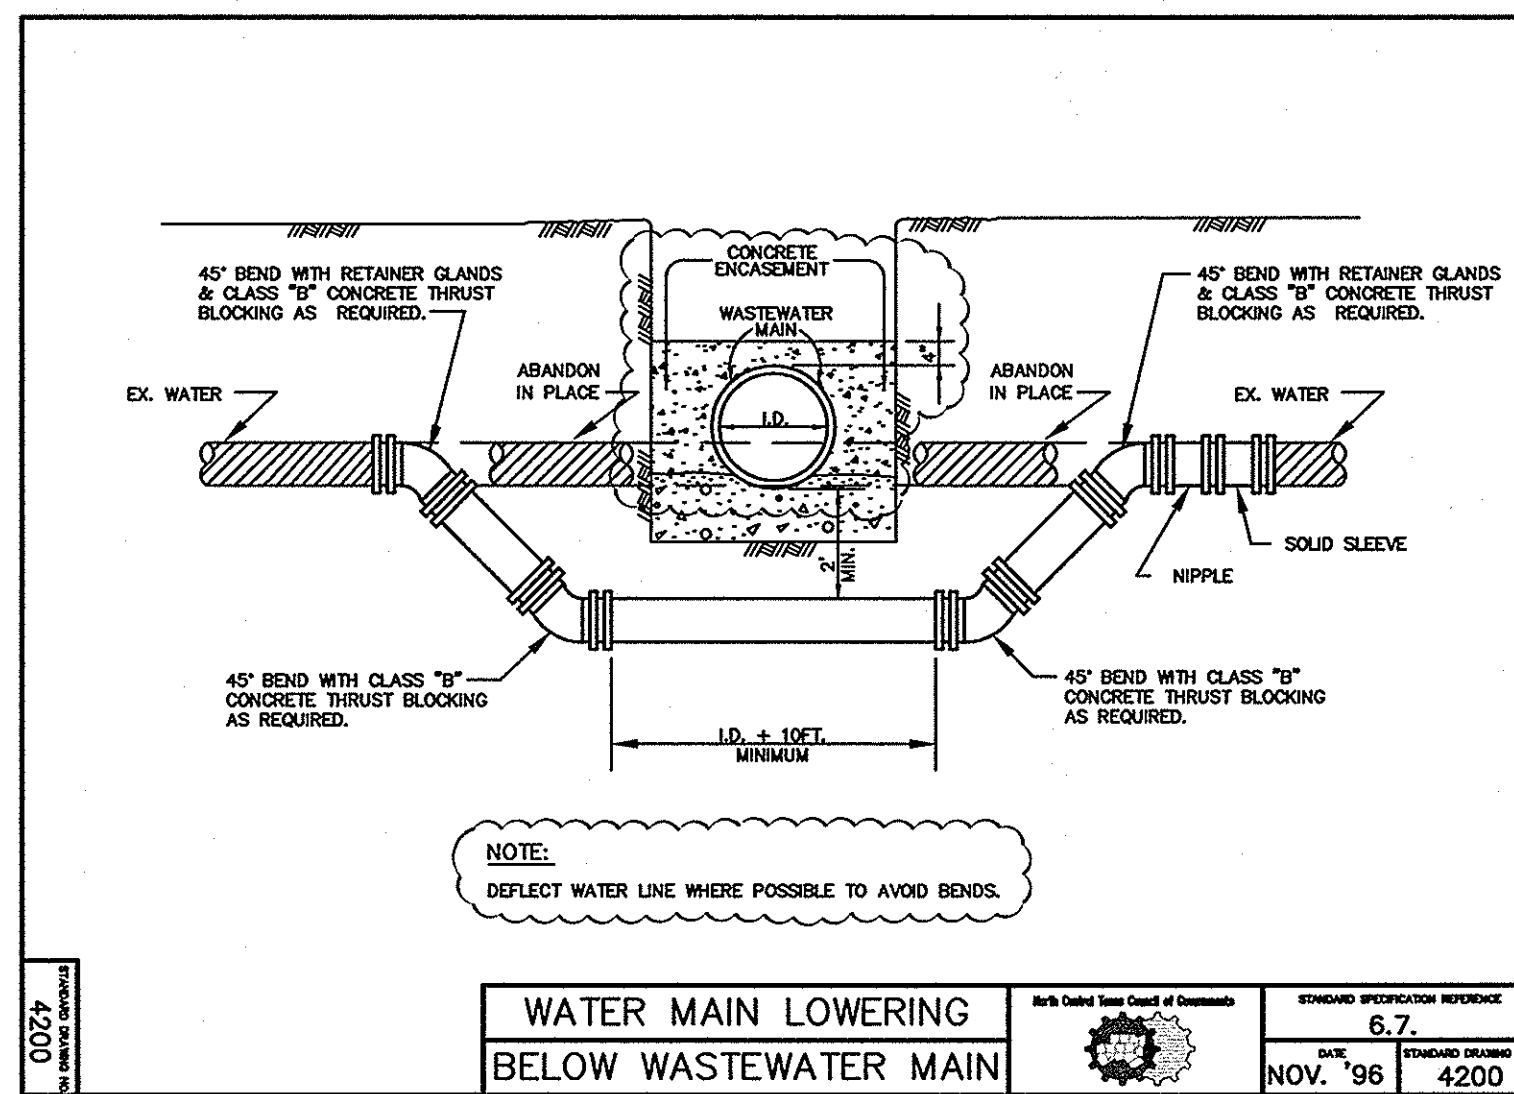

**NOTES:**  
 1. REFERENCE CITY OF ROCKWALL STANDARD DRAWINGS FOR ALL OTHER APPLICABLE DETAILS.  
 2. REFERENCE CITY OF ROCKWALL AMENDMENTS TO THE NCTCOG STANDARD DRAWINGS (AS CLOUDED ON THE MODIFIED NCTCOG STANDARD DRAWINGS SHOWN ON THIS PAGE).

No.	Date	Revisions	App.

**Kimley-Horn and Associates, Inc.**  
 Tel. No. (972) 335-3950  
 Fax No. (972) 335-3779  
 Suite 320  
 9300 Wade Boulevard,  
 Frisco, Texas 75035

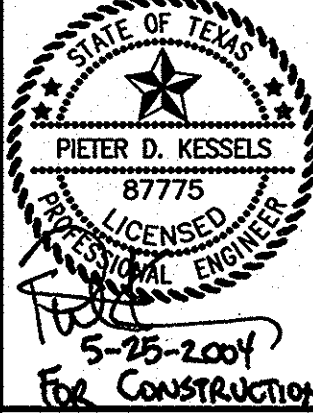

**ROCKWALL COMMONS  
 AND MIXED USE TRACT  
 CITY OF ROCKWALL, TEXAS**

**WATER,  
 SANITARY SEWER, AND  
 STORM SEWER DETAILS**

**RECORD DRAWING**  
 THIS RECORD DRAWING HEREIN REFLECTS TO THE BEST OF THE DESIGN ENGINEER'S KNOWLEDGE, THE APPROXIMATE LOCATION OF THE CONSTRUCTED WORK, USING INFORMATION AS PROVIDED BY THE CONTRACTORS AND SURVEYED GRADES.

Scale:  
 Designed by:  
 Drawn by:  
 Checked by: P.D.K.  
 Date: 05/25/04  
 Project No. 067051007

SHEET  
 C-22  
 OF 24