
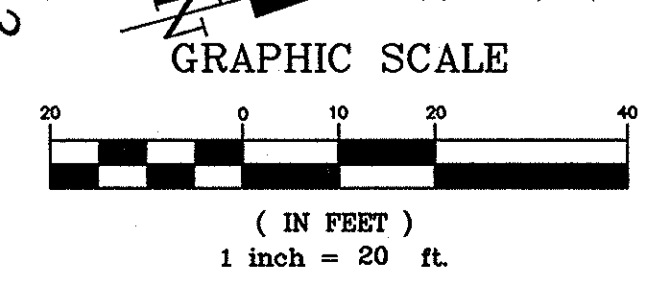


SEE SHEET C-1 FOR CONSTRUCTION NOTES

THE CONTRACTOR SHALL FIELD VERIFY THE HORIZONTAL AND VERTICAL LOCATIONS OF ALL EXISTING UTILITIES PRIOR TO START OF CONSTRUCTION AND SHALL NOTIFY THE CONSTRUCTION MANAGER AND ENGINEER OF ANY CONFLICTS DISCOVERED. CONTRACTOR IS RESPONSIBLE FOR PROTECTING EXISTING UTILITIES (SHOWN OR NOT SHOWN) WITHIN SCOPE OF CONSTRUCTION. IF ANY EXISTING UTILITIES ARE DAMAGED, THE CONTRACTOR SHALL REPLACE THEM AT HIS OWN EXPENSE. CALL 1-800-DIG-TESS AT LEAST 72 HOURS PRIOR TO COMMENCING CONSTRUCTION IN VICINITY.

LEGEND	
	EXISTING CONTOUR
	PROPOSED CONTOUR
	NATURAL GROUND SHOT
	EX TOP OF CURB
	EXISTING GUTTER
	PROPOSED TOP OF PAVEMENT
	PROPOSED GUTTER
	PROPOSED SIDEWALK GRADE
	PROPOSED SURFACE GRADE
	RIDGE
	FLOW DIRECTION ARROW
	TOP OF WALL
	BOTTOM OF EXPOSED WALL
	TOP OF DECK
	LOW POINT
	HIGH POINT
	FLOW LINE

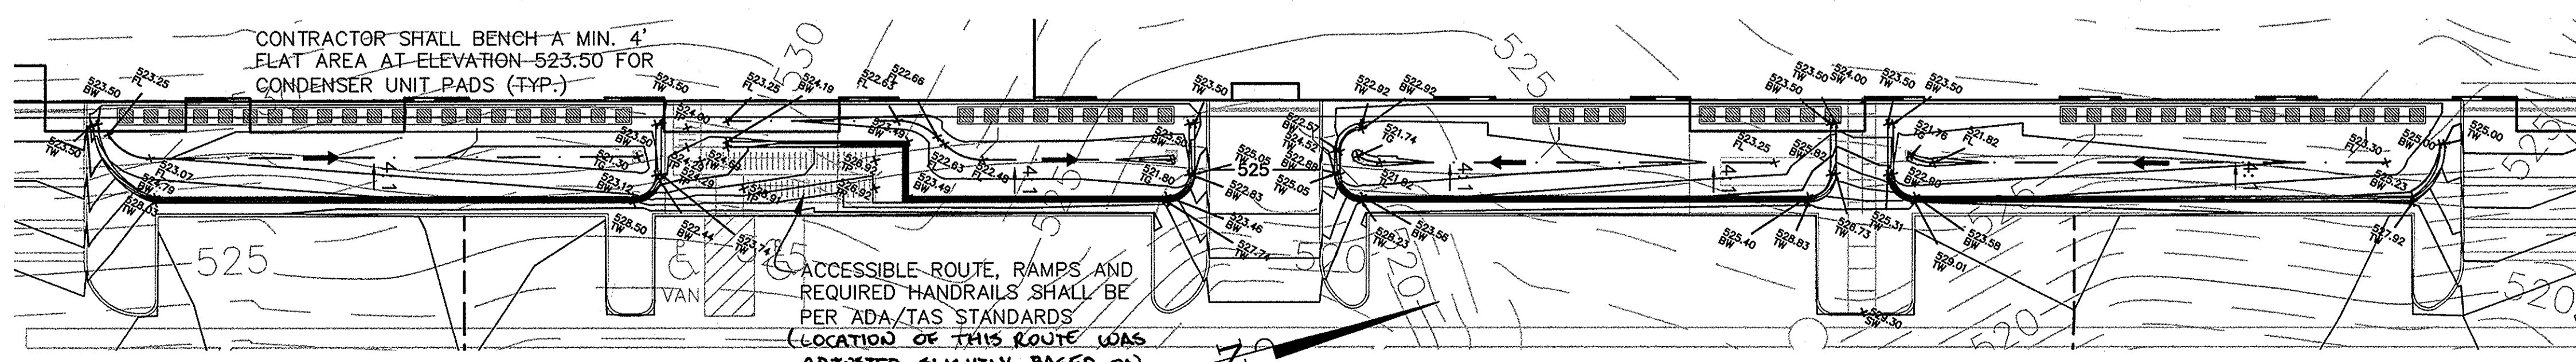

RECORD DRAWING
THIS RECORD DRAWING HEREIN REFLECTS TO THE BEST OF THE DESIGN ENGINEER'S KNOWLEDGE THE APPROXIMATE LOCATION OF THE CONSTRUCTED WORK, USING INFORMATION AS PROVIDED BY THE CONTRACTORS AND SURVEYED GRADES.

BENCHMARKS:
ROCKWALL MONUMENT R500-1: CONC. MONUMENT IN CENTER MEDIAN OF SUMMIT RIDGE DRIVE, WEST OF RIDGE RD. ELEV: 578.63
"T" SET IN MEDIAN NOSE RIDGE ROAD ±193 FEET SOUTH OF SW PROPERTY CORNER. ELEV: 546.15
"T" SET ON INLET WEST CURB LINE RIDGE ROAD, ±155 SOUTH OF NW PROPERTY CORNER. ELEV: 553.07

No.	Date	Revisions	App.
1/31/05		REVISED ENTRANCES AND GRADING	JRY

Kimley-Horn and Associates, Inc.
Site 320
5300 Weeks Boulevard,
Frisco, Texas 75035
Tel. No. (972) 355-3969
Fax No. (972) 355-3779

PETER D. KESSELS
87775
LICENSED PROFESSIONAL ENGINEER
01-31-2005

ROCKWALL COMMONS MIXED USE TRACT
CITY OF ROCKWALL, TEXAS

GRADING PLAN SOUTH

Scale:	AS SHOWN
Designed by:	P.D.K.
Drawn by:	C.D.R.
Checked by:	P.D.K.
Date:	05/25/04
Project No.	067051007
SHEET	
C-4	
OF 24	