



LEGEND	
	DRAINAGE AREA DIVIDE
	EXISTING STORM SEWER LINE & INLET
	FLOW ARROWS
	DRAINAGE AREA
	ACRES
	Q ₁₀₀


DRAINAGE AREA RUNOFF CALCULATIONS					
DRAINAGE AREA NO.	AREA (ac)	C (coeff.)	t _c (min)	I ₁₀₀ (in/hr)	Q ₁₀₀ (cfs)
1	2.63	0.35	20	8.3	7.64
To Outfall #1					7.64
2	5.46	0.35	20	8.3	15.86
To Outfall #2					15.86

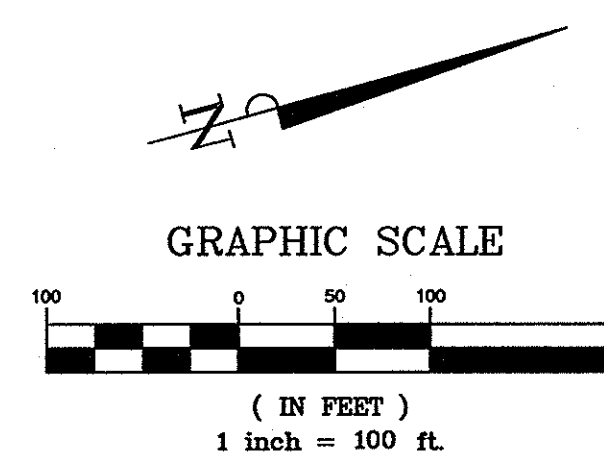

BENCHMARKS:
 ROCKWALL MONUMENT RS00-1:
 CONG. MONUMENT IN CENTER
 MEDIAN OF SUMMIT RIDGE DRIVE,
 WEST OF RIDGE RD.
 ELEV: 578.63
 "I" SET IN MEDIAN NOSE RIDGE
 ROAD ±193 FEET SOUTH OF SW
 PROPERTY CORNER.
 ELEV: 546.15
 "I" SET ON INLET WEST CURB
 LINE RIDGE ROAD, ±155 SOUTH
 OF NW PROPERTY CORNER
 ELEV: 553.07

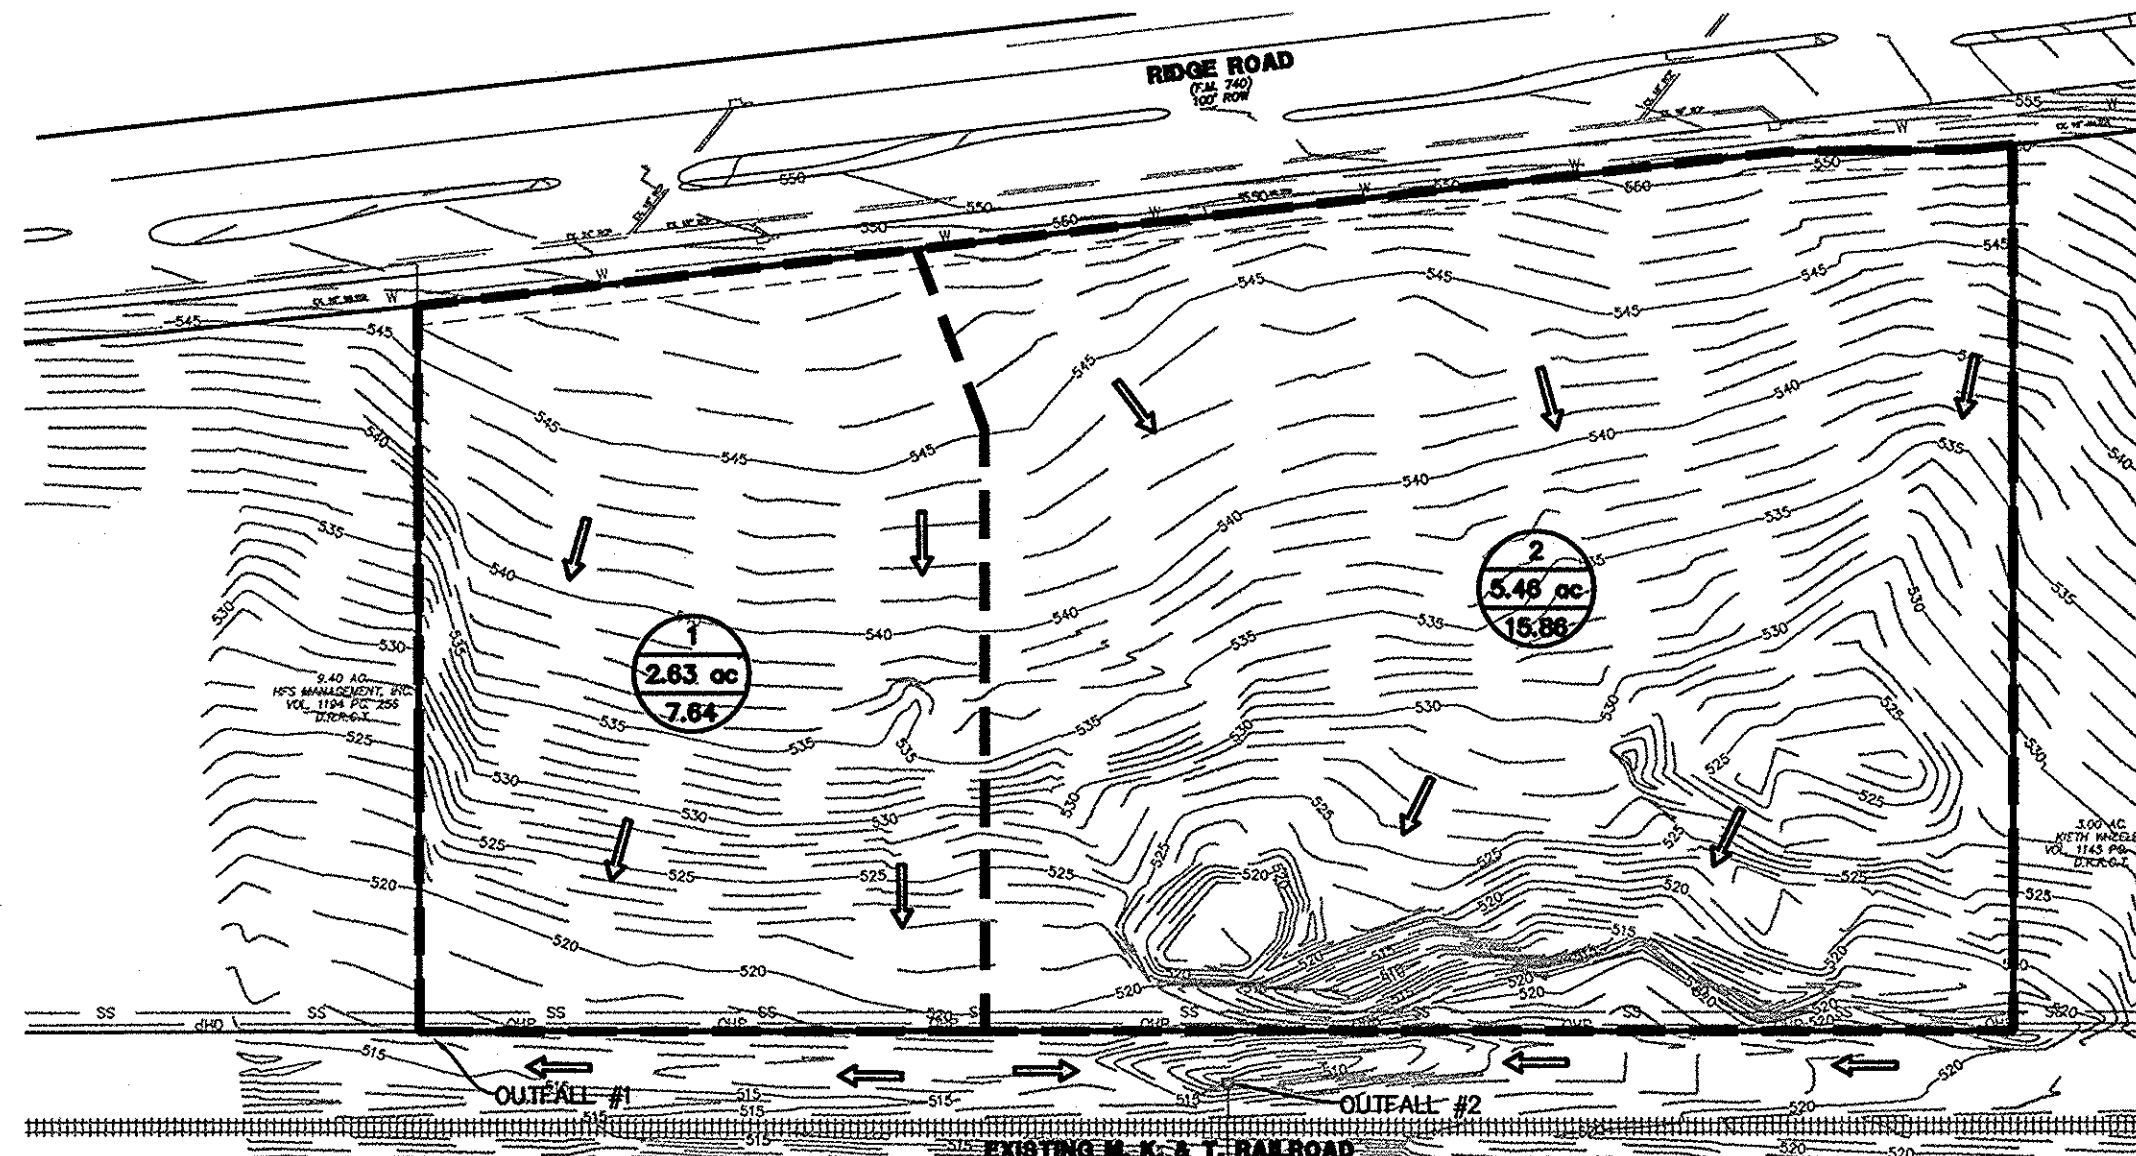

EXISTING ON-SITE DRAINAGE AREA MAP

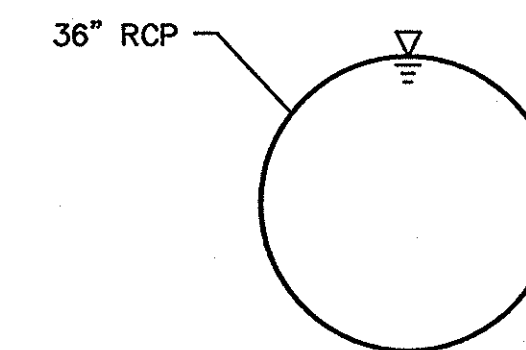

DETERMINATION OF STORAGE PROVIDED:
 CROSS-SECTIONAL AREA OF 36" RCP = 7.069 SF
 LENGTH OF PROPOSED DETENTION PIPE = 565 LF
 STORAGE PROVIDED = 7.069 SF X 565 LF = 3900 CF

DETENTION SYSTEM "A" ANALYSIS (DRY DETENTION POND)

1. DETERMINATION OF RELEASE RATE FROM DETENTION SYSTEM "A" (100 YEAR)

ON-SITE EXISTING CONDITIONS (TO OUTFALL #1):

100 YEAR STORM EVENT
 C=0.35
 I₁₀₀ = 8.30 IN/HR
 T_c = 20 MINUTES
 A = 2.63 ACRES
 Q₁₀₀ = 7.64 CFS

ON-SITE PROPOSED CONDITIONS:

100 YEAR STORM EVENT
 C=0.80
 I₁₀₀ = 9.80 IN/HR
 T_c = 10 MINUTES
 A₁ = 5.16 ACRES (DETAINED AREA FOR SYSTEM "A" SEE SHEET C-6)
 A₂ = 0.23 ACRES (UNDETAINED AREAS TO OUTFALL #1 SEE SHEET C-6)
 Q₁₀₀ = 40.48 CFS
 Q₁₀₀ = 1.80 CFS

PROPOSED DETENTION POND PARAMETERS:

100 YEAR W.S.E. = 532.00
 AVERAGE DEPTH OF POND IS 13.50 FEET
 POND AREA = 5149 SQUARE FEET
 POND VOLUME PROVIDED = 69500 CUBIC FEET
 SYSTEM "A" WILL OVERDETAIN DOWN BY 2.84 CFS
 TO MAXIMIZE THE PROVIDED POND VOLUME OF 69500 CF.

RELEASE RATE FROM SYSTEM "A":

Q₁₀₀ - Q_{2.84} = Q_r (ALLOWABLE RELEASE RATE FROM SYSTEM "A")
 7.64 CFS - 1.80 CFS = 5.84 CFS
 LESS OVERDETAINED AMOUNT:
 5.84 CFS - 2.84 CFS = Q_r = 3.00 CFS

2. DETERMINATION OF REQUIRED STORAGE VOLUME FOR DETENTION SYSTEM "A" (100 YEAR)

Q_r = 40.48 CFS (PROPOSED CONDITIONS)
 Q₁₀₀ = 3.00 CFS (RELEASE RATE)

DURATION (MIN.)	RAINFALL INTENSITY (IN/HR)	INFLOW RATE (CFS)	INFLOW VOLUME (CF)	OUTFLOW RATE (CFS)	OUTFLOW VOLUME (CF)	REQUIRED STORAGE (CF)
10	9.80	40.48	24,288	3.00	1,800	22,488
15	9.00	37.18	33,458	3.00	2,250	31,208
20	8.30	34.28	41,141	3.00	2,700	38,441
30	6.85	28.29	50,930	3.00	3,600	47,330
40	5.75	23.75	57,003	3.00	4,500	52,503
50	5.00	20.65	61,959	3.00	5,400	56,559
60	4.45	18.38	66,172	3.00	6,300	59,872
70	4.10	16.94	71,129	3.00	7,200	63,929
80	3.75	15.49	74,351	3.00	8,100	66,251
90	3.45	14.25	76,953	3.00	9,000	67,953
100	3.20	13.22	79,308	3.00	9,900	69,408
120	2.70	11.15	80,299	3.00	11,700	68,599

STORAGE VOLUME REQUIRED: 69,408 CF (100 YEAR)
 STORAGE VOLUME PROVIDED: 69,500 CF (100 YEAR)

3. DEVELOPED RUNOFF, ALLOWABLE RELEASE, AND REQUIRED DETENTION STORAGE FOR EACH RETURN PERIOD

RETURN PERIOD	AGRICULTURAL RELEASE (CFS)	DEVELOPED RUNOFF (CFS)	STORAGE VOLUME (CF)	WATER SURFACE ELEVATION	ACTUAL RELEASE (CFS)
10 YEAR	2.09	30.15	47,627	528.20	2.39
25 YEAR	2.49	34.70	57,215	530.20	2.67
50 YEAR	2.67	37.18	63,367	531.40	2.81
100 YEAR	3.00	40.48	69,408	532.60	2.95

*CALCULATIONS FOR 10, 25, AND 50 YEAR STORM EVENTS AVAILABLE UPON REQUEST.


ORIFICE DETAIL AND ANALYSIS

NTS

ORIFICE EQUATION

Q = CA(2GH)^{0.5}
 Q = ALLOWABLE RELEASE (CFS)
 A = ORIFICE AREA
 H = HEAD (FEET)
 C = ORIFICE COEFFICIENT (0.60)

*CALCULATIONS AVAILABLE UPON REQUEST.

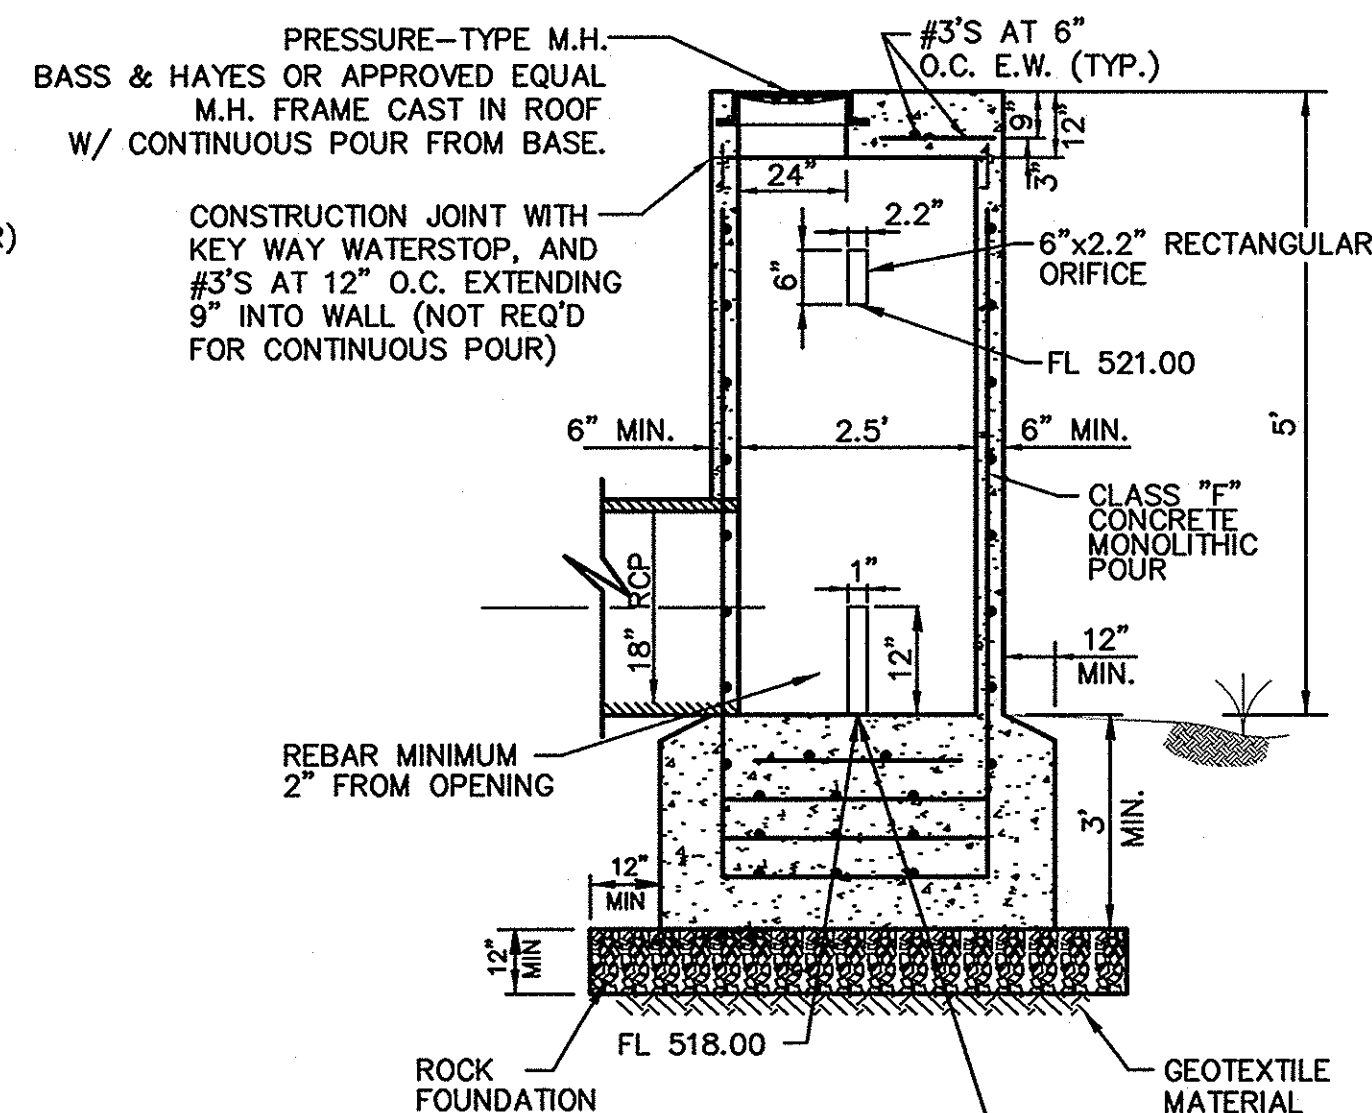

NOTE:
 FOR SEAL BETWEEN FRAME & COVER USE EITHER
 A 1/16" COPPER GASKET OR A 1/4" DIA. NEOPRENE
 O-RING GASKET (LOCATION OF O-RING IS LEFT TO
 MFR., BUT SUBJECT TO APPROVAL BY CONST. ENGR.)

DETENTION SYSTEM "B" ANALYSIS (UNDERGROUND)

1. DETERMINATION OF RELEASE RATE FROM DETENTION SYSTEM "B" (100 YEAR)

ON-SITE EXISTING CONDITIONS (TO OUTFALL #2):

100 YEAR STORM EVENT
 C=0.35
 I₁₀₀ = 8.30 IN/HR
 T_c = 20 MINUTES
 A = 5.46 ACRES
 Q₁₀₀ = 15.86 CFS (TOTAL ALLOWABLE RELEASE TO OUTFALL #2)

ON-SITE PROPOSED CONDITIONS:

100 YEAR STORM EVENT
 C=0.80
 I₁₀₀ = 9.80 IN/HR
 T_c = 10 MINUTES
 A₁ = 1.17 ACRES (DETAINED AREA FOR SYSTEM "B" SEE SHEET C-6)
 A₂ = 1.57 ACRES (UNDETAINED AREA TO OUTFALL #2 SEE SHEET C-6)
 Q₁₀₀ = 9.17 CFS
 Q₁₀₀ = 12.32 CFS

RELEASE RATE FROM SYSTEM "A":

Q₁₀₀ - Q_{2.84} = Q_r (ALLOWABLE RELEASE RATE FROM SYSTEM "A")
 15.86 CFS - 12.32 CFS = 3.54 CFS
 PLUS OVERDETAINED AMOUNT FROM SYSTEM "A":
 3.54 CFS + 2.84 CFS = Q_r = 6.38 CFS

2. DETERMINATION OF REQUIRED STORAGE VOLUME FOR DETENTION SYSTEM "B" (100 YEAR)

Q_r = 9.17 CFS (PROPOSED CONDITIONS)
 Q₁₀₀ = 6.38 (RELEASE RATE)

DURATION (MIN.)	RAINFALL INTENSITY (IN/HR)	INFLOW RATE (CFS)	INFLOW VOLUME (CF)	OUTFLOW RATE (CFS)	OUTFLOW VOLUME (CF)	REQUIRED STORAGE (CF)
10	9.80	9.17	5,502	6.38	3,828	1,674
15	9.00	8.42	7,579	6.38	4,785	2,794
20	8.30	7.77	9,320	6.38	5,742	3,578
30	6.85	6.41	11,537	6.38	7,656	3,881
40	5.75	5.38	12,913	6.38	9,570	3,343
50	5.00	4.68	14,036	6.38	11,484	2,552
60	4.45	4.16	14,990	6.38	13,398	1,592
70	4.10	3.84	16,113	6.38	15,312	801
80	3.75	3.51	16,843	6.38	17,226	0
90	3.45	3.23	17,432	6.38	19,140	0
100	3.20	2.99	17,966	6.38	21,054	0
120	2.70	2.53	18,190	6.38	24,882	0

STORAGE VOLUME REQUIRED: 3,881 CF (100 YEAR)
 STORAGE VOLUME PROVIDED: 3,881 CF (100 YEAR)

3. DEVELOPED RUNOFF, ALLOWABLE RELEASE, AND REQUIRED DETENTION STORAGE FOR EACH RETURN PERIOD

RETURN PERIOD	AGRICULTURAL RELEASE (CFS)	DEVELOPED RUNOFF (CFS)	STORAGE VOLUME (CF)	WATER SURFACE ELEV. UPSTREAM @ OUTFALL STRUCTURE
10 YEAR	4.47	6.83	2,892	519.68
25 YEAR	5.31	7.86	3,063	519.78
50 YEAR	5.70	8.42	3,606	520.13
100 YEAR	6.38	9.17	3,881	520.63

*CALCULATIONS FOR 10, 25, AND 50 YEAR STORM EVENTS AVAILABLE UPON REQUEST.

WEIR PLATE DETAIL AND ANALYSIS

NTS


WEIR EQUATION

Q = CLH^{1.5}
 Q = ALLOWABLE RELEASE (CFS)
 L = LENGTH (FEET)
 H = HEAD (FEET)
 C = WEIR COEFFICIENT (3.0)

*CALCULATIONS AVAILABLE UPON REQUEST.

RETURN PERIOD (YEAR)	AGRICULTURAL RELEASE (CFS)	*ACTUAL RELEASE (CFS)
10	4.47	4.50
25	5.31	4.93
50	5.70	5.59
100	6.38	6.35

*RELEASE BASED ON PROPOSED WEIR GEOMETRY

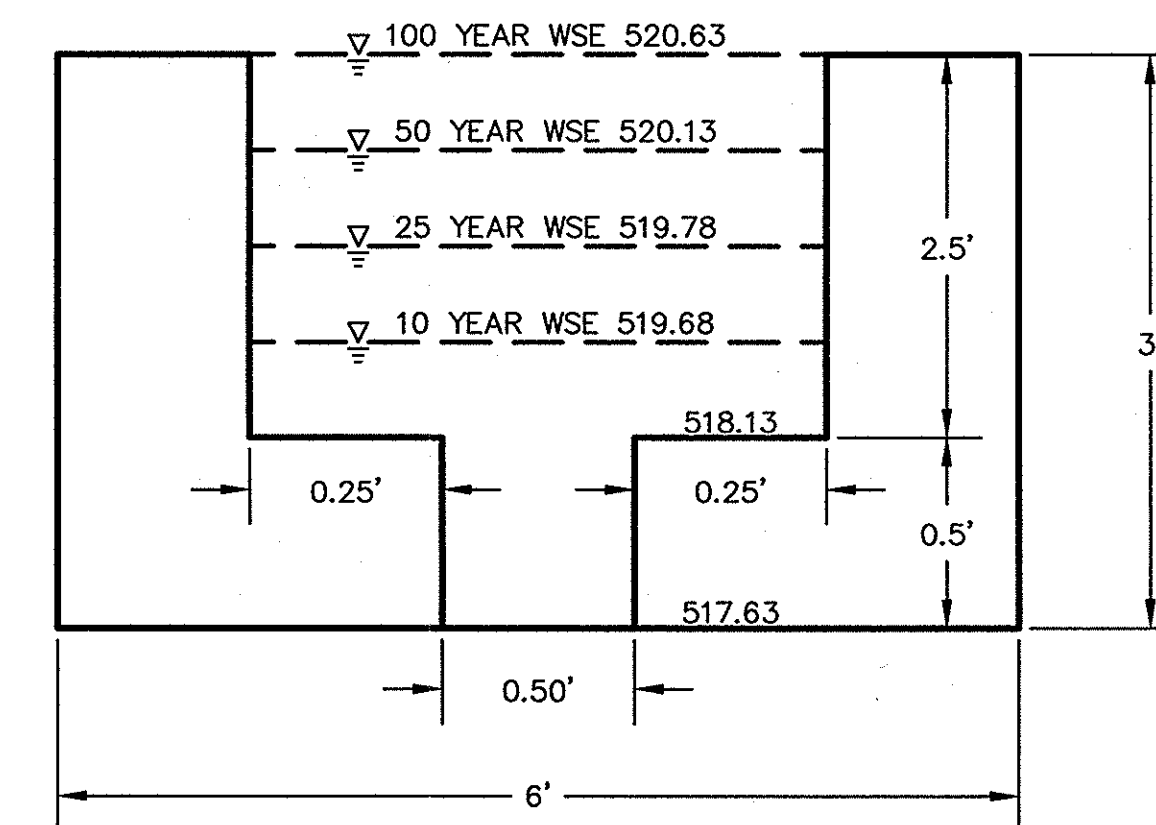

*SEE STORM SEWER DETAIL SHEET FOR WEIR PLATE CONSTRUCTION DETAIL

RECORD DRAWING
 THIS RECORD DRAWING HEREIN REFLECTS TO
 THE BEST OF THE DESIGN ENGINEERS
 KNOWLEDGE, THE APPROXIMATE LOCATION OF
 THE CONSTRUCTED WORK, USING
 INFORMATION AS PROVIDED BY THE
 CONTRACTORS AND SURVEYED GRADES.

No.	Date	Revisions	App.

Kimley-Horn and Associates, Inc.
 6300 Weddell Blvd., Suite 320
 Frisco, Texas 75035
 Tel. No. (972) 355-3599
 Fax No. (972) 355-3779

STATE OF TEXAS
 PIETER D. KESSELS
 57775
 LICENSED PROFESSIONAL ENGINEER
 5-25-2004
 FOR CONSTRUCTION

**ROCKWALL COMMONS
 MIXED USE TRACT
 CITY OF ROCKWALL, TEXAS**

**STORM DRAINAGE
 DETENTION
 CALCULATIONS**

Scale: AS SHOWN
 Designed by: P.D.K.
 Drawn by: C.D.R.
 Checked by: P.D.K.
 Date: 05/25/04
 Project No. 067051007

SHEET
 C-7
 OF 24